

STONE FILL, TYPE I
 STA. b 112+25 - STA. b 114+25 LT

GRUBBING MATERIAL
 STA. b 112+25 - STA. b 114+25 LT

GEOTEXTILE FOR SILT FENCE
 STA. b 112+25 - STA. b 114+25 LT

GEOTEXTILE UNDER STONE FILL
 STA. b 112+25 - STA. b 114+25 LT

REMOVING AND RESETTING FENCE
 STA. b 112+94 - STA. b 114+21 LT
 STA. c 0+00 - STA. c 0+50 LT

6" UNDERDRAIN PIPE
 B 115+30 - C 0+50 LT

CURVE #25
 DELTA = 8°46'08"
 D = 2°36'16"
 R = 2200.00'
 T = 168.68'
 L = 336.70'
 BANKING 0.04 FT/FT
 140' RUNOFF (45 MPH)
 SEE SUPERELEVATION DIAGRAMS
 FOR BANKING INFORMATION


DURABLE 4 INCH WHITE LINE (SEE OPTION ITEMS)
 STA. b 112+25 - STA. b 117+45.96 (SOLID LT & RT)
 STA. c 0+00 - STA. c 0+50 (SOLID LT & RT)

TEMPORARY 4 INCH WHITE LINE, PAINT
 STA. b 112+25 - STA. b 117+45.96 (SOLID LT & RT)
 STA. c 0+00 - STA. c 0+50 (SOLID LT & RT)

DURABLE 4 INCH YELLOW LINE (SEE OPTION ITEMS)
 STA. b 112+25 - STA. b 117+45.96 (SOLID LT & RT)
 STA. c 0+00 - STA. c 0+50 (SOLID LT & RT)

TEMPORARY 4 INCH YELLOW LINE, PAINT
 STA. b 112+25 - STA. b 117+45.96 (SOLID LT & RT)
 STA. c 0+00 - STA. c 0+50 (SOLID LT & RT)


NOTE:
 EXISTING BURIED FIBER OPTIC CABLES HAVE
 BEEN ABANDONED WITHIN PROJECT LIMITS

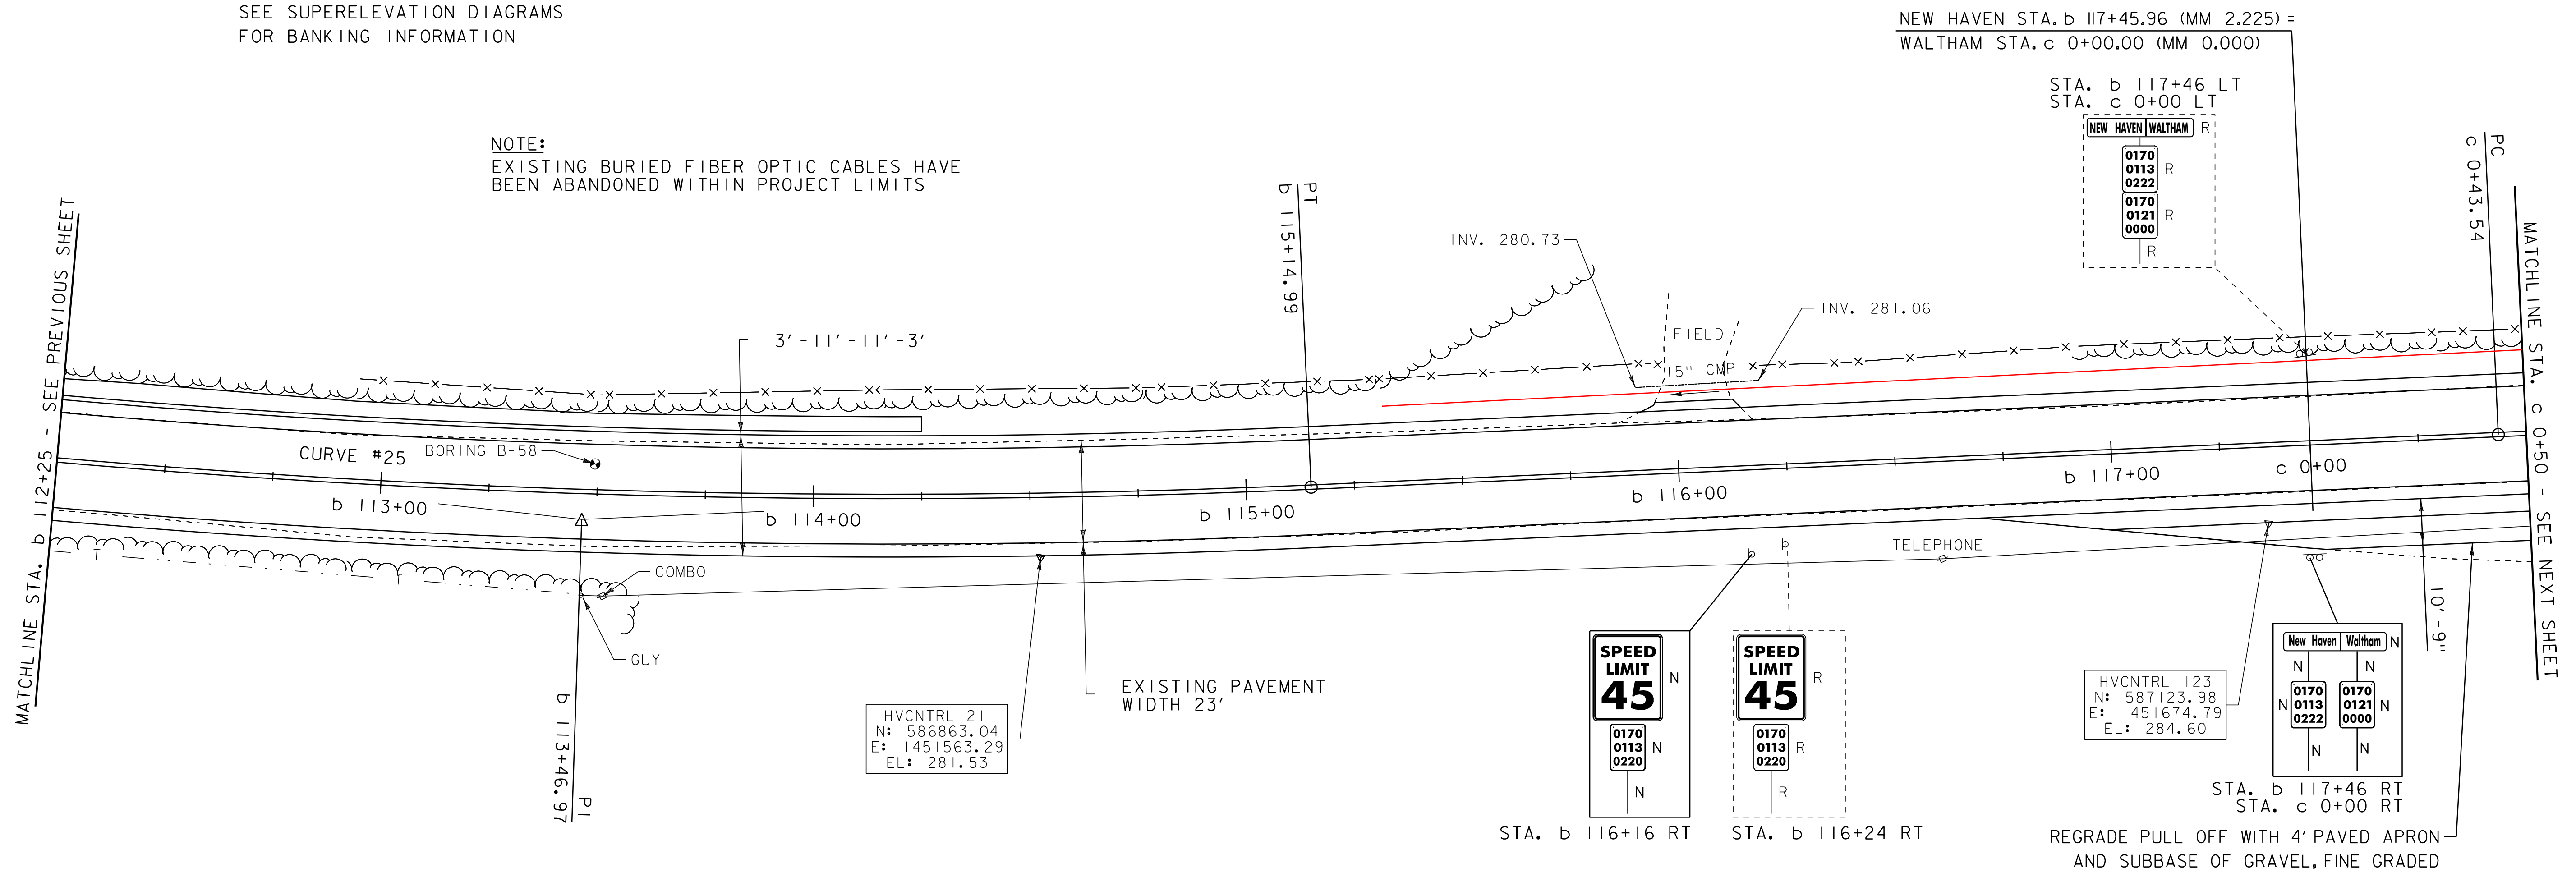

REMOVING SIGNS
 AS SHOWN - 5

- LEGEND**
- SIGN
 - ⊙ HYDRANT
 - MANHOLE
 - ⊙ GATE VALVE
 - ⊙ GAS PIPELINE MARKER
 - ⊙ CATCH BASIN / DROP INLET
 - CURB INLET
 - ⊙ BORING LOCATION
 - ⊙ MAILBOX
 - ⊙ UTILITY POLE
 - ⊙ FLUSHING BASIN

- SIGN LEGEND**
- R = REMOVE
 - R&S = REMOVE AND SALVAGE
 - RET = RETAIN
 - S = SALVAGE
 - N = NEW
 - B-B = BACK TO BACK

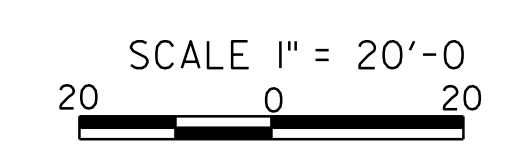

DATUM
 NAVD 88
 NAD 83

PROJECT LAYOUT SHEET 48	PROJECT NAME: ADDISON - NEW HAVEN	PLOT DATE: 3/13/2012
	PROJECT NUMBER: STP 9632(1)	DRAWN BY: SJL
	FILE NAME: p95B076.dgn	CHECKED BY: EPD
	DESIGNED BY: SJL	SHEET 71 OF 186
	PLOT FILE: p95B076.71.i	