

DURABLE 4 INCH WHITE LINE (SEE OPTION ITEMS)  
 STA. c 17+75 - STA. c 23+50 (SOLID LT & RT)  
 (WITH EDGELINE BREAKS AT TH #4)

TEMPORARY 4 INCH WHITE LINE, PAINT  
 STA. c 17+75 - STA. c 23+50 (SOLID LT & RT)  
 (WITH EDGELINE BREAKS AT TH #4)


DURABLE 4 INCH YELLOW LINE (SEE OPTION ITEMS)  
 STA. c 17+75 - STA. c 23+50 (SOLID LT & RT)  
 (WITH CENTERLINE BREAKS AT TH #4)

TEMPORARY 4 INCH YELLOW LINE, PAINT  
 STA. c 17+75 - STA. c 23+50 (SOLID LT & RT)  
 (WITH CENTERLINE BREAKS AT TH #4)


6 INCH UNDERDRAIN PIPE  
 STA. c ~~22+25~~ - STA. c 23+50 RT  
 22+75

6 INCH UNDERDRAIN CARRIER PIPE  
 STA. c 22+25 RT

CURVE #5  
 DELTA = 0°50'55"  
 D = 0°31'15"  
 R = 11000.00'  
 T = 81.45'  
 L = 162.90'  
 NORMAL CROWN

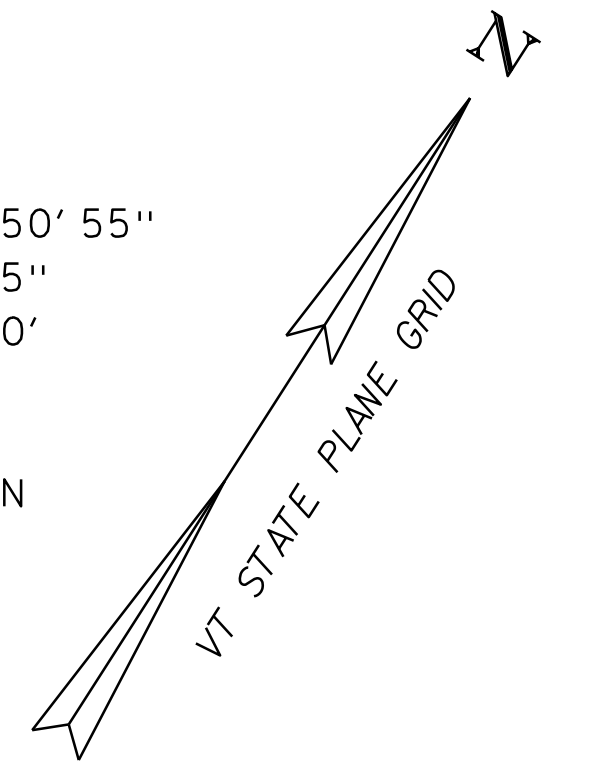

NOTE:  
 EXISTING BURIED FIBER OPTIC CABLES HAVE  
 BEEN ABANDONED WITHIN PROJECT LIMITS

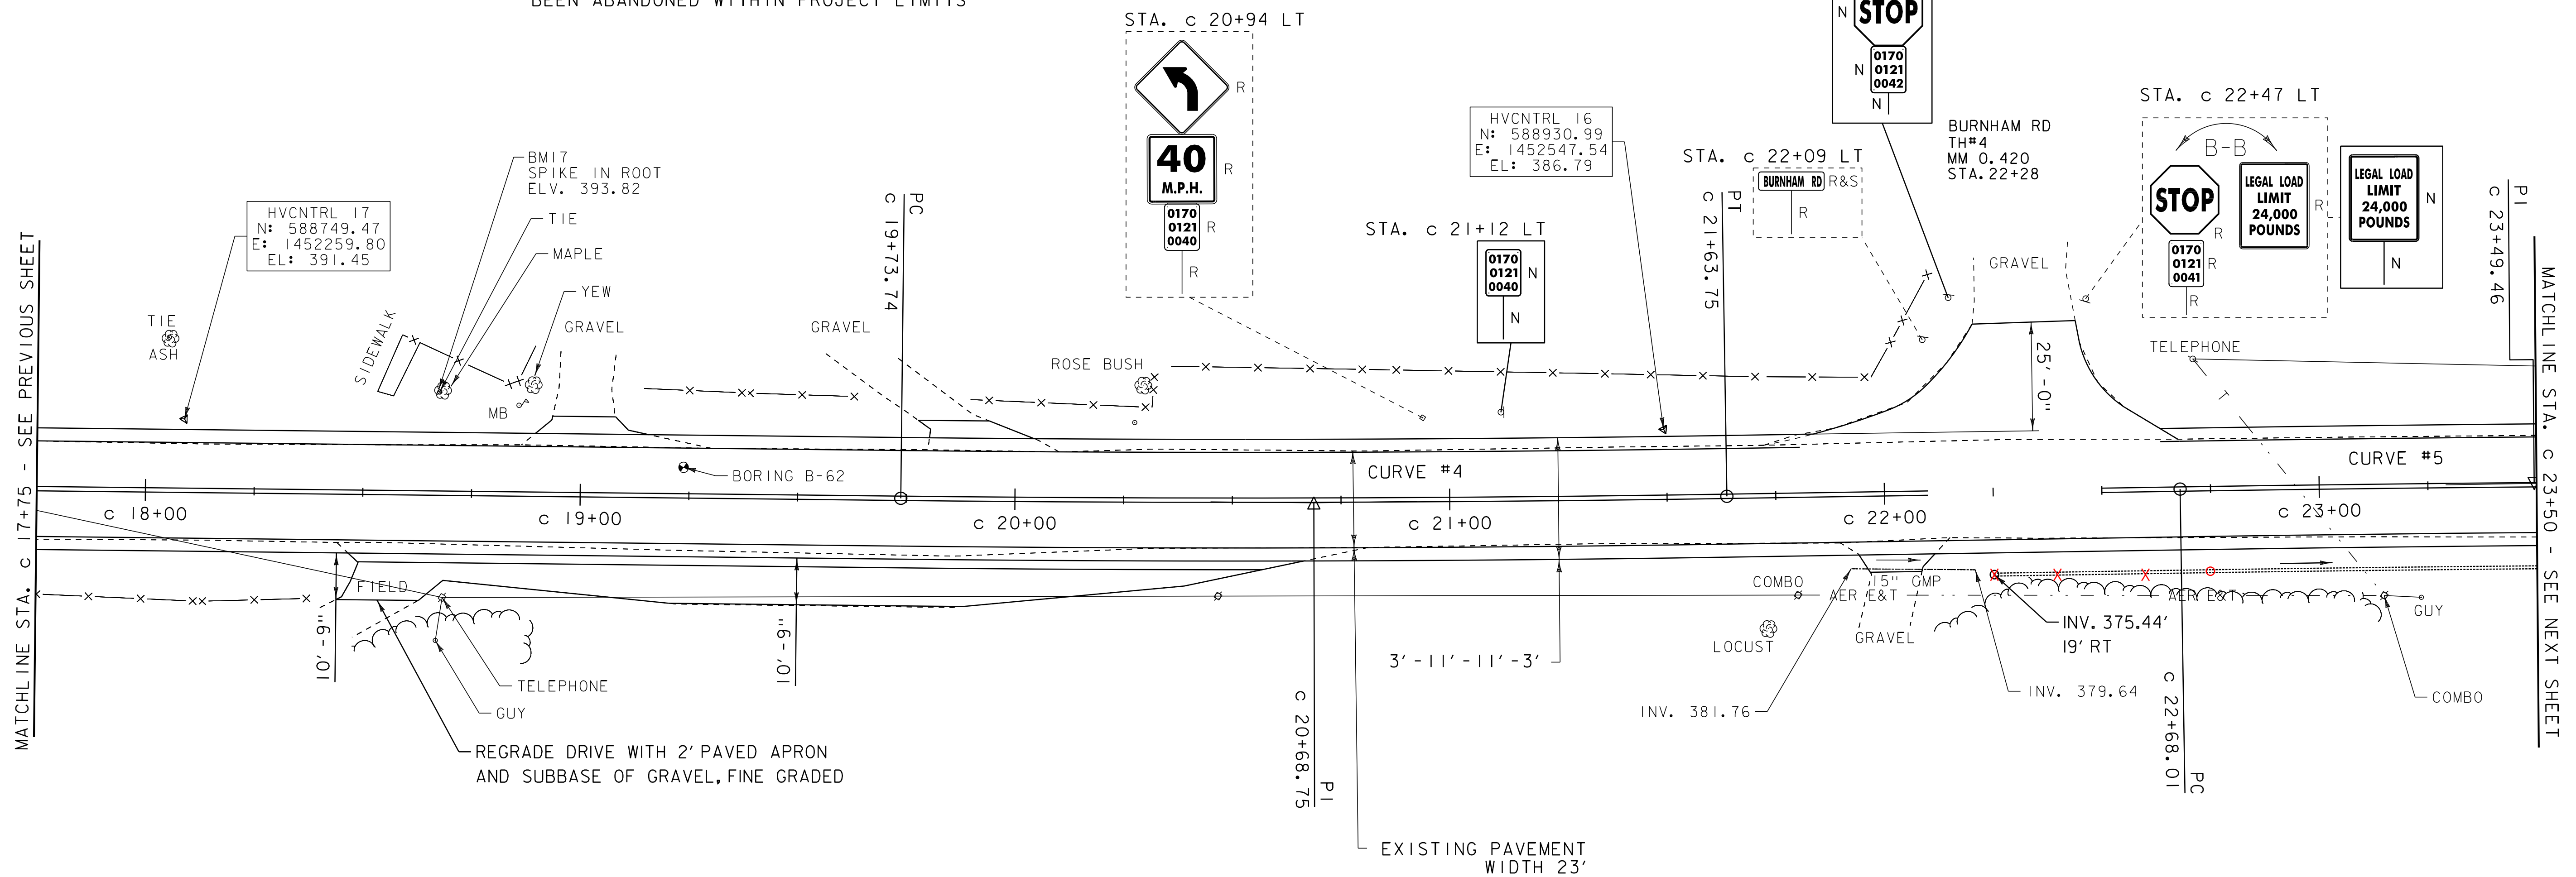

CURVE #4  
 DELTA = 1°33'19"  
 D = 0°49'07"  
 R = 7000.00'  
 T = 95.01'  
 L = 190.01'  
 NORMAL CROWN

REMOVING SIGNS  
 AS SHOWN - 7  
 ERECTING SALVAGED SIGNS  
 AS SHOWN - 1

- LEGEND**
- SIGN
  - HYDRANT
  - MANHOLE
  - GATE VALVE
  - GAS PIPELINE MARKER
  - CATCH BASIN / DROP INLET
  - CURB INLET
  - BORING LOCATION
  - MAILBOX
  - UTILITY POLE
  - FLUSHING BASIN

- SIGN LEGEND**
- R = REMOVE
  - R&S = REMOVE AND SALVAGE
  - RET = RETAIN
  - S = SALVAGE
  - N = NEW
  - B-B = BACK TO BACK

DATUM  
 NAVD 88  
 NAD 83

SCALE 1" = 20'-0"

<b>PROJECT LAYOUT SHEET 52</b>	PROJECT NAME: ADDISON - NEW HAVEN	PLOT DATE: 3/13/2012
	PROJECT NUMBER: STP 9632(1)	DRAWN BY: SJL
	FILE NAME: p95B076.dgn	CHECKED BY: EPD
	PROJECT LEADER: CDL	SHEET 75 OF 186
	DESIGNED BY: SJL	
	PLOT FILE: p95B076.75.1	