

DURABLE 4 INCH WHITE LINE (SEE OPTION ITEMS)
 STA. c 23+50 - STA. c 29+50 (SOLID LT & RT)

DURABLE 4 INCH YELLOW LINE (SEE OPTION ITEMS)
 STA. c 23+50 - STA. c 29+50 (SOLID LT & RT)

TEMPORARY 4 INCH WHITE LINE, PAINT
 STA. c 23+50 - STA. c 29+50 (SOLID LT & RT)

TEMPORARY 4 INCH YELLOW LINE, PAINT
 STA. c 23+50 - STA. c 29+50 (SOLID LT & RT)

STONE FILL, TYPE I
 STA. c 25+75 - STA. c 27+00 LT
 STA. c 29+25 - STA. c 29+50 LT

GRUBBING MATERIAL
 STA. c 25+75 - STA. c 27+00 LT
 STA. c 29+25 - STA. c 29+50 LT

GEOTEXTILE FOR SILT FENCE
 STA. c 25+75 - STA. c 27+00 LT
 STA. c 29+25 - STA. c 29+50 LT

GEOTEXTILE UNDER STONE FILL
 STA. c 25+75 - STA. c 27+00 LT
 STA. c 29+25 - STA. c 29+50 LT


6 INCH UNDERDRAIN PIPE
 STA. c 23+50 - STA. c 24+75 RT 26+35
 STA. c 26+50 - STA. c 29+50 RT
 26+60

6 INCH UNDERDRAIN CARRIER PIPE
 STA. c 26+50 RT

UNDERDRAIN FLUSHING BASIN
 STA. c 26+50 RT
 26+60


CURVE #6
 DELTA = 1°38'20"
 D = 1°54'35"
 R = 3000.00'
 T = 42.91'
 L = 85.81'
 BANKING 0.031 FT/FT
 140' RUNOFF (45 MPH)
 SEE SUPERELEVATION DIAGRAMS
 FOR BANKING INFORMATION

NOTE:
 EXISTING BURIED FIBER OPTIC CABLES HAVE
 BEEN ABANDONED WITHIN PROJECT LIMITS

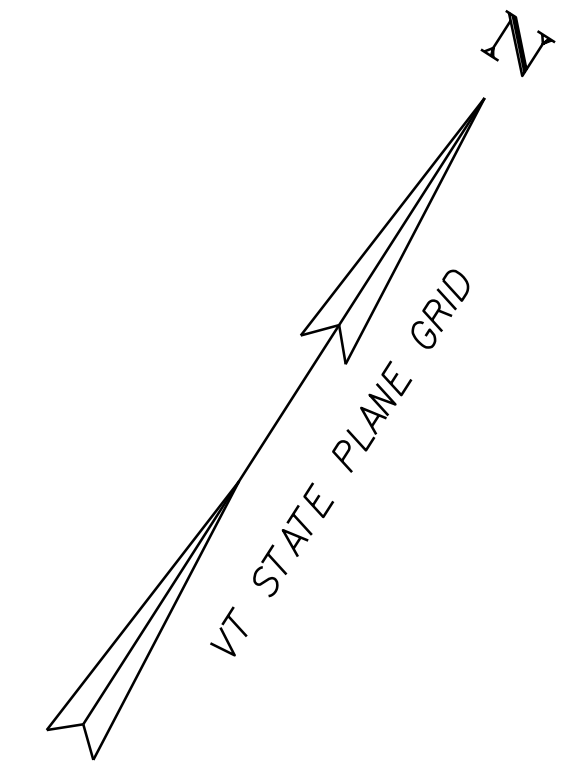

MATCHLINE STA. c 23+50 - SEE PREVIOUS SHEET

MATCHLINE STA. c 29+50 - SEE NEXT SHEET

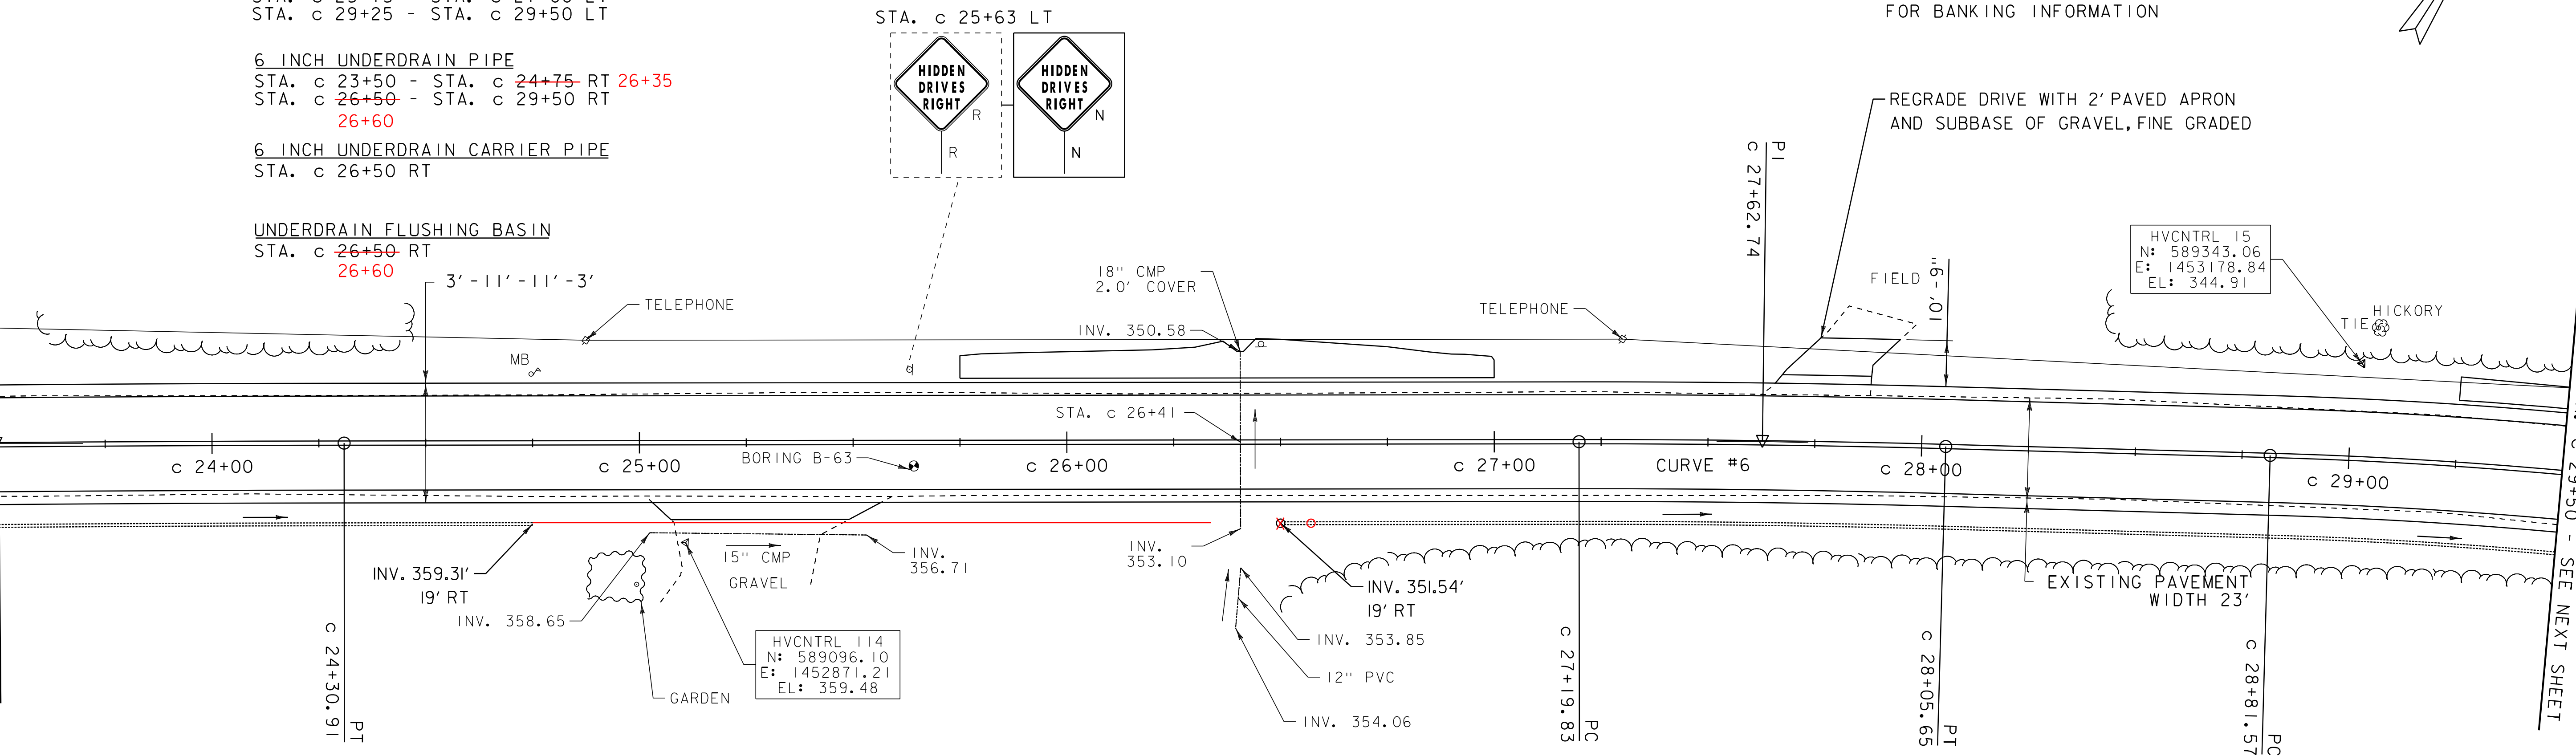

ENVIRONMENTALLY SENSITIVE LOCATIONS:

NO.	LIMITS	POS.	TYPE
22.	STA. c 24+75 - STA. c 27+50	LT	EM
23.	STA. c 26+25 - STA. c 26+75	RT	EM
24.	STA. c 29+25 - STA. c 29+50	LT	EM

KEY:
 EM - EMERGENT WETLAND
 FO - FORESTED WETLAND
 SS - SCRUB-SHRUB WETLAND

REMOVING SIGNS
 AS SHOWN - I

LEGEND

- SIGN
- HYDRANT
- MANHOLE
- GATE VALVE
- GAS PIPELINE MARKER
- CATCH BASIN / DROP INLET
- CURB INLET
- BORING LOCATION
- MAILBOX
- UTILITY POLE
- FLUSHING BASIN

SIGN LEGEND

- R = REMOVE
- R&S = REMOVE AND SALVAGE
- RET = RETAIN
- S = SALVAGE
- N = NEW
- B-B = BACK TO BACK

DATUM
 NAVD 88
 NAD 83

SCALE 1" = 20'-0"

PROJECT LAYOUT SHEET 53

PROJECT NAME: ADDISON - NEW HAVEN
 PROJECT NUMBER: STP 9632(1)

FILE NAME: p95B076.dgn
 PROJECT LEADER: CDL
 DESIGNED BY: SJL
 PLOT FILE: p95B076.76.t

PLOT DATE: 3/13/2012
 DRAWN BY: SJL
 CHECKED BY: EPD
 SHEET 76 OF 186