

CURVE #7  
 DELTA = 12°39'39"  
 D = 5°12'31"  
 R = 1100.00'  
 T = 122.03'  
 L = 243.07'  
 BANKING 0.064 FT/FT  
 145' RUNOFF (45 MPH)  
 SEE SUPERELEVATION DIAGRAMS  
 FOR BANKING INFORMATION

STONE FILL, TYPE I  
 STA. c 29+50 - STA. c 34+50 LT

GRUBBING MATERIAL  
 STA. c 29+50 - STA. c 34+50 LT

GEOTEXTILE FOR SILT FENCE  
 STA. c 29+50 - STA. c 34+50 LT

GEOTEXTILE STONE FILL  
 STA. c 29+50 - STA. c 34+50 LT

DURABLE 4 INCH WHITE LINE (SEE OPTION ITEMS)  
 STA. c 29+50 - STA. c 34+50 (SOLID LT & RT)

TEMPORARY 4 INCH WHITE LINE, PAINT  
 STA. c 29+50 - STA. c 34+50 (SOLID LT & RT)

DURABLE 4 INCH YELLOW LINE (SEE OPTION ITEMS)  
 STA. c 29+50 - STA. c 34+50 (SOLID LT & RT)


TEMPORARY 4 INCH YELLOW LINE, PAINT  
 STA. c 29+50 - STA. c 34+50 (SOLID LT & RT)

6 INCH UNDERDRAIN PIPE  
 STA. c 29+50 - STA. c ~~33+25~~ RT 33+45  
 STA. c ~~33+75~~ - STA. c 34+50 RT  
 33+70

6 INCH UNDERDRAIN CARRIER PIPE  
 STA. c 30+00 RT  
 STA. c 33+75 RT

UNDERDRAIN FLUSHING BASIN  
 STA. c ~~30+00~~ RT  
 STA. c ~~33+75~~ RT  
 C 33+70 RT

NOTE:  
 EXISTING BURIED FIBER OPTIC CABLES HAVE  
 BEEN ABANDONED WITHIN PROJECT LIMITS

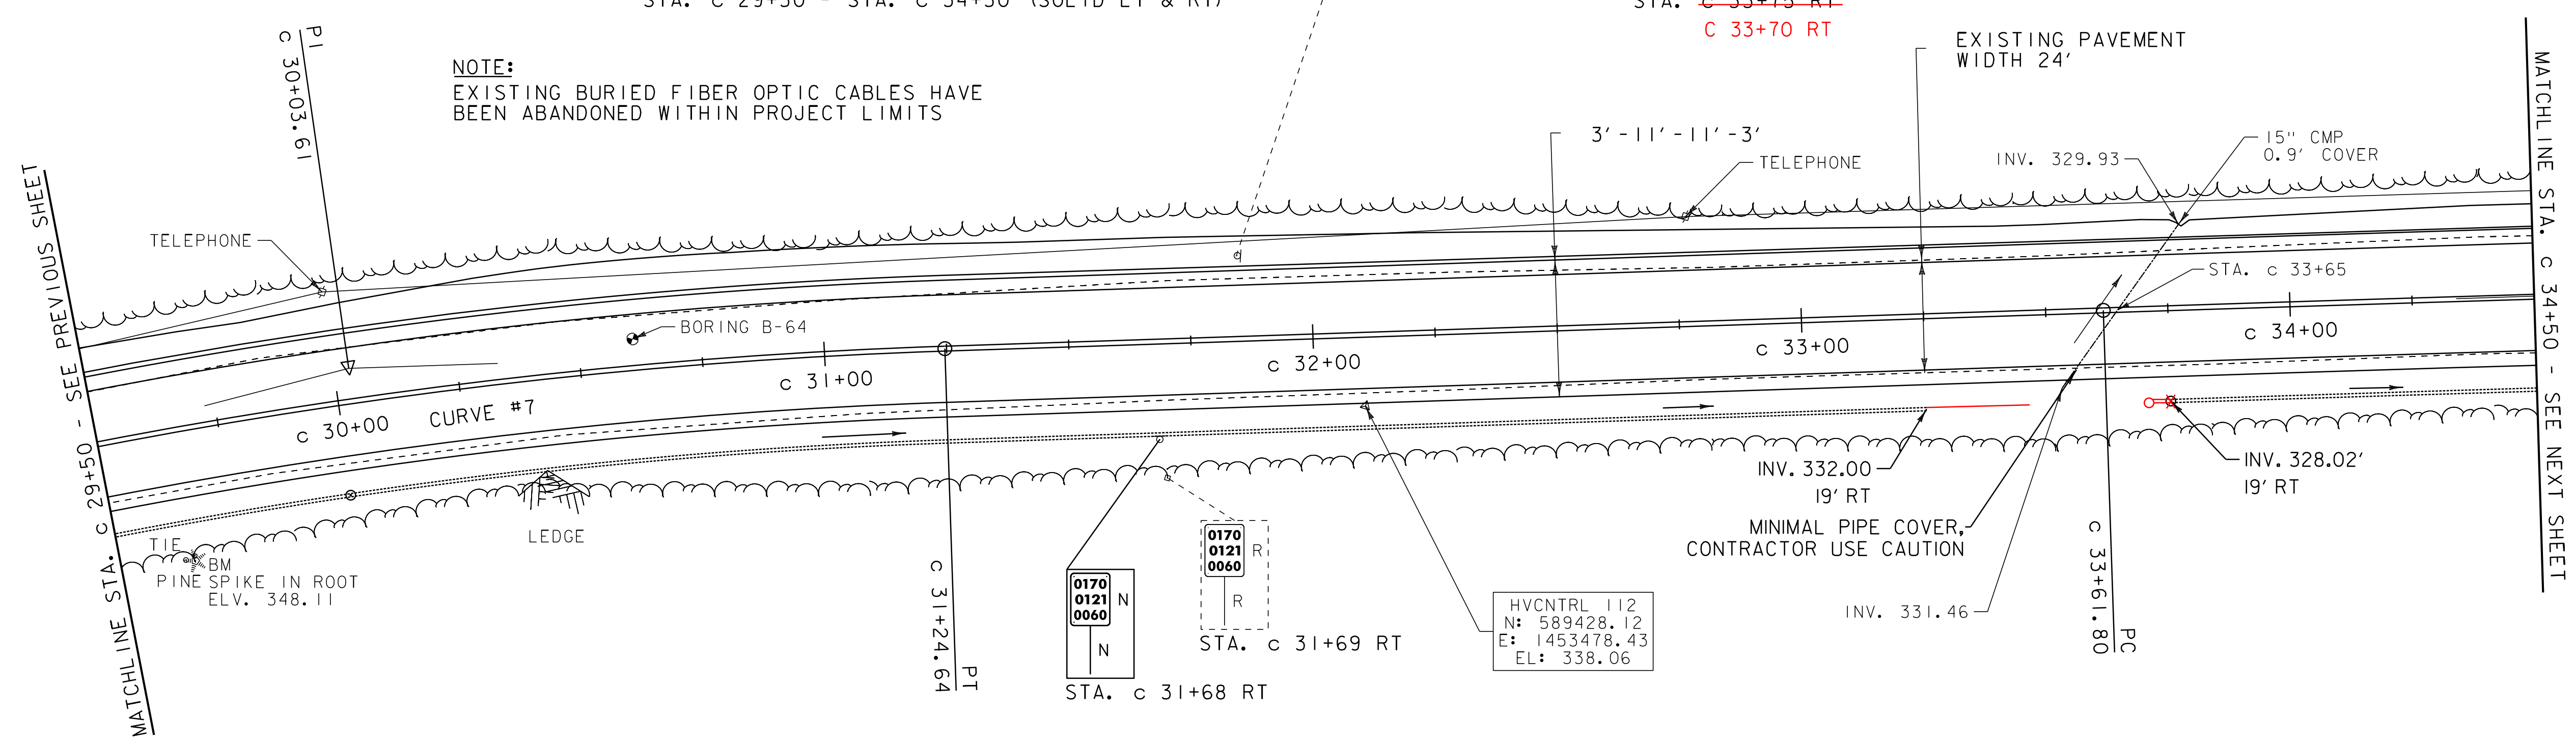


**ENVIRONMENTALLY SENSITIVE LOCATIONS:**

| NO. | LIMITS                      | POS. | TYPE |
|-----|-----------------------------|------|------|
| 24. | STA. c 29+50 - STA. c 34+50 | LT   | EM   |

KEY:  
 EM - EMERGENT WETLAND  
 FO - FORESTED WETLAND  
 SS - SCRUB-SHRUB WETLAND

- LEGEND**
- SIGN
  - HYDRANT
  - MANHOLE
  - GATE VALVE
  - GAS PIPELINE MARKER
  - CATCH BASIN / DROP INLET
  - CURB INLET
  - BORING LOCATION
  - MAILBOX
  - UTILITY POLE
  - FLUSHING BASIN

- SIGN LEGEND**
- R = REMOVE
  - R&S = REMOVE AND SALVAGE
  - RET = RETAIN
  - S = SALVAGE
  - N = NEW
  - B-B = BACK TO BACK

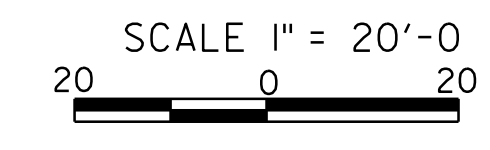

REMOVING SIGNS  
 AS SHOWN - 2

DATUM

|         |
|---------|
| NAVD 88 |
| NAD 83  |

|                                |                                   |                      |
|--------------------------------|-----------------------------------|----------------------|
| <b>PROJECT LAYOUT SHEET 54</b> | PROJECT NAME: ADDISON - NEW HAVEN | PLOT DATE: 3/13/2012 |
|                                | PROJECT NUMBER: STP 9632(1)       | DRAWN BY: SJL        |
|                                | FILE NAME: p95B076.dgn            | CHECKED BY: EPD      |
|                                | DESIGNED BY: SJL                  | SHEET 77 OF 186      |
|                                | PLOT FILE: p95B076_77.i           |                      |