

STONE FILL, TYPE I
 STA. d 122+75 - STA. d 123+75 LT

GRUBBING MATERIAL
 STA. d 122+75 - STA. d 123+75 LT

GEOTEXTILE FOR SILT FENCE
 STA. d 122+75 - STA. d 123+75 LT

GEOTEXTILE UNDER STONE FILL
 STA. d 122+75 - STA. d 123+75 LT

STEEL BEAM GUARDRAIL, GALVANIZED W/8 FEET POSTS
~~STA. d 122+22.75 - STA. d 123+04 RT D 122+33 - D 123+83 RT~~
 STA. d 122+47.75 - STA. d 123+04 RT
 STA. d 123+29 - STA. d 124+72.75 LT
~~STA. d 123+29 - STA. d 123+85.25 RT~~

STEEL BEAM GUARDRAIL,
 GALVANIZED/NESTED W/8 FEET POSTS
~~STA. d 123+04 - STA. d 123+29 LT~~
~~STA. d 123+04 - STA. d 123+29 RT~~



ANCHOR FOR STEEL BEAM RAIL
~~STA. d 122+22.75 RT D 122+33 RT~~
 STA. d 122+47.75 LT
 STA. d 123+85.25 RT
 STA. d 124+72.75 LT

DURABLE 4 INCH WHITE LINE (SEE OPTION ITEMS)
 STA. d 120+50 - STA. d 126+25 (SOLID LT & RT)

TEMPORARY 4 INCH WHITE LINE, PAINT
 STA. d 120+50 - STA. d 126+25 (SOLID LT & RT)

DURABLE 4 INCH YELLOW LINE (SEE OPTION ITEMS)
 STA. d 120+50 - STA. d 126+25 (SOLID LT & RT)

TEMPORARY 4 INCH YELLOW LINE, PAINT
 STA. d 120+50 - STA. d 126+25 (SOLID LT & RT)

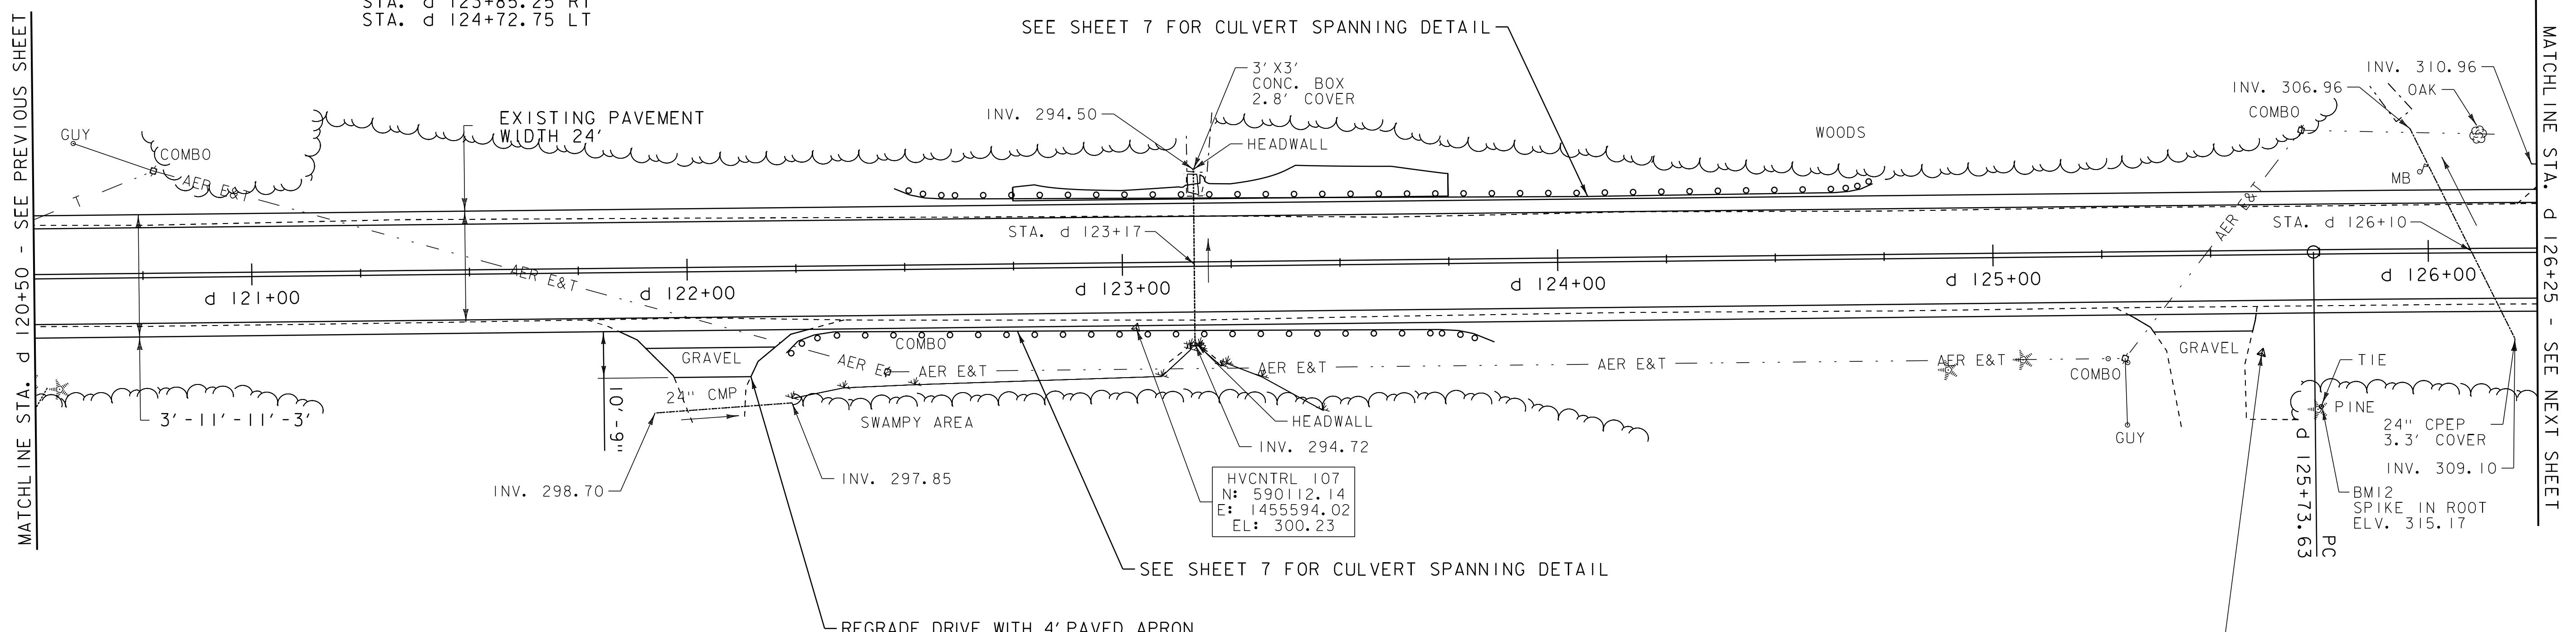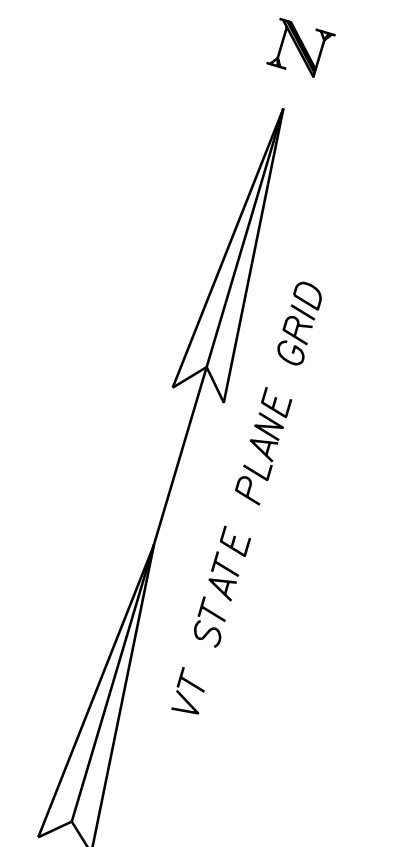

ENVIRONMENTALLY SENSITIVE LOCATIONS:


NO.	LIMITS	POS.	TYPE
28.	STA. d 121+25 - STA. d 126+00	LT	EM
29.	STA. d 120+75 - STA. d 124+50	RT	EM/SS/FO
30.	STA. d 126+00 - STA. d 126+25	RT	EM

KEY:
 EM - EMERGENT WETLAND
 FO - FORESTED WETLAND
 SS - SCRUB-SHRUB WETLAND

- LEGEND**
- SIGN
 - HYDRANT
 - MANHOLE
 - GATE VALVE
 - GAS PIPELINE MARKER
 - CATCH BASIN / DROP INLET
 - CURB INLET
 - BORING LOCATION
 - MAILBOX
 - UTILITY POLE
 - FLUSHING BASIN

- SIGN LEGEND**
- R = REMOVE
 - R&S = REMOVE AND SALVAGE
 - RET = RETAIN
 - S = SALVAGE
 - N = NEW
 - B-B = BACK TO BACK

DATUM
 NAVD 88
 NAD 83

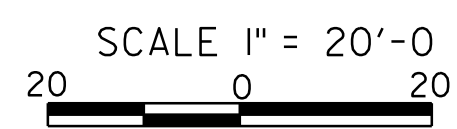

PROJECT LAYOUT SHEET 58	PROJECT NAME: ADDISON - NEW HAVEN	PLOT DATE: 3/13/2012
	PROJECT NUMBER: STP 9632(1)	DRAWN BY: SJL
	FILE NAME: p95B076.dgn	CHECKED BY: EPD
	PROJECT LEADER: CDL	SHEET 81 OF 186
	DESIGNED BY: SJL	
	PLOT FILE: p95B076_81.I	