

STONE FILL, TYPE I
 STA. d 135+75 - STA. d 136+70 RT
 STA. d 137+00 - STA. d 137+50 RT

GRUBBING MATERIAL
 STA. d 135+75 - STA. d 136+70 RT
 STA. d 137+00 - STA. d 137+50 RT

GEOTEXTILE FOR SILT FENCE
 STA. d 135+75 - STA. d 136+70 RT
 STA. d 137+00 - STA. d 137+50 RT

GEOTEXTILE UNDER STONE FILL
 STA. d 135+75 - STA. d 136+70 RT
 STA. d 137+00 - STA. d 137+50 RT

DURABLE 4 INCH WHITE LINE (SEE OPTION ITEMS)
 STA. d 131+75 - STA. d 137+50 (SOLID LT & RT)

TEMPORARY 4 INCH WHITE LINE, PAINT
 STA. d 131+75 - STA. d 137+50 (SOLID LT & RT)

DURABLE 4 INCH YELLOW LINE (SEE OPTION ITEMS)
 STA. d 131+75 - STA. d 137+50 (SOLID LT & RT)



TEMPORARY 4 INCH YELLOW LINE, PAINT
 STA. d 131+75 - STA. d 137+50 (SOLID LT & RT)

6 INCH UNDERDRAIN PIPE
 STA. d 135+25 - STA. d 137+00 LT
 134+95 136+95

6 INCH UNDERDRAIN CARRIER PIPE
 STA. d 137+00 LT

UNDERDRAIN FLUSHING BASIN
 STA. d 137+00 LT
 136+95

RELOCATE MAILBOX, SINGLE SUPPORT
 STA. d 136+98 RT

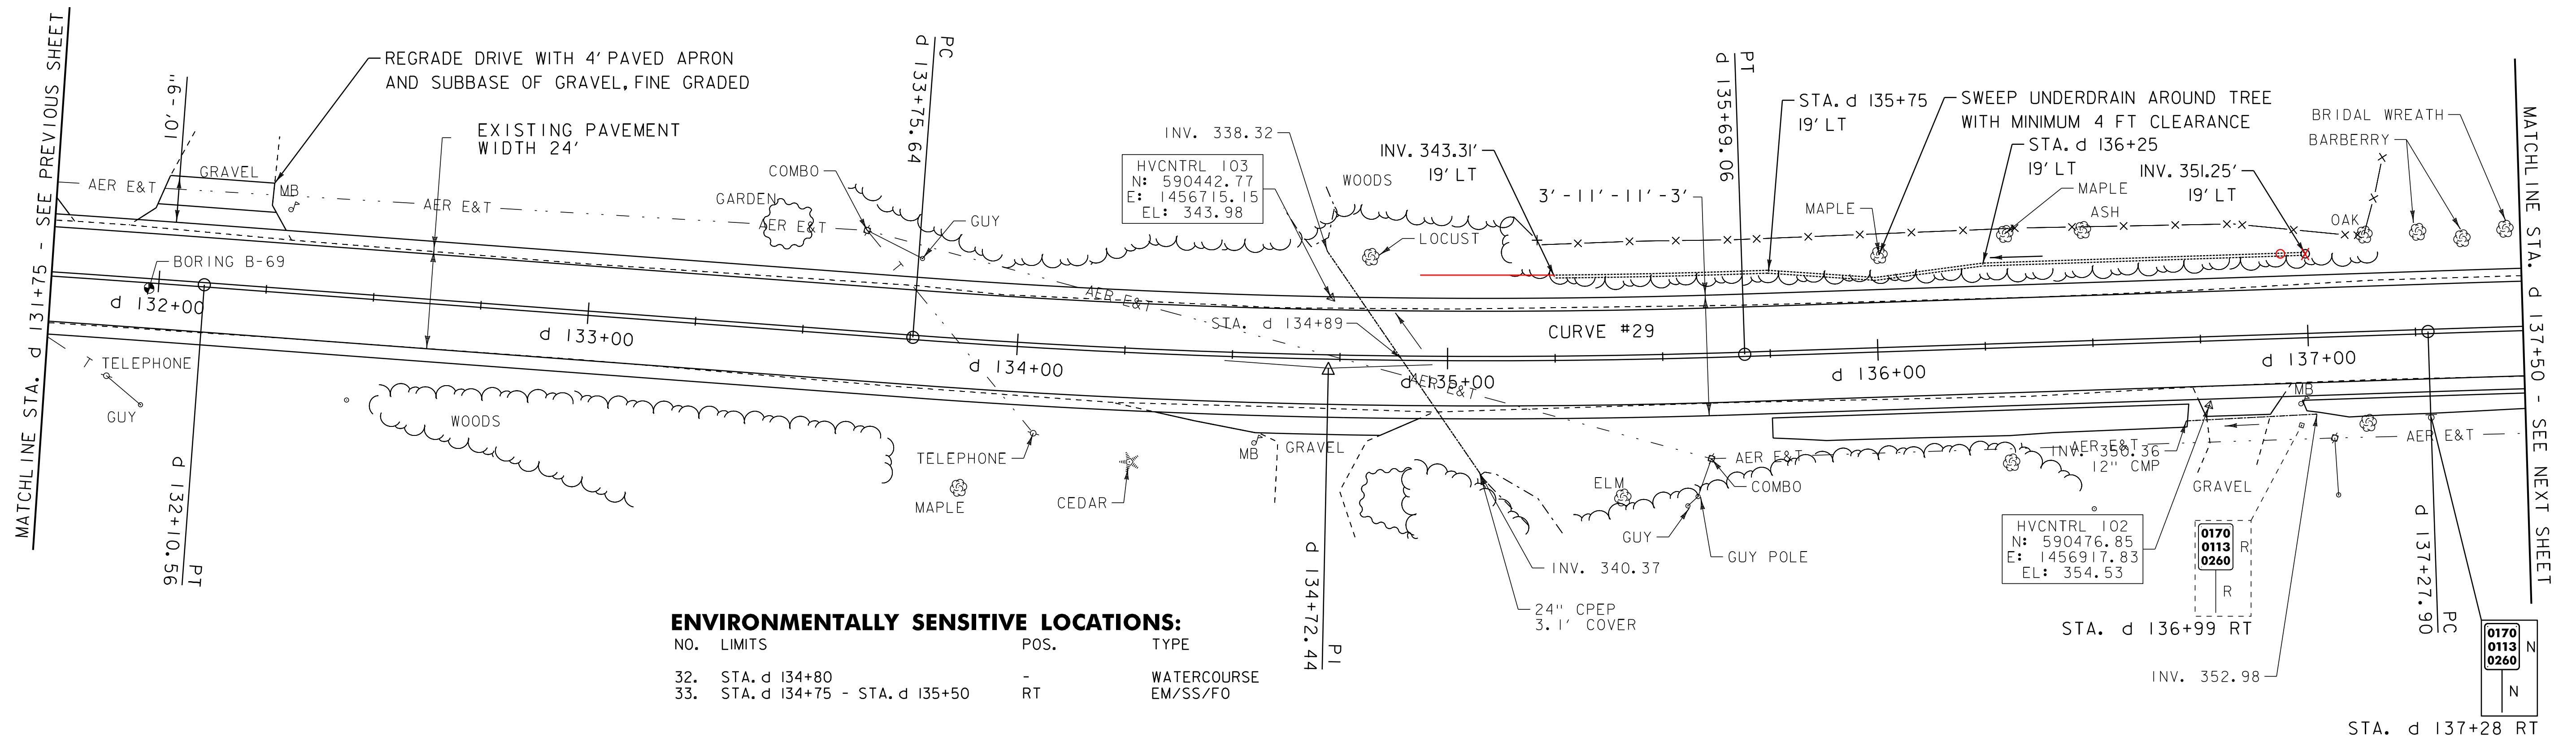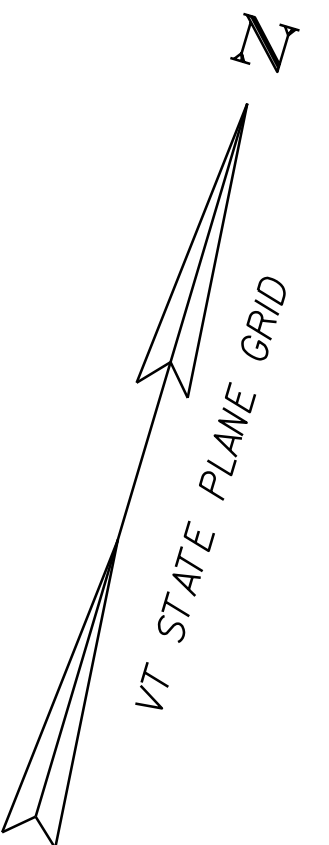

ENVIRONMENTALLY SENSITIVE LOCATIONS:

NO.	LIMITS	POS.	TYPE
32.	STA. d 134+80	-	WATERCOURSE
33.	STA. d 134+75 - STA. d 135+50	RT	EM/SS/FO

KEY:
 EM - EMERGENT WETLAND
 FO - FORESTED WETLAND
 SS - SCRUB-SHRUB WETLAND

- LEGEND**
- SIGN
 - HYDRANT
 - MANHOLE
 - GATE VALVE
 - GAS PIPELINE MARKER
 - CATCH BASIN / DROP INLET
 - CURB INLET
 - BORING LOCATION
 - MAILBOX
 - UTILITY POLE
 - FLUSHING BASIN

- SIGN LEGEND**
- R = REMOVE
 - R&S = REMOVE AND SALVAGE
 - RET = RETAIN
 - S = SALVAGE
 - N = NEW
 - B-B = BACK TO BACK

CURVE #29
 DELTA = 6°09'25"
 D = 3°10'59"
 R = 1800.00'
 T = 96.80'
 L = 193.42'
 BANKING 0.047 FT/FT
 140' RUNOFF (45 MPH)
 SEE SUPERELEVATION DIAGRAMS
 FOR BANKING INFORMATION

REMOVING SIGNS
 AS SHOWN - I

DATUM
 NAVD 88
 NAD 83

SCALE 1" = 20'-0"
 20 0 20

PROJECT LAYOUT SHEET 60

PROJECT NAME: ADDISON - NEW HAVEN
 PROJECT NUMBER: STP 9632(1)

FILE NAME: p95B076.dgn PLOT DATE: 3/13/2012
 PROJECT LEADER: CDL DRAWN BY: SJL
 DESIGNED BY: SJL CHECKED BY: EPD
 PLOT FILE: p95B076_83.1 SHEET 83 OF 186