


DURABLE 4 INCH WHITE LINE (SEE OPTION ITEMS)  
 STA. d 143+25 - STA. d 148+50 (SOLID LT & RT)

DURABLE 4 INCH YELLOW LINE (SEE OPTION ITEMS)  
 STA. d 143+25 - STA. d 148+50 (SOLID LT & RT)

TEMPORARY 4 INCH WHITE LINE, PAINT  
 STA. d 143+25 - STA. d 148+50 (SOLID LT & RT)

TEMPORARY 4 INCH YELLOW LINE, PAINT  
 STA. d 143+25 - STA. d 148+50 (SOLID LT & RT)

6" UNDERDRAIN PIPE  
 D 143+25 RT - D 145+00 LT

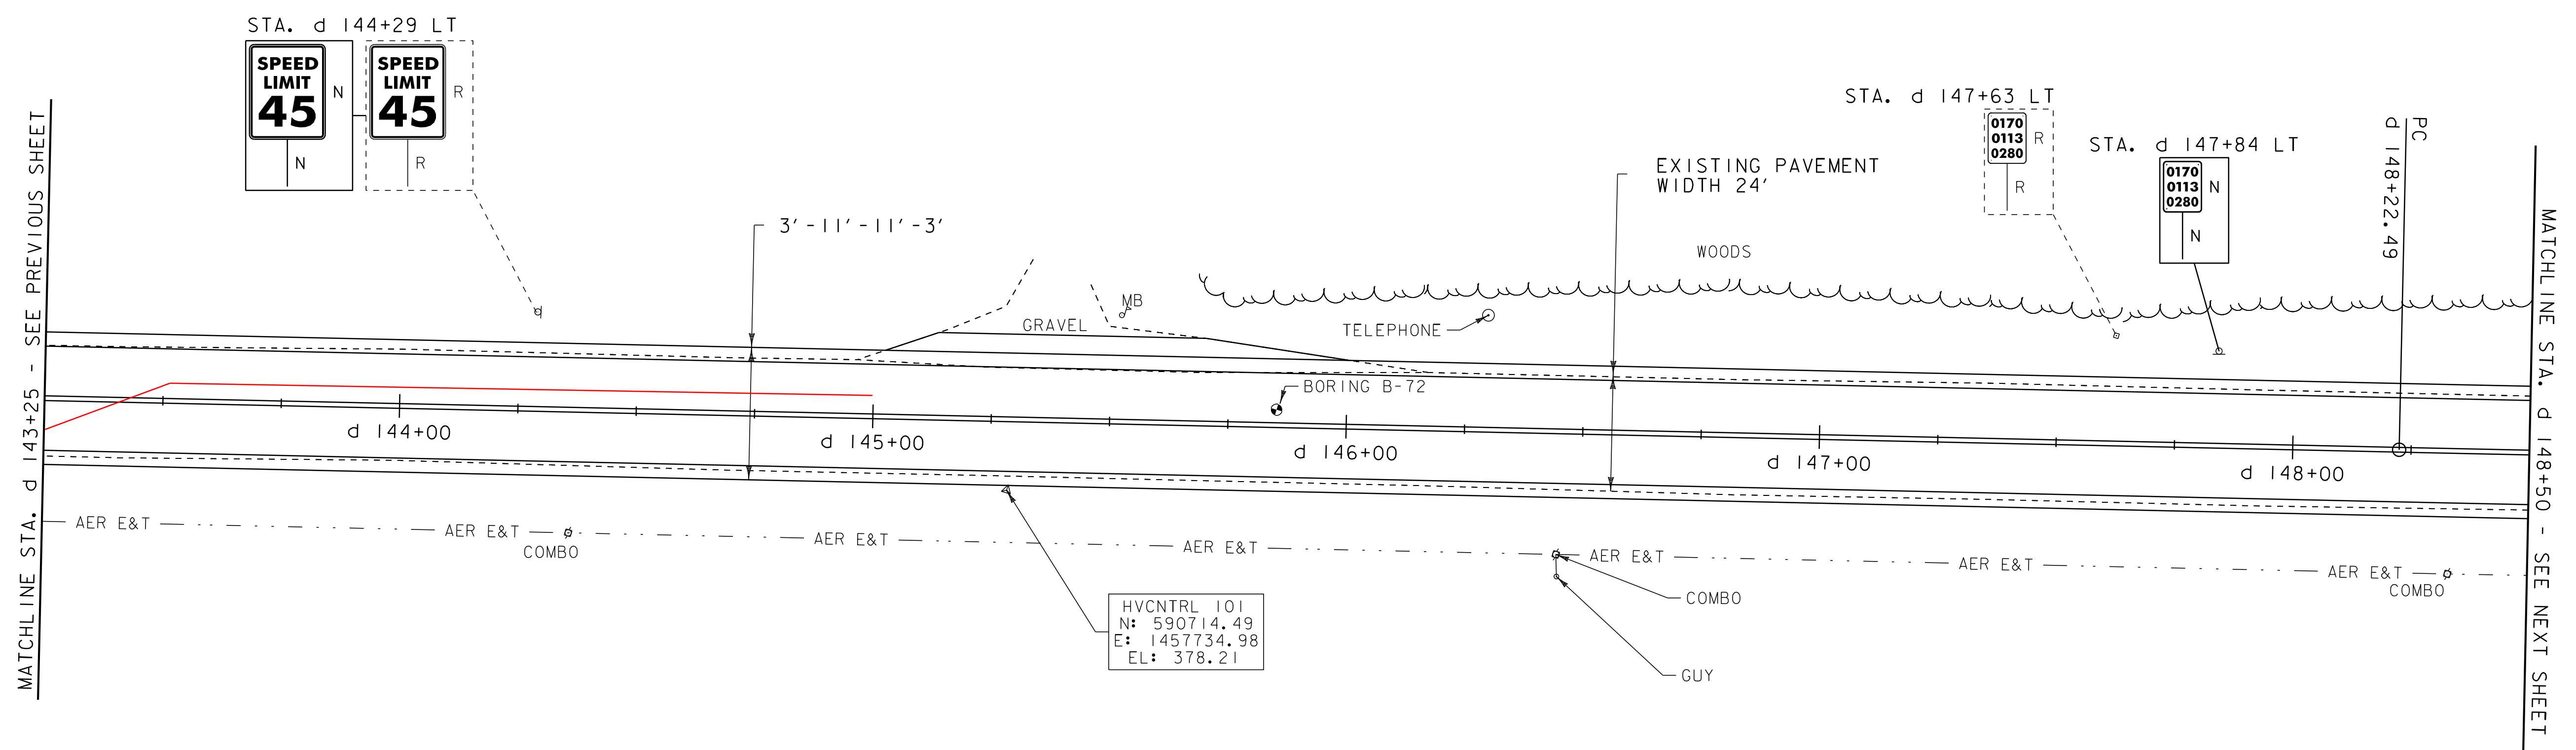

MATCHLINE STA. d 143+25 - SEE PREVIOUS SHEET


MATCHLINE STA. d 148+50 - SEE NEXT SHEET

REMOVING SIGNS  
 AS SHOWN - 2

- LEGEND**
- SIGN
  - HYDRANT
  - MANHOLE
  - GATE VALVE
  - GAS PIPELINE MARKER
  - CATCH BASIN / DROP INLET
  - CURB INLET
  - ⊙ BORING LOCATION
  - ♣ MAILBOX
  - UTILITY POLE
  - FLUSHING BASIN

- SIGN LEGEND**
- R = REMOVE
  - R&S = REMOVE AND SALVAGE
  - RET = RETAIN
  - S = SALVAGE
  - N = NEW
  - B-B = BACK TO BACK

DATUM  
 NAVD 88  
 NAD 83

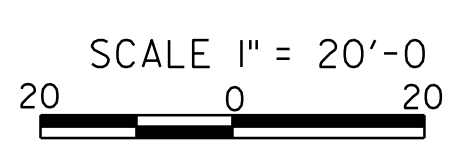

<b>PROJECT LAYOUT SHEET 62</b>	PROJECT NAME: ADDISON - NEW HAVEN	
	PROJECT NUMBER: STP 9632(1)	
	FILE NAME: p95B076.dgn	PLOT DATE: 3/13/2012
PROJECT LEADER: CDL	DRAWN BY: SJL	
DESIGNED BY: SJL	CHECKED BY: EPD	
PLOT FILE: p95B076_85.1	SHEET 85 OF 186	