

DURABLE 4 INCH WHITE LINE (SEE OPTION ITEMS)
 STA. d 159+75 - STA. d 165+50 (SOLID LT & RT)
 (WITH EDGELINE BREAKS AT TH #21)
 STA. d 161+40 RT (EDGELINES TH #21)

TEMPORARY 4 INCH WHITE LINE, PAINT
 STA. d 159+75 - STA. d 165+50 (SOLID LT & RT)
 (WITH EDGELINE BREAKS AT TH #21)
 STA. d 161+40 RT (EDGELINES TH #21)

DURABLE 4 INCH YELLOW LINE (SEE OPTION ITEMS)
 STA. d 159+75 - STA. d 165+50 (SOLID LT & RT)
 (WITH CENTERLINE BREAKS AT TH #21)
 STA. d 161+40 RT (CENTERLINE TH #21)

TEMPORARY 4 INCH YELLOW LINE, PAINT
 STA. d 159+75 - STA. d 165+50 (SOLID LT & RT)
 (WITH CENTERLINE BREAKS AT TH #21)
 STA. d 161+40 RT (CENTERLINE TH #21)

CURVE #32
 DELTA = 31°02'13"
 D = 9°42'40"
 R = 590.00'
 T = 163.83'
 L = 319.60'
 BANKING 0.08 FT/FT
 180' RUNOFF (45 MPH)
 SEE SUPERELEVATION DIAGRAMS
 FOR BANKING INFORMATION

STONE FILL, TYPE I
 STA. d 163+50 - STA. d 165+00 RT

GRUBBING MATERIAL
 STA. d 163+50 - STA. d 165+00 RT

GEOTEXTILE FOR SILT FENCE
 STA. d 163+50 - STA. d 165+00 RT

GEOTEXTILE UNDER STONE FILL
 STA. d 163+50 - STA. d 165+00 RT

6 INCH UNDERDRAIN PIPE
 STA. d ~~161+00~~ - STA. d ~~165+00~~ LT
 161+07 165+10



6 INCH UNDERDRAIN CARRIER PIPE
 STA. d 161+00 LT
 STA. d 163+00 LT

UNDERDRAIN FLUSHING BASIN
 STA. d ~~161+00~~ LT
 STA. d ~~163+00~~ LT
 D 161+07 LT

TEMPORARY 24 INCH STOP BAR, PAINT
 STA. d 161+43 - STA. d 161+66 RT (TH #21)
TEMPORARY LETTER OR SYMBOL, PAINT
 STA. d 161+46 RT "STOP" (TH #21)

DURABLE 24 INCH STOP BAR (SEE OPTION ITEMS)
 STA. d 161+43 - STA. d 161+66 RT (TH #21)
DURABLE LETTER OR SYMBOL (SEE OPTION ITEMS)
 STA. d 161+46 RT "STOP" (TH #21)

REMOVING AND RESETTING FENCE
 STA. d 163+27 - STA. d 164+66 RT

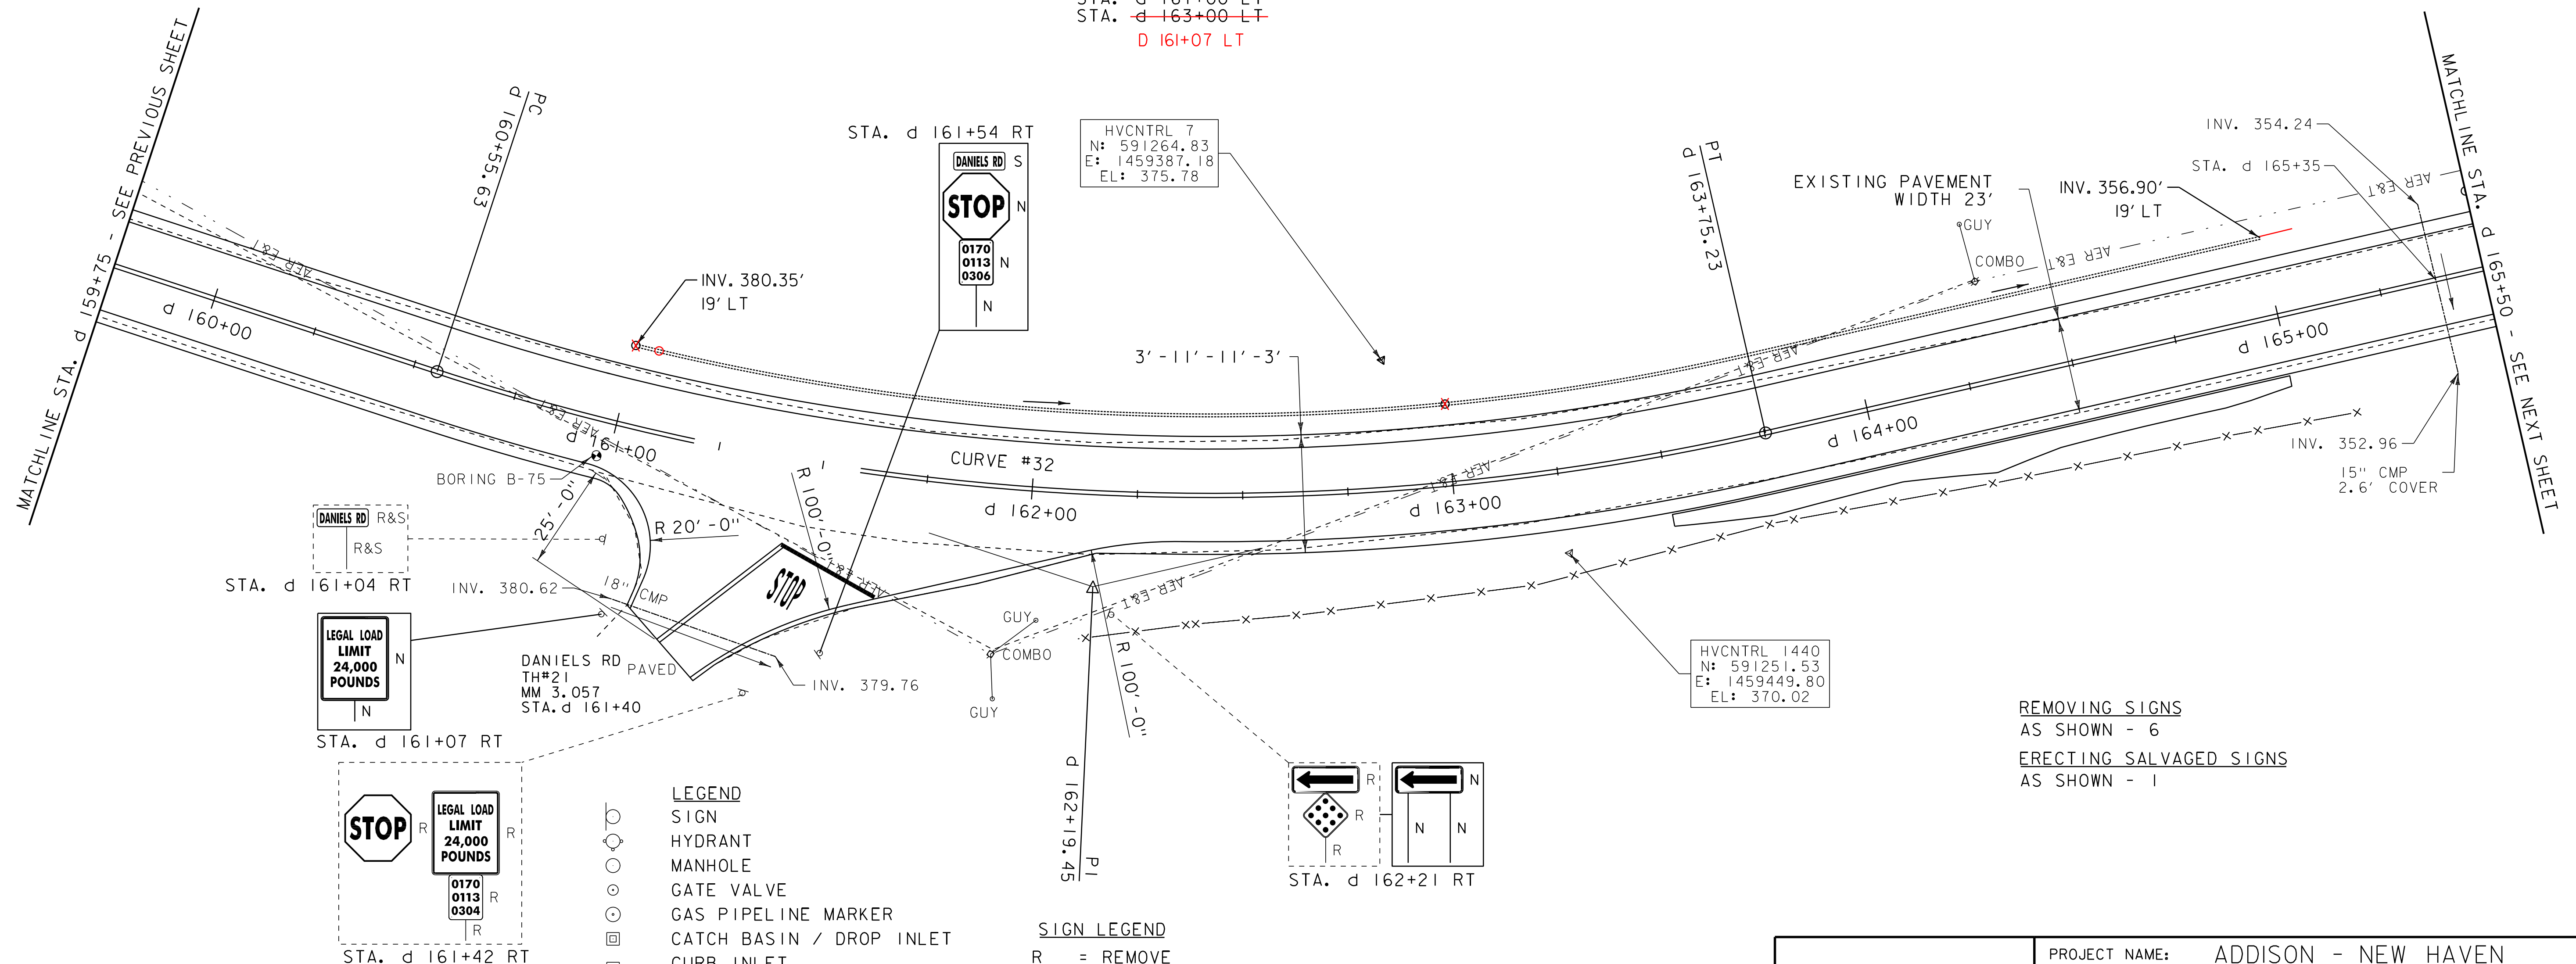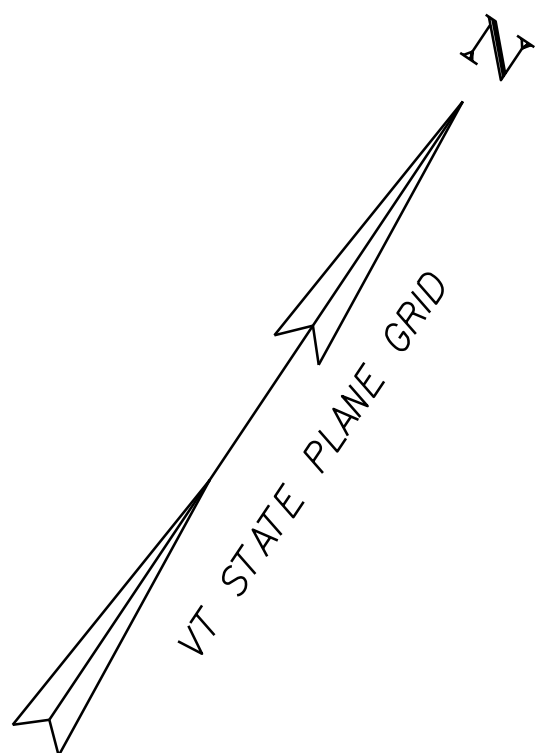

REMOVING SIGNS
 AS SHOWN - 6
ERECTING SALVAGED SIGNS
 AS SHOWN - 1

- LEGEND**
- SIGN
 - HYDRANT
 - MANHOLE
 - GATE VALVE
 - GAS PIPELINE MARKER
 - CATCH BASIN / DROP INLET
 - CURB INLET
 - ⊙ BORING LOCATION
 - ⊙ MAILBOX
 - UTILITY POLE
 - FLUSHING BASIN

- SIGN LEGEND**
- R = REMOVE
 - R&S = REMOVE AND SALVAGE
 - RET = RETAIN
 - S = SALVAGE
 - N = NEW
 - B-B = BACK TO BACK

DATUM
 NAVD 88
 NAD 83

SCALE 1" = 20'-0"
 20 0 20

PROJECT LAYOUT SHEET 65	PROJECT NAME: ADDISON - NEW HAVEN
	PROJECT NUMBER: STP 9632(1)
	FILE NAME: p95B076.dgn
	PLOT DATE: 3/13/2012
	PROJECT LEADER: CDL
	DESIGNED BY: SJL
	PLOT FILE: p95B076.88.1
	DRAWN BY: SJL
	CHECKED BY: EPD
	SHEET 88 OF 186