

6 INCH UNDERDRAIN PIPE
 STA. d 171+50 - STA. d 172+00 LT 172+08
 STA. d 171+50 - STA. d 172+00 RT 172+05

DURABLE 4 INCH WHITE LINE (SEE OPTION ITEMS)
 STA. d 171+50 - STA. d 177+50 (SOLID LT & RT)

TEMPORARY 4 INCH WHITE LINE, PAINT
 STA. d 171+50 - STA. d 177+50 (SOLID LT & RT)

DURABLE 4 INCH YELLOW LINE (SEE OPTION ITEMS)
 STA. d 171+50 - STA. d 177+50 (SOLID LT & RT)

TEMPORARY 4 INCH YELLOW LINE, PAINT
 STA. d 171+50 - STA. d 177+50 (SOLID LT & RT)

DURABLE LETTER OR SYMBOL (SEE OPTION ITEMS)



STA. d 174+90 RT "STOP"
 STA. d 175+30 RT "AHEAD"

TEMPORARY LETTER OR SYMBOL, PAINT

STA. d 174+90 RT "STOP"
 STA. d 175+30 RT "AHEAD"

DURABLE RAILROAD CROSSING SYMBOL (SEE OPTION ITEMS)
 STA. d 177+09 RT RR SYMBOL

TEMPORARY RAILROAD CROSSING SYMBOL, PAINT
 STA. d 177+09 RT RR SYMBOL

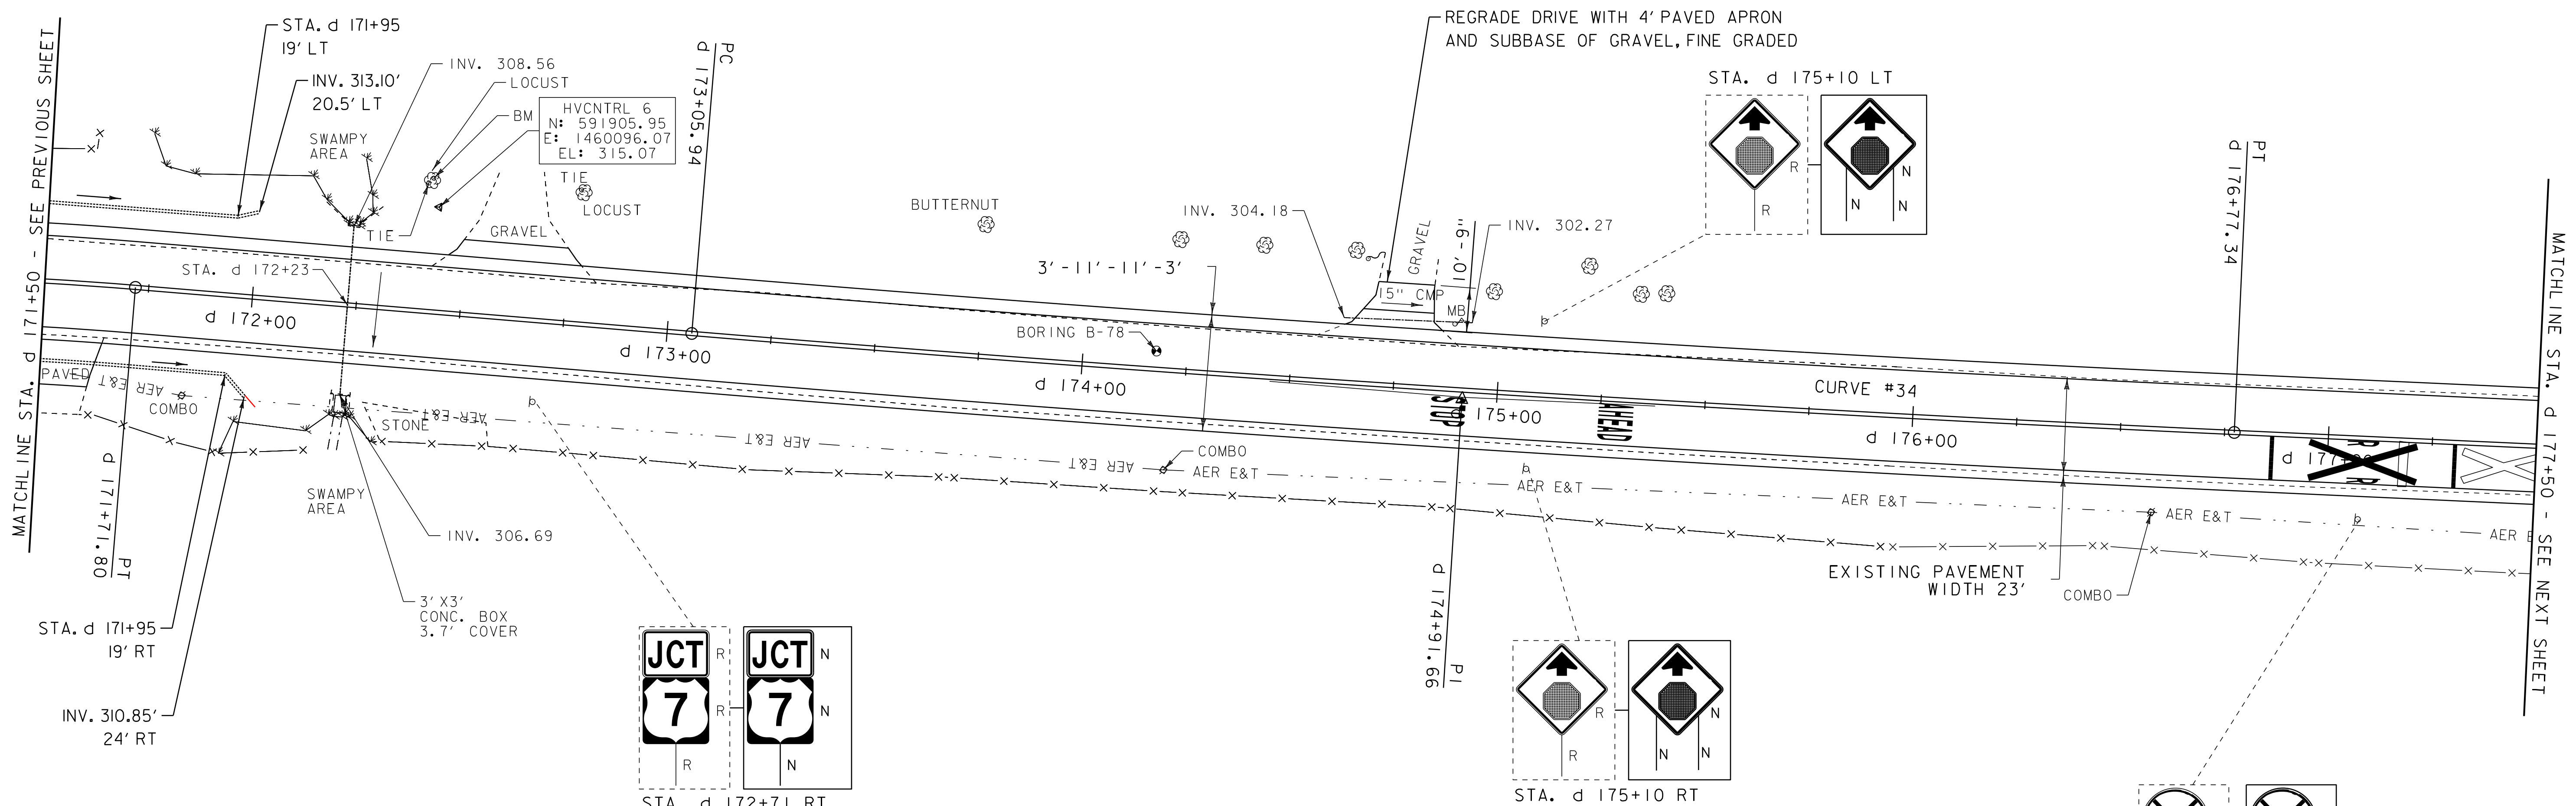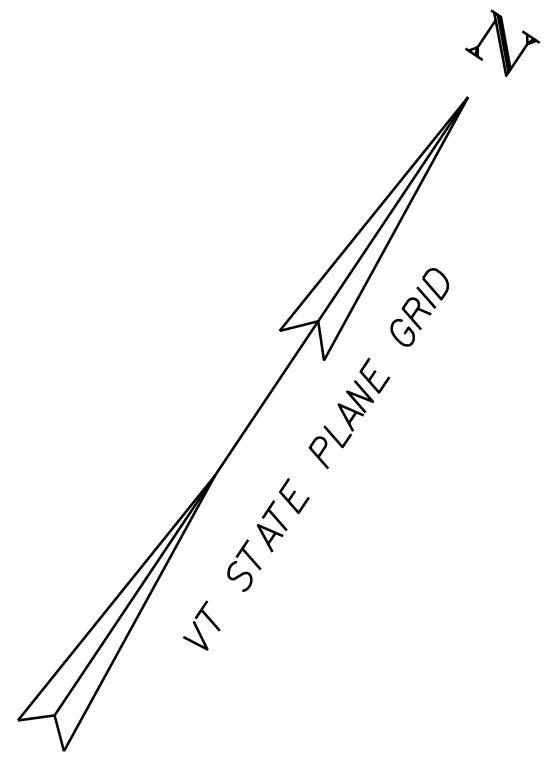

ENVIRONMENTALLY SENSITIVE LOCATIONS:

NO.	LIMITS	POS.	TYPE
34.	STA. d 171+75 - STA. d 172+50	LT	EM
	STA. d 171+75 - STA. d 172+50	RT	EM

KEY:
 EM - EMERGENT WETLAND
 FO - FORESTED WETLAND
 SS - SCRUB-SHRUB WETLAND

- LEGEND**
- SIGN
 - HYDRANT
 - MANHOLE
 - GATE VALVE
 - GAS PIPELINE MARKER
 - CATCH BASIN / DROP INLET
 - CURB INLET
 - ⊕ BORING LOCATION
 - ⌘ MAILBOX
 - ⌘ UTILITY POLE
 - ⊙ FLUSHING BASIN


CURVE #34
 DELTA = 2°07'41"
 D = 0°34'23"
 R = 10000.00'
 T = 185.72'
 L = 371.40'
 NORMAL CROWN

- SIGN LEGEND**
- R = REMOVE
 - R&S = REMOVE AND SALVAGE
 - RET = RETAIN
 - S = SALVAGE
 - N = NEW
 - B-B = BACK TO BACK

REMOVING SIGNS
 AS SHOWN - 5

DATUM

NAVD 88
NAD 83

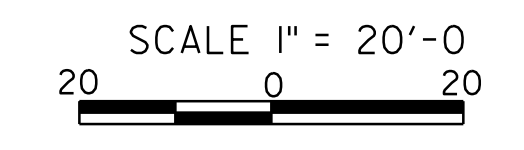

PROJECT LAYOUT SHEET 67	PROJECT NAME: ADDISON - NEW HAVEN	PLOT DATE: 3/13/2012
	PROJECT NUMBER: STP 9632(1)	DRAWN BY: SJL
	FILE NAME: p95B076.dgn	CHECKED BY: EPD
	PROJECT LEADER: CDL	SHEET 90 OF 186
	DESIGNED BY: SJL	
	PLOT FILE: p95B076_90.i	