




448+00

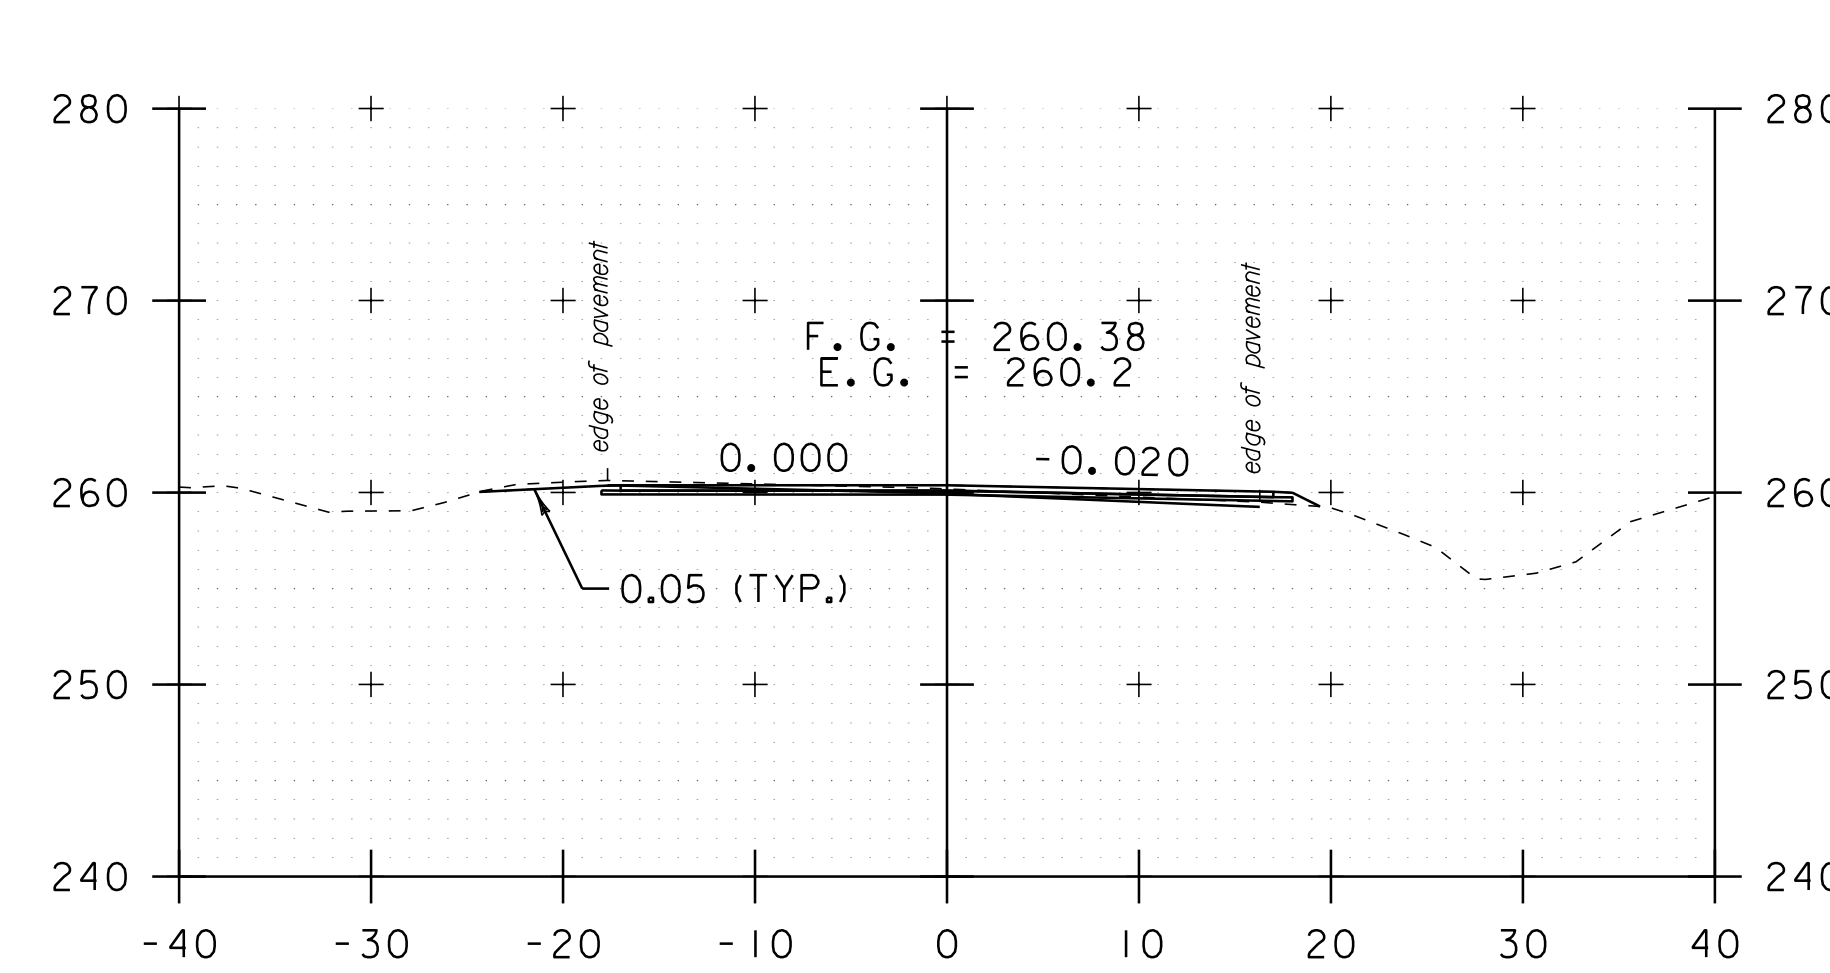


449+45

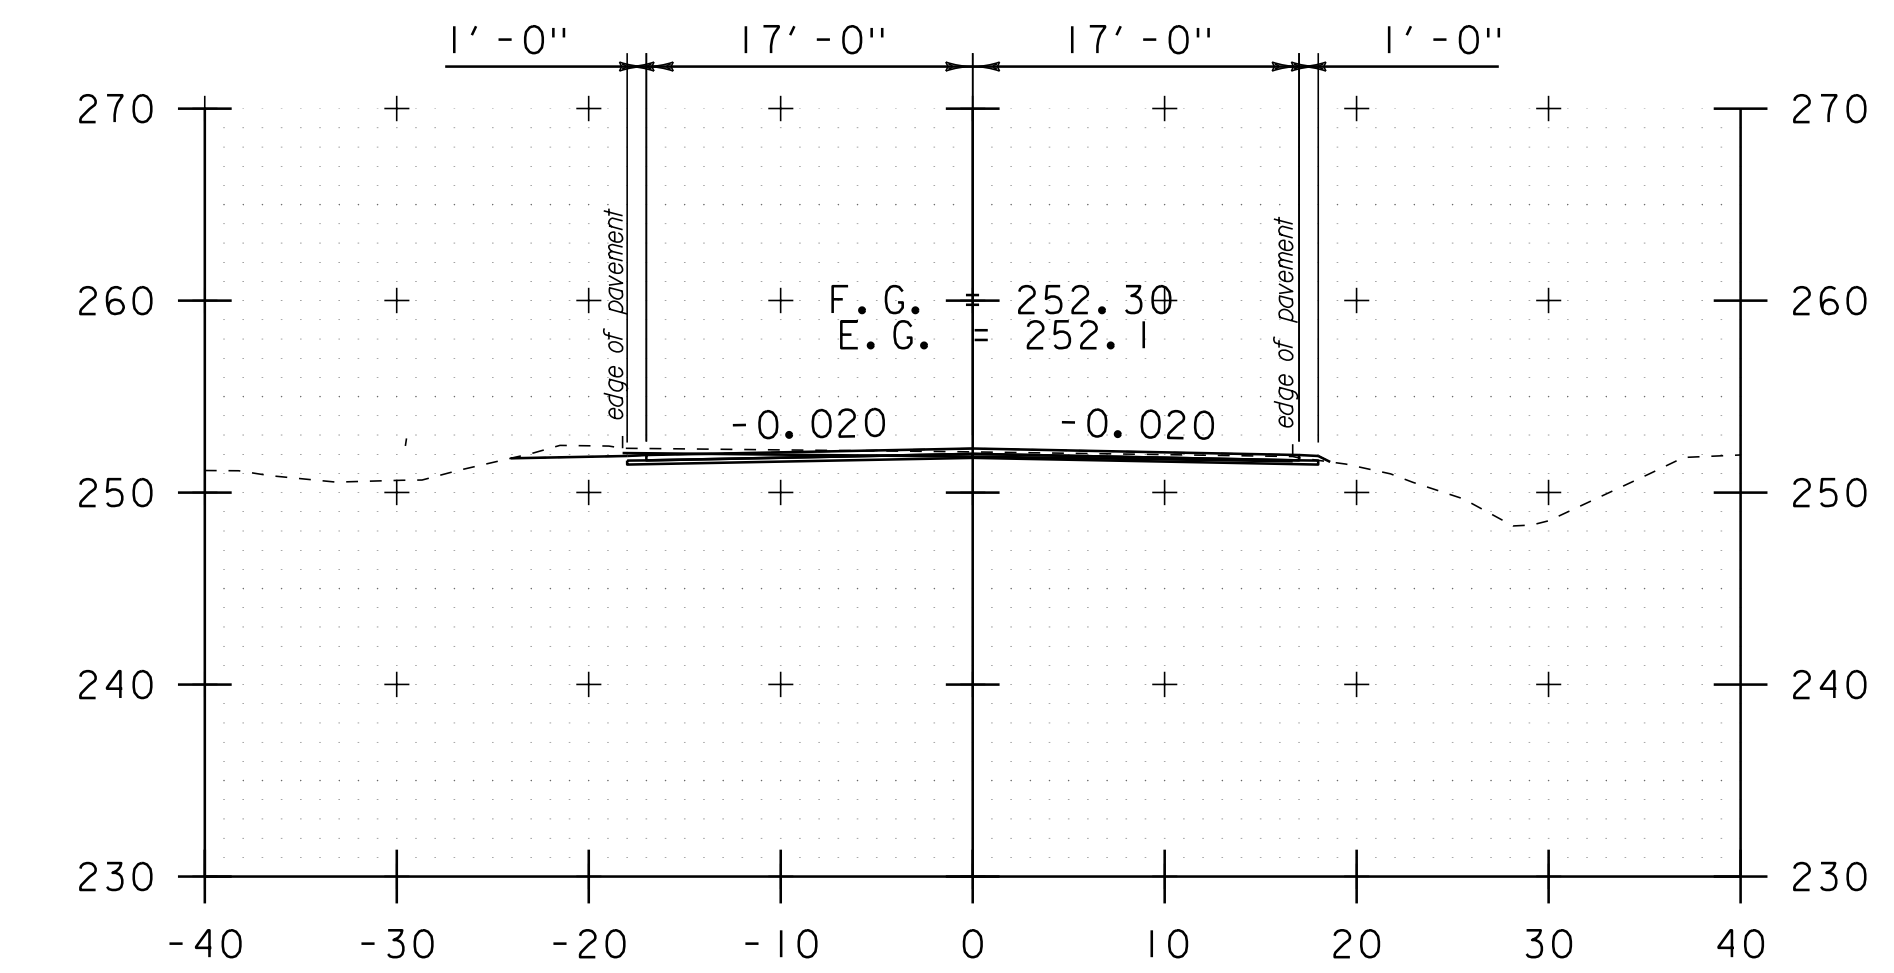


450+50

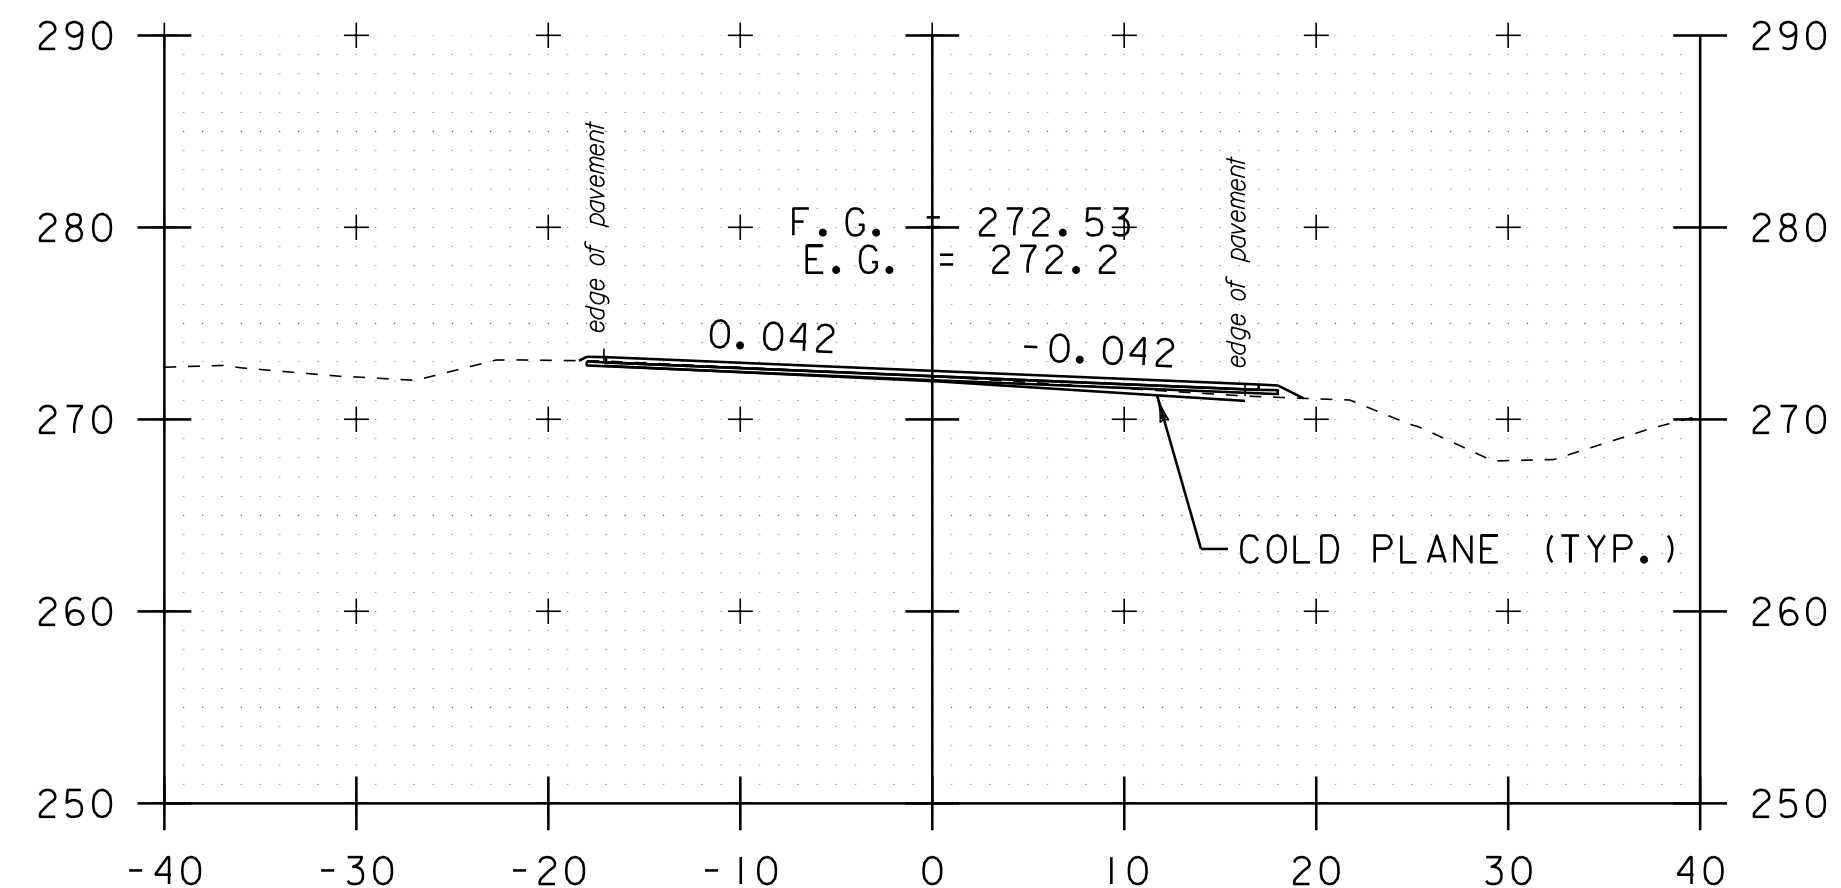


447+50

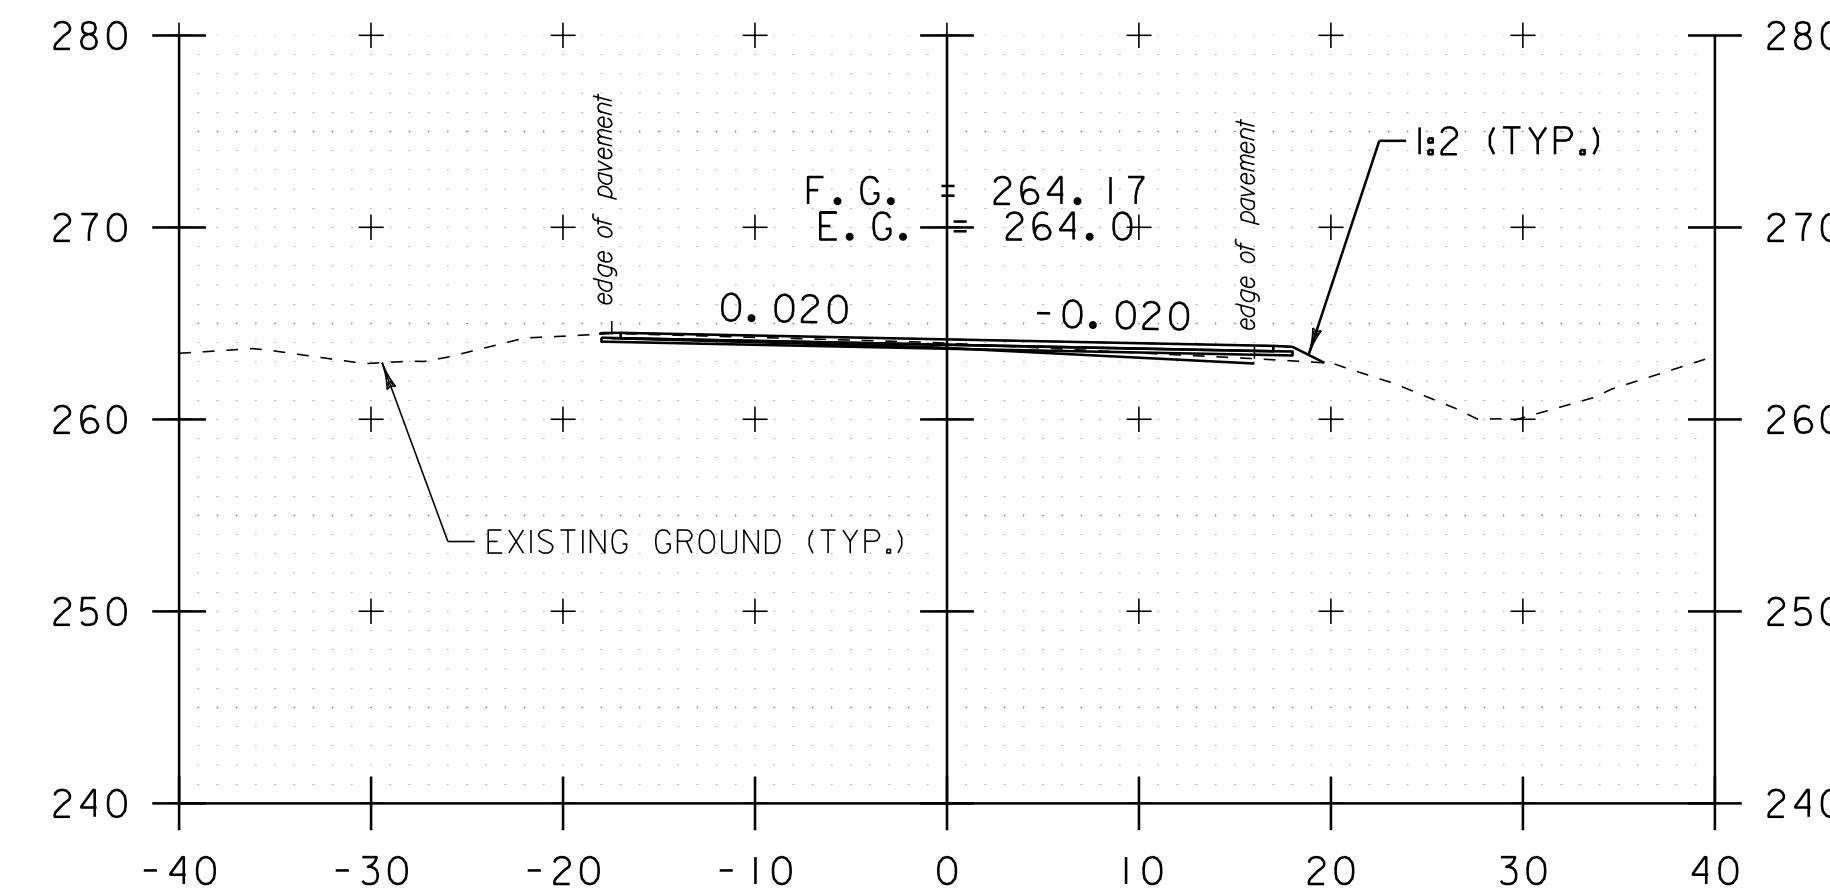


448+90

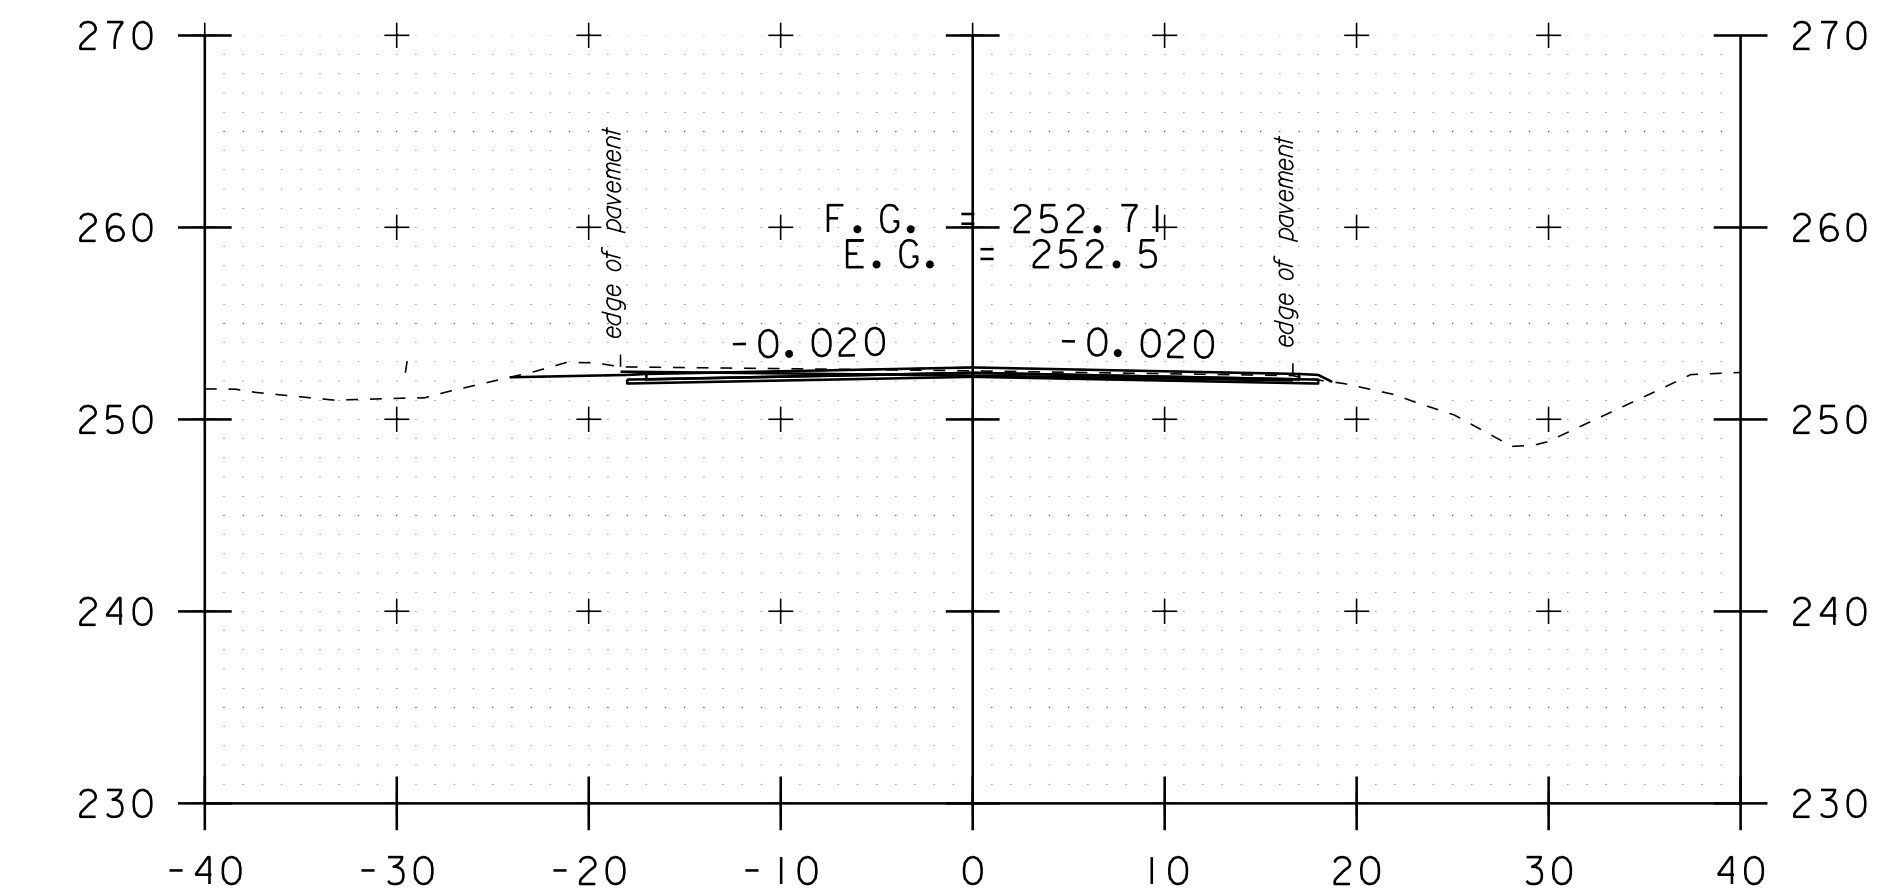


450+45

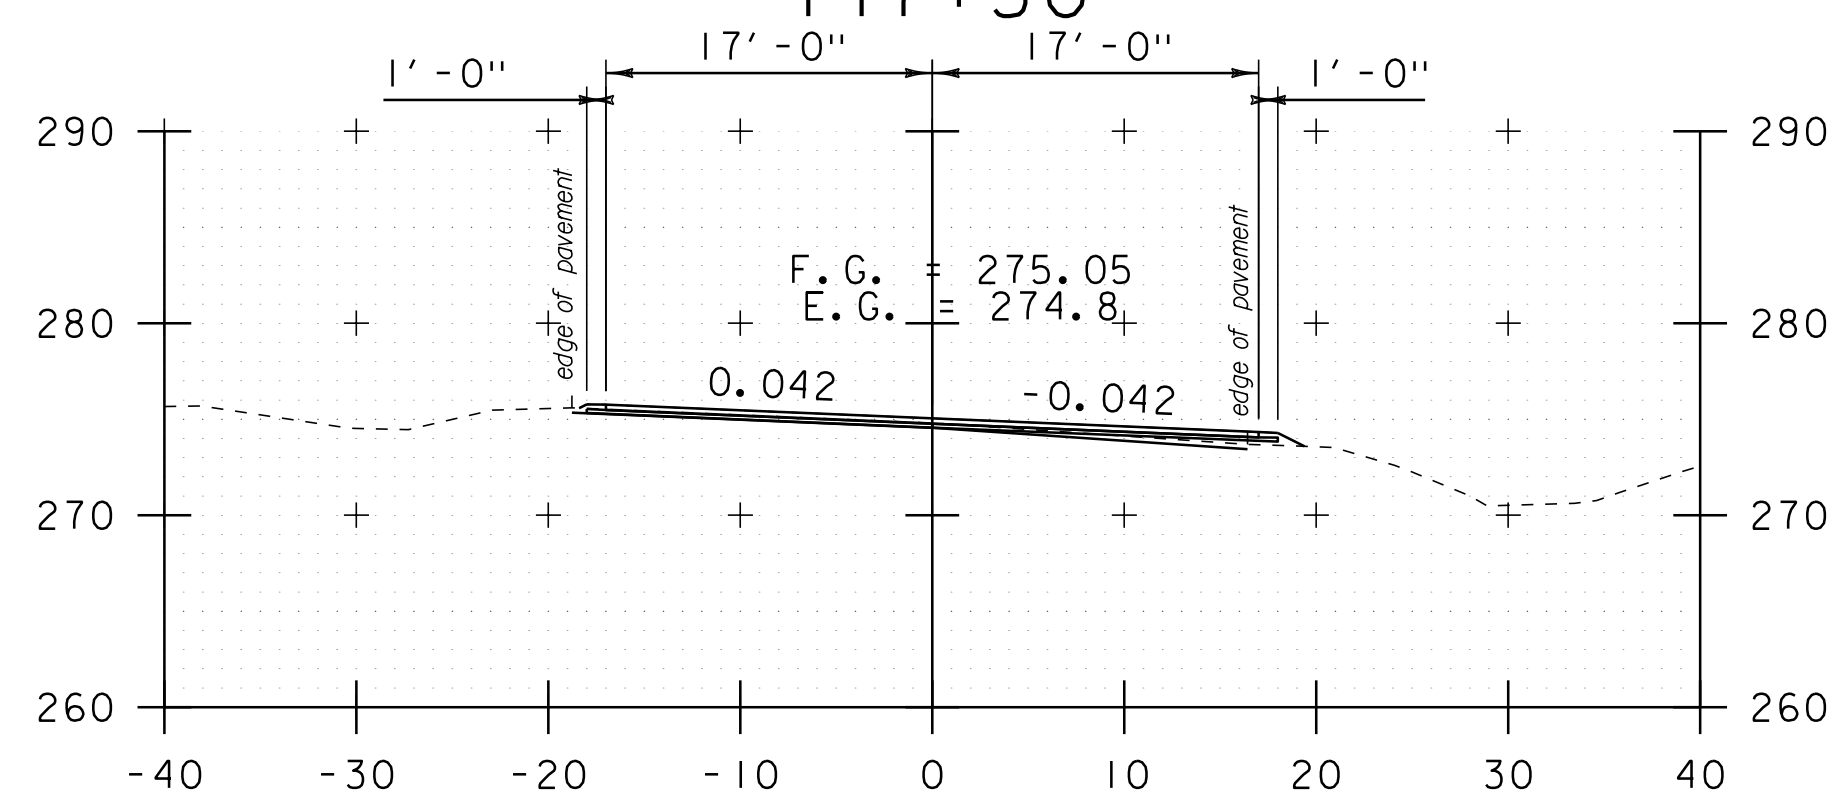

447+00

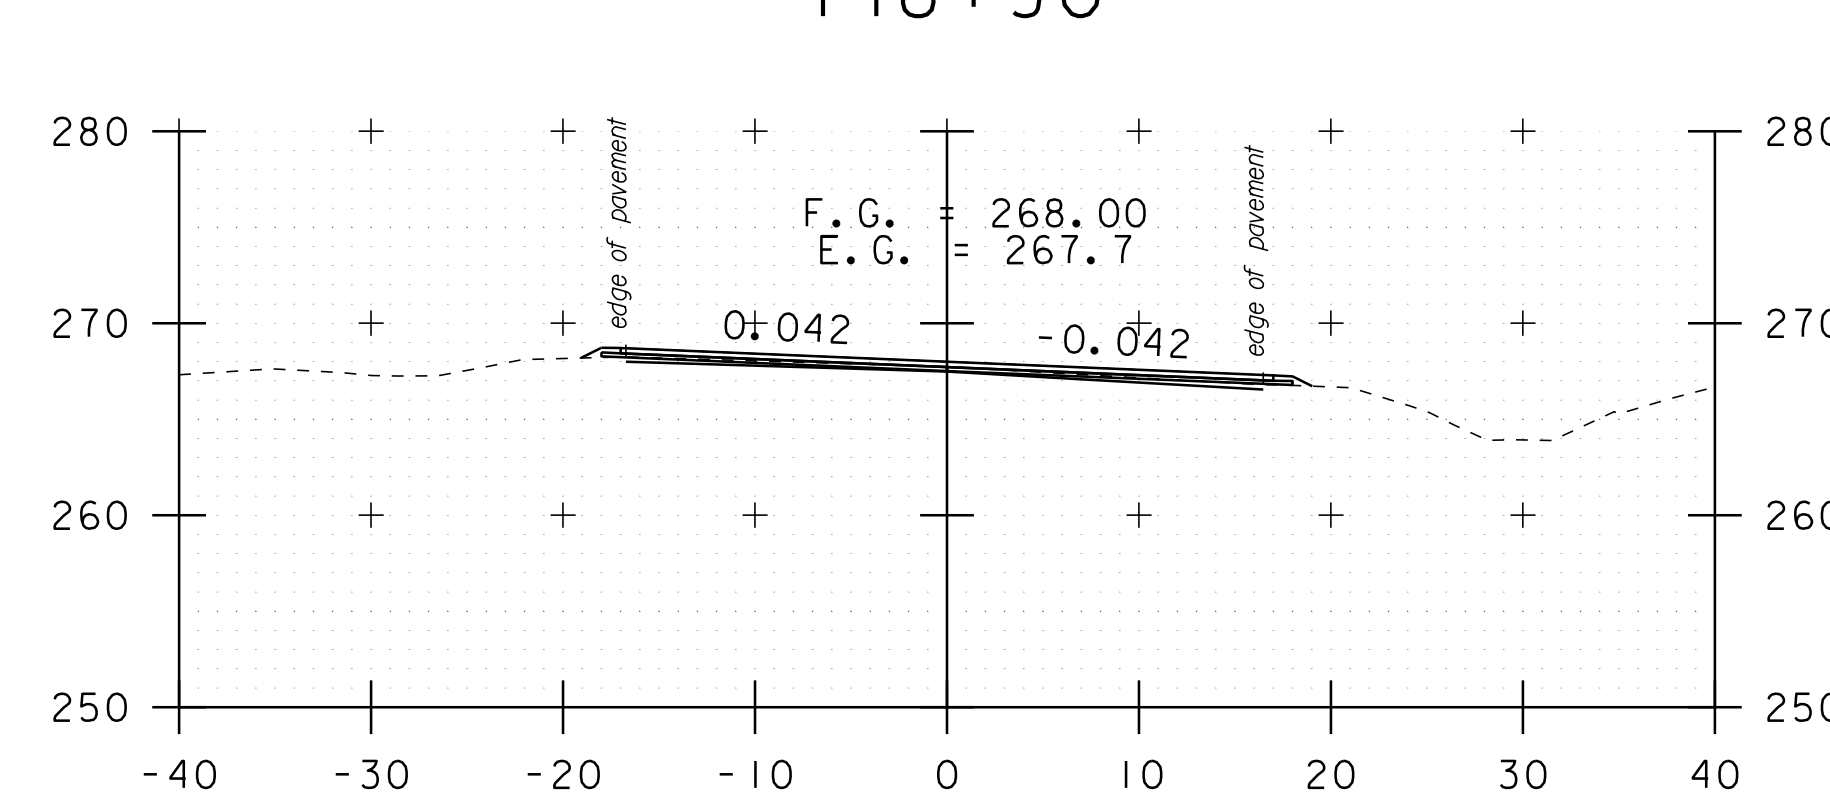


448+30

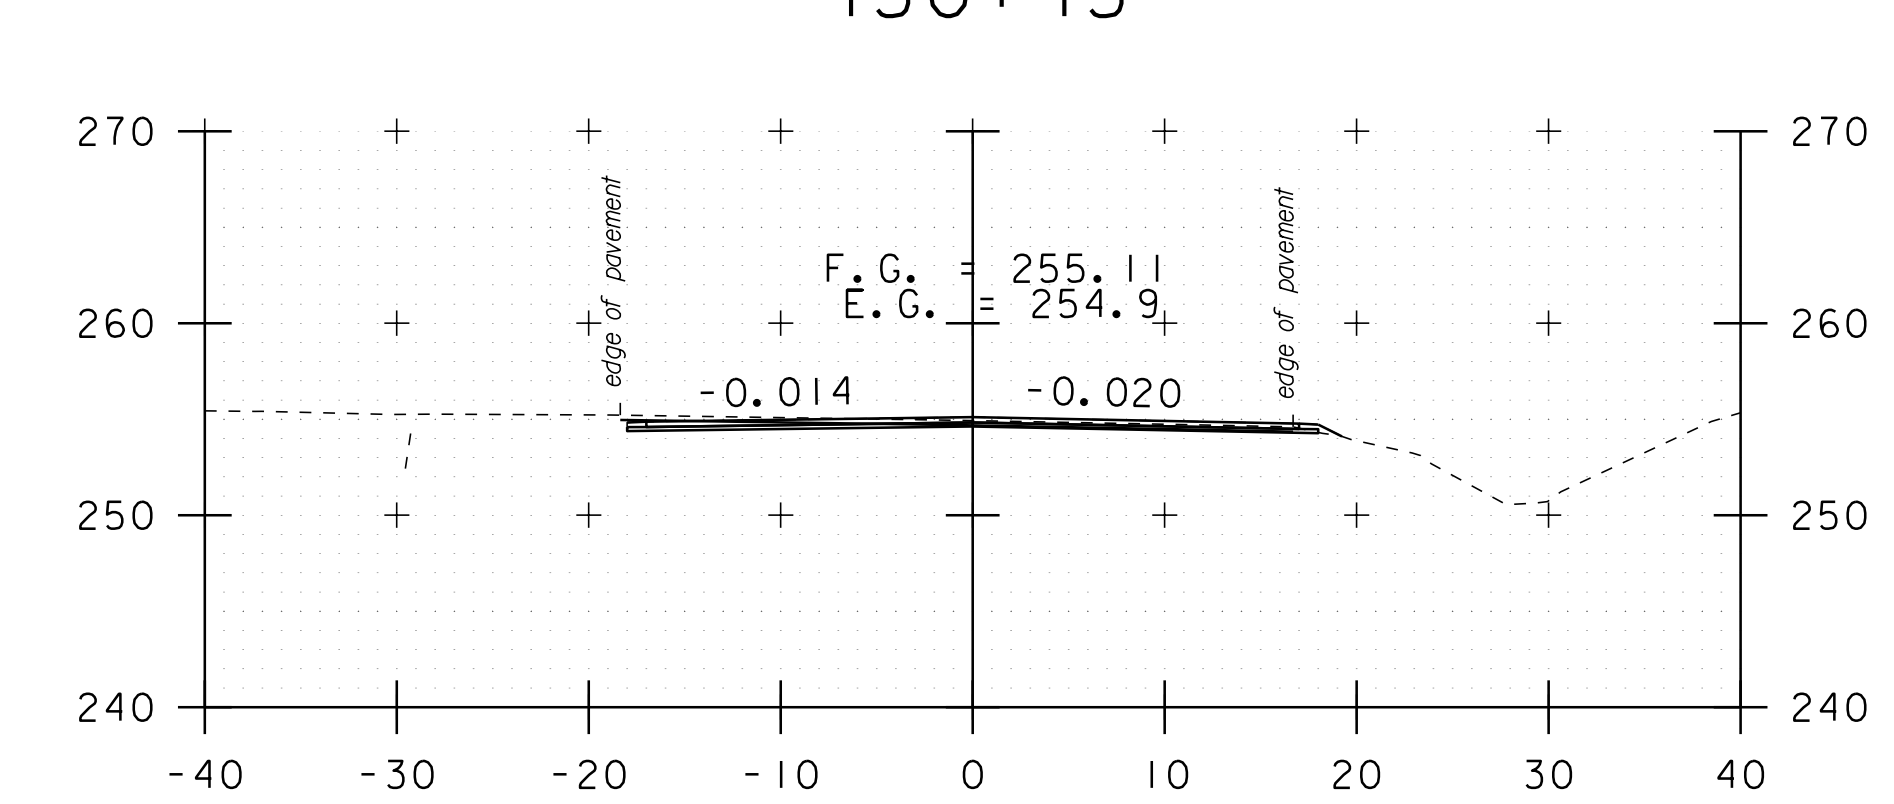

450+15
DRIVE LT

DATUM	NAVD 88
	NAD 83

STA. 447+00 TO STA. 450+50

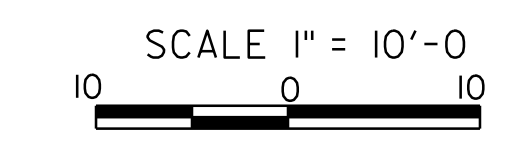

CROSS SECTION SHEET 2

PROJECT NAME:	ADDISON-NEW HAVEN
PROJECT NUMBER:	STP 9632(1)
FILE NAME:	p95B076.dgn
PROJECT LEADER:	CDL
DESIGNED BY:	SJL
PLOT FILE:	p95B076_107.1
PLOT DATE:	3/13/2012
DRAWN BY:	SJL
CHECKED BY:	EPD
SHEET	107 OF 186