




485+65

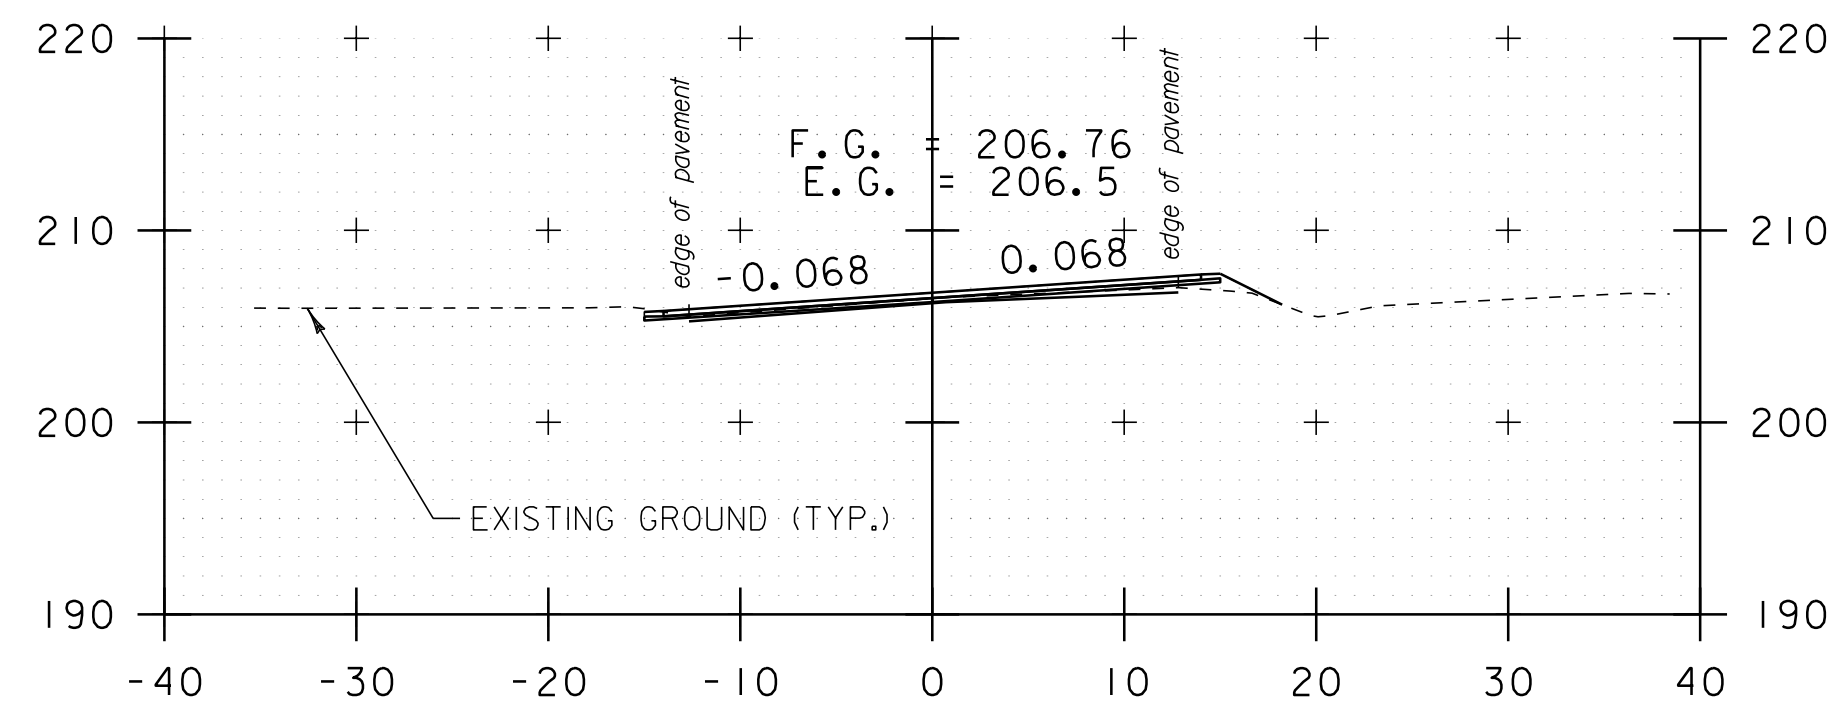


485+59

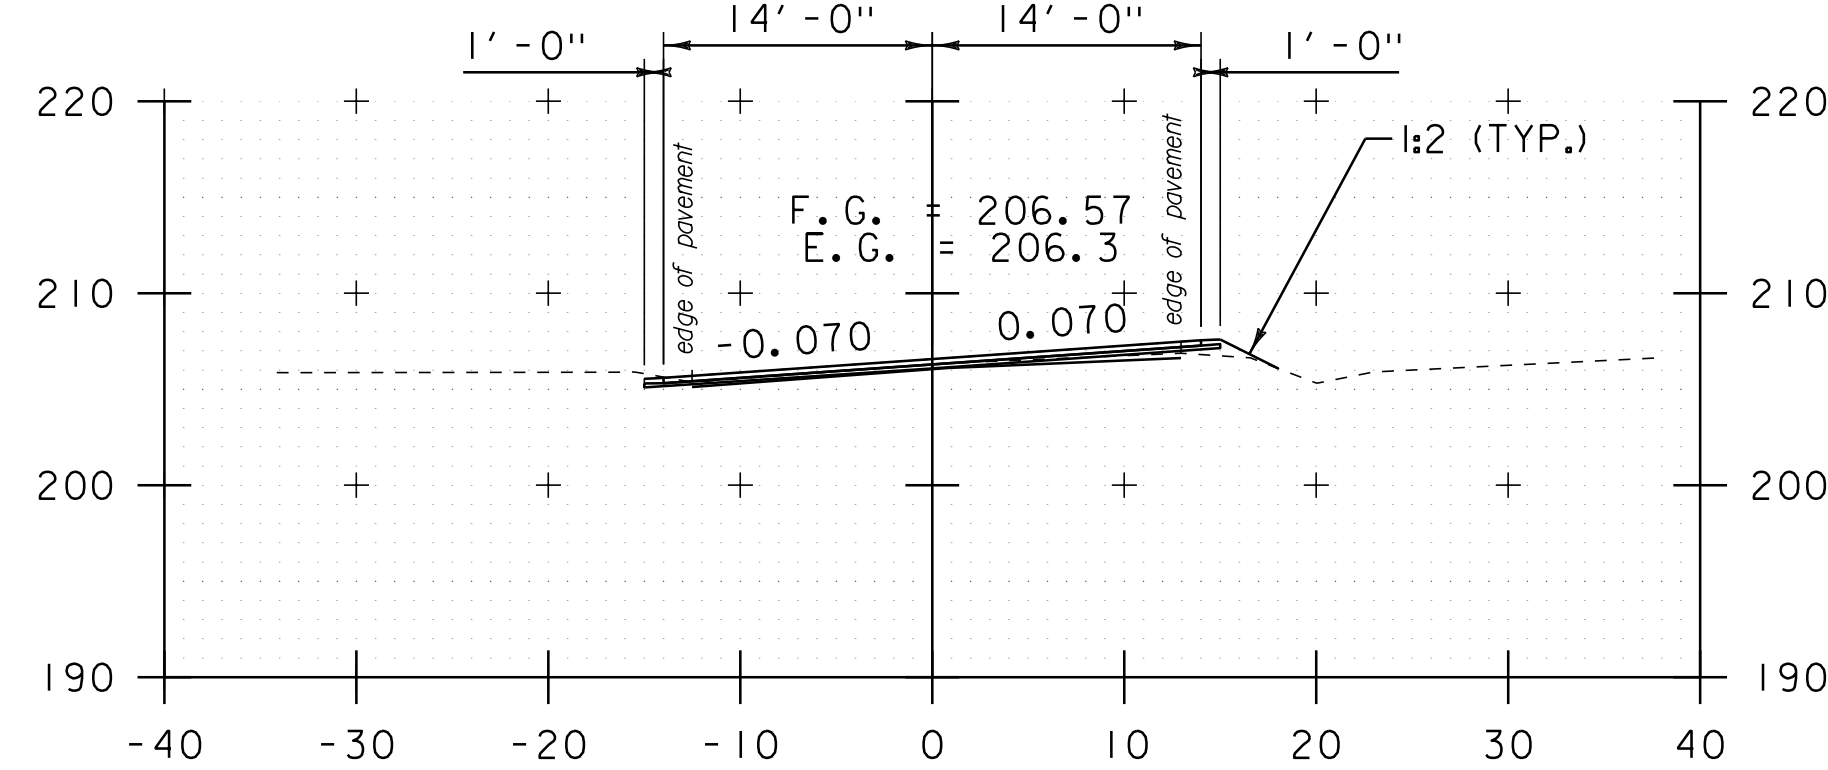


485+55

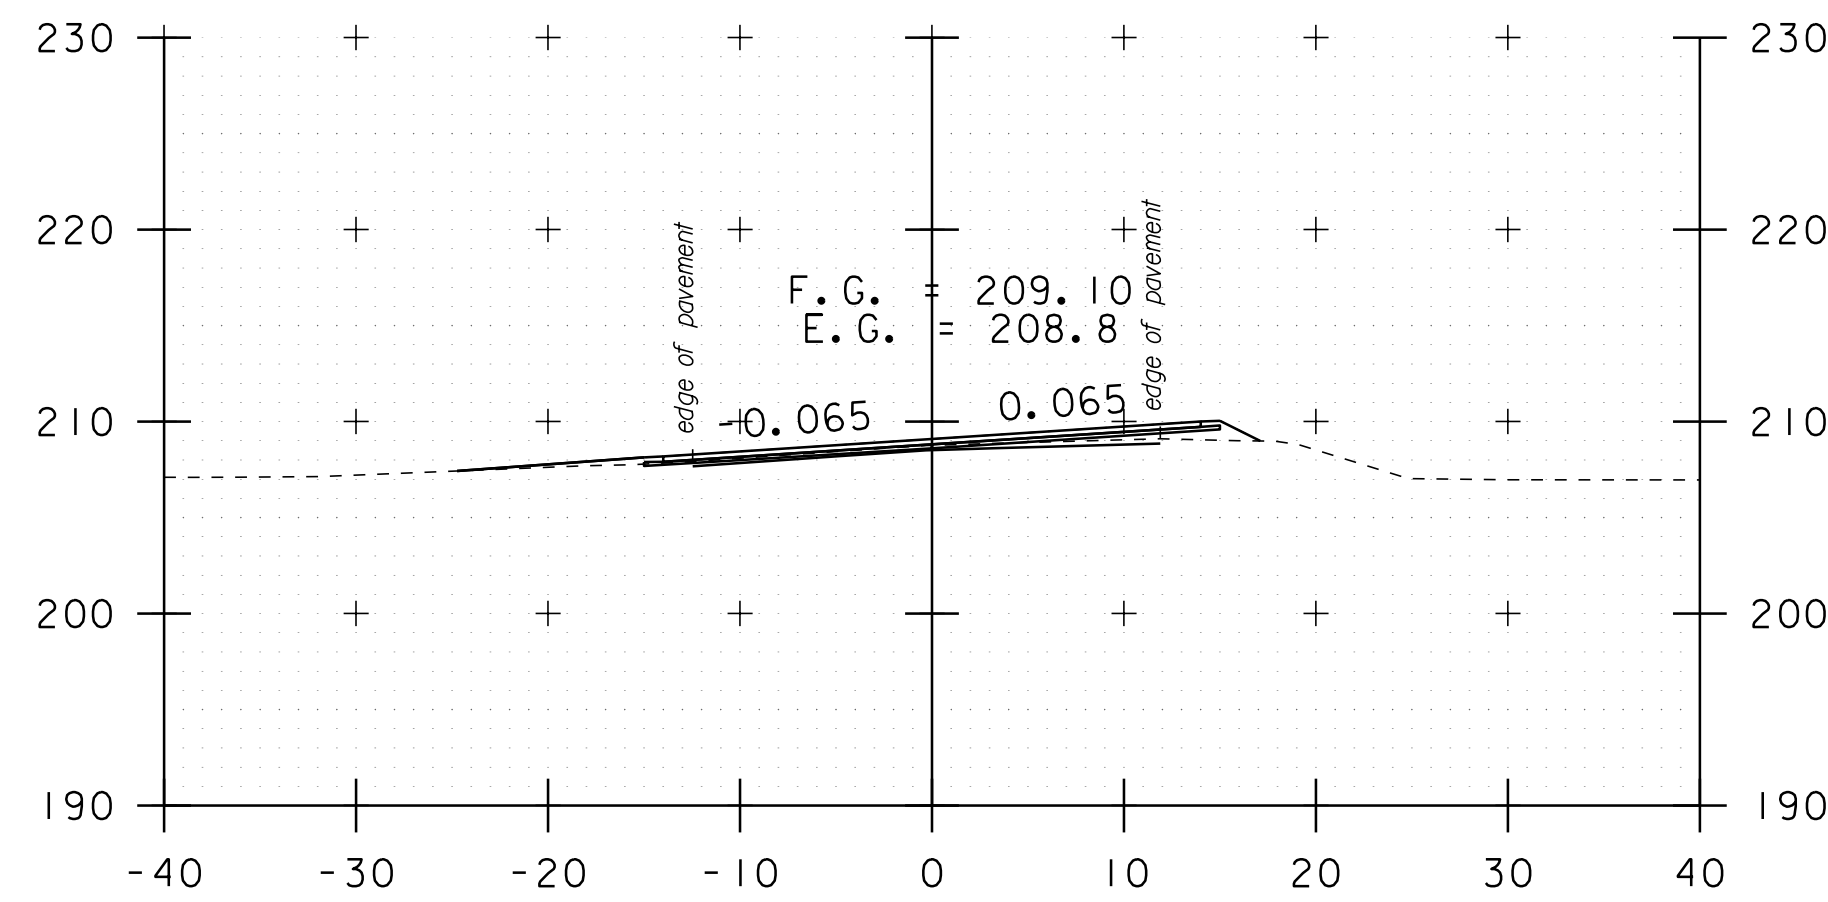


486+80  
DRIVE LT

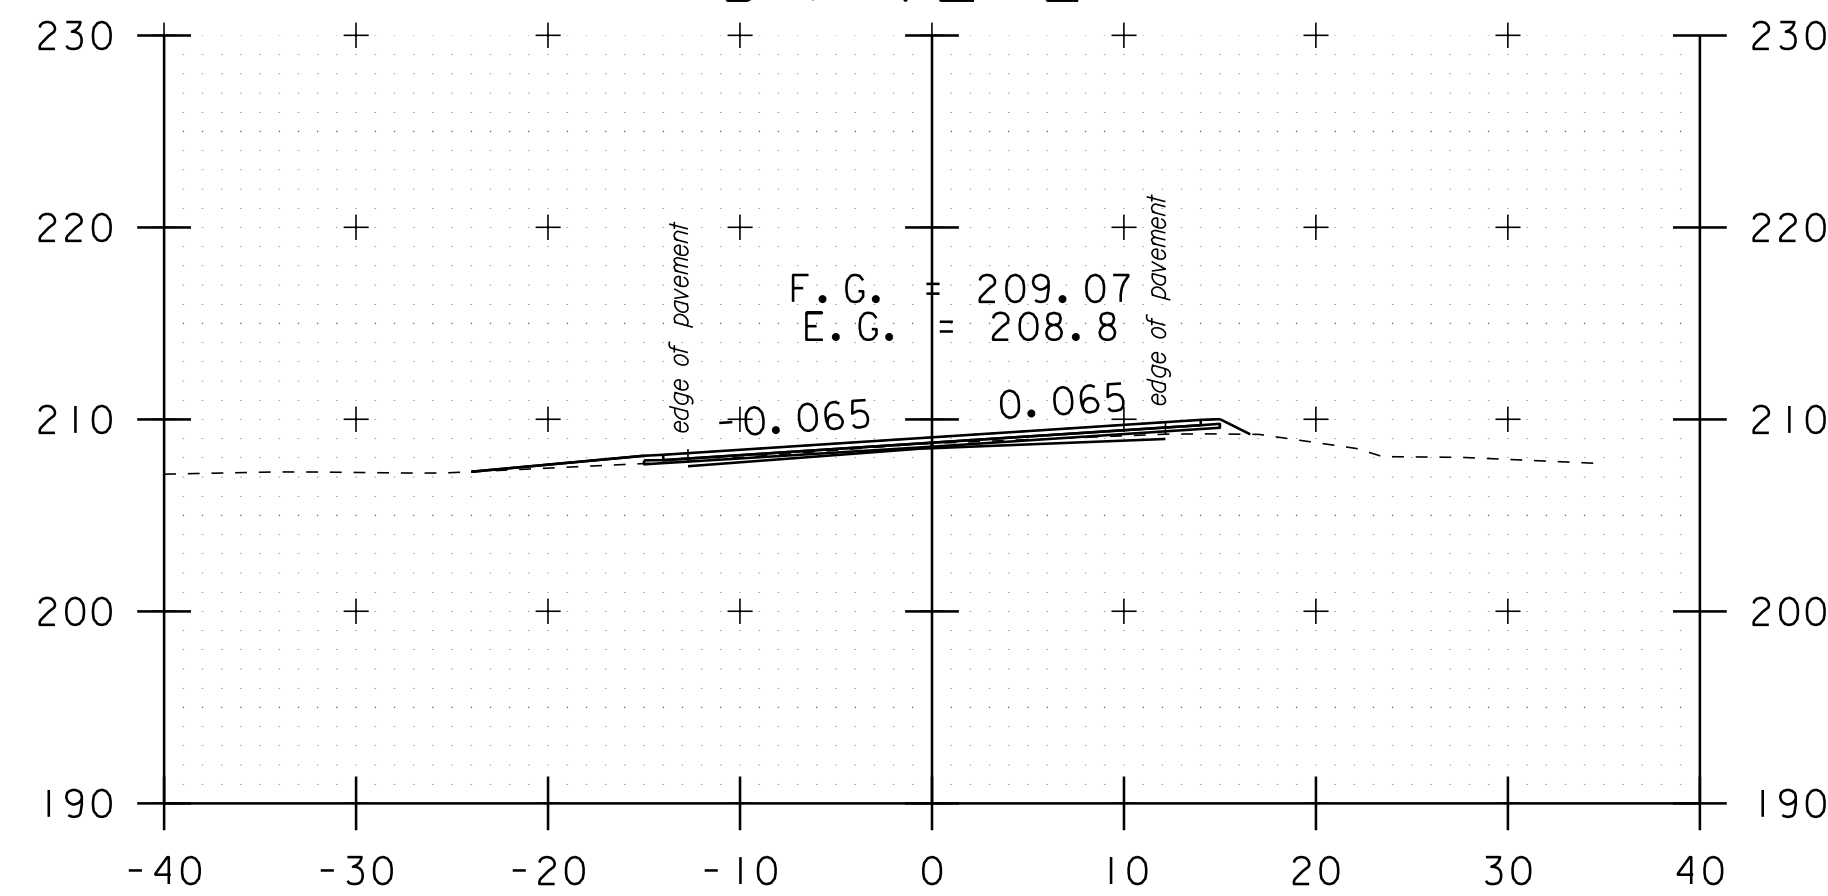


486+50  
DRIVE LT

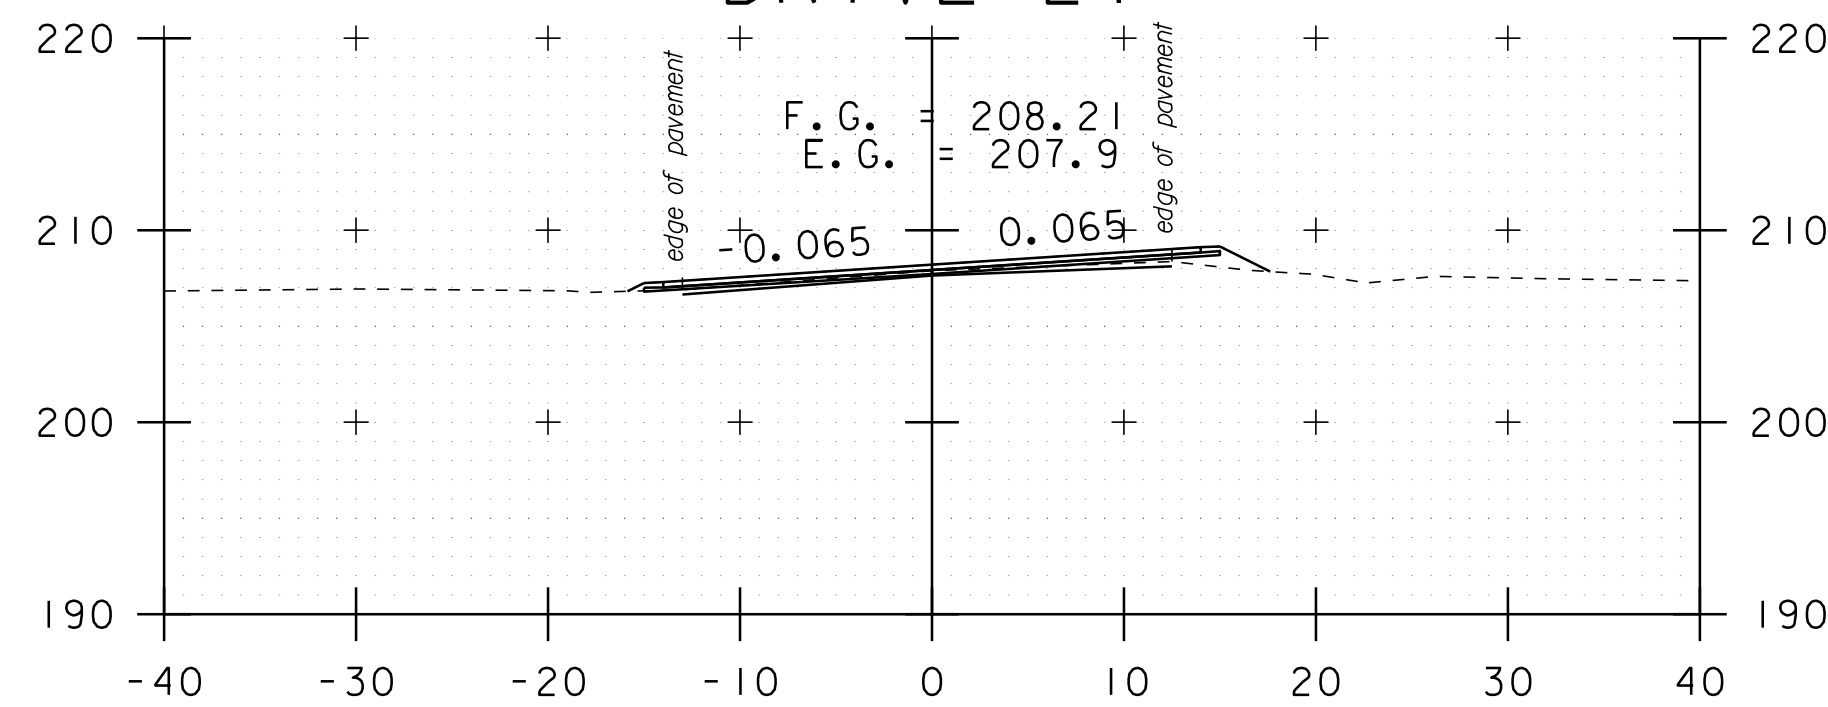


486+00

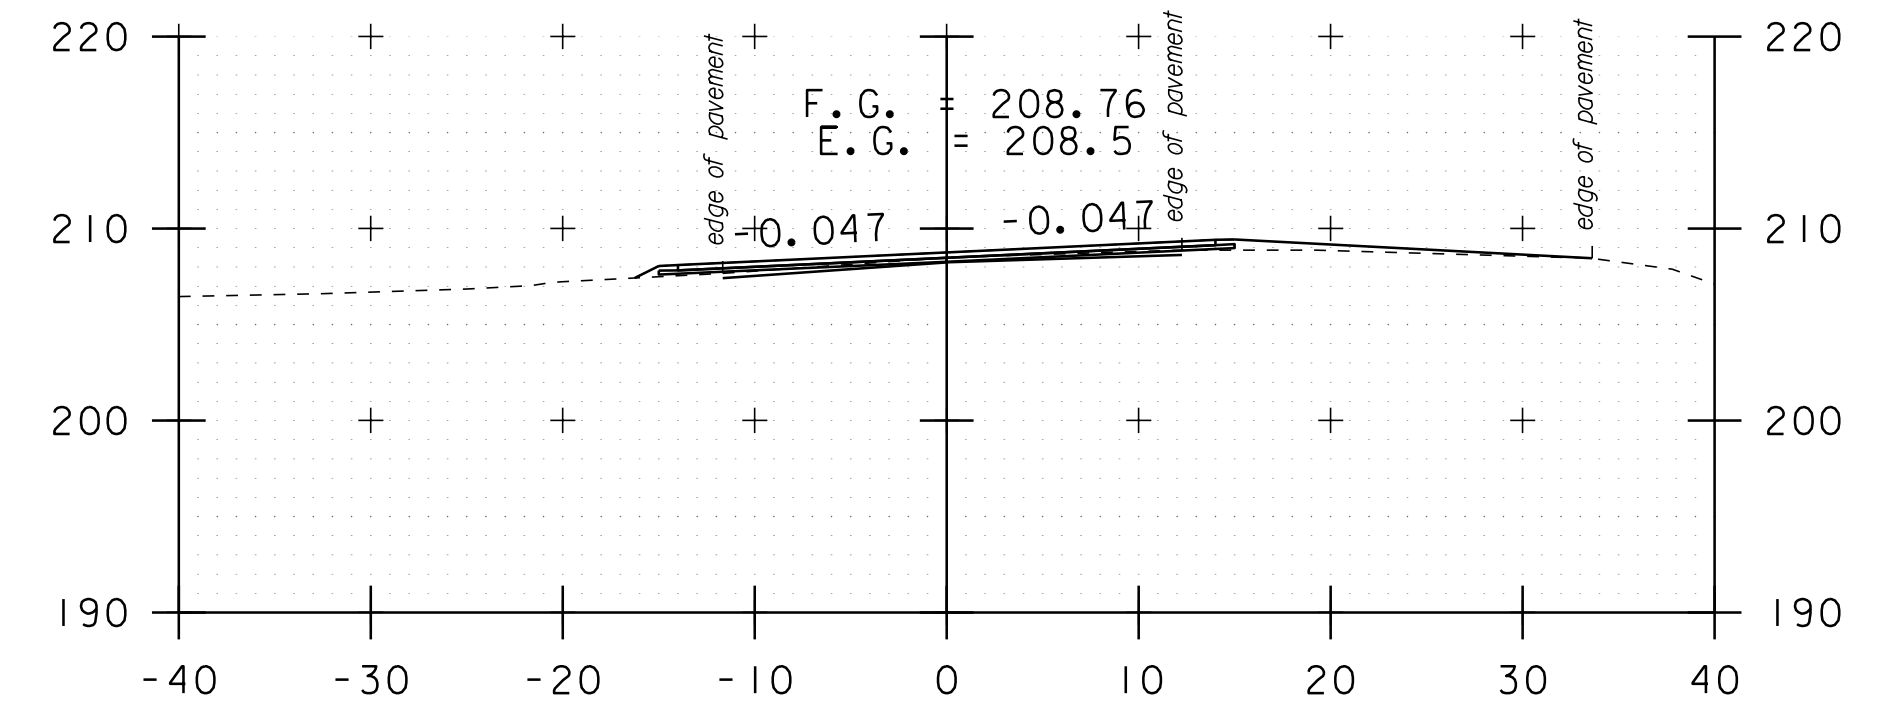

487+16  
TH#5 RT

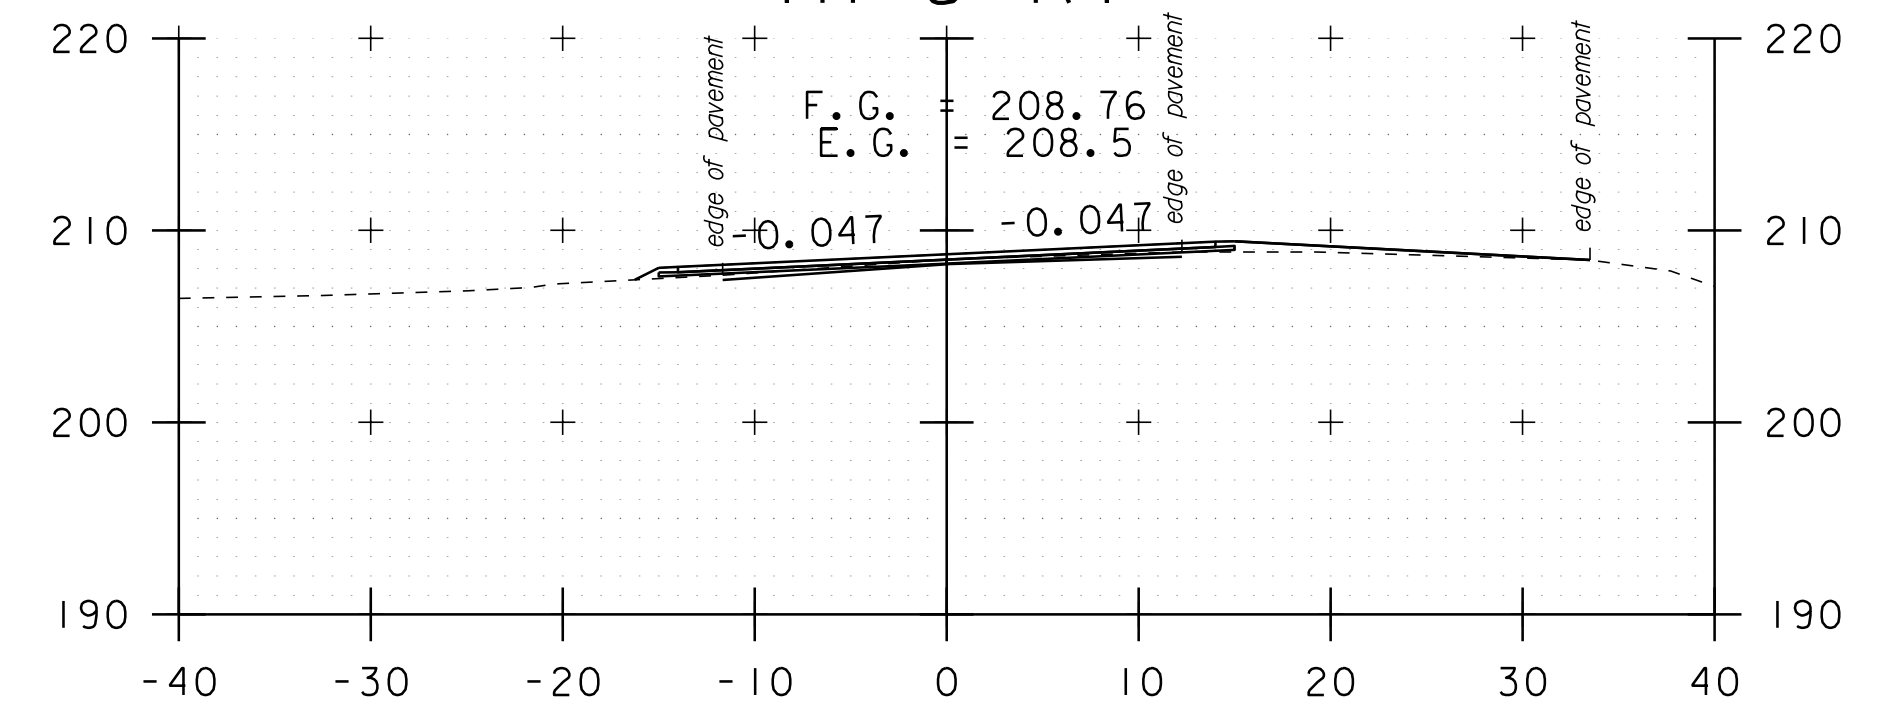


487+16  
TH#5 RT

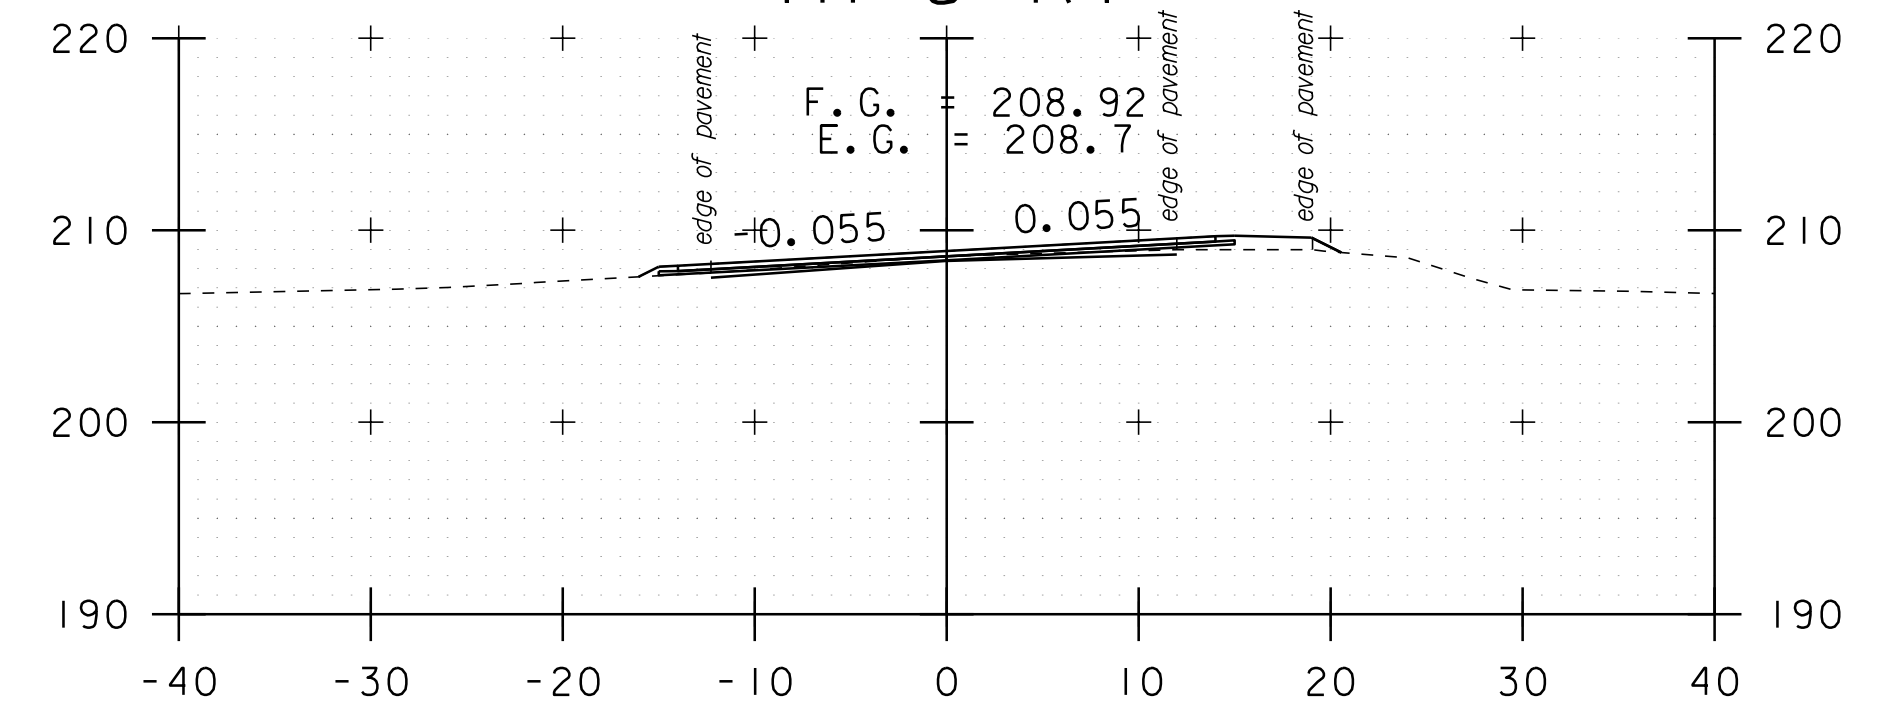

487+00  
TH#5 RT

DATUM	NAVD 88
	NAD 83

STA. 485+55 TO STA. 487+16

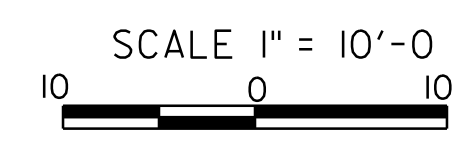

<b>CROSS SECTION SHEET 4</b>	PROJECT NAME: ADDISON-NEW HAVEN	PLOT DATE: 3/13/2012
	PROJECT NUMBER: STP 9632(1)	DRAWN BY: SJL
	FILE NAME: p95B076.dgn	CHECKED BY: EPD
	PROJECT LEADER: CDL	SHEET 109 OF 186
	DESIGNED BY: SJL	
	PLOT FILE: p95B076_109.1	