




489+10

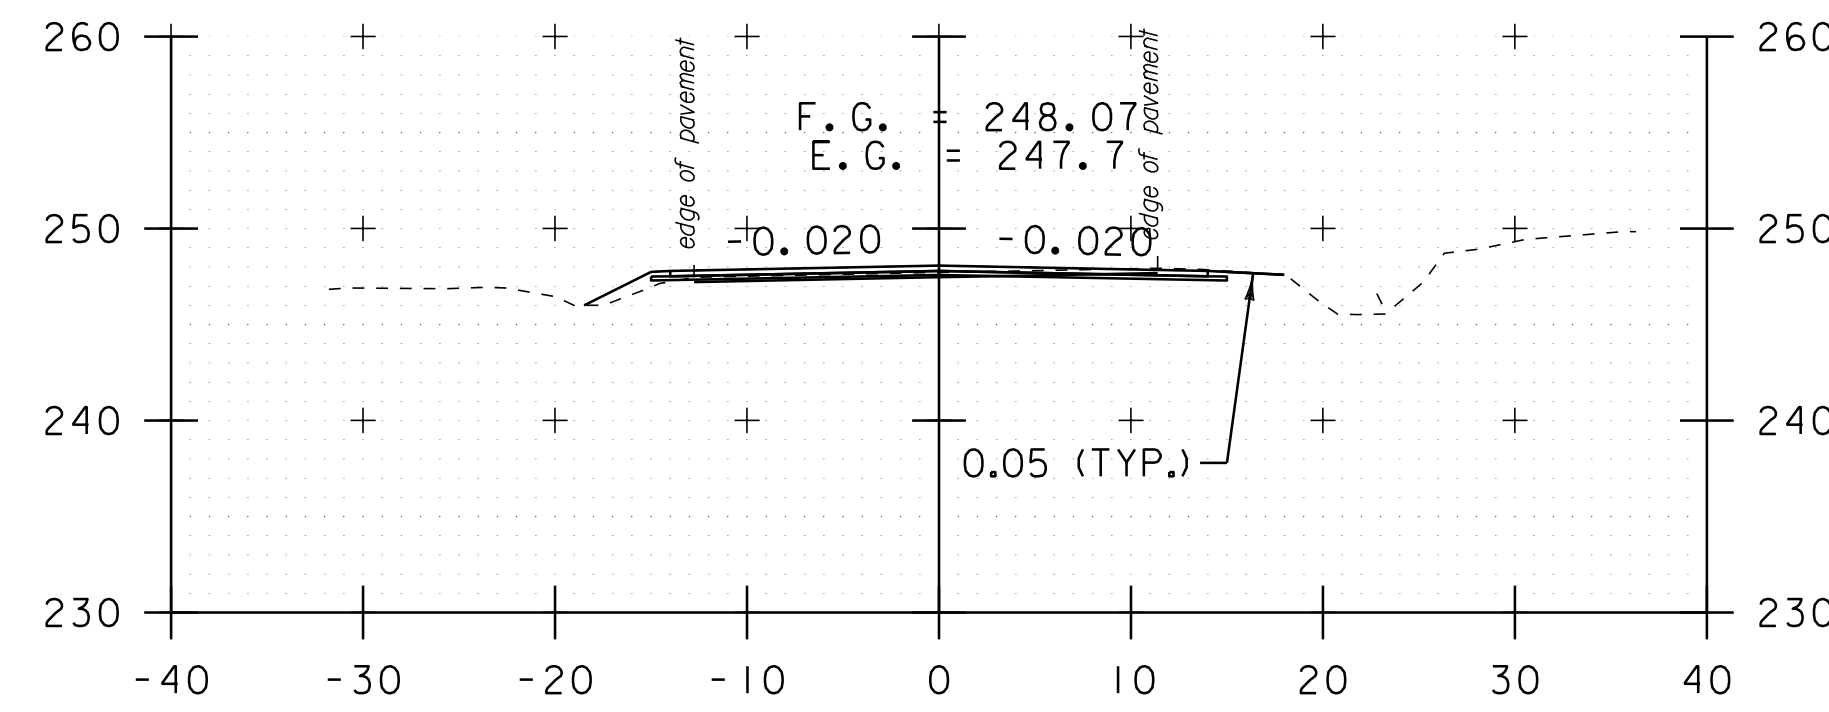


510+20

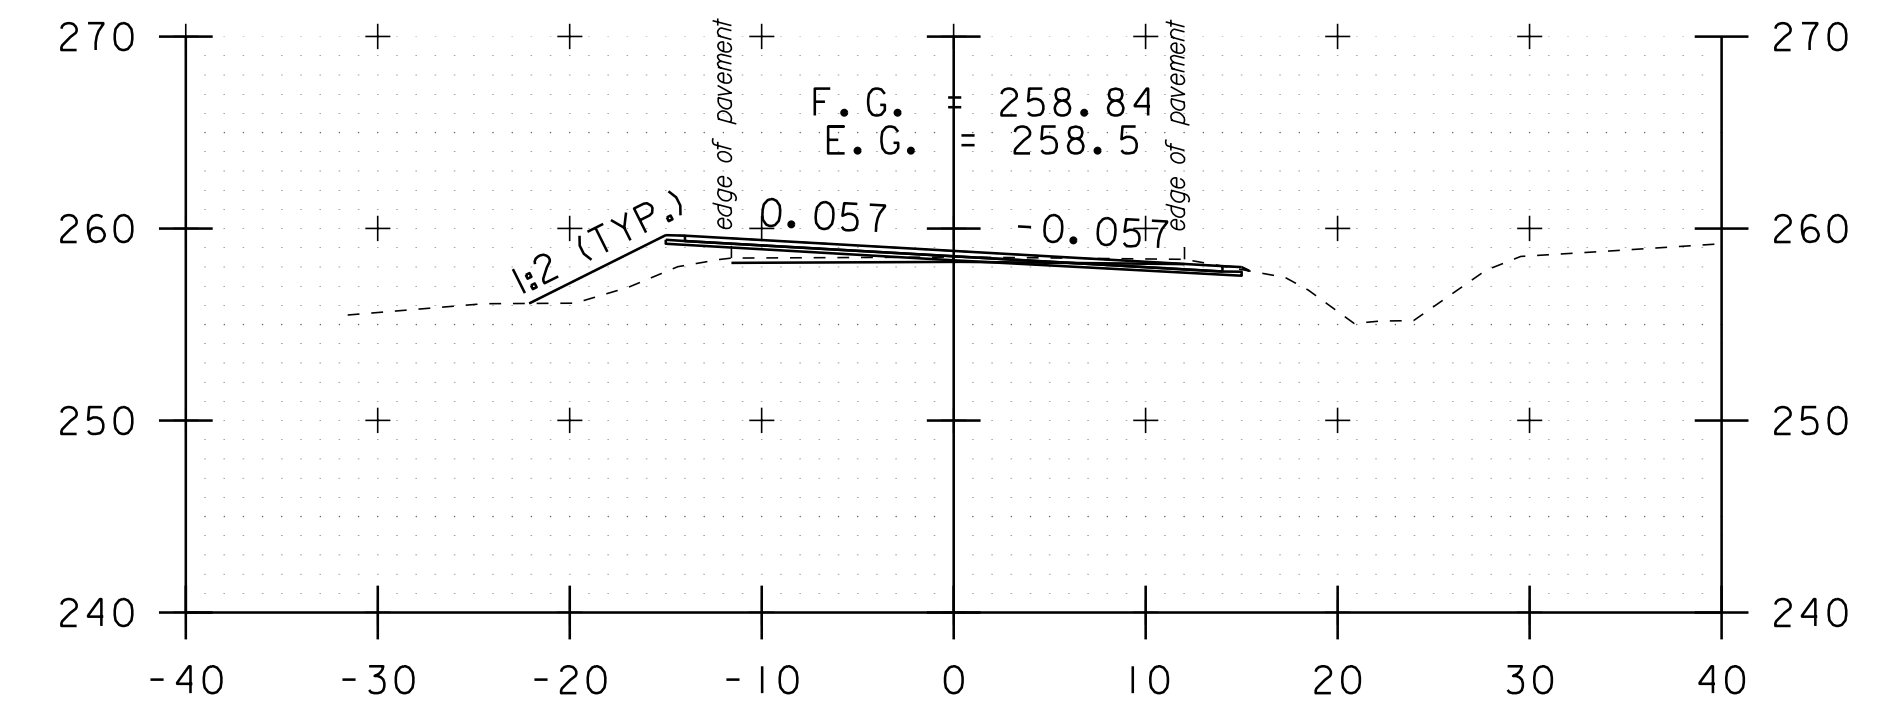


512+48

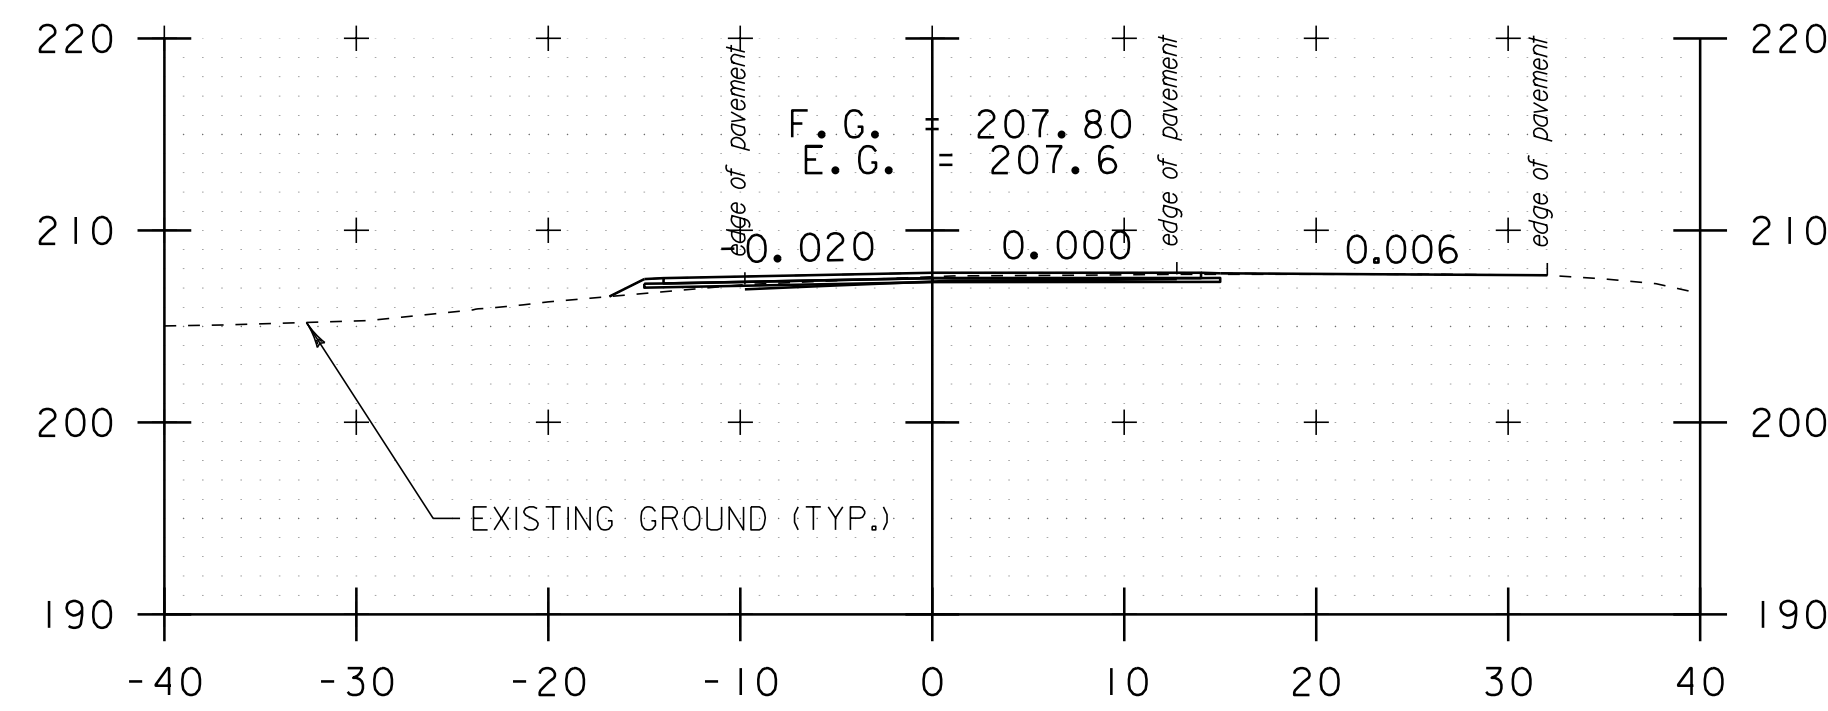


TH#5 RT
488+10

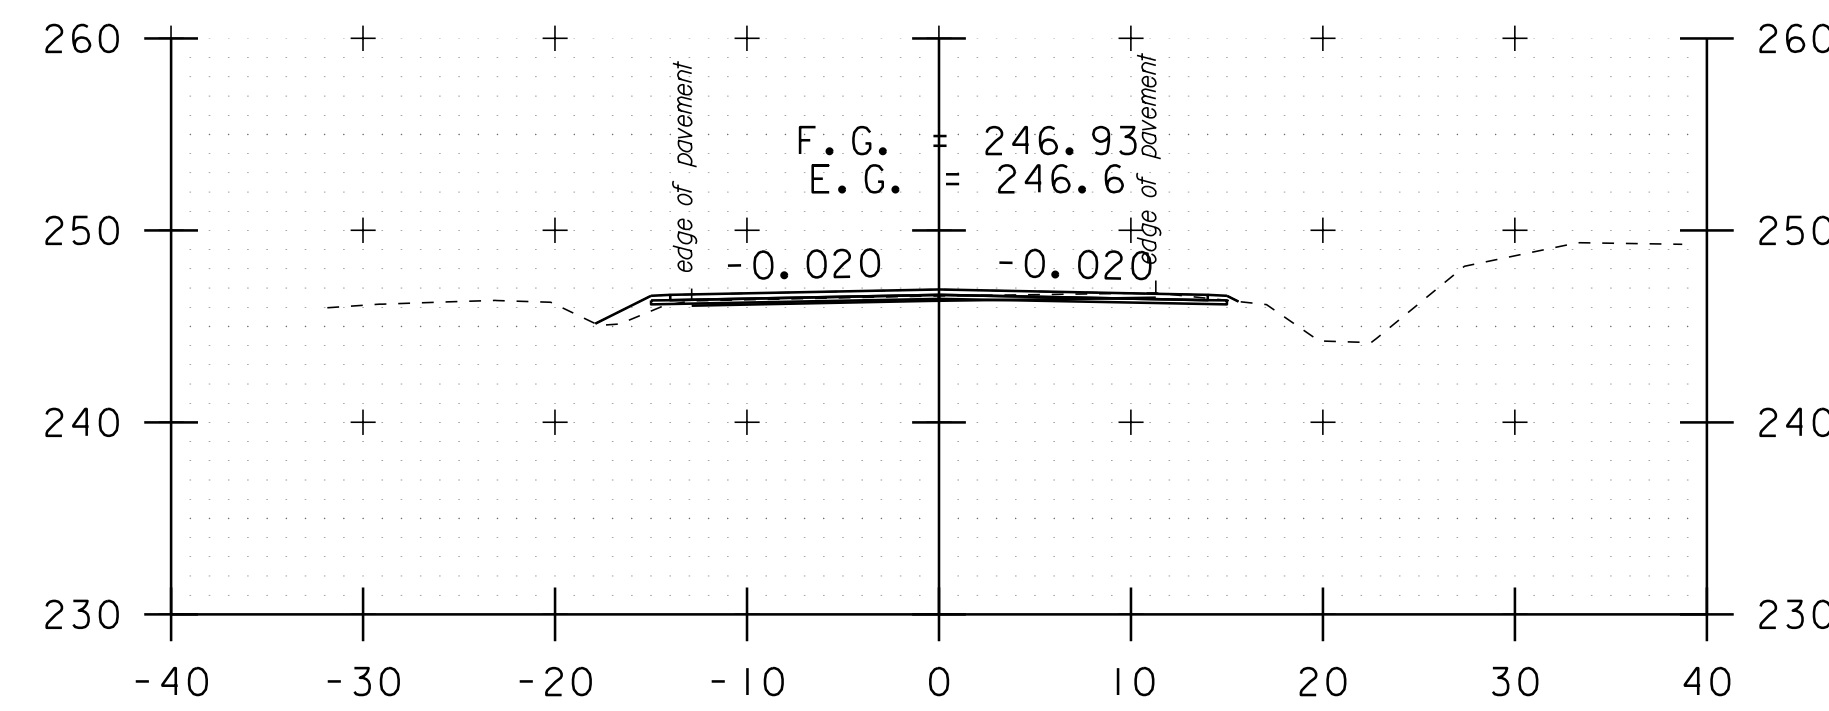


510+00

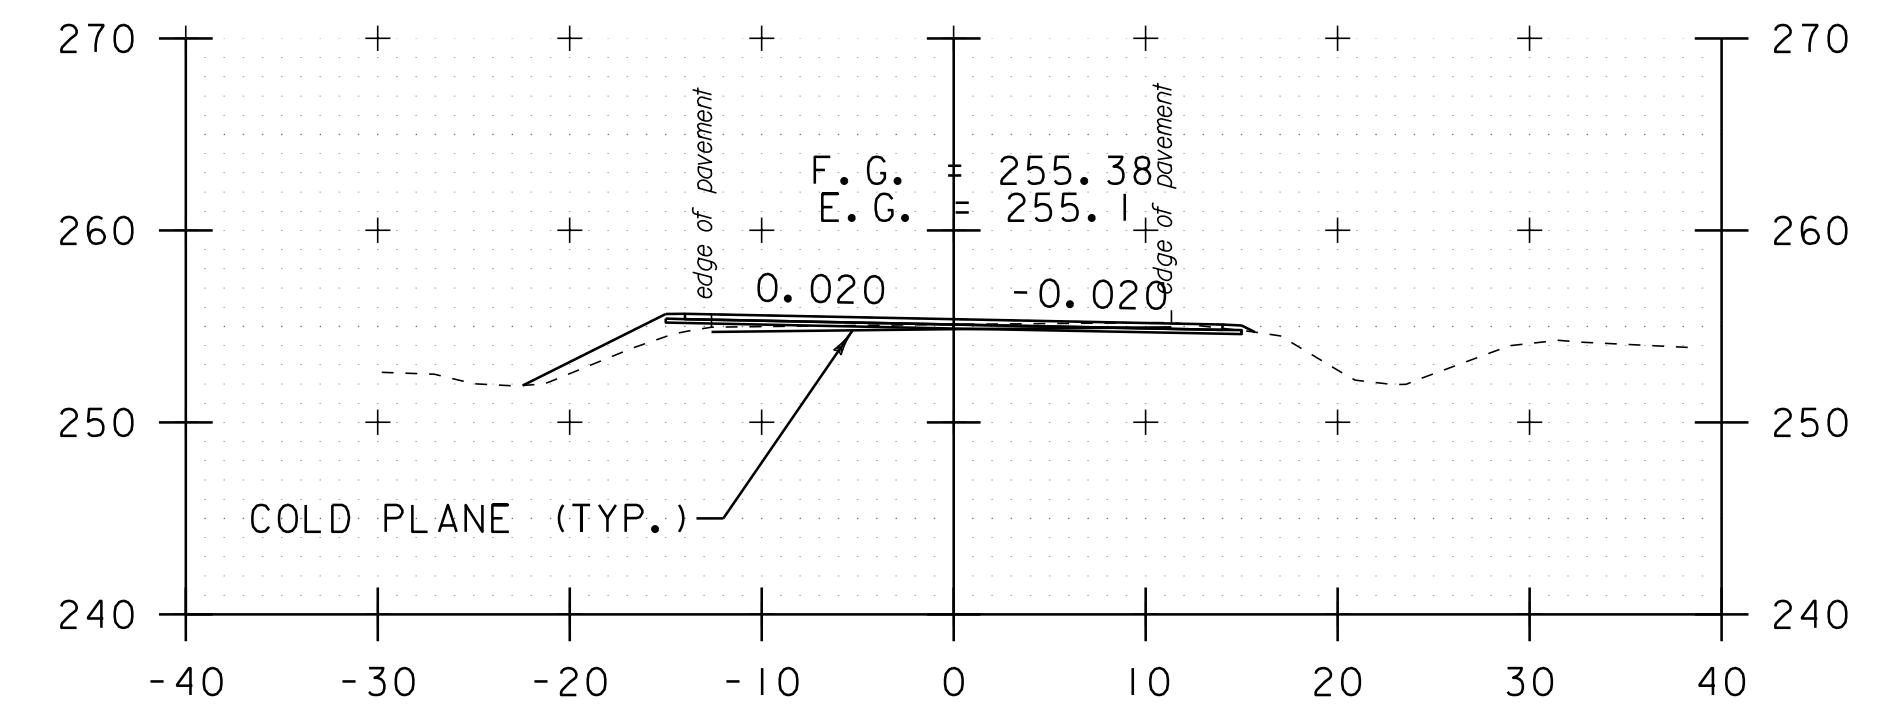


511+65

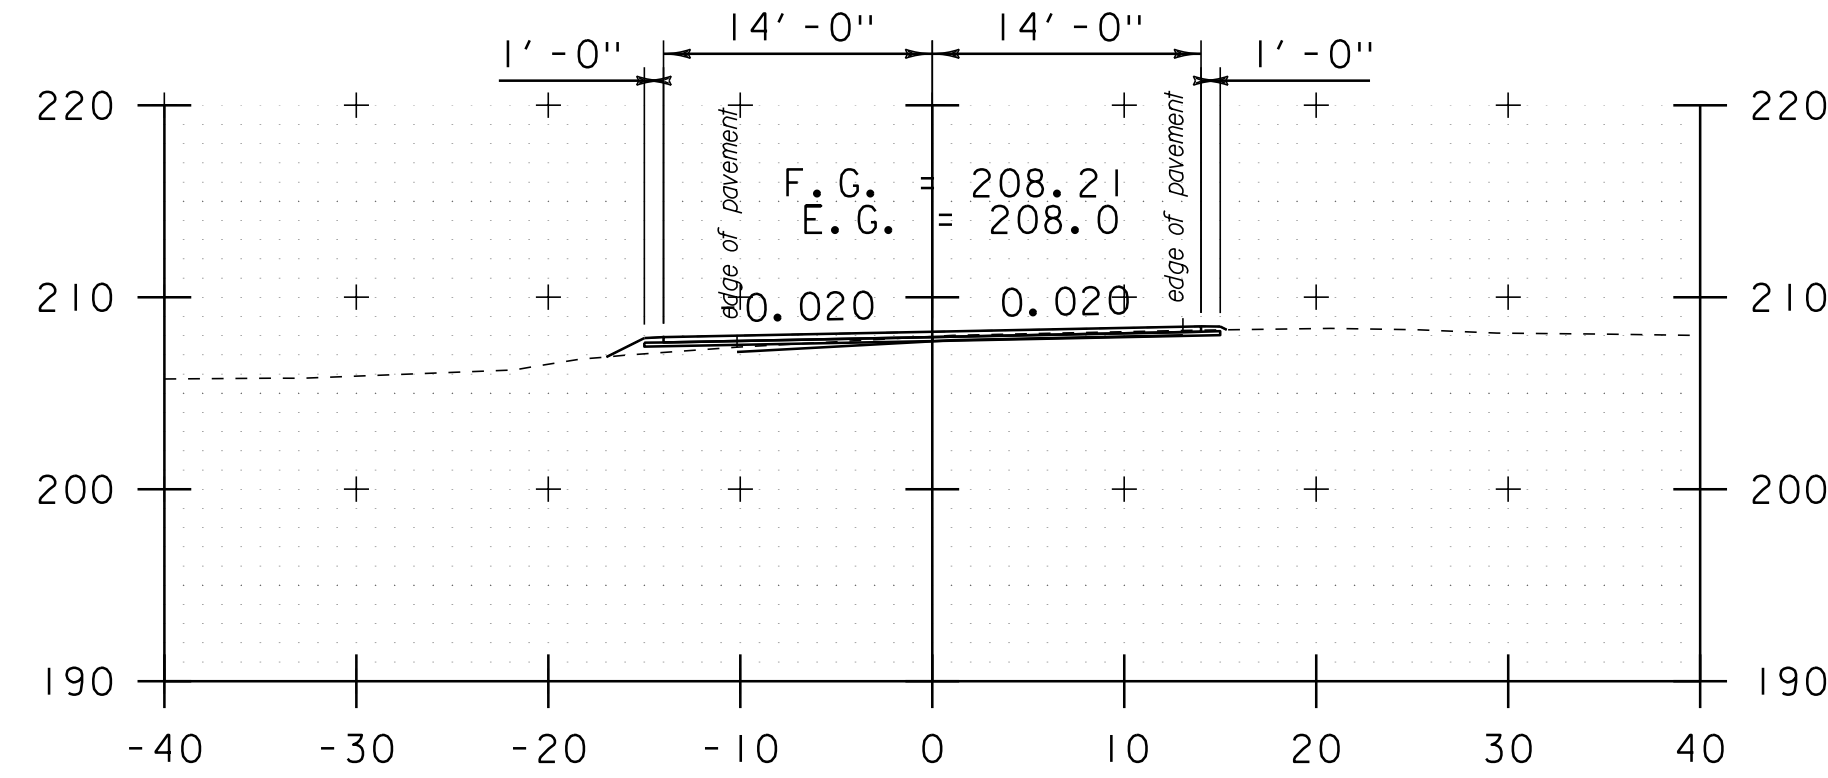

487+70

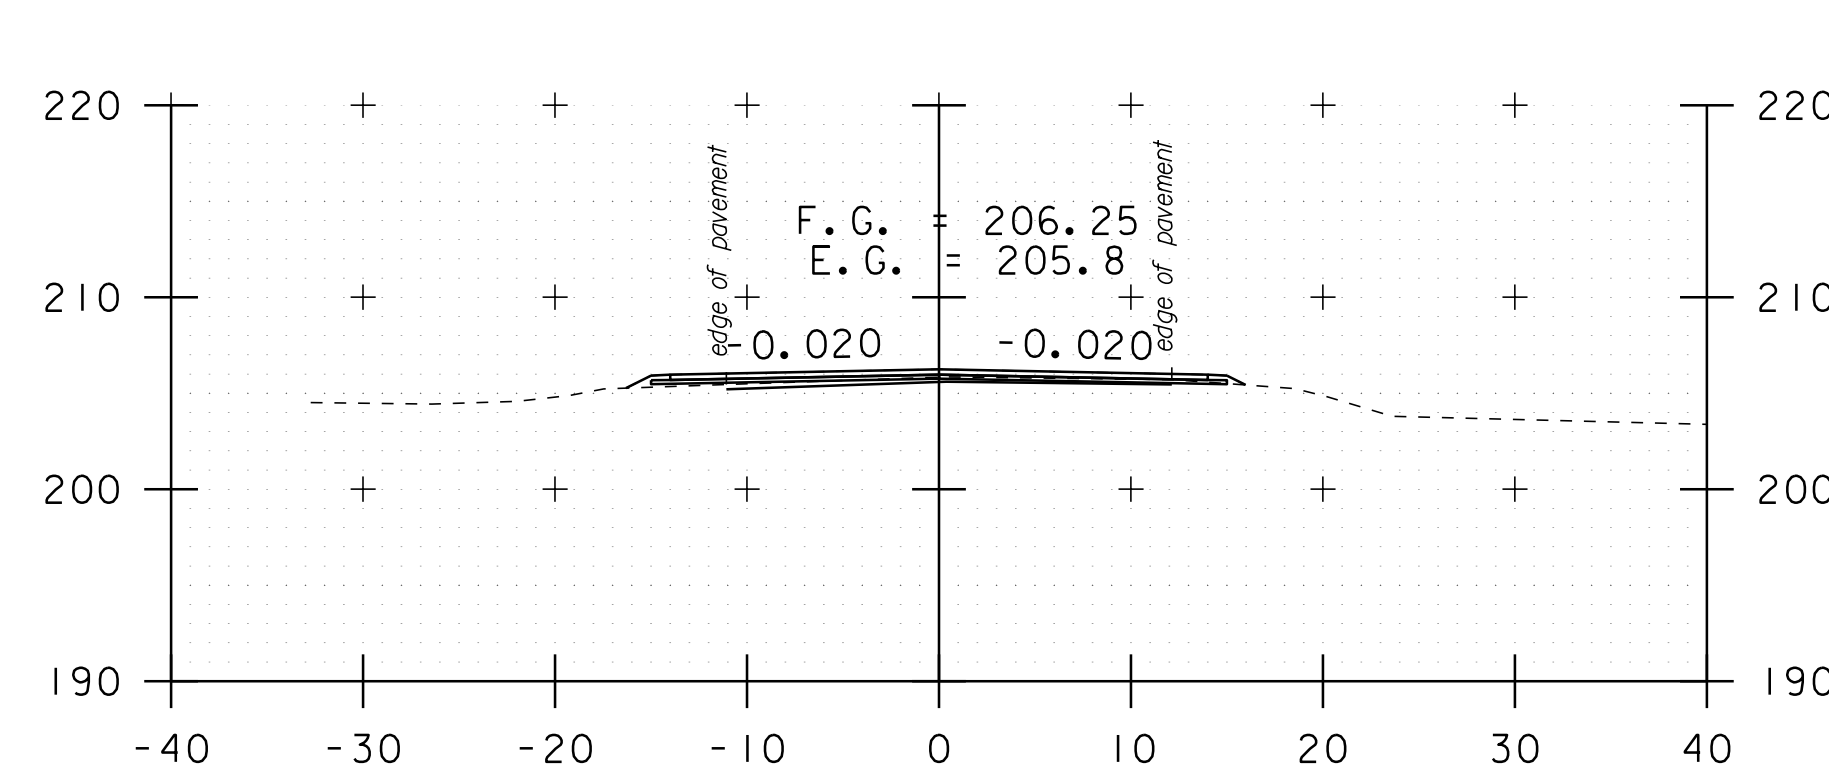


489+50

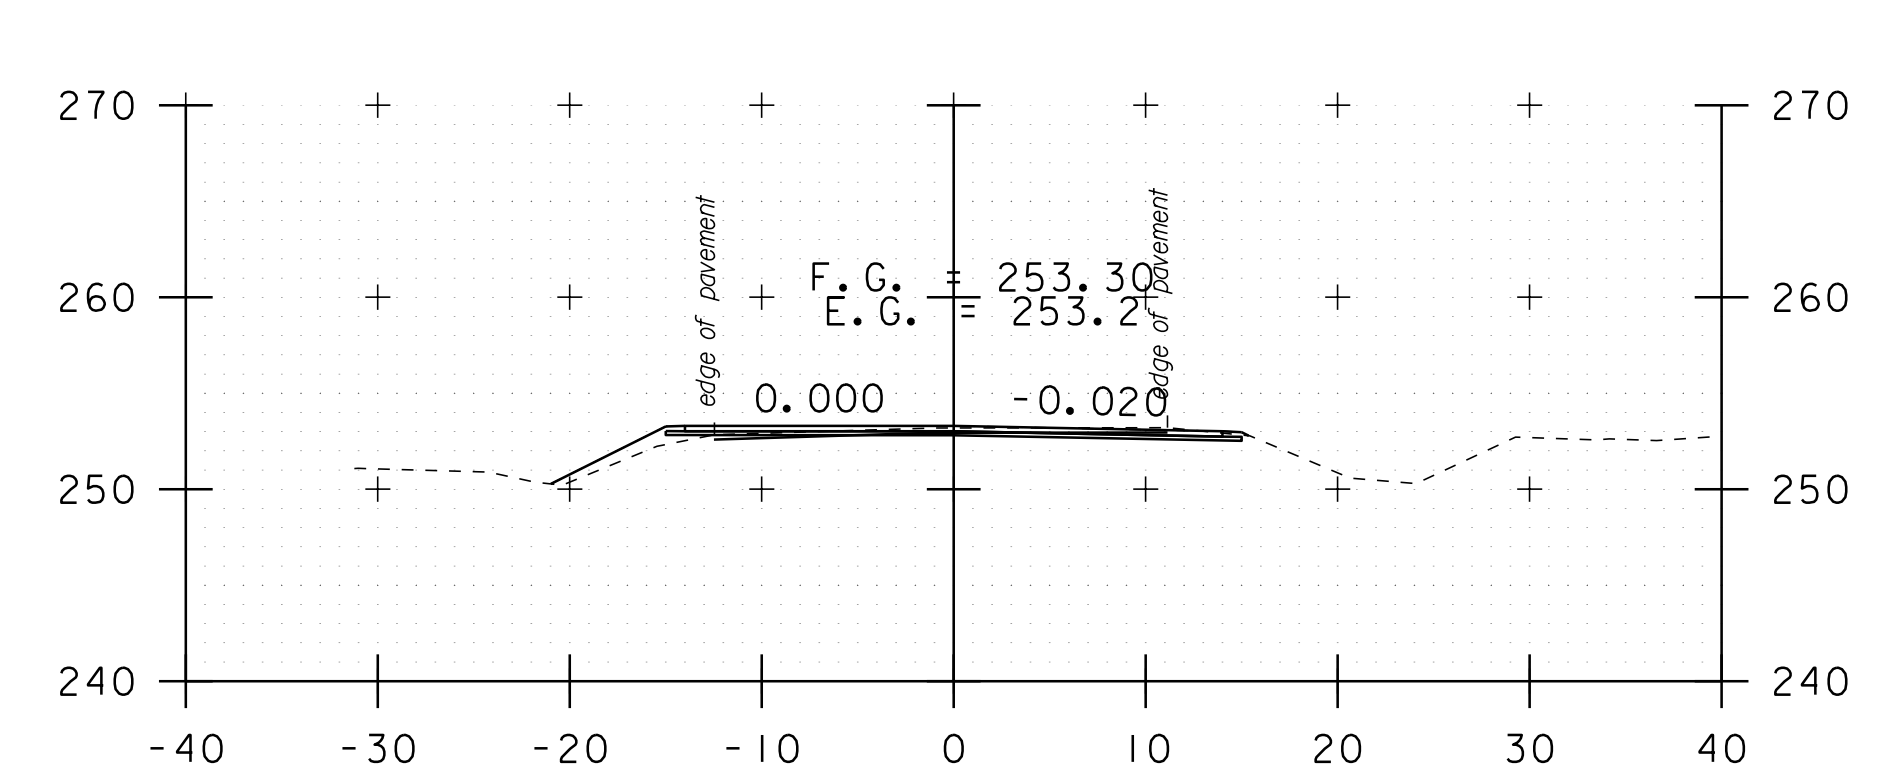

511+20

DATUM	NAVD 88
	NAD 83

STA. 487+70 TO STA. 512+48

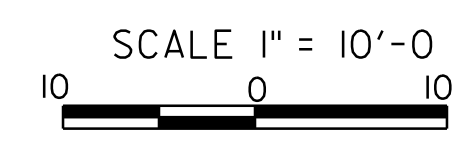

CROSS SECTION SHEET 5	PROJECT NAME: ADDISON-NEW HAVEN	PLOT DATE: 3/13/2012
	PROJECT NUMBER: STP 9632(1)	DRAWN BY: SJL
	FILE NAME: p95B076.dgn	CHECKED BY: EPD
	PROJECT LEADER: CDL	SHEET 110 OF 186
	DESIGNED BY: SJL	
	PLOT FILE: p95B076_110.i	