




514+00

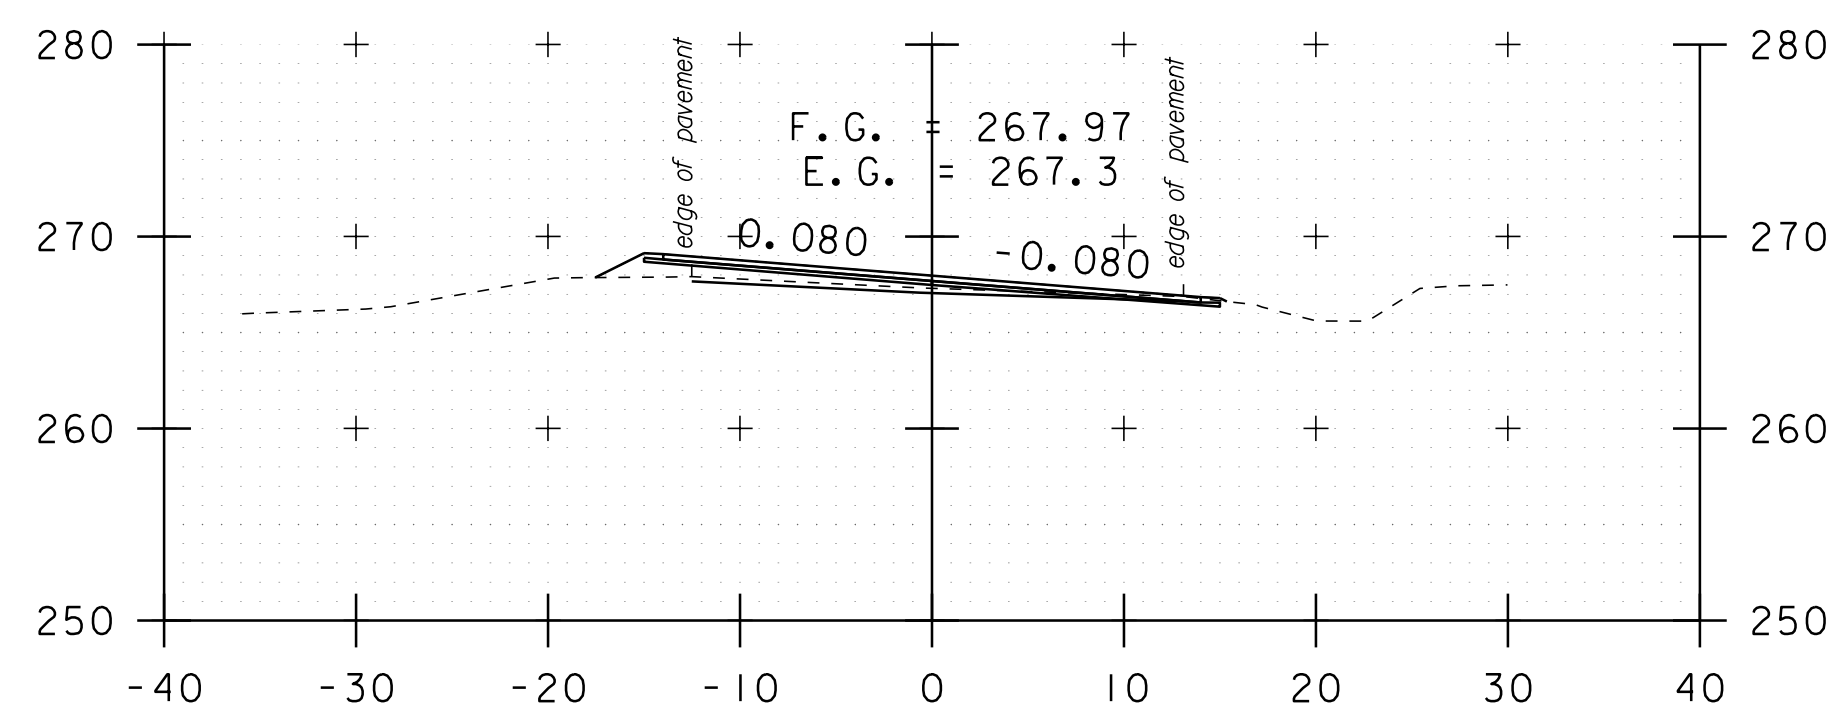


515+00

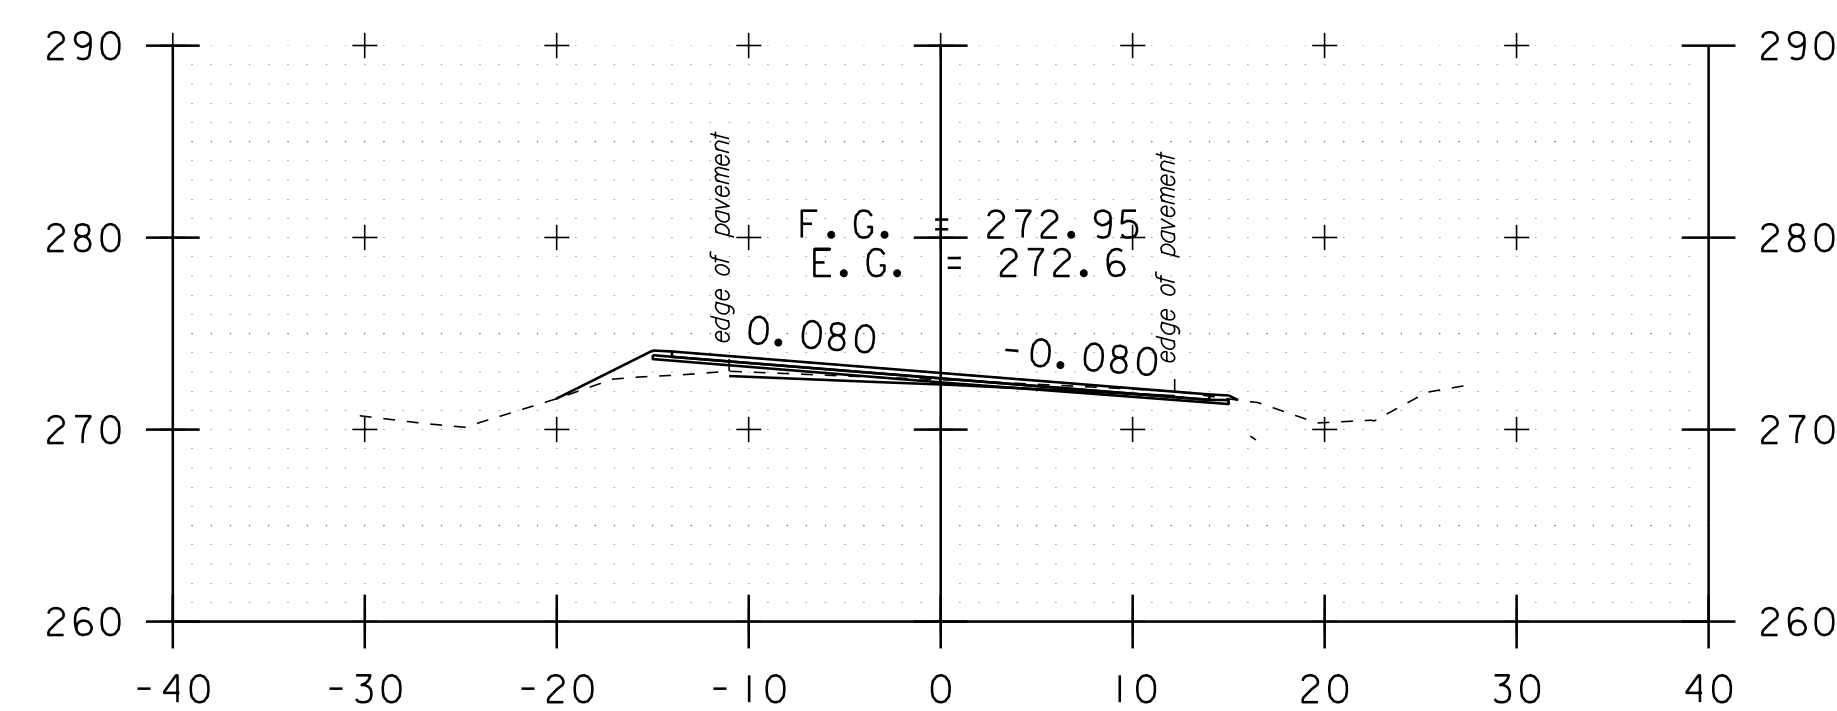


516+50

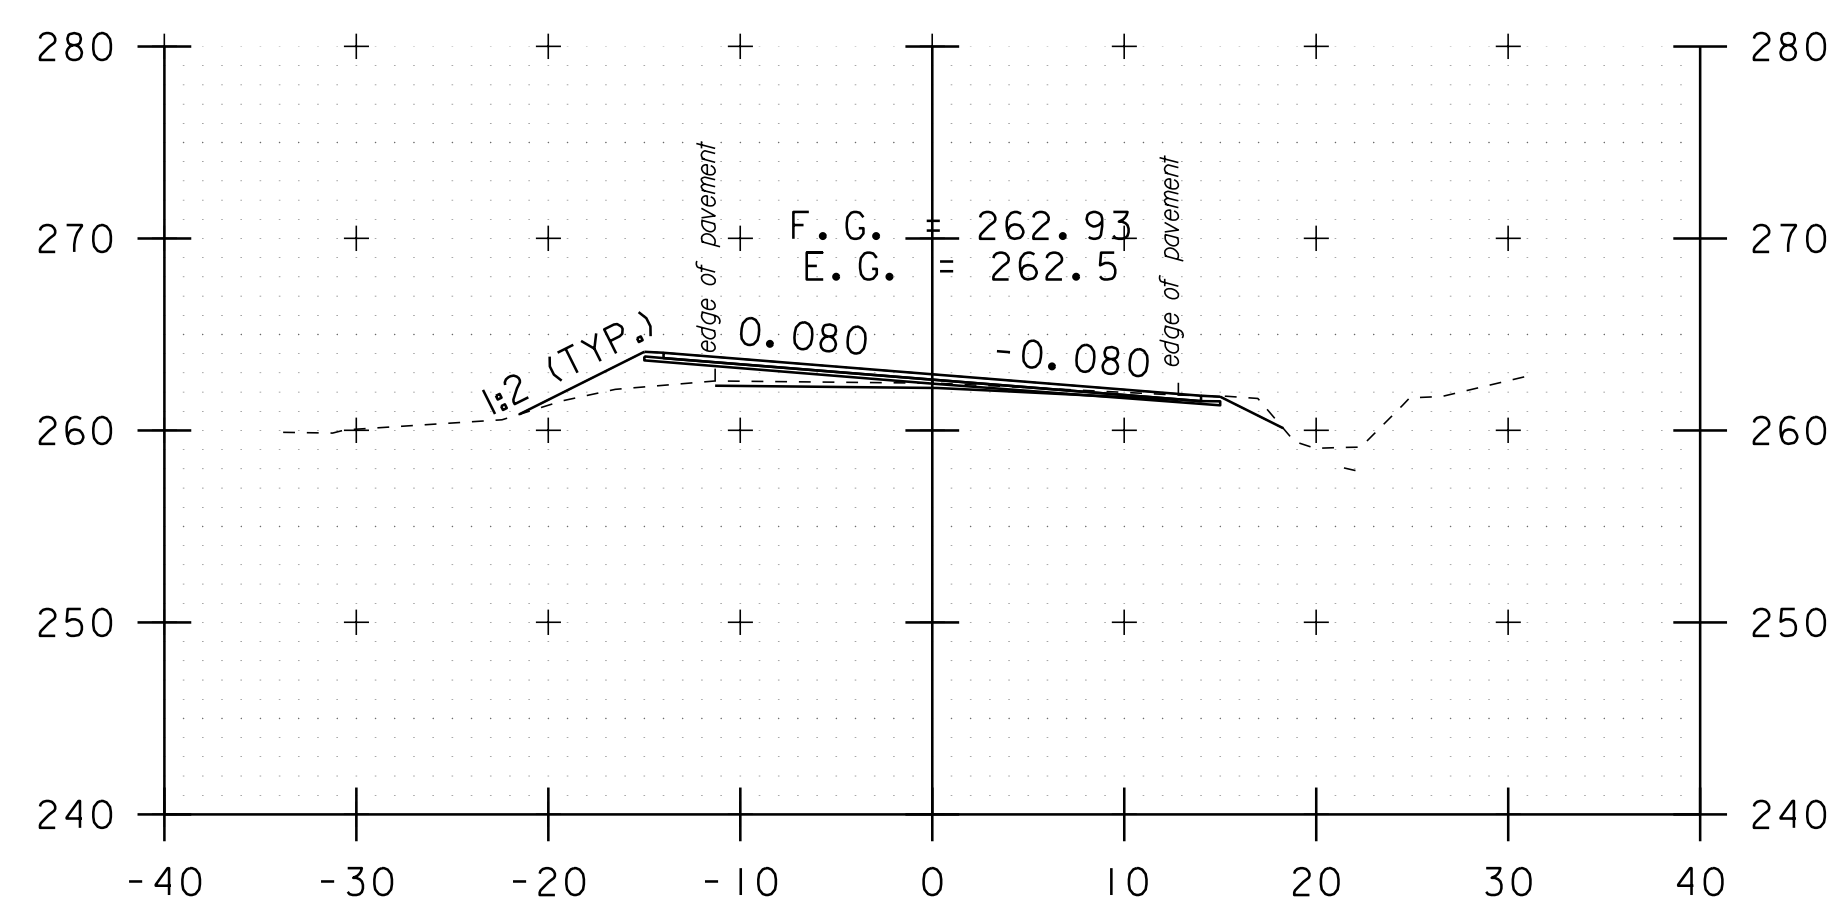


513+50

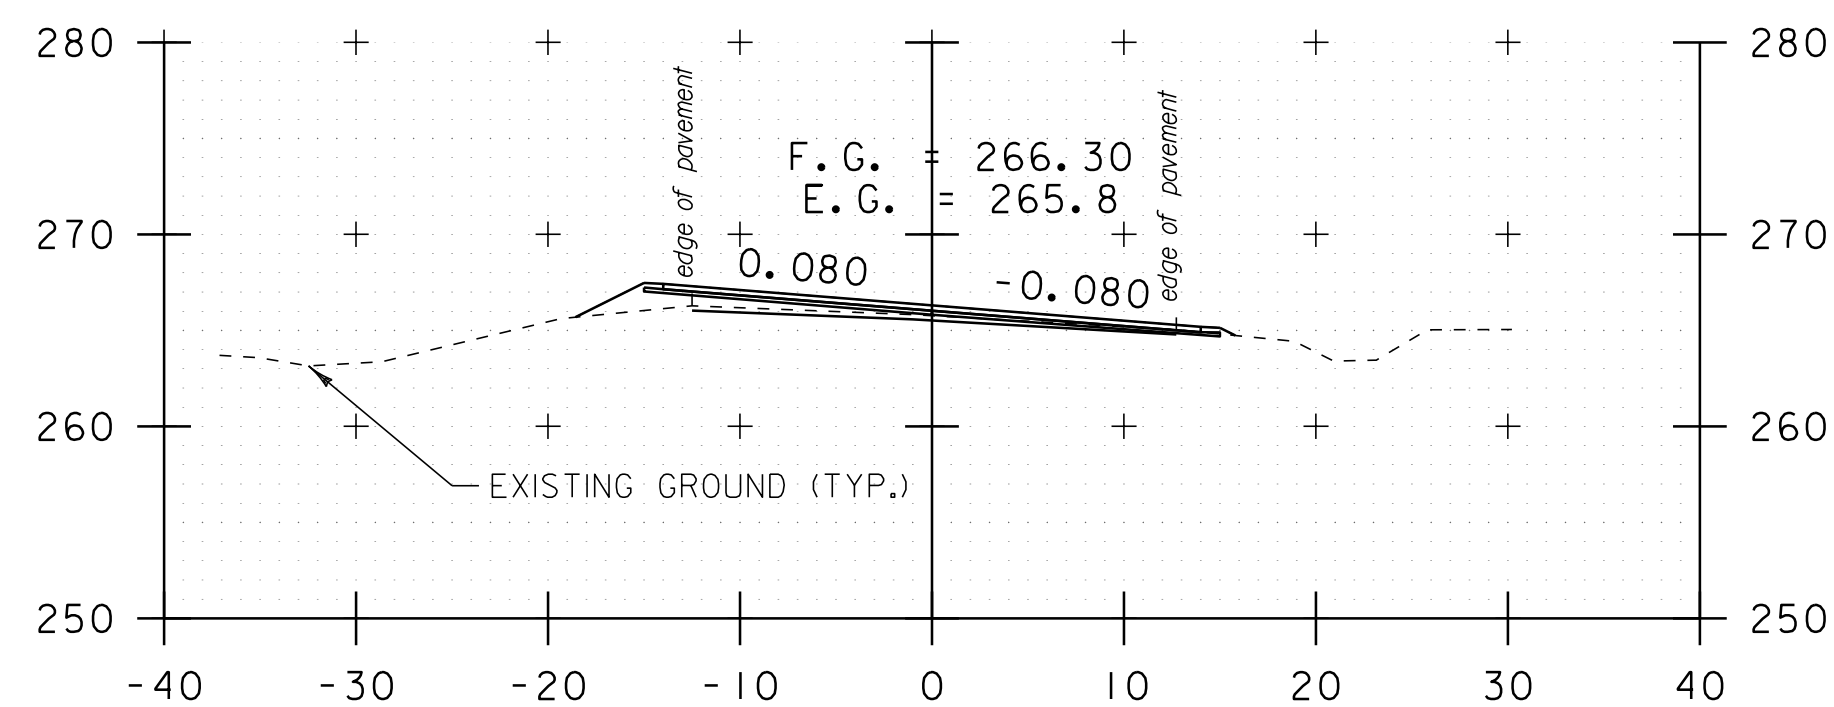


514+50

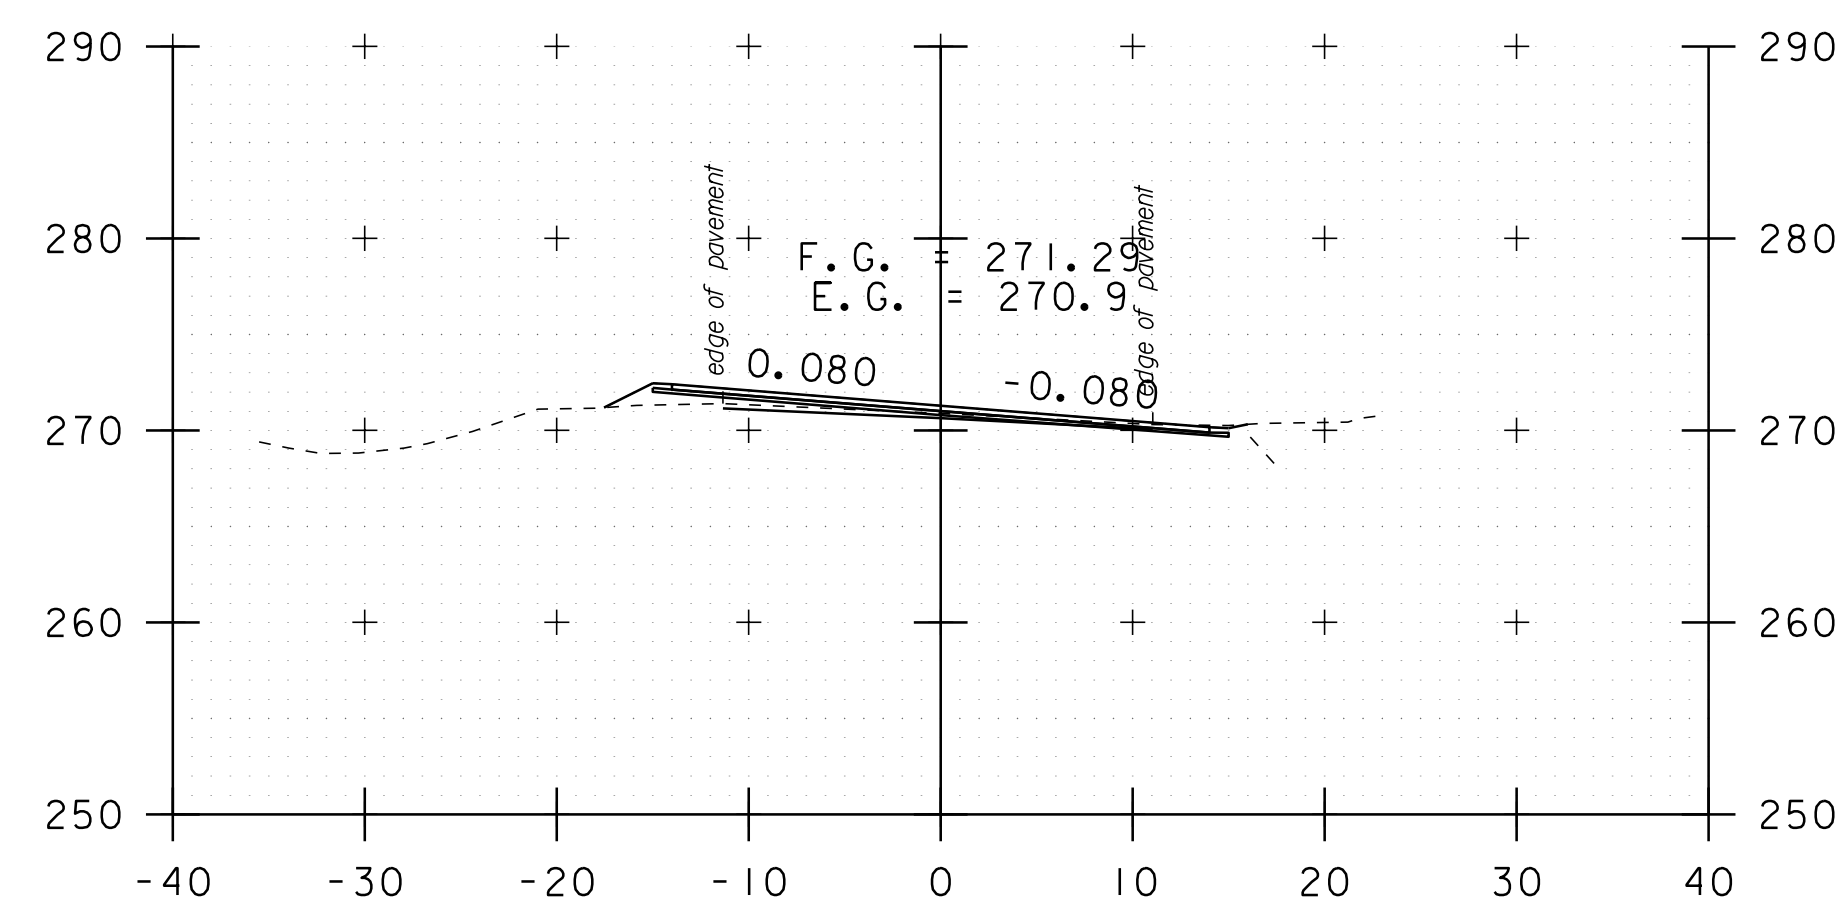


516+00  
DRIVE LT

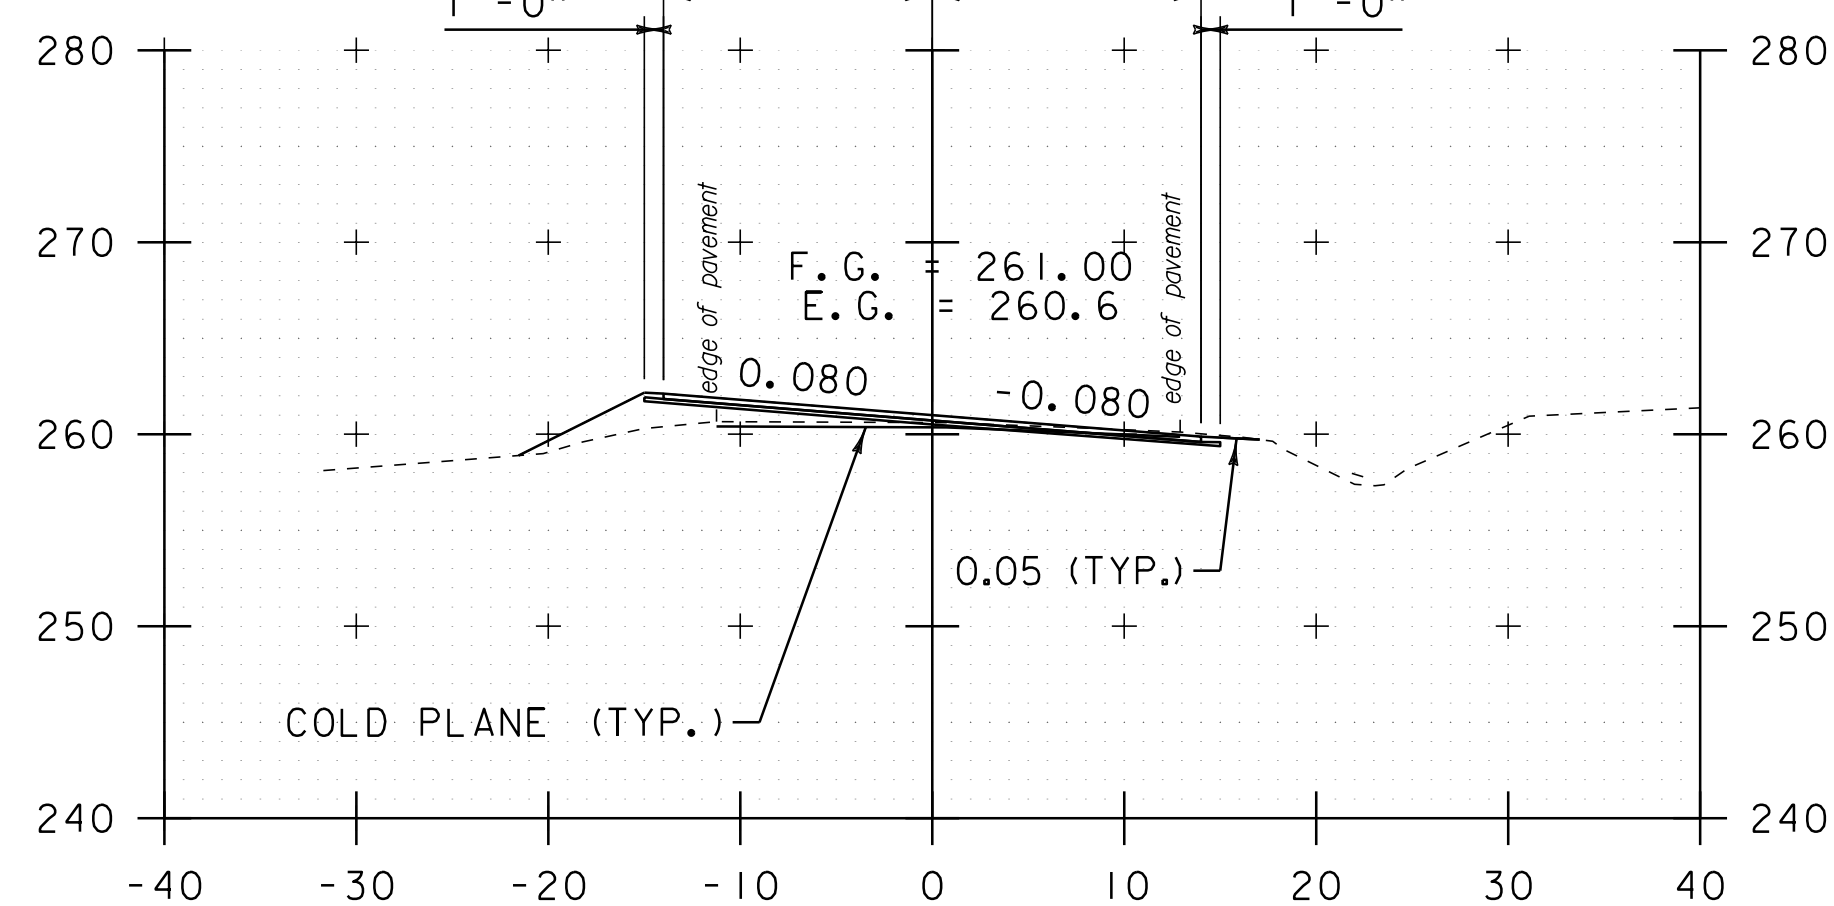

513+00

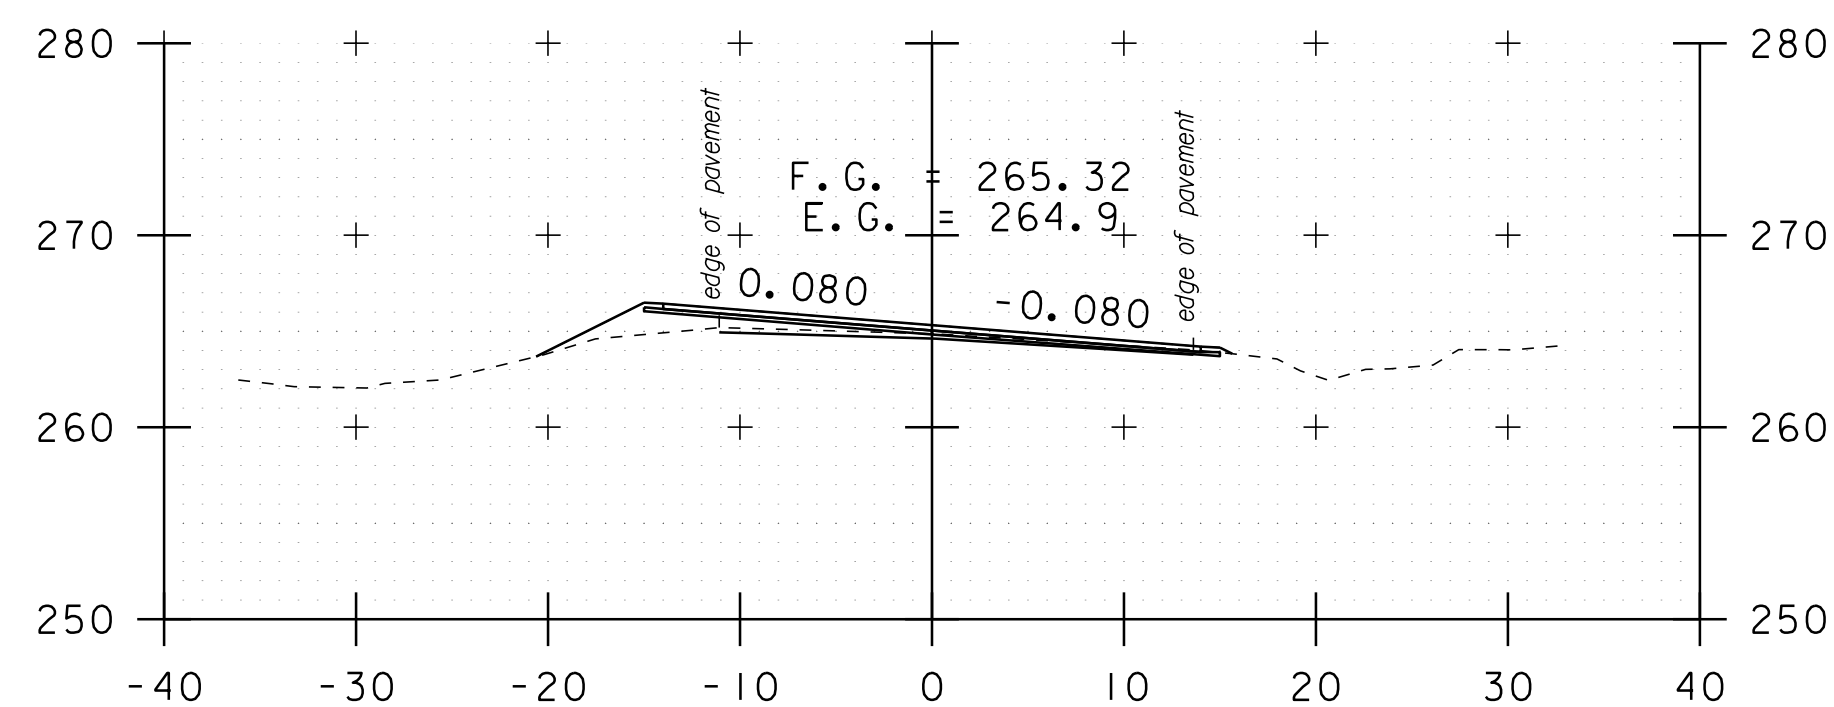


514+20

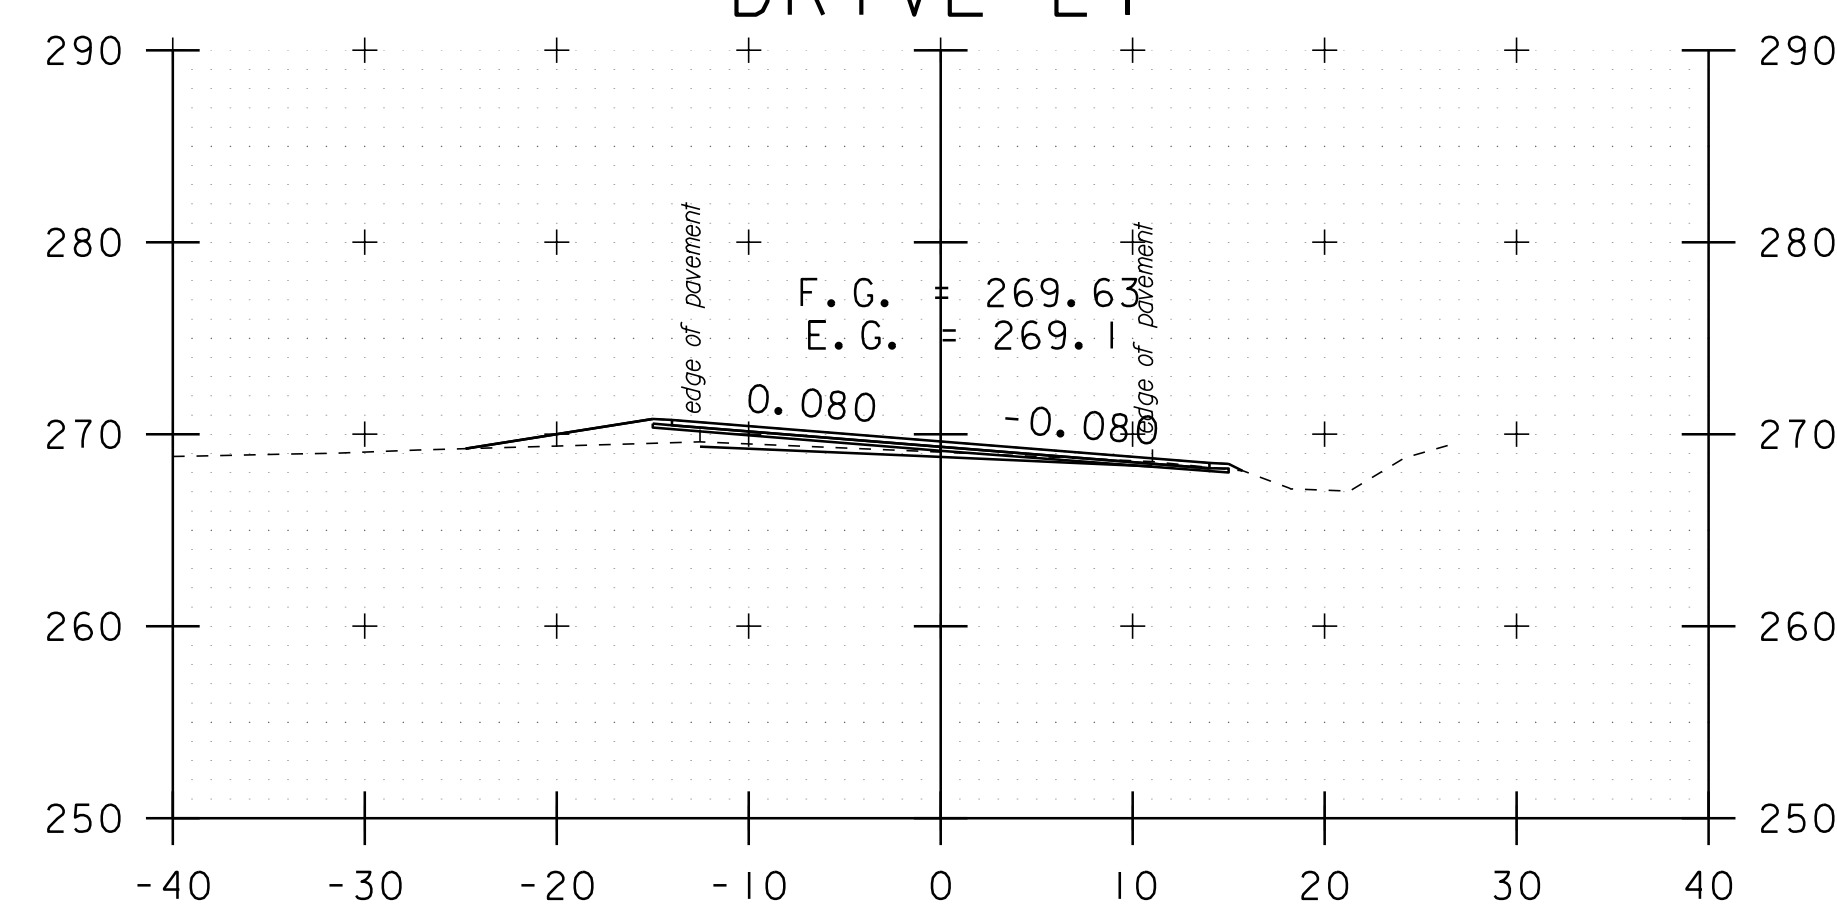

515+50  
DRIVE LT

DATUM	NAVD 88
	NAD 83

STA. 513+00 TO STA. 516+50

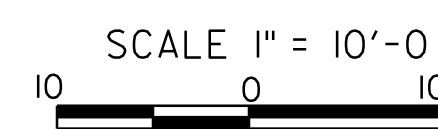

**CROSS SECTION SHEET 6**

PROJECT NAME: ADDISON-NEW HAVEN  
PROJECT NUMBER: STP 9632(1)

FILE NAME: p95B076.dgn  
PROJECT LEADER: CDL  
DESIGNED BY: SJL  
PLOT FILE: p95B076\_III.1

PLOT DATE: 3/13/2012  
DRAWN BY: SJL  
CHECKED BY: EPD  
SHEET III OF 186