


516+80  
 DRIVE LT

518+60

522+00

DATUM	NAVD 88
	NAD 83

STA. 516+80 TO STA. 523+15

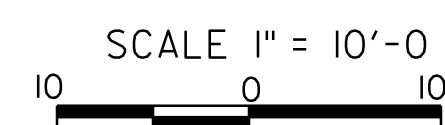

**CROSS SECTION SHEET 7**

PROJECT NAME: ADDISON-NEW HAVEN  
 PROJECT NUMBER: STP 9632(1)

FILE NAME: p95B076.dgn	PLOT DATE: 3/13/2012
PROJECT LEADER: CDL	DRAWN BY: SJL
DESIGNED BY: SJL	CHECKED BY: EPD
PLOT FILE: p95B076_I12.1	SHEET 112 OF 186