




524+95

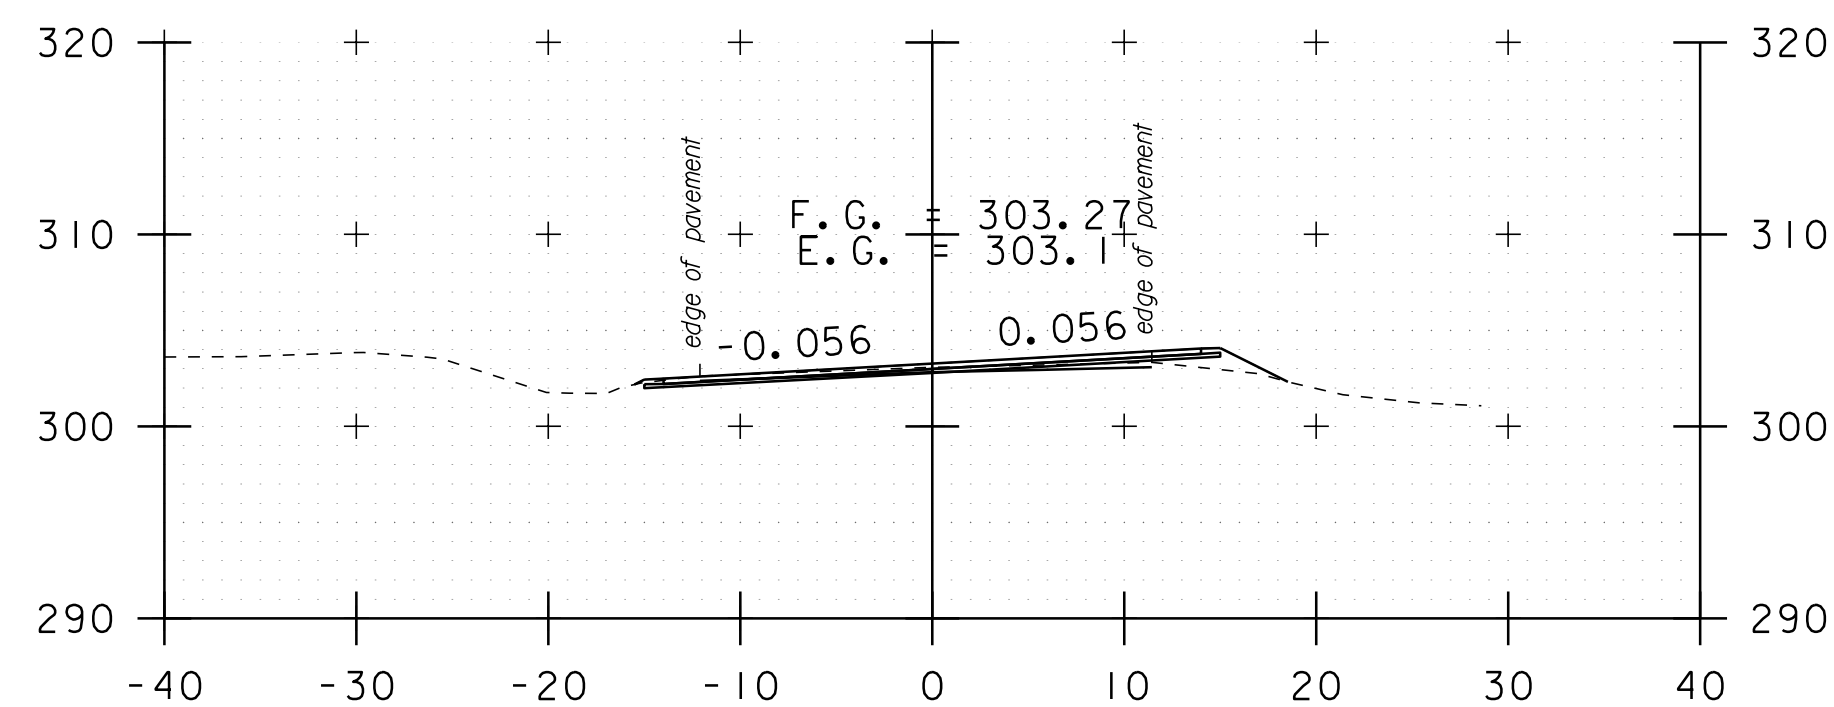


524+41

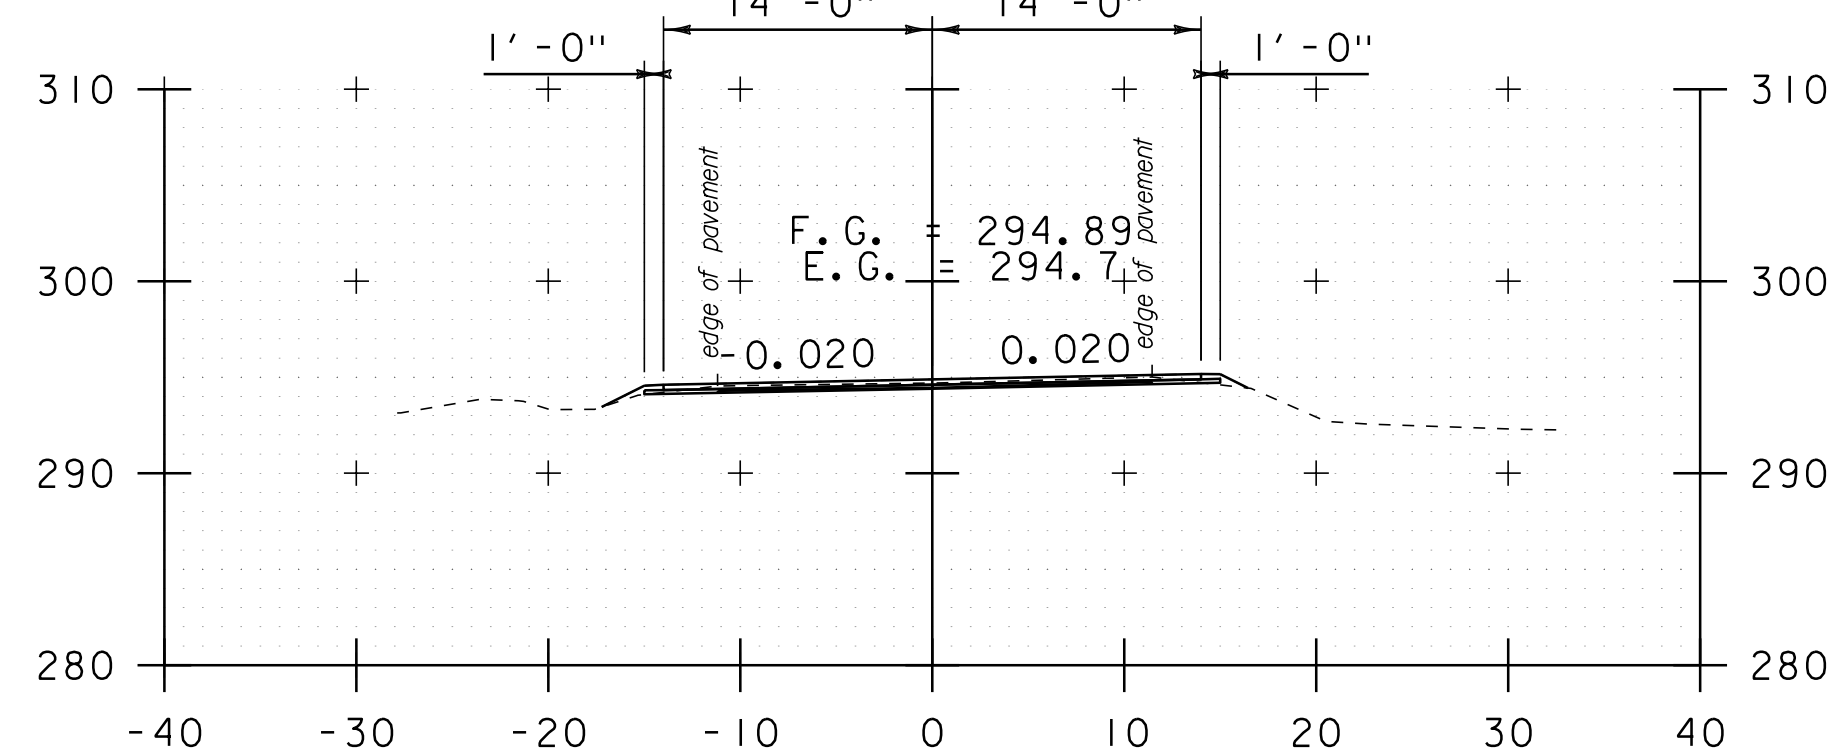


523+60

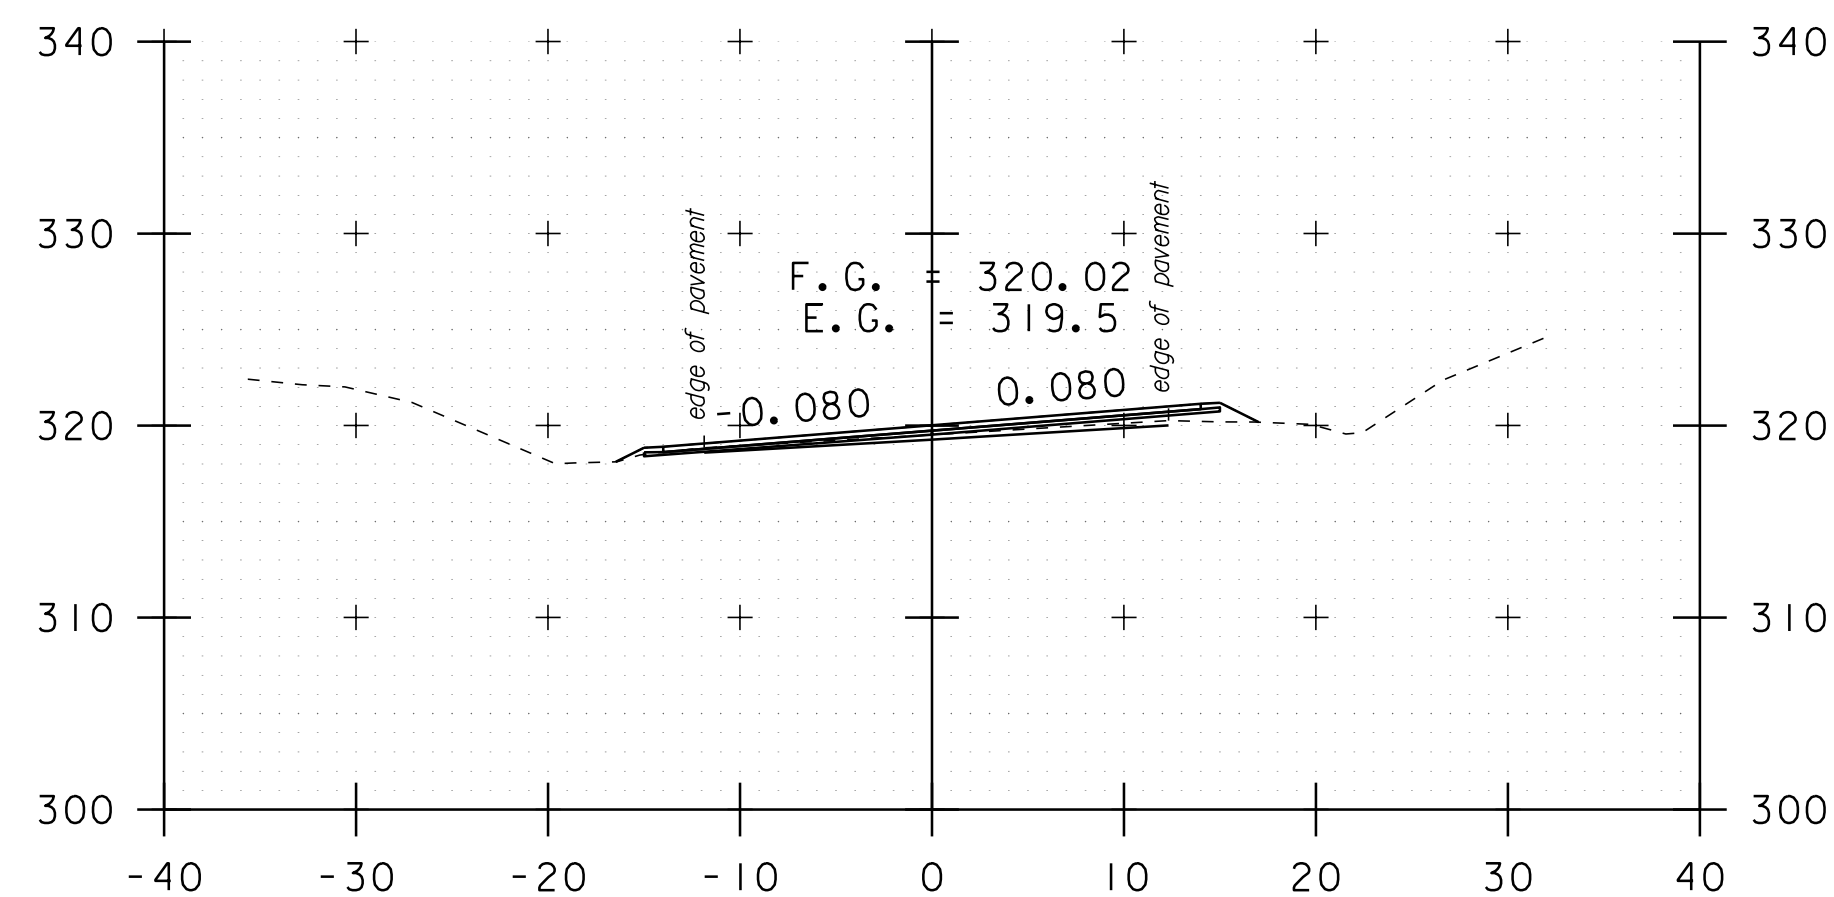


526+00

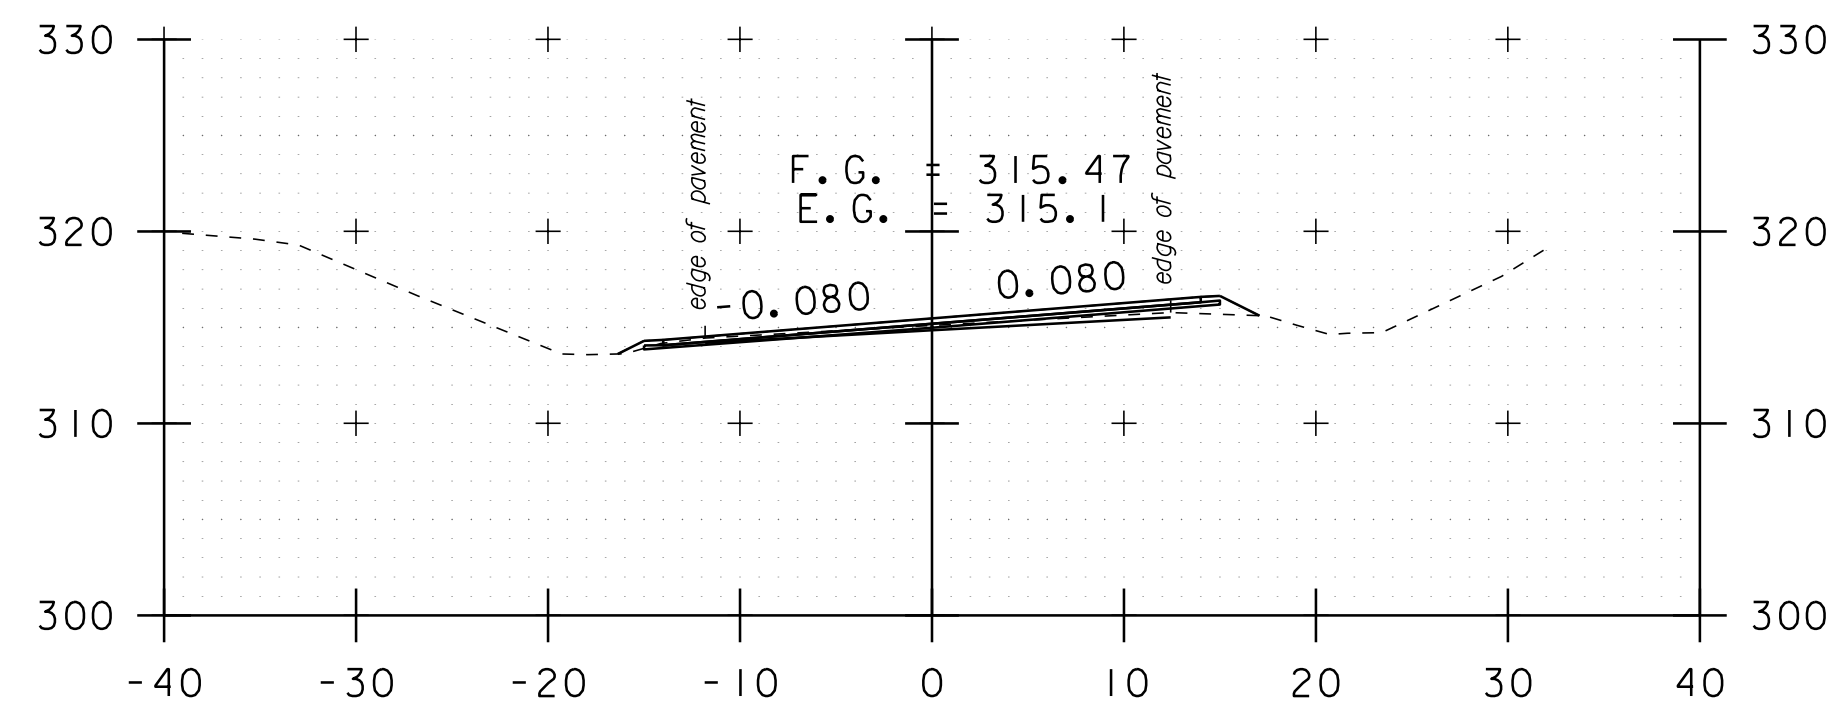


525+50

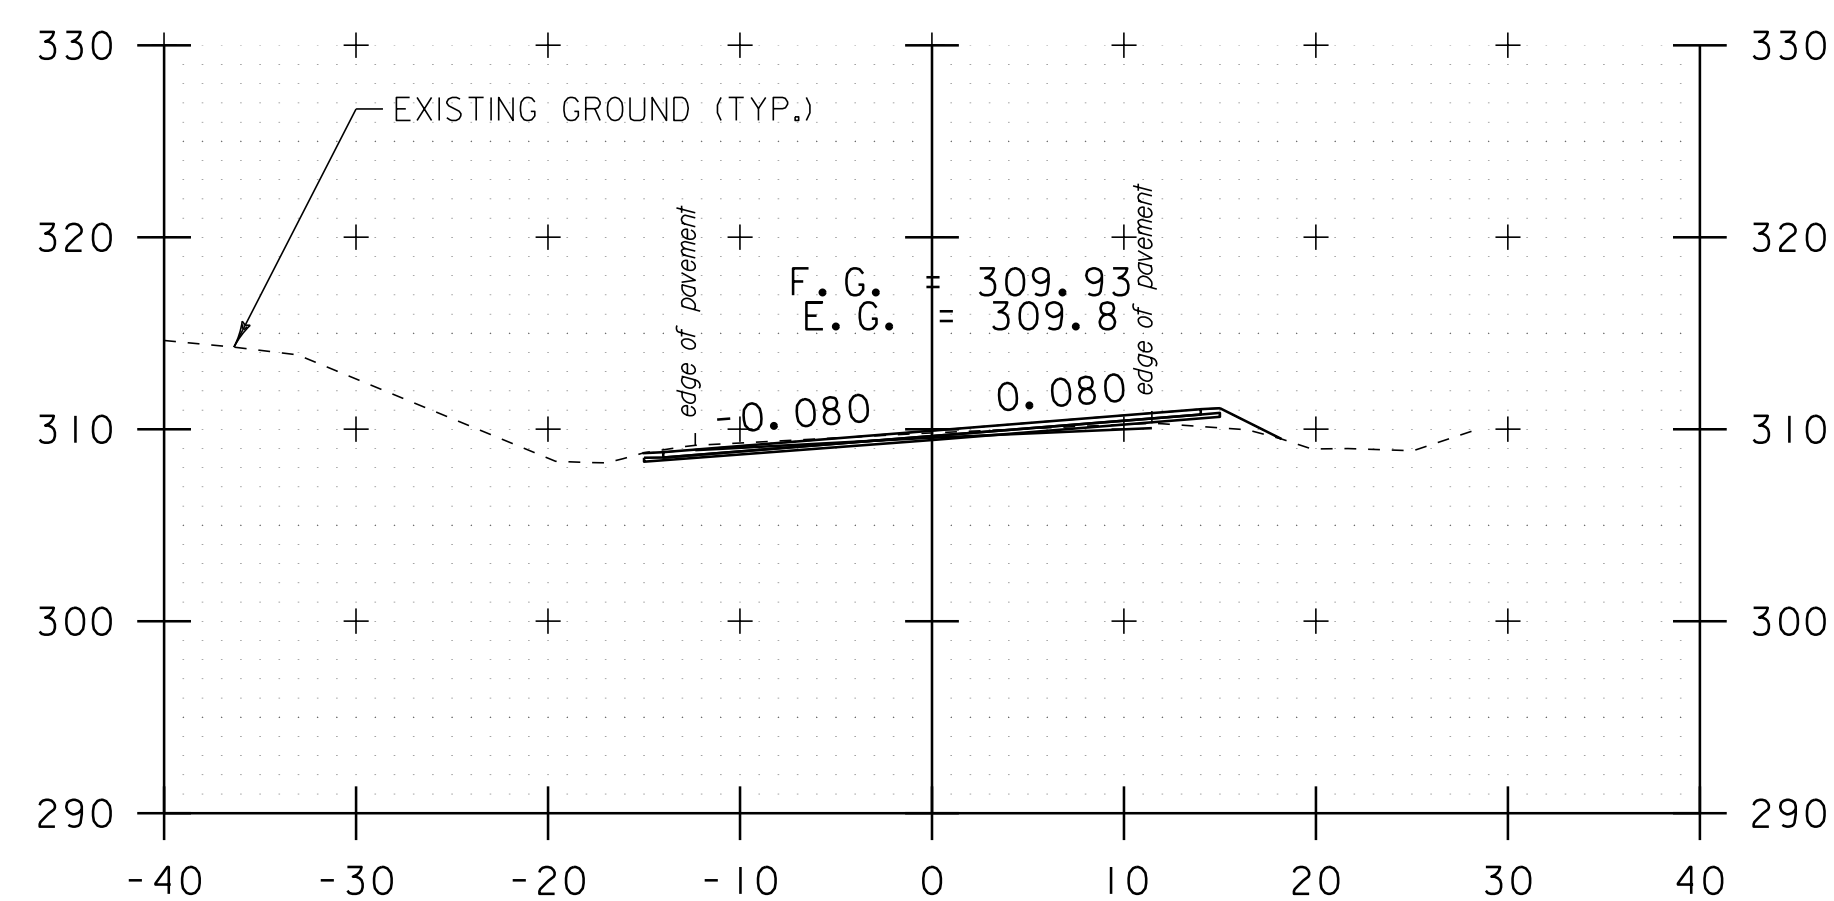


525+00

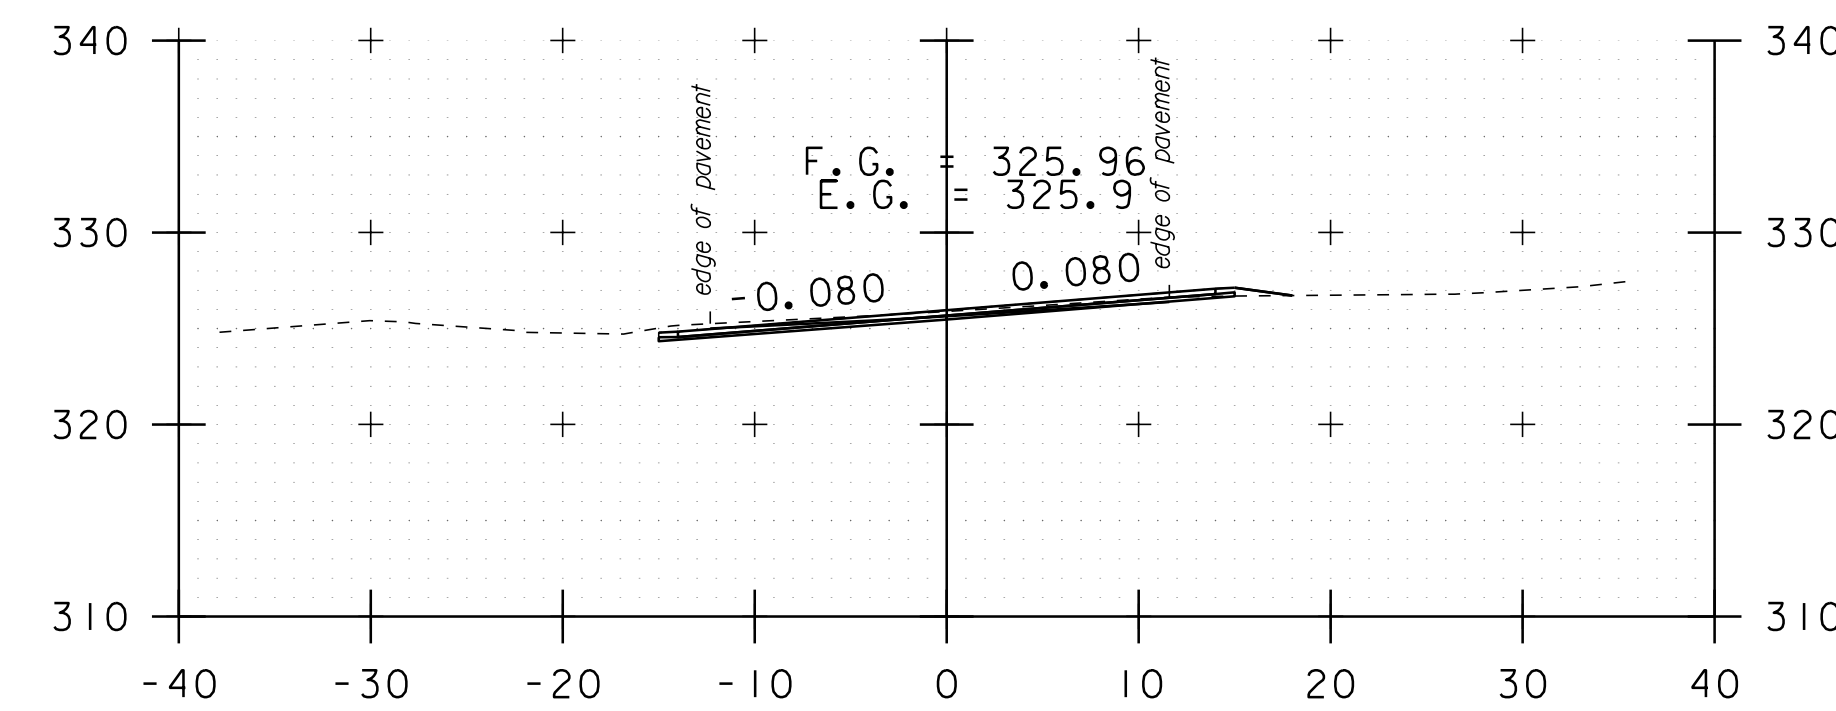

527+20
DRIVE RT

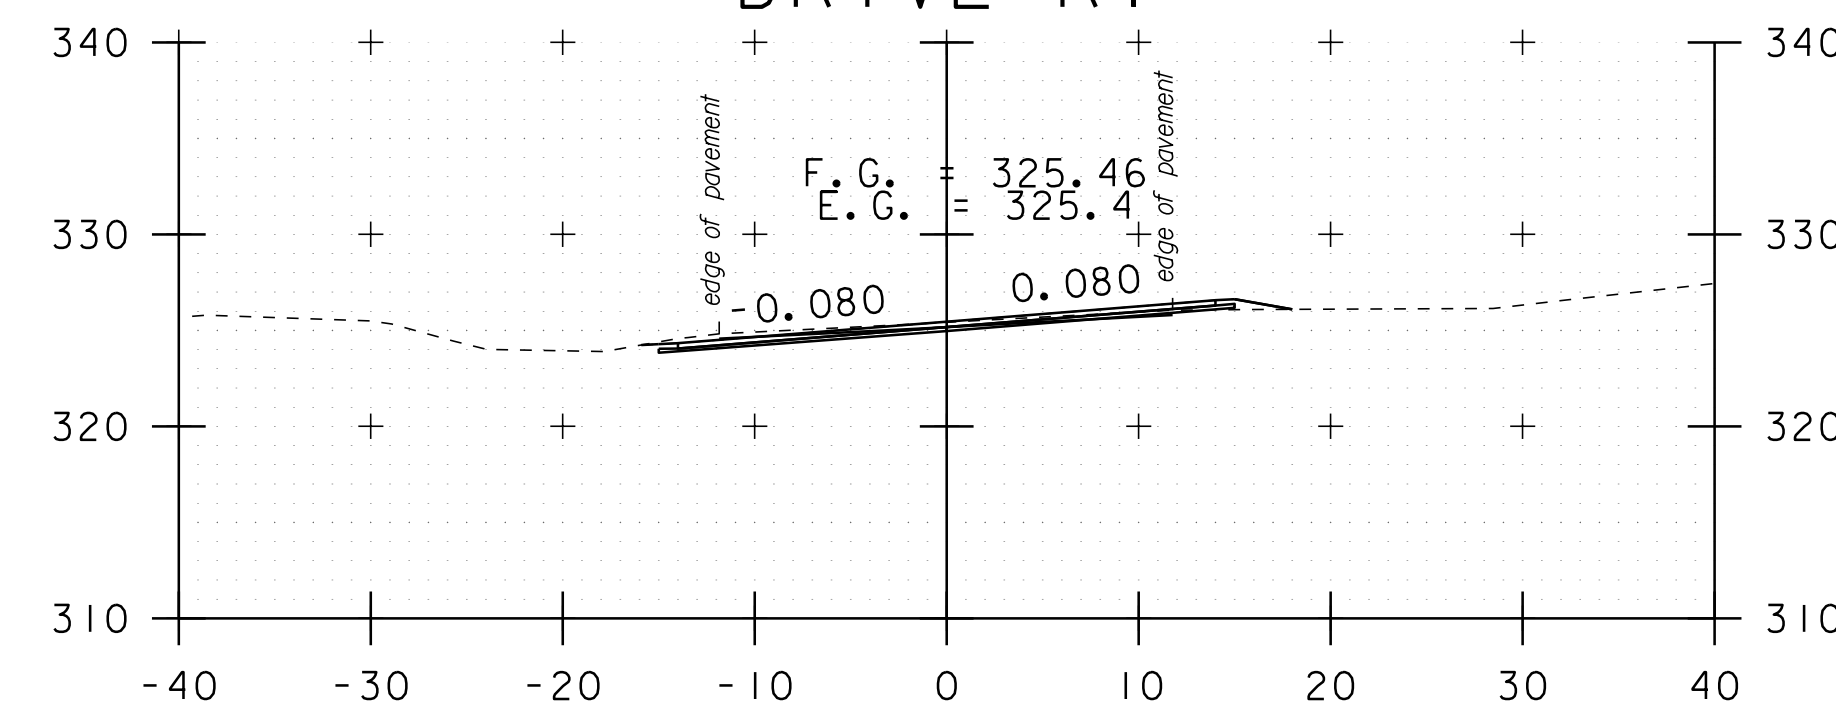


527+00
DRIVE RT

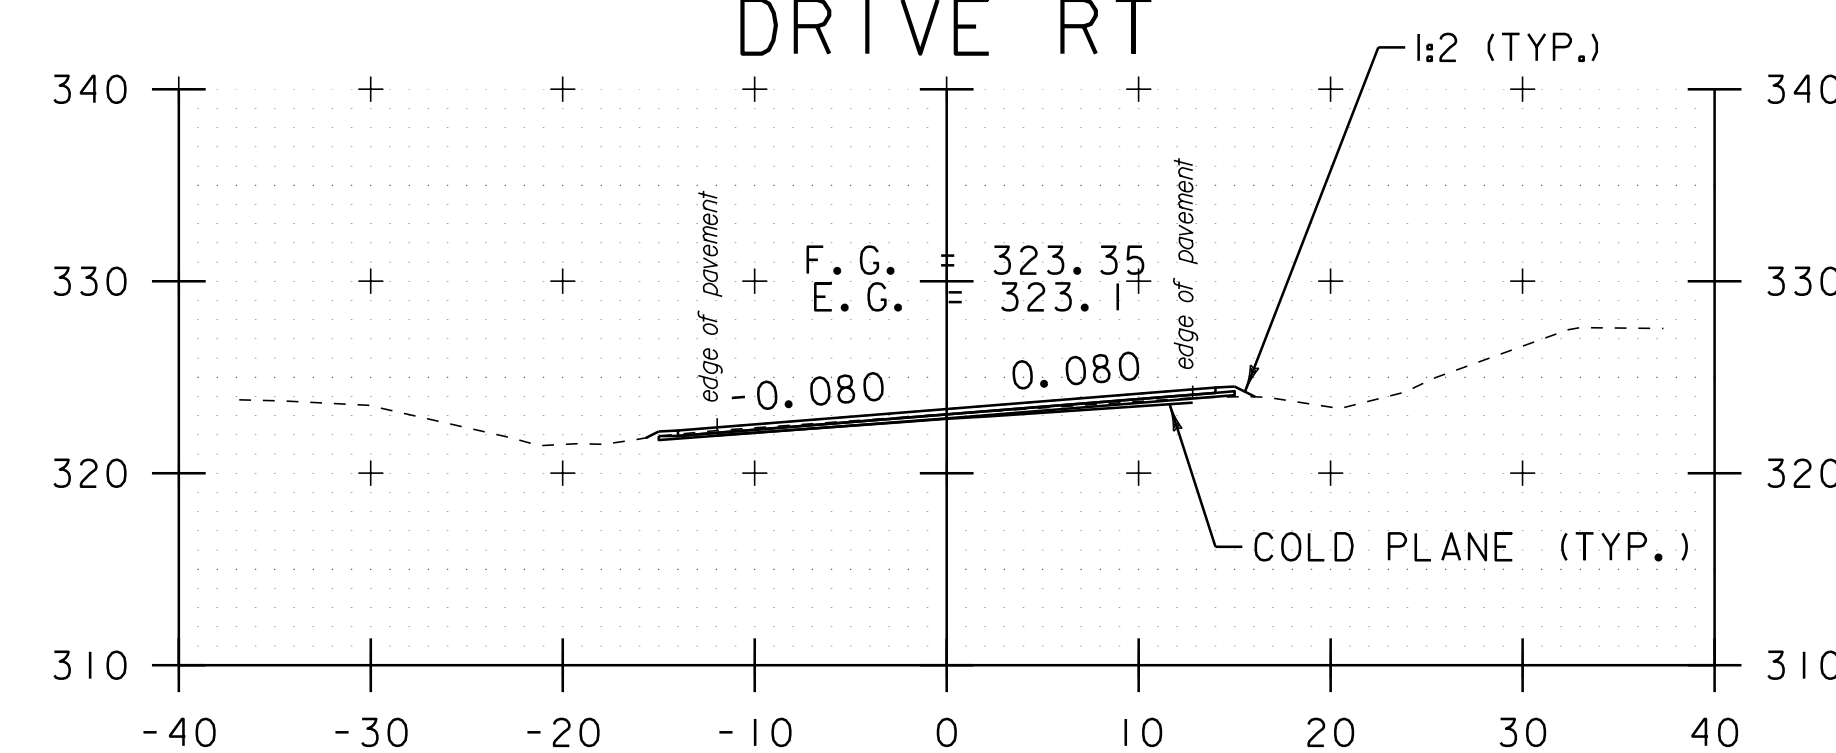

526+50

DATUM	NAVD 88
	NAD 83

STA. 523+60 TO STA. 527+20

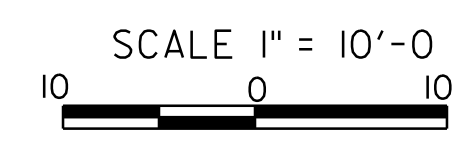

CROSS SECTION SHEET 8

PROJECT NAME:	ADDISON-NEW HAVEN	PLOT DATE:	3/13/2012
PROJECT NUMBER:	STP 9632(1)	DRAWN BY:	SJL
FILE NAME:	p95B076.dgn	CHECKED BY:	EPD
PROJECT LEADER:	CDL	SHEET	113 OF 186
DESIGNED BY:	SJL		
PLOT FILE:	p95B076_113.1		