




535+65

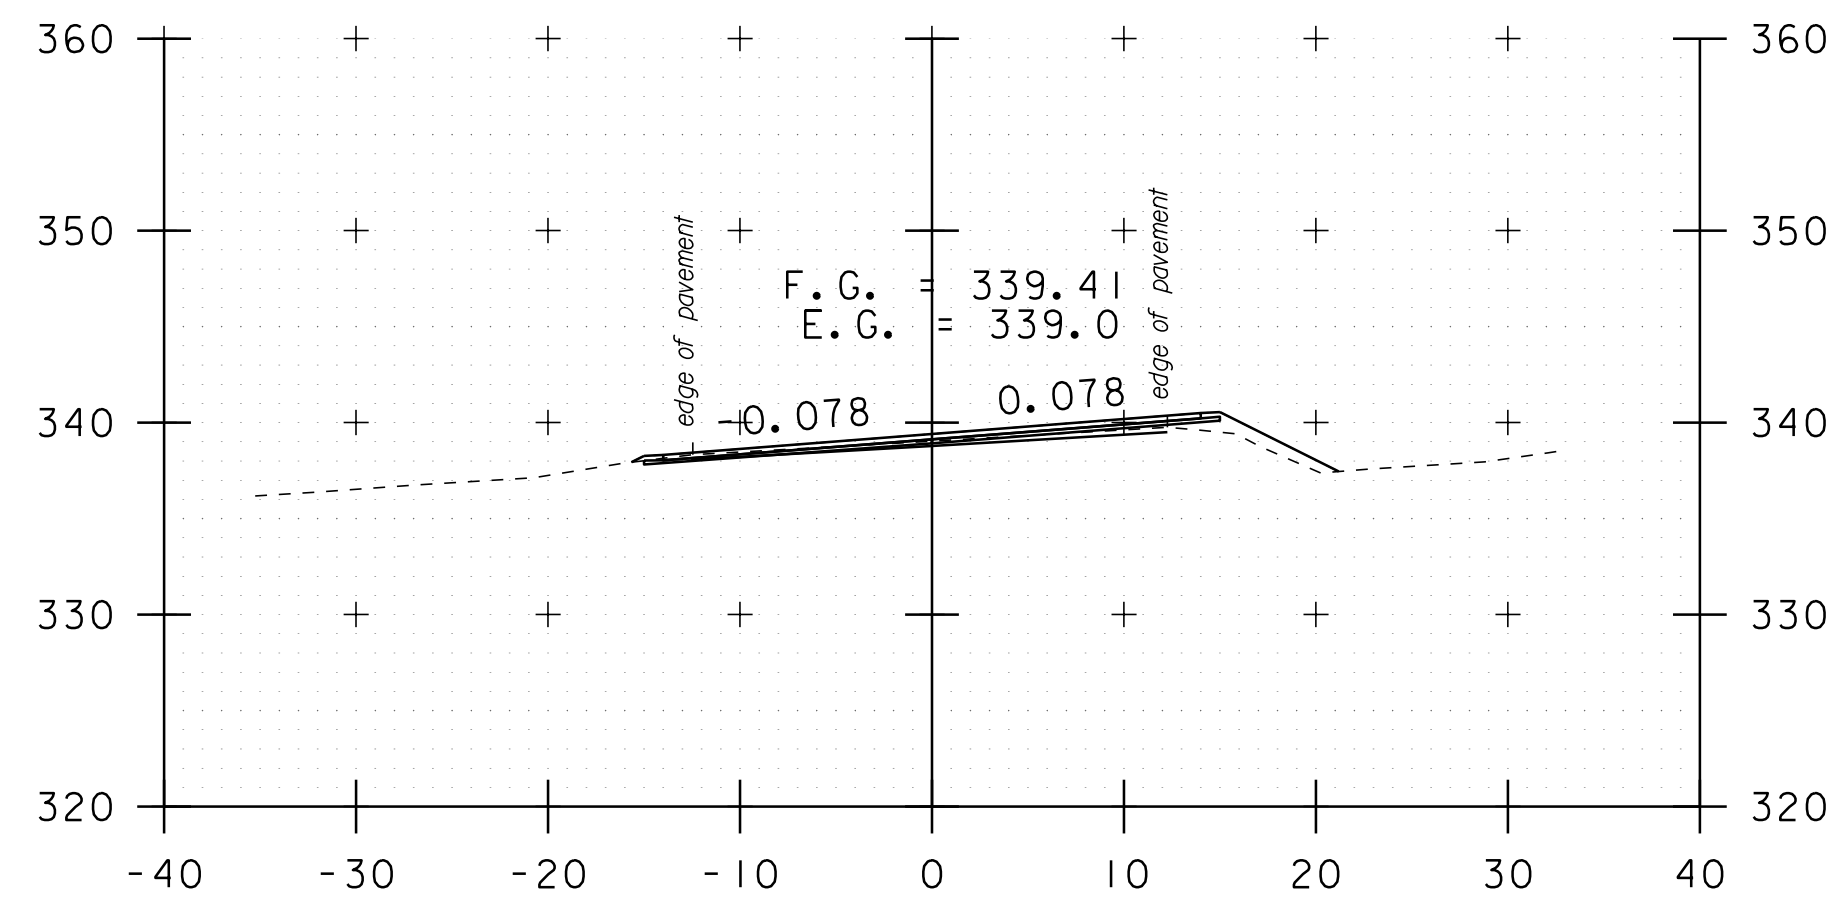


537+00

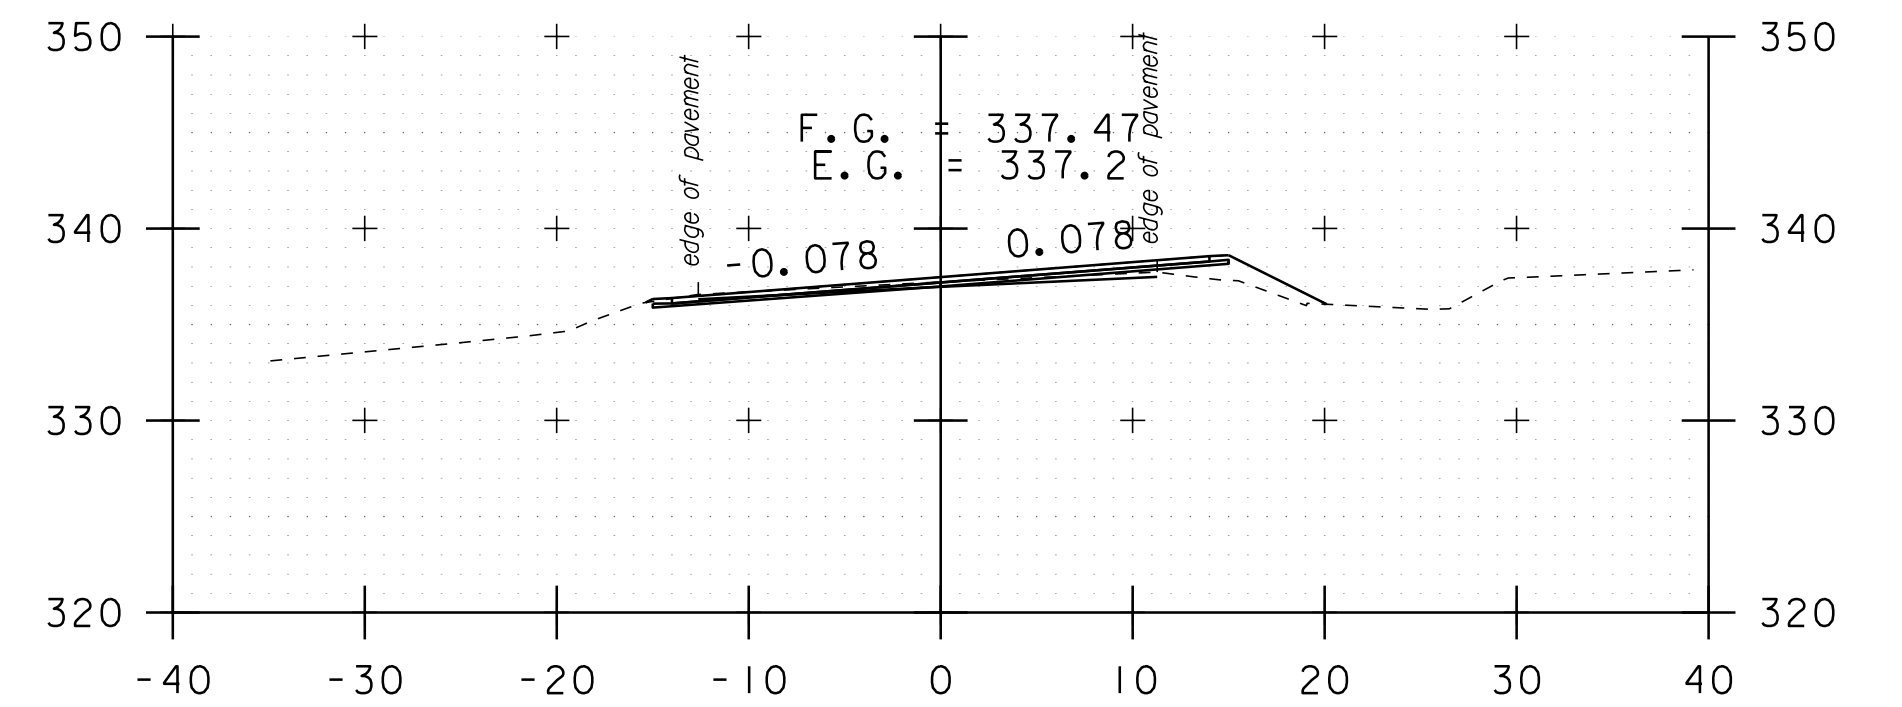


538+20

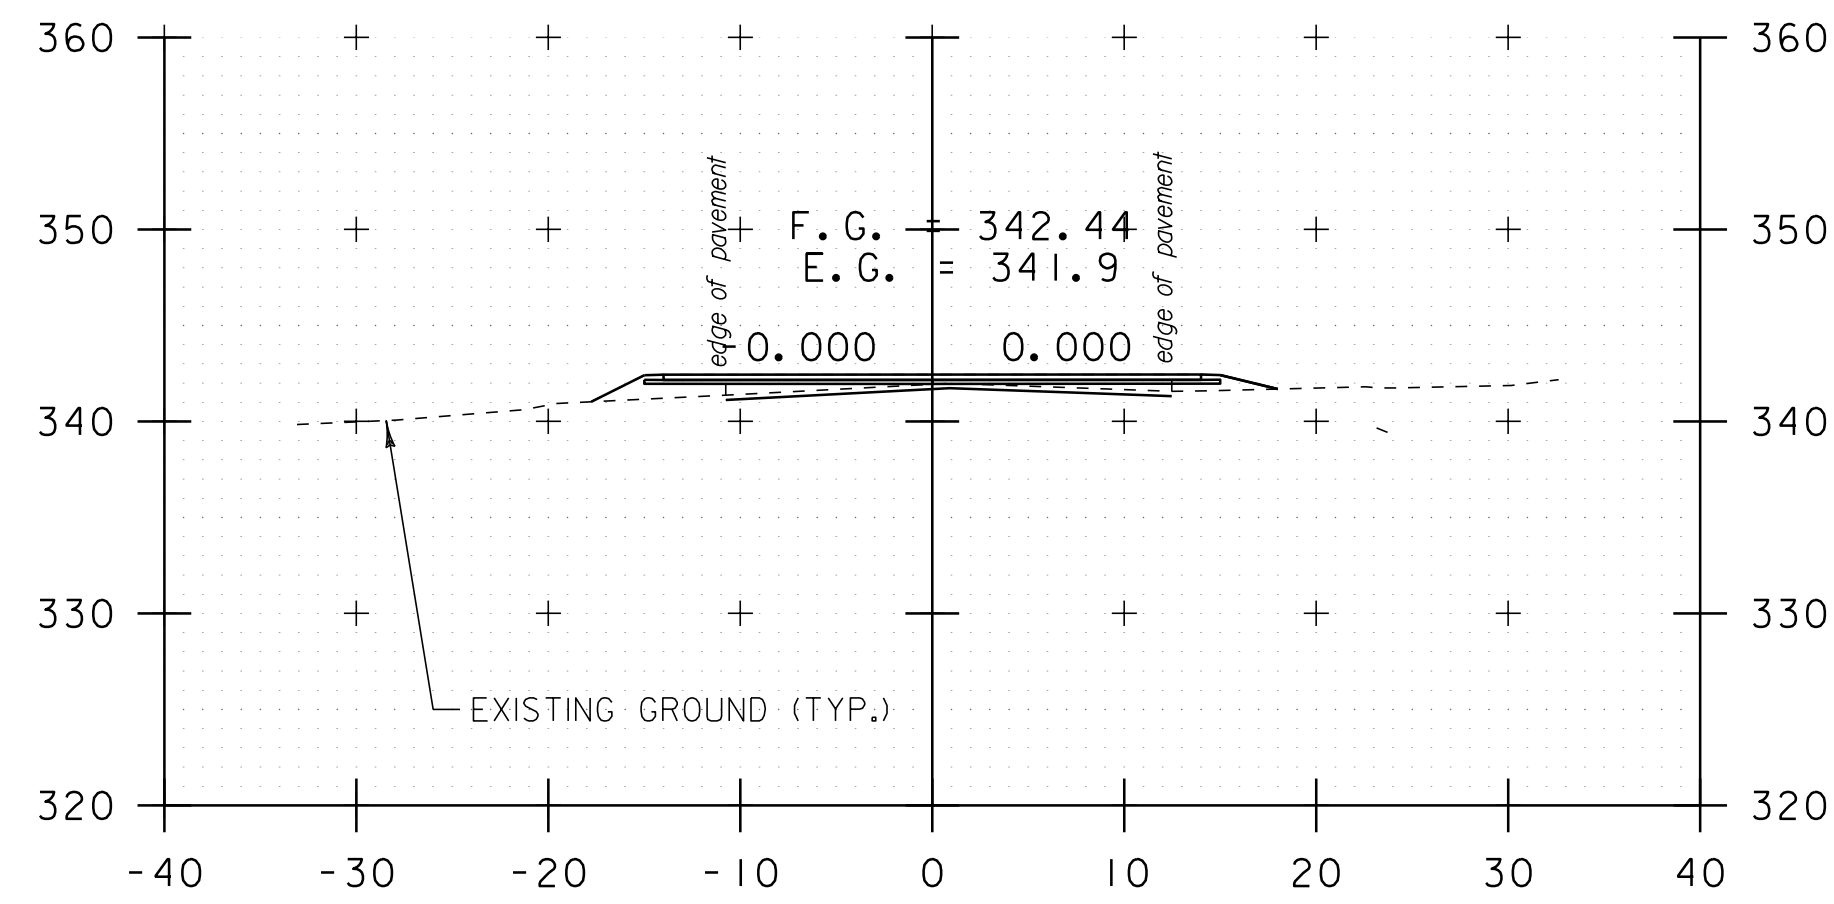


534+50
DRIVE RT

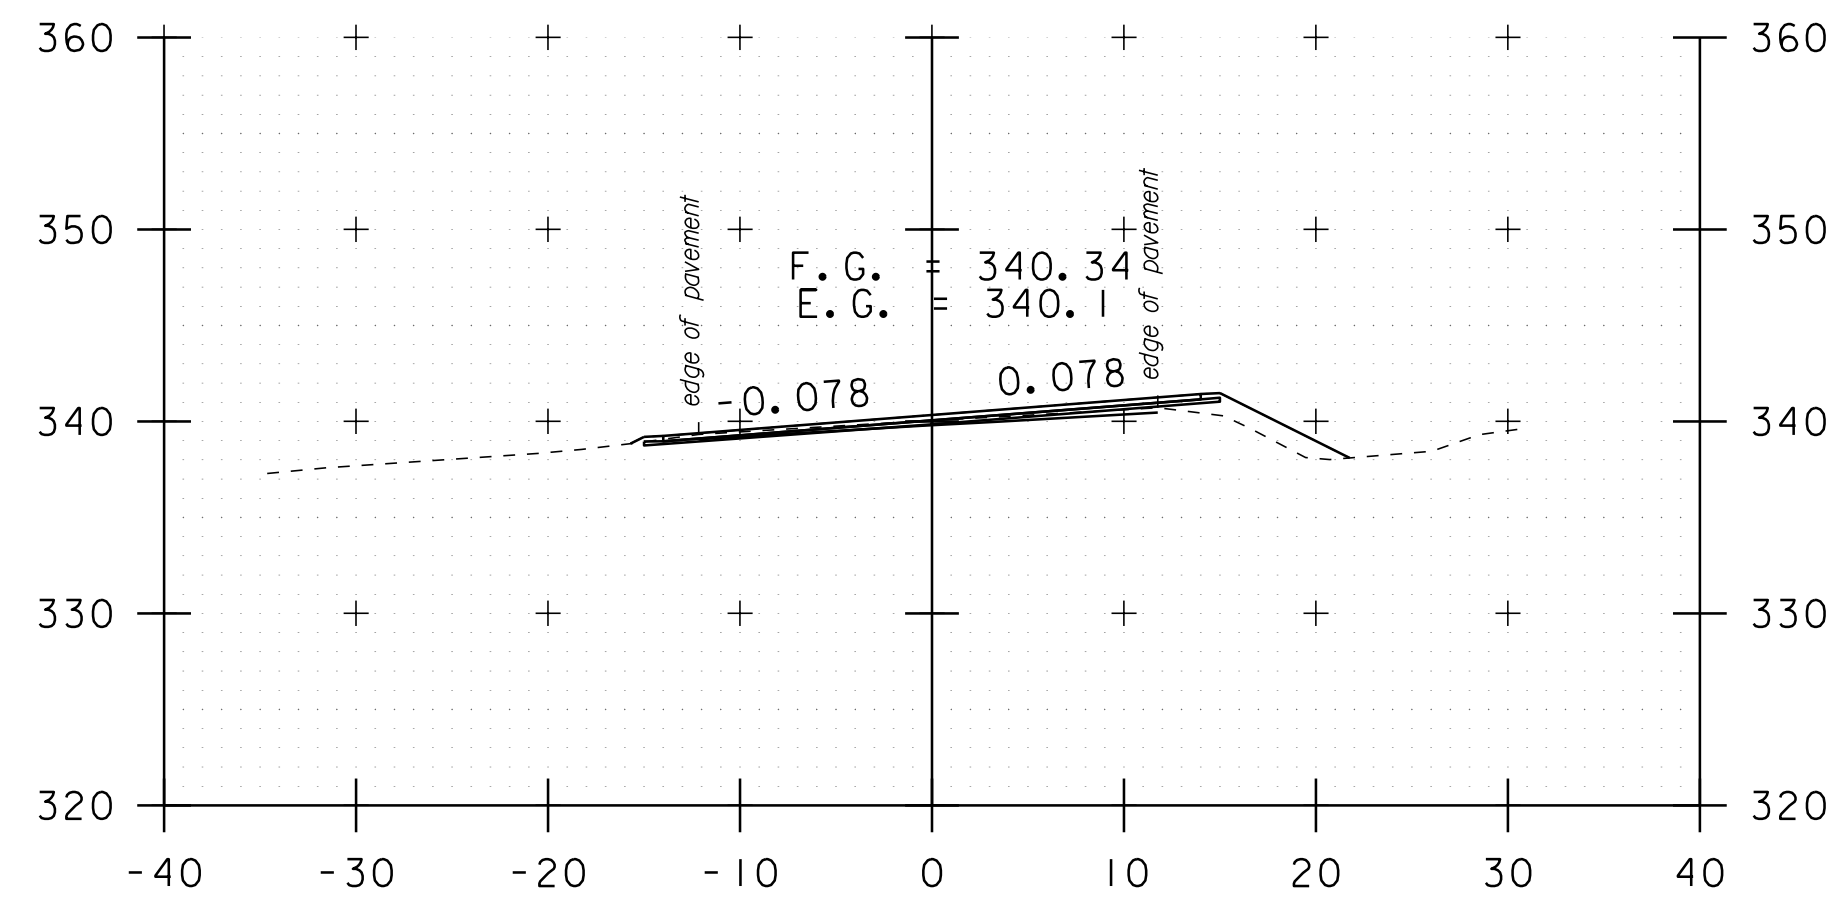


536+50

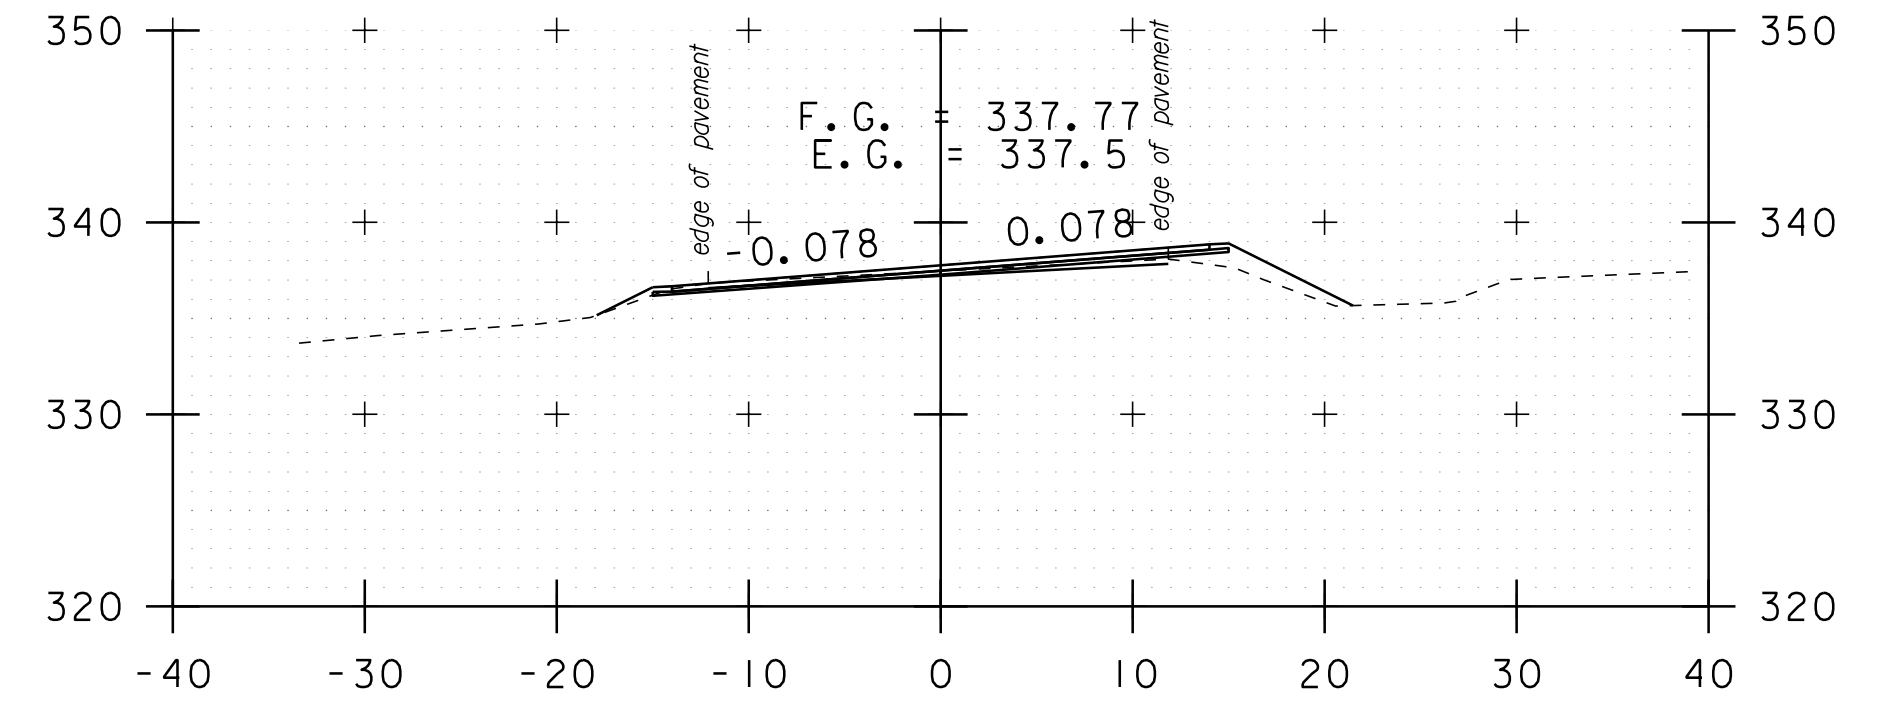


538+00

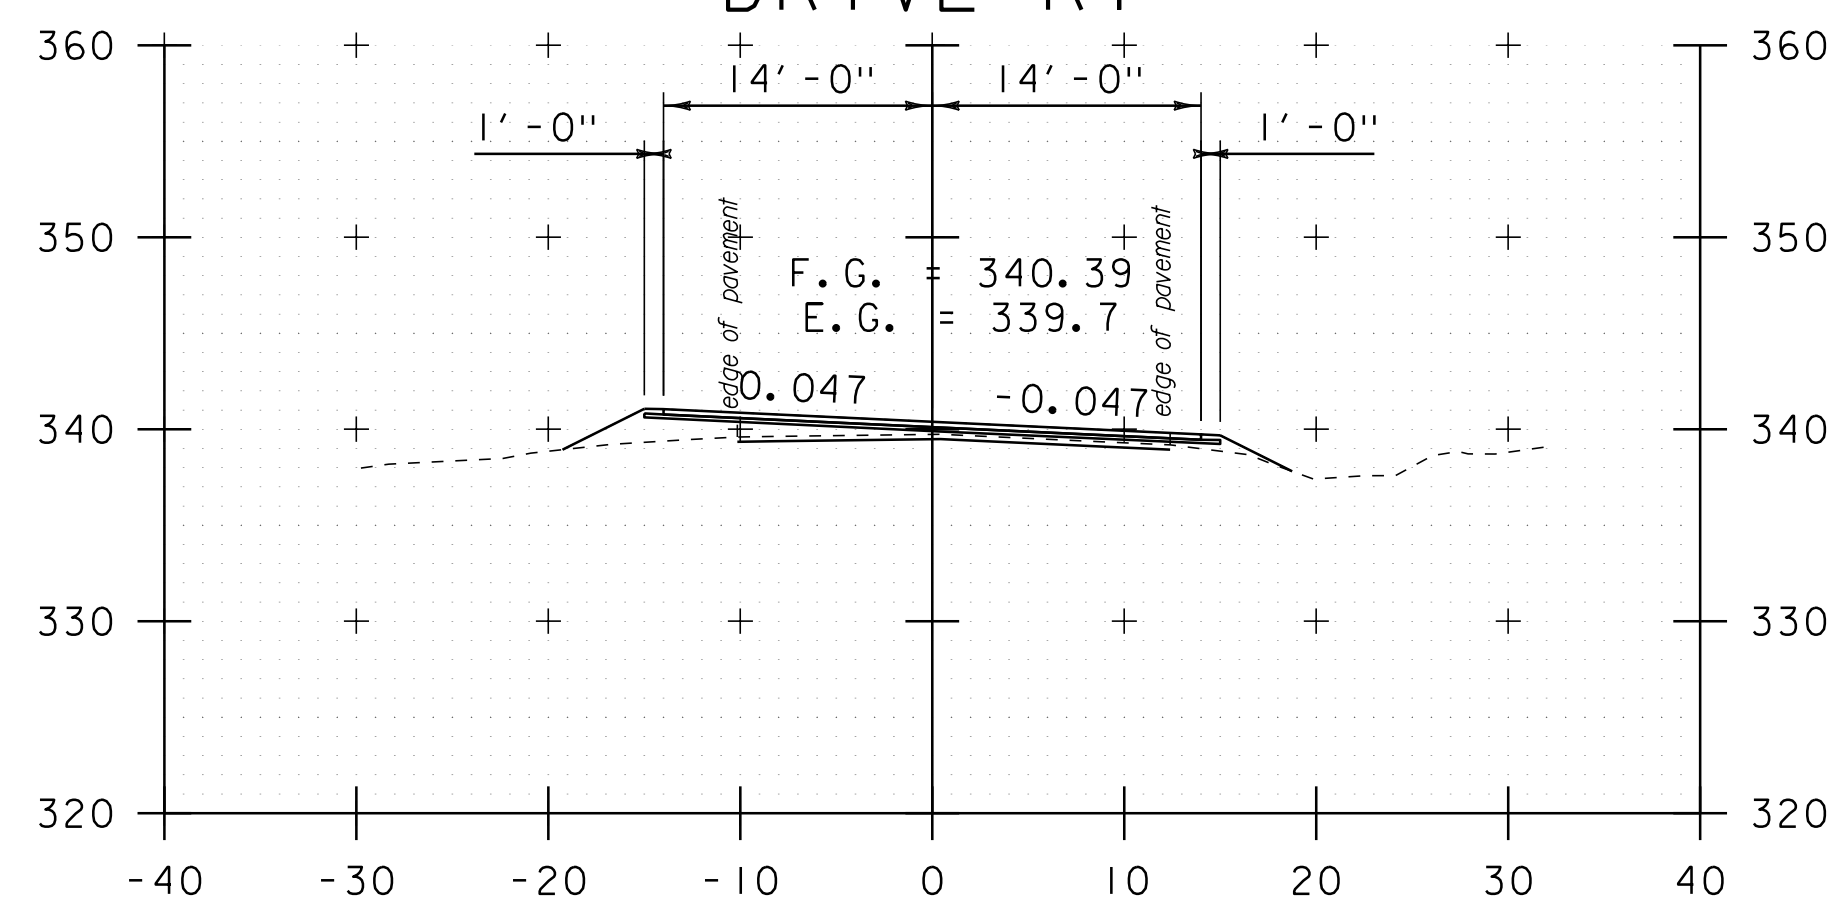

533+50

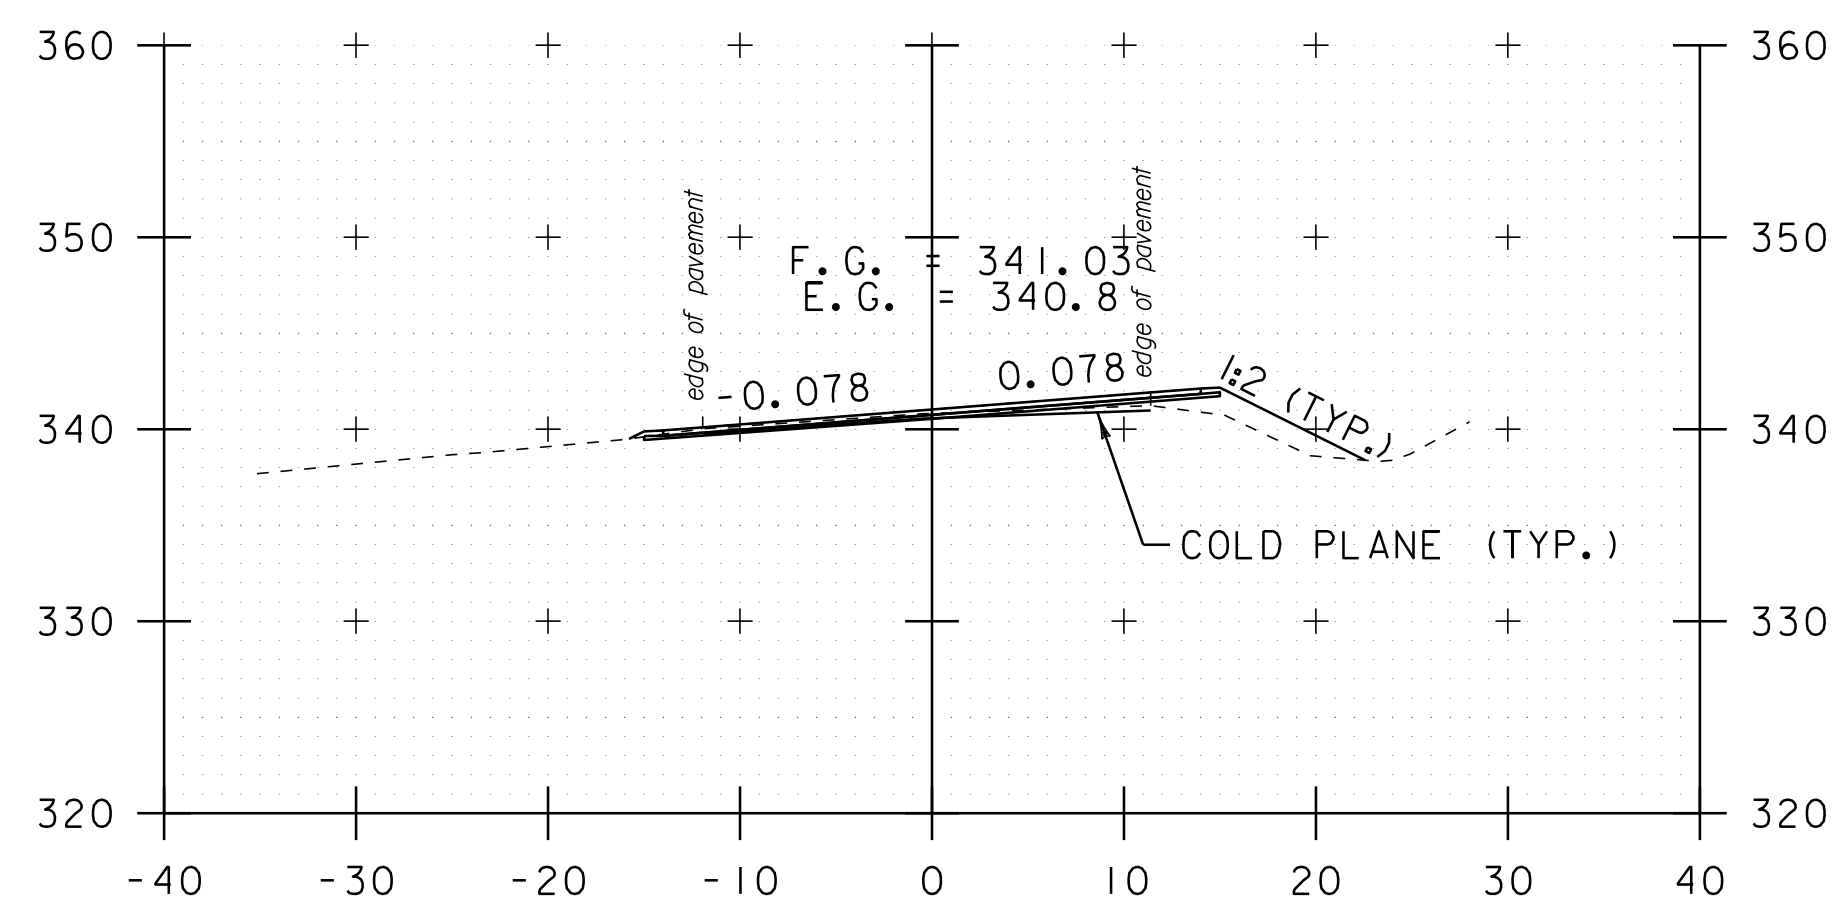


536+15

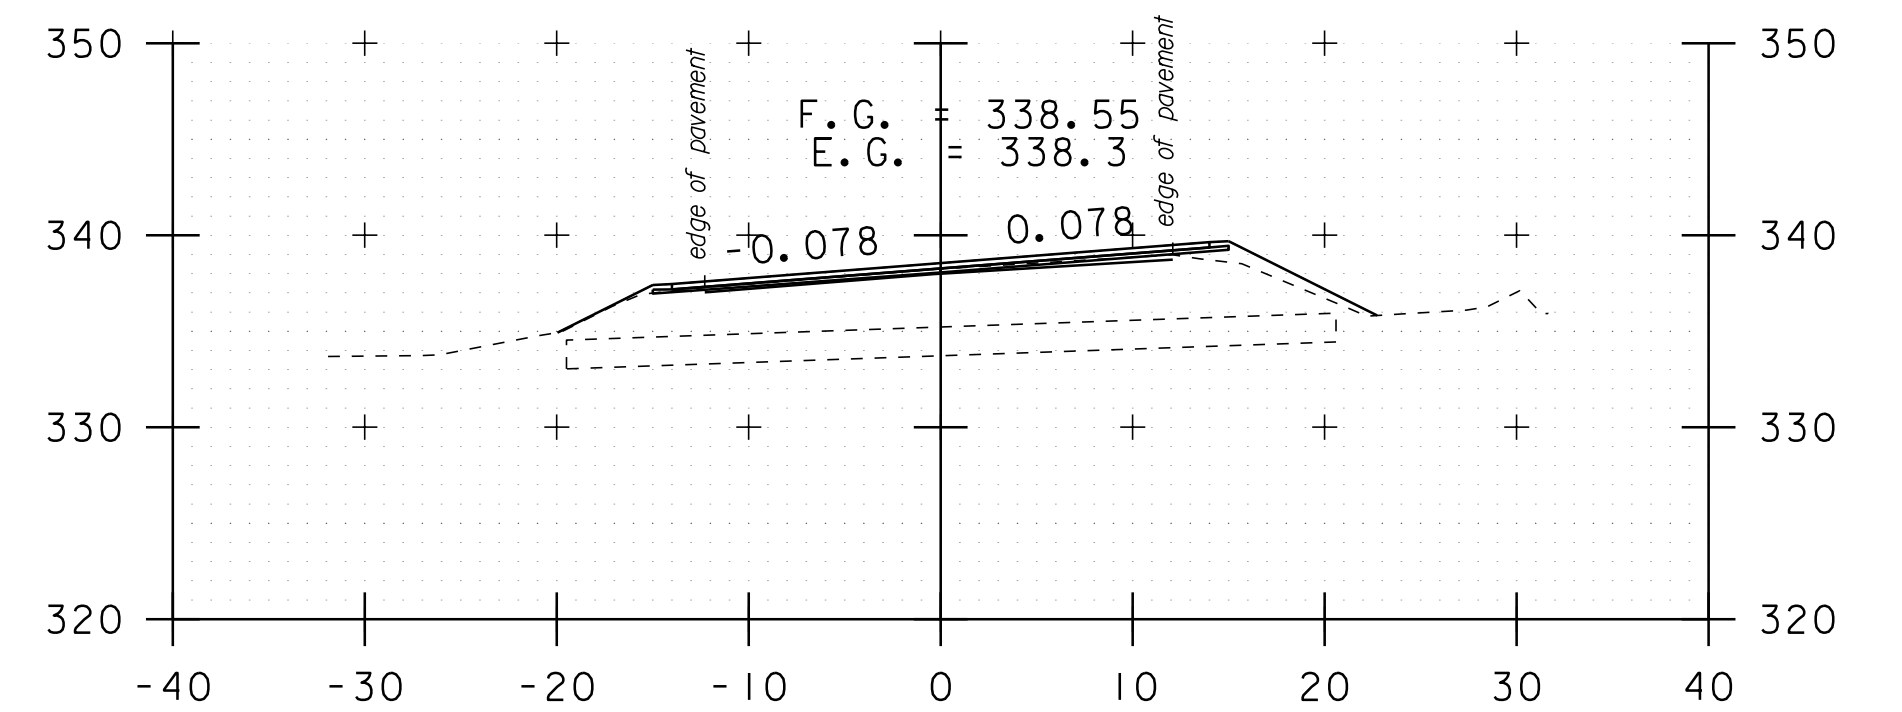

537+50

DATUM	NAVD 88
	NAD 83

STA. 533+50 TO STA. 538+20

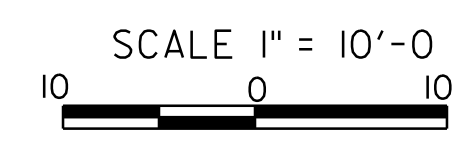

CROSS SECTION SHEET 10

PROJECT NAME:	ADDISON-NEW HAVEN	PLOT DATE:	3/13/2012
PROJECT NUMBER:	STP 9632(1)	DRAWN BY:	SJL
FILE NAME:	p95B076.dgn	CHECKED BY:	EPD
PROJECT LEADER:	CDL	SHEET	115 OF 186
DESIGNED BY:	SJL		
PLOT FILE:	p95B076_115.1		