




539+50
DRIVE LT

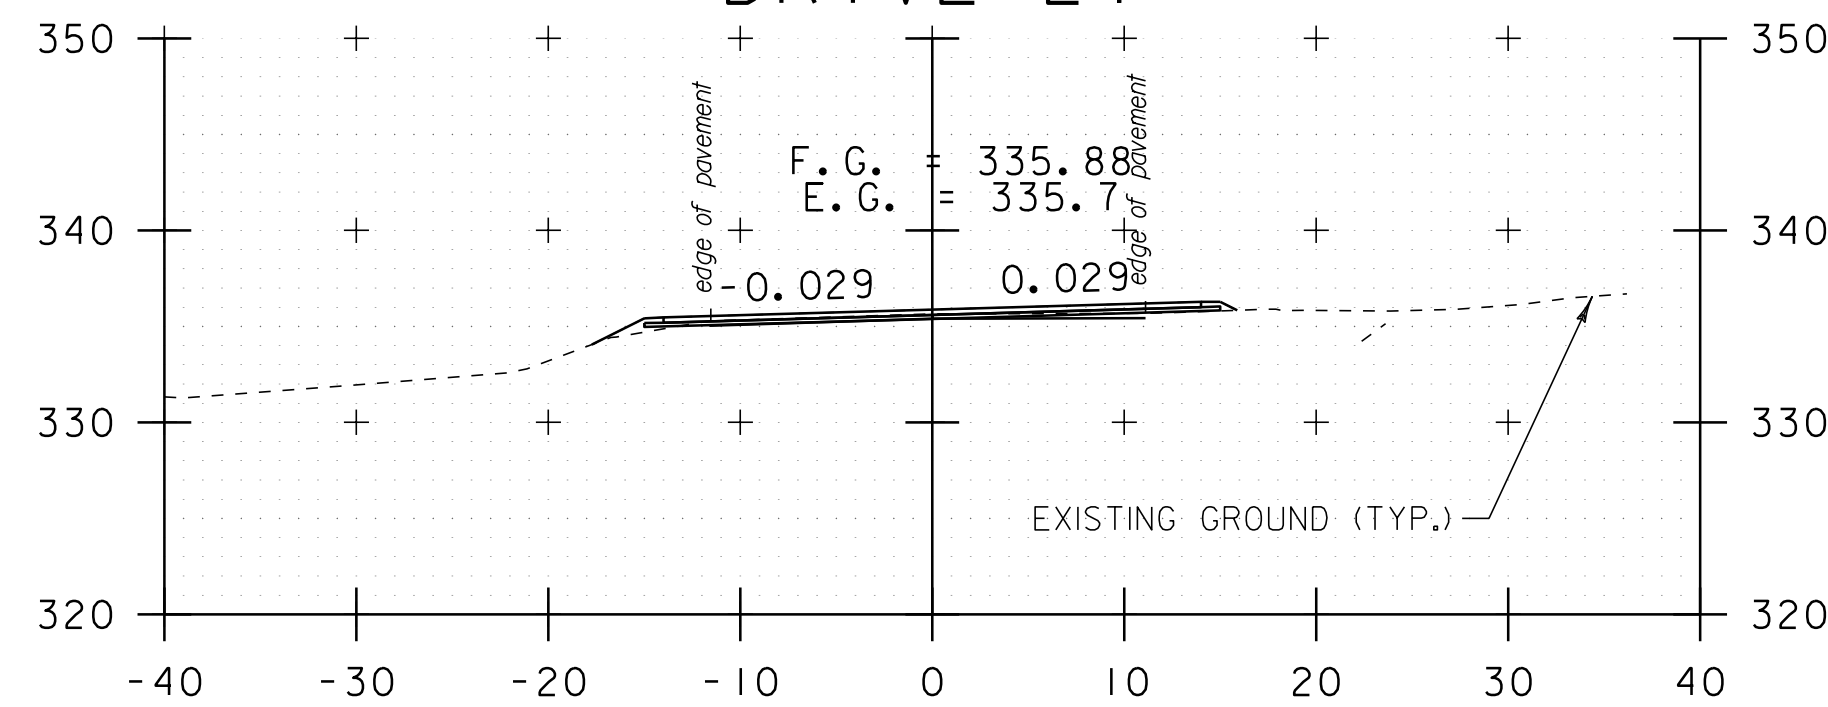


539+30

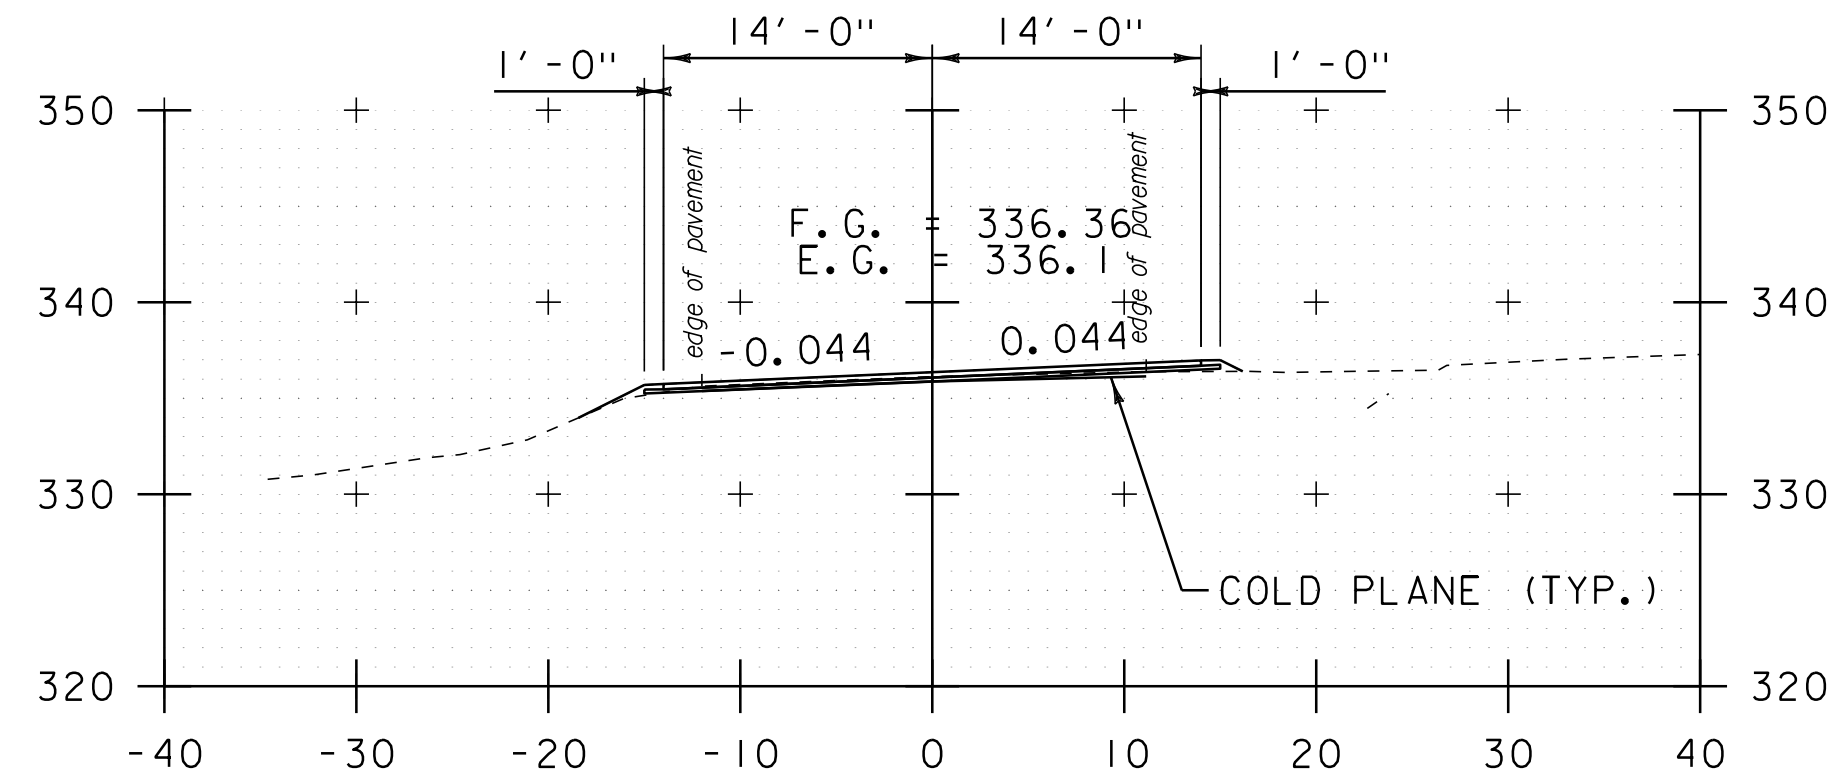


538+97

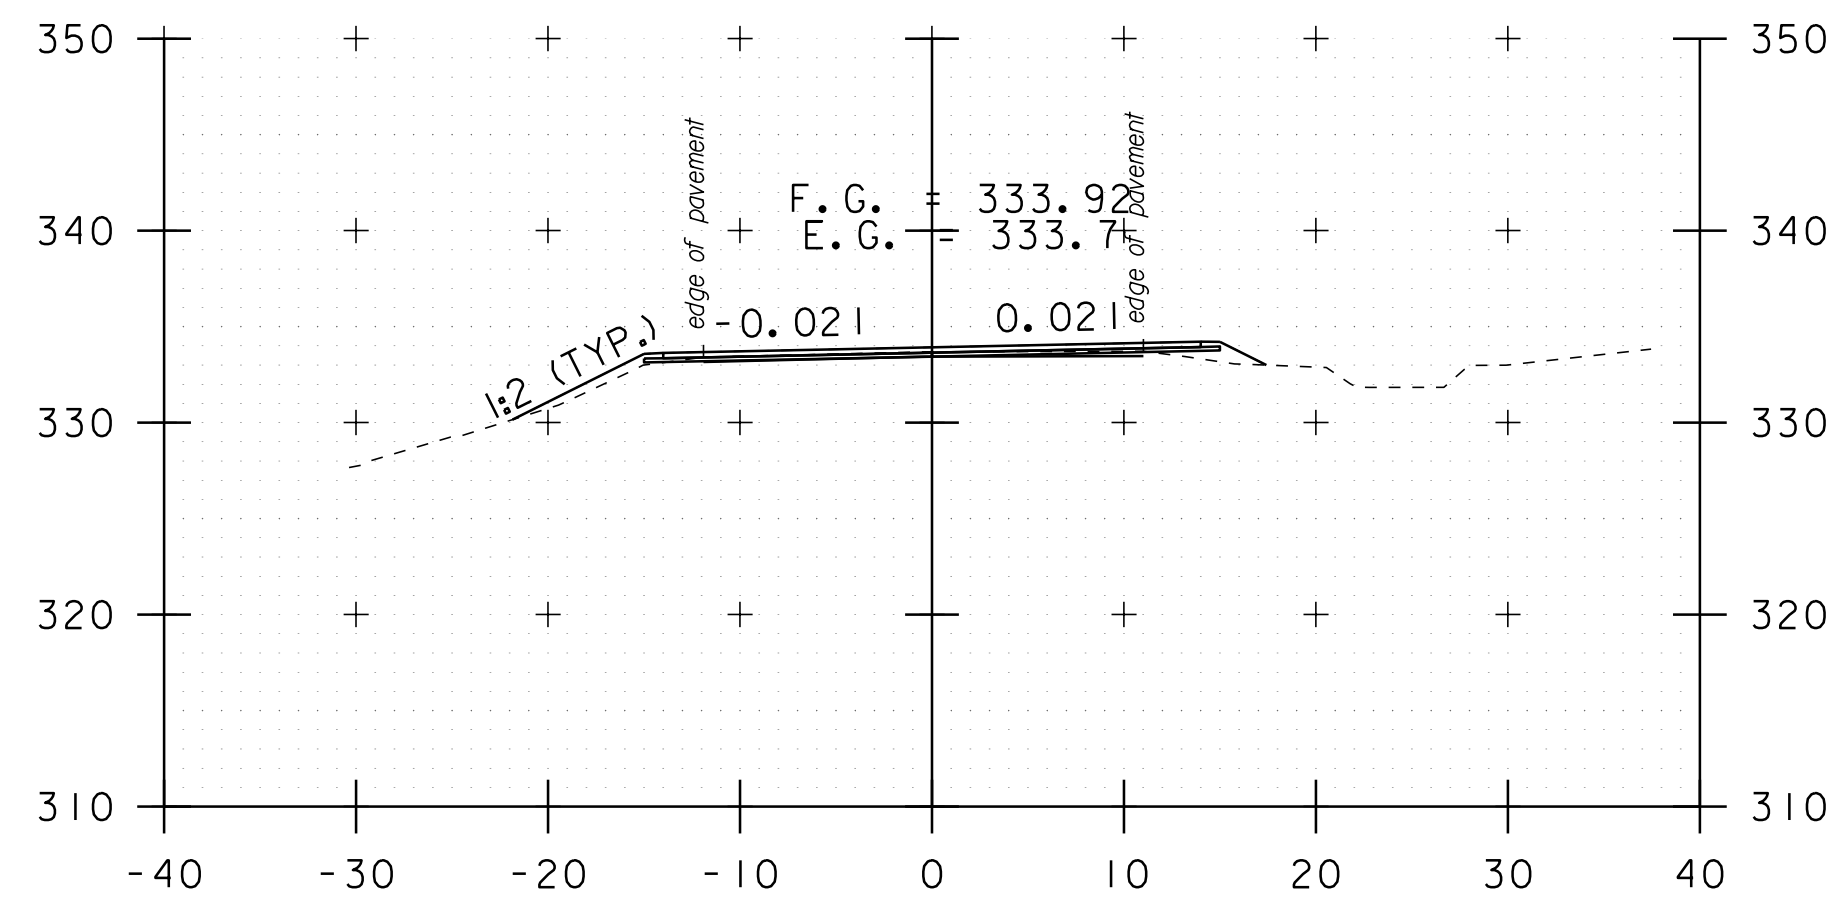


540+89

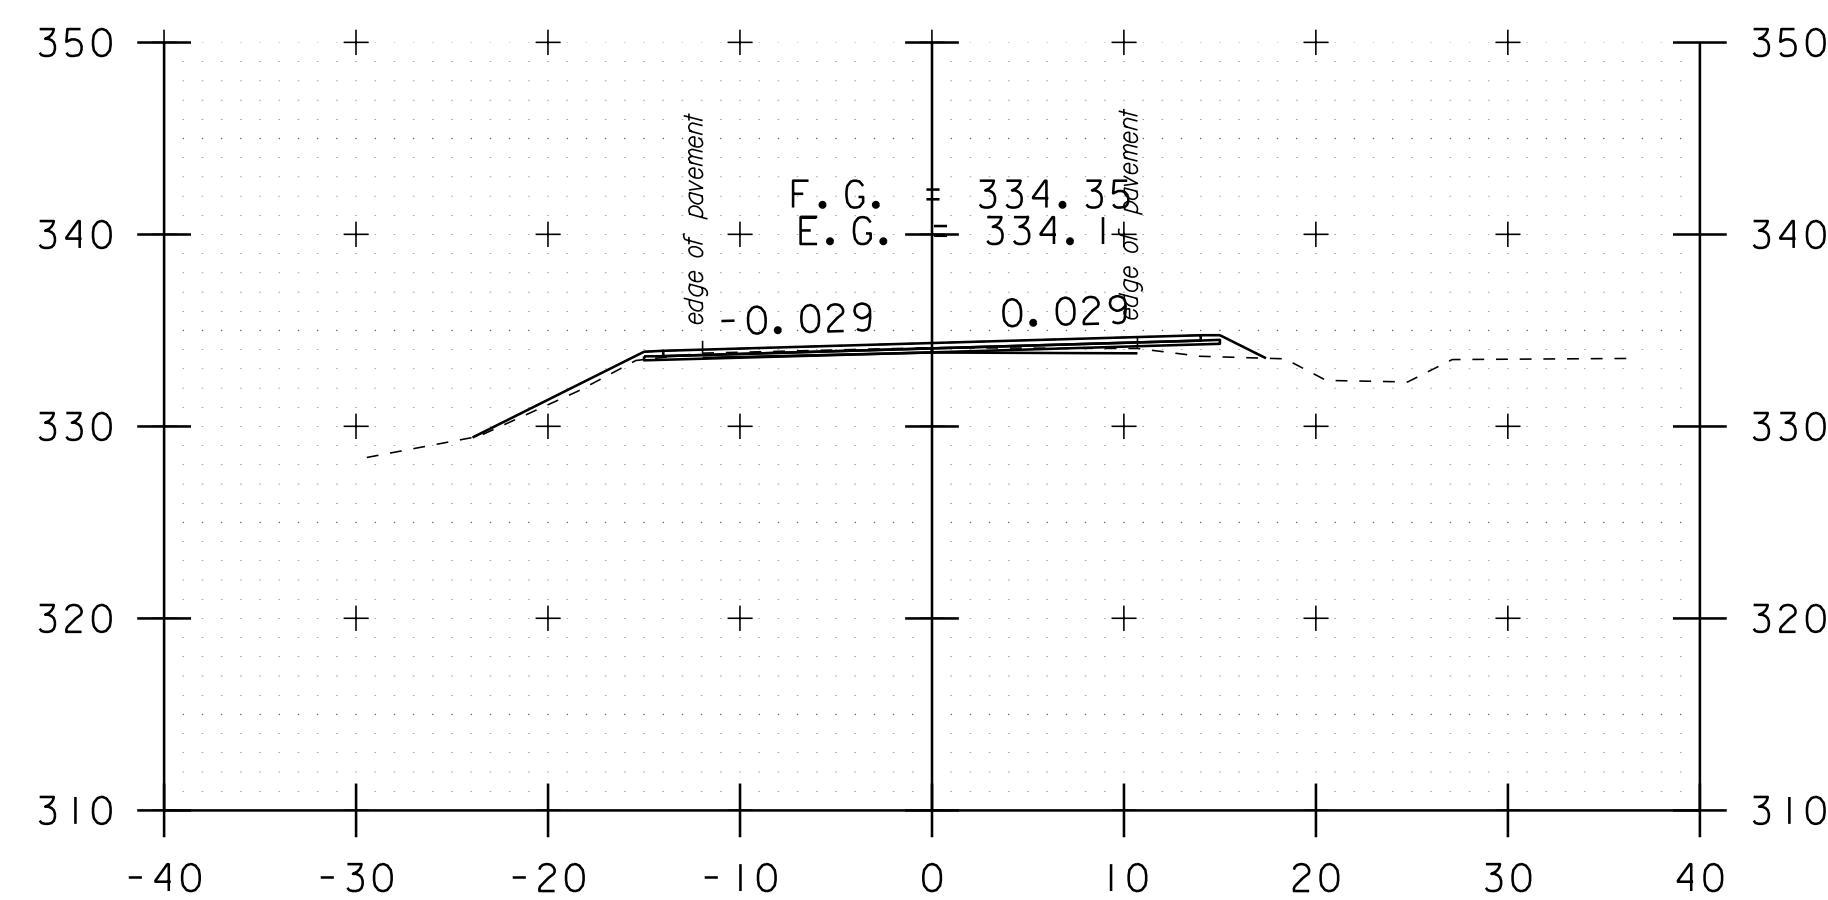


540+50

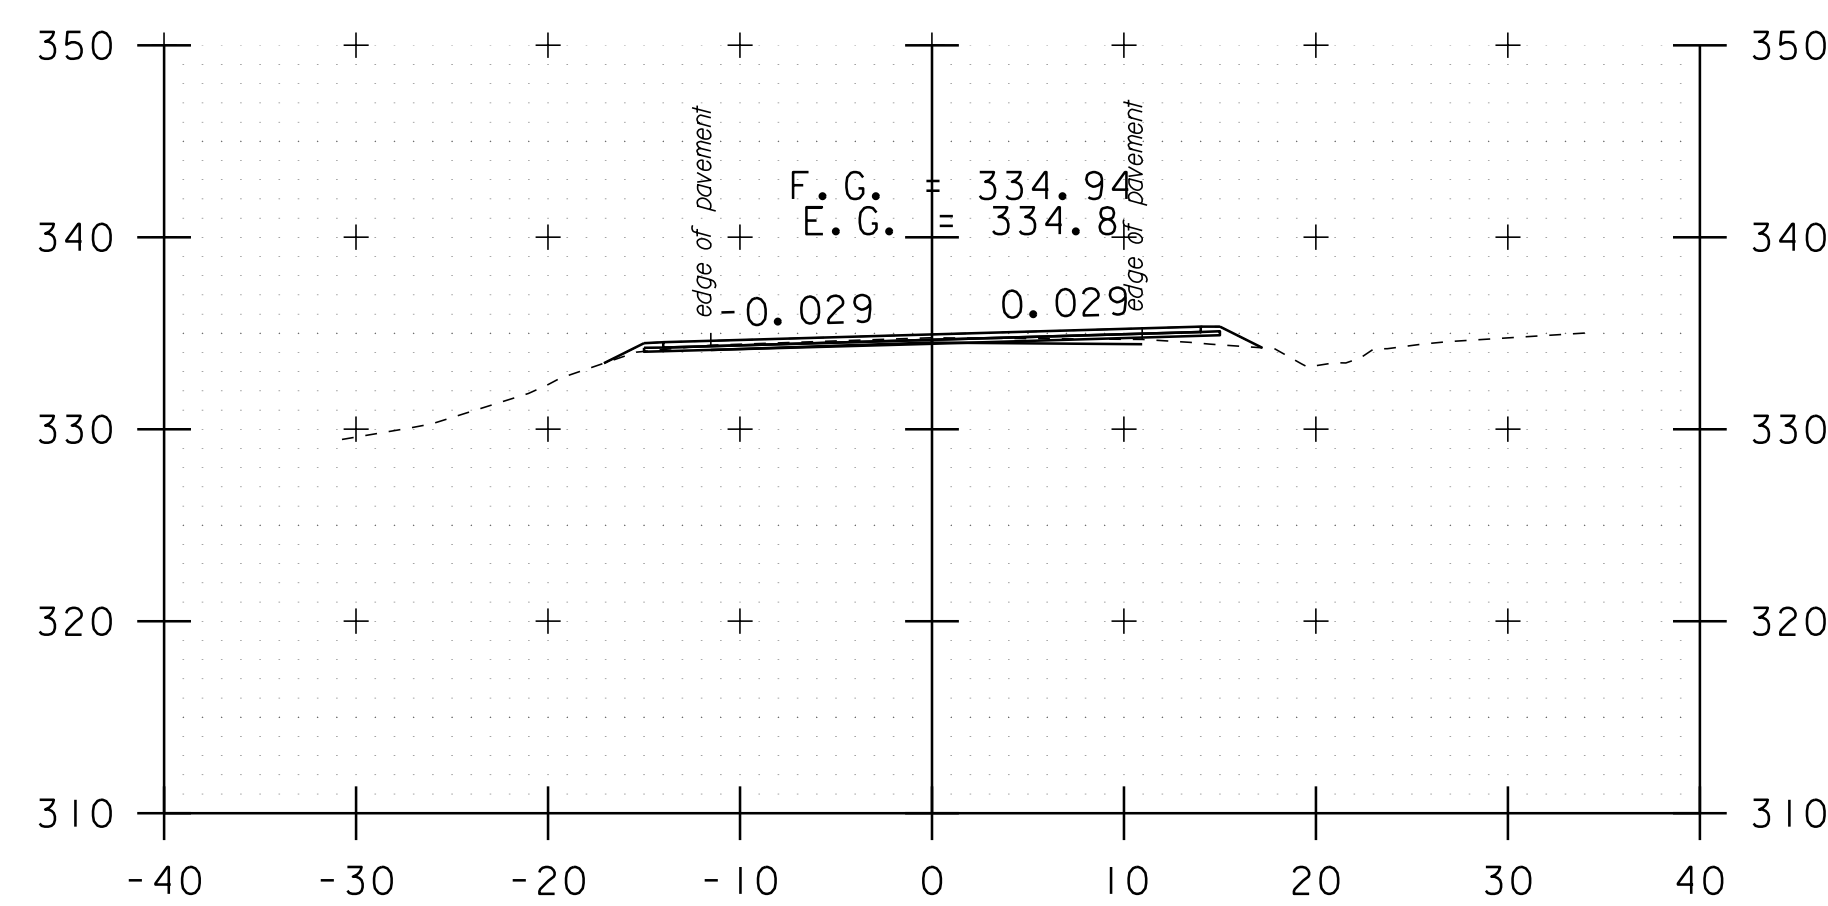


540+00

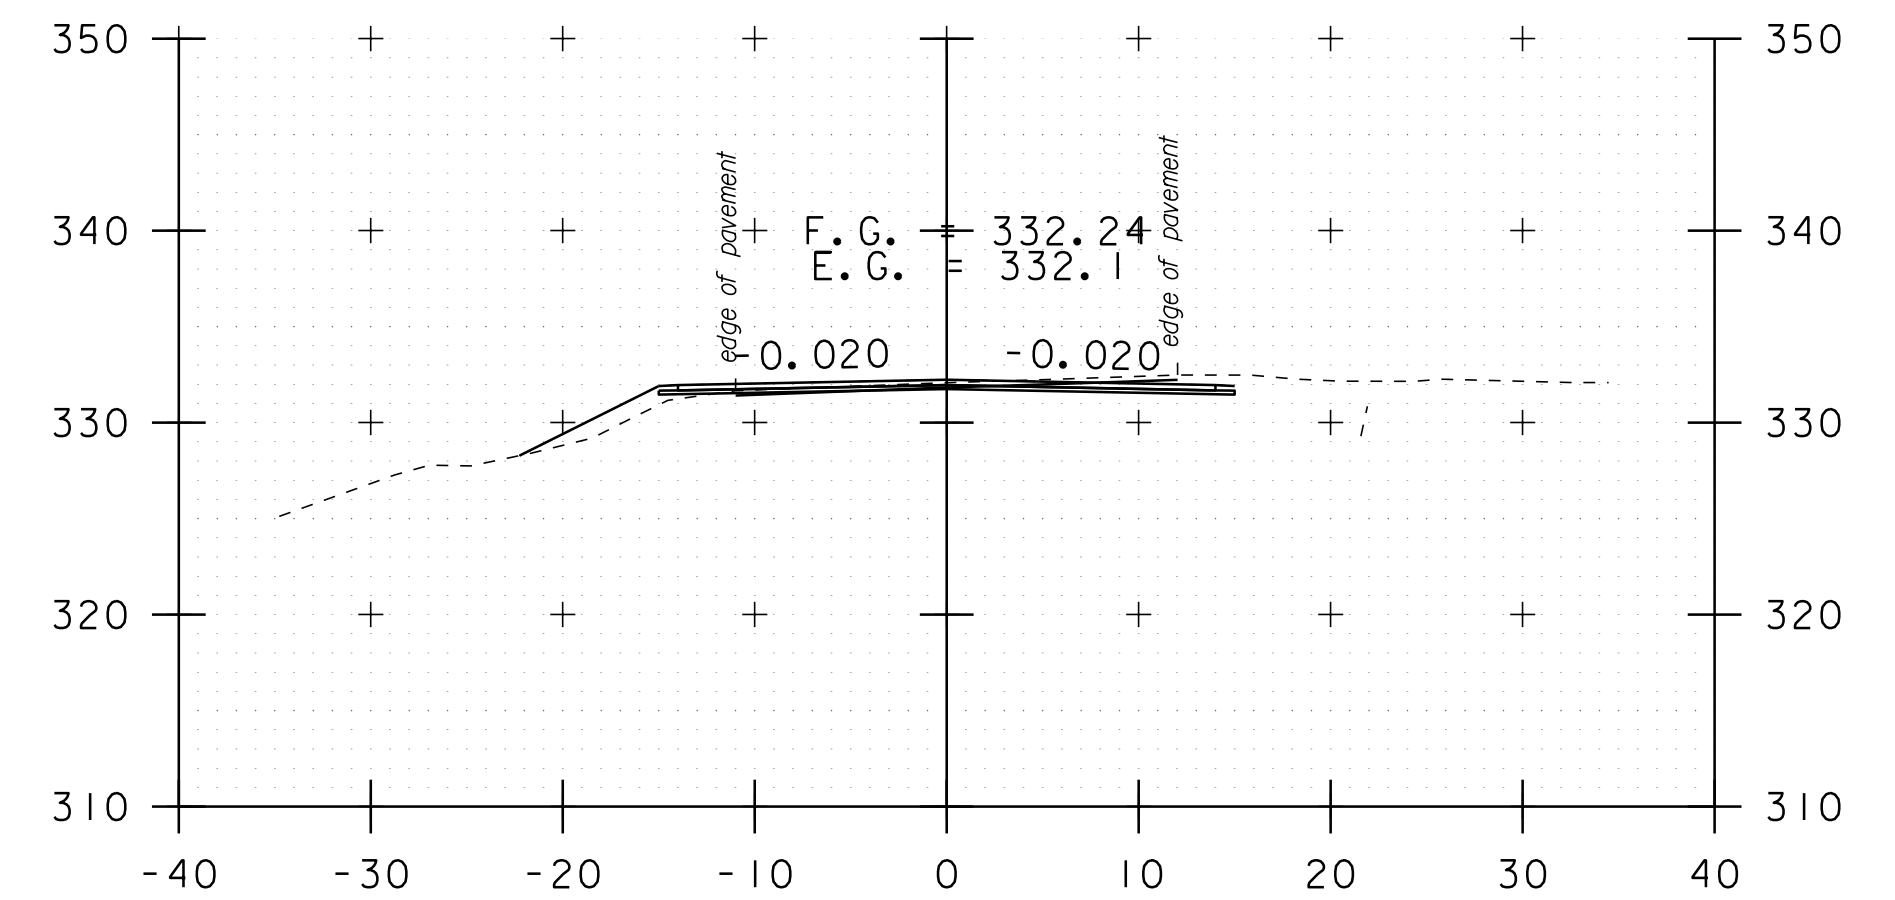

542+90

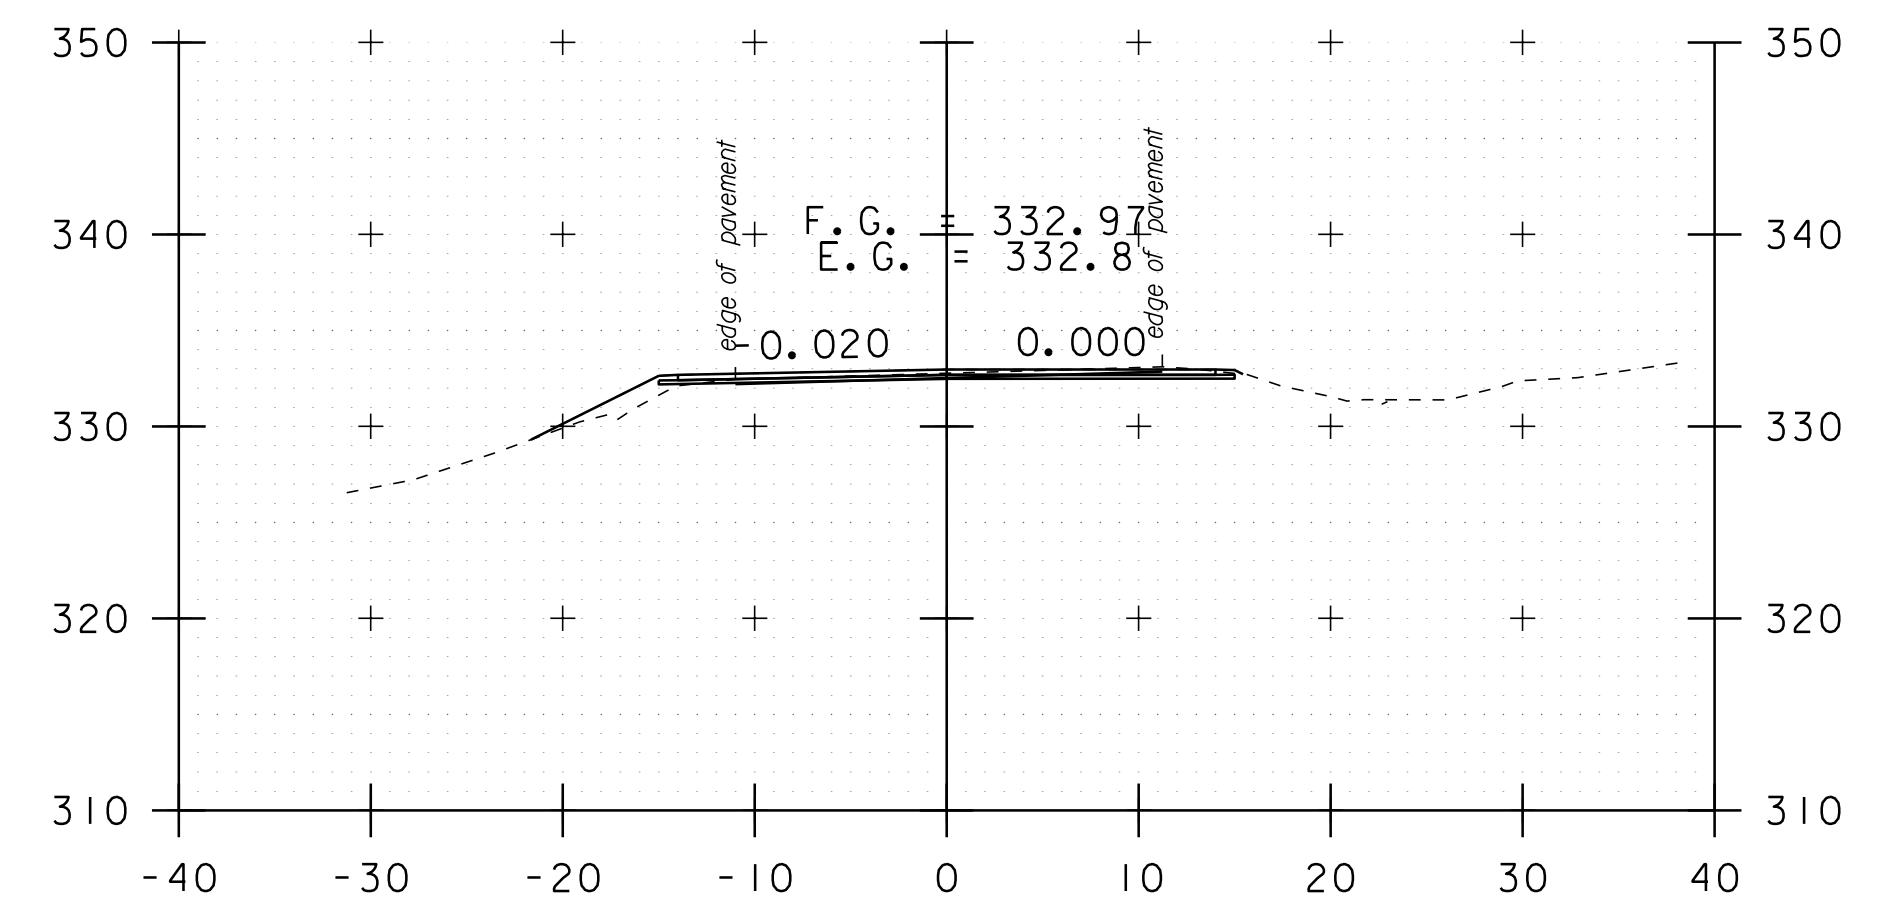


541+90

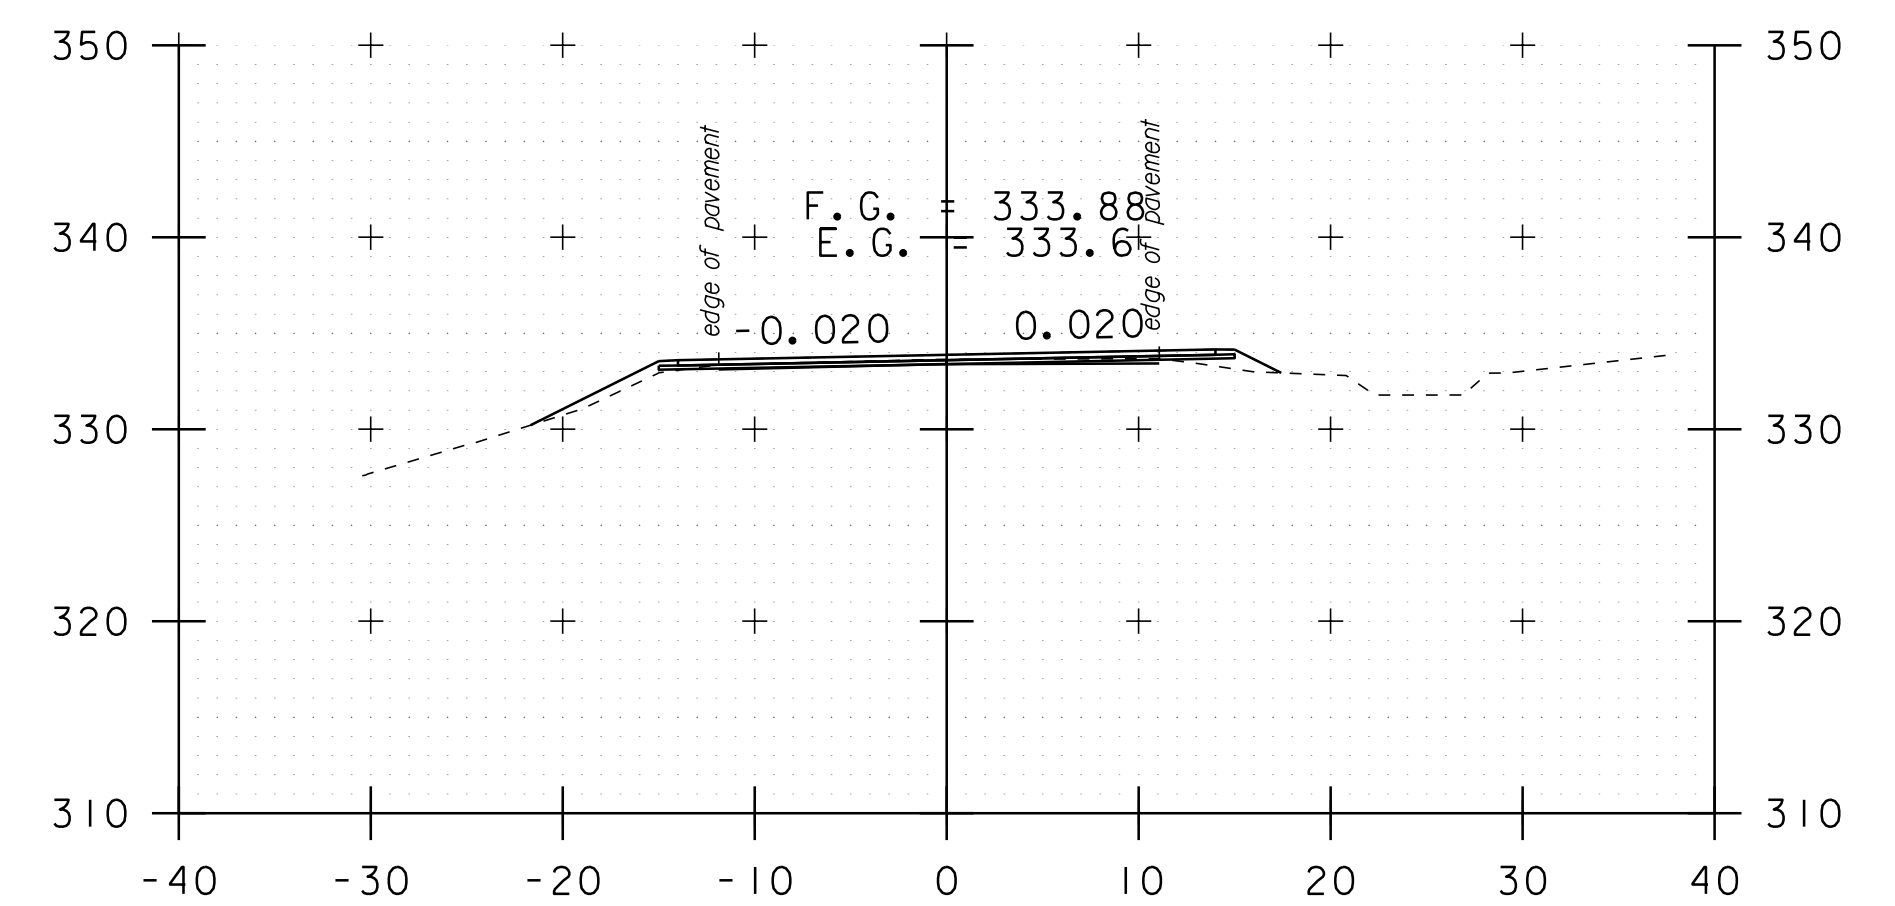

540+93

DATUM	NAVD 88
	NAD 83

STA. 538+97 TO STA. 542+90

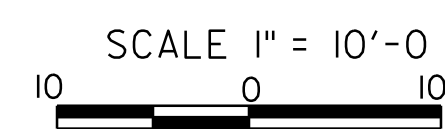

CROSS SECTION SHEET 11

PROJECT NAME: ADDISON-NEW HAVEN
PROJECT NUMBER: STP 9632(1)

FILE NAME: p95B076.dgn
PROJECT LEADER: CDL
DESIGNED BY: SJL
PLOT FILE: p95B076_116.1

PLOT DATE: 3/13/2012
DRAWN BY: SJL
CHECKED BY: EPD
SHEET 116 OF 186