




545+50

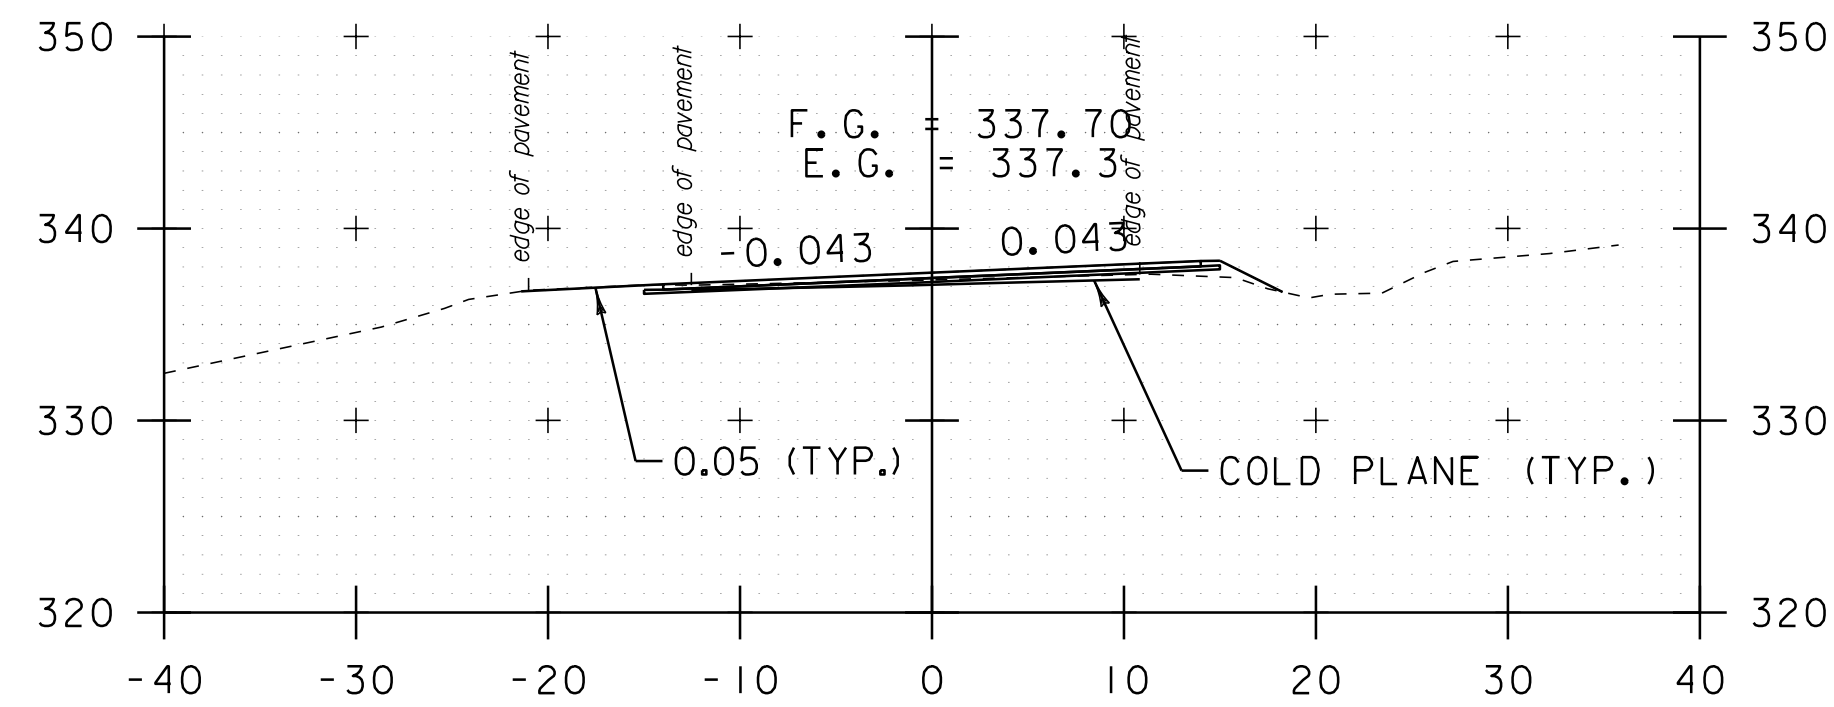


547+48

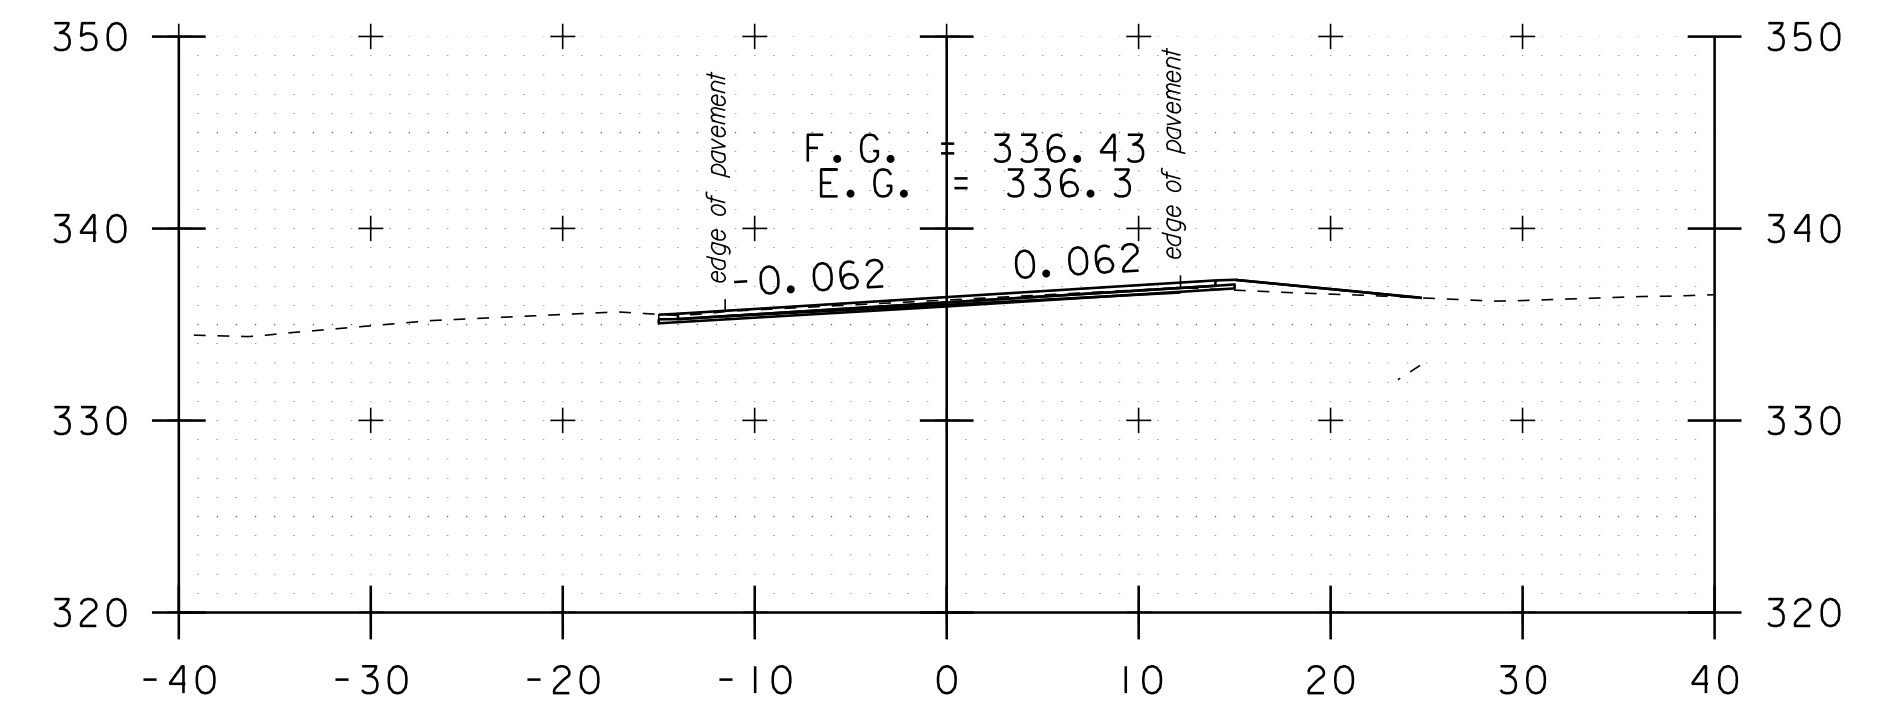


548+50  
DRIVE RT

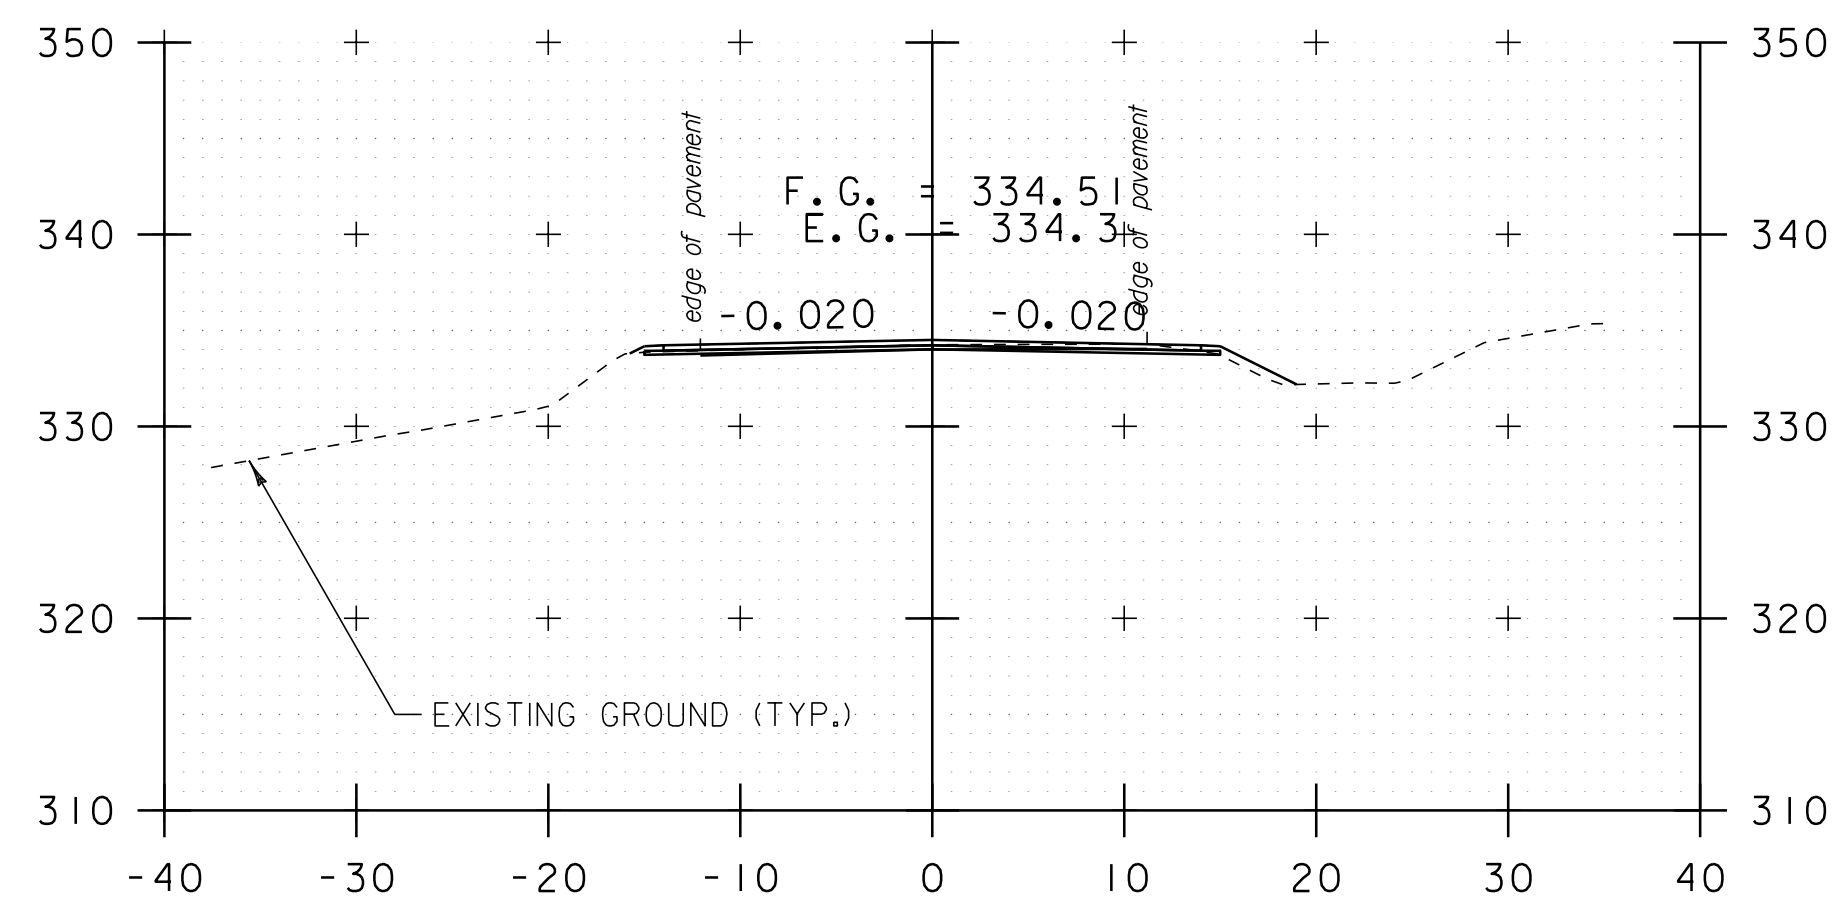


545+00

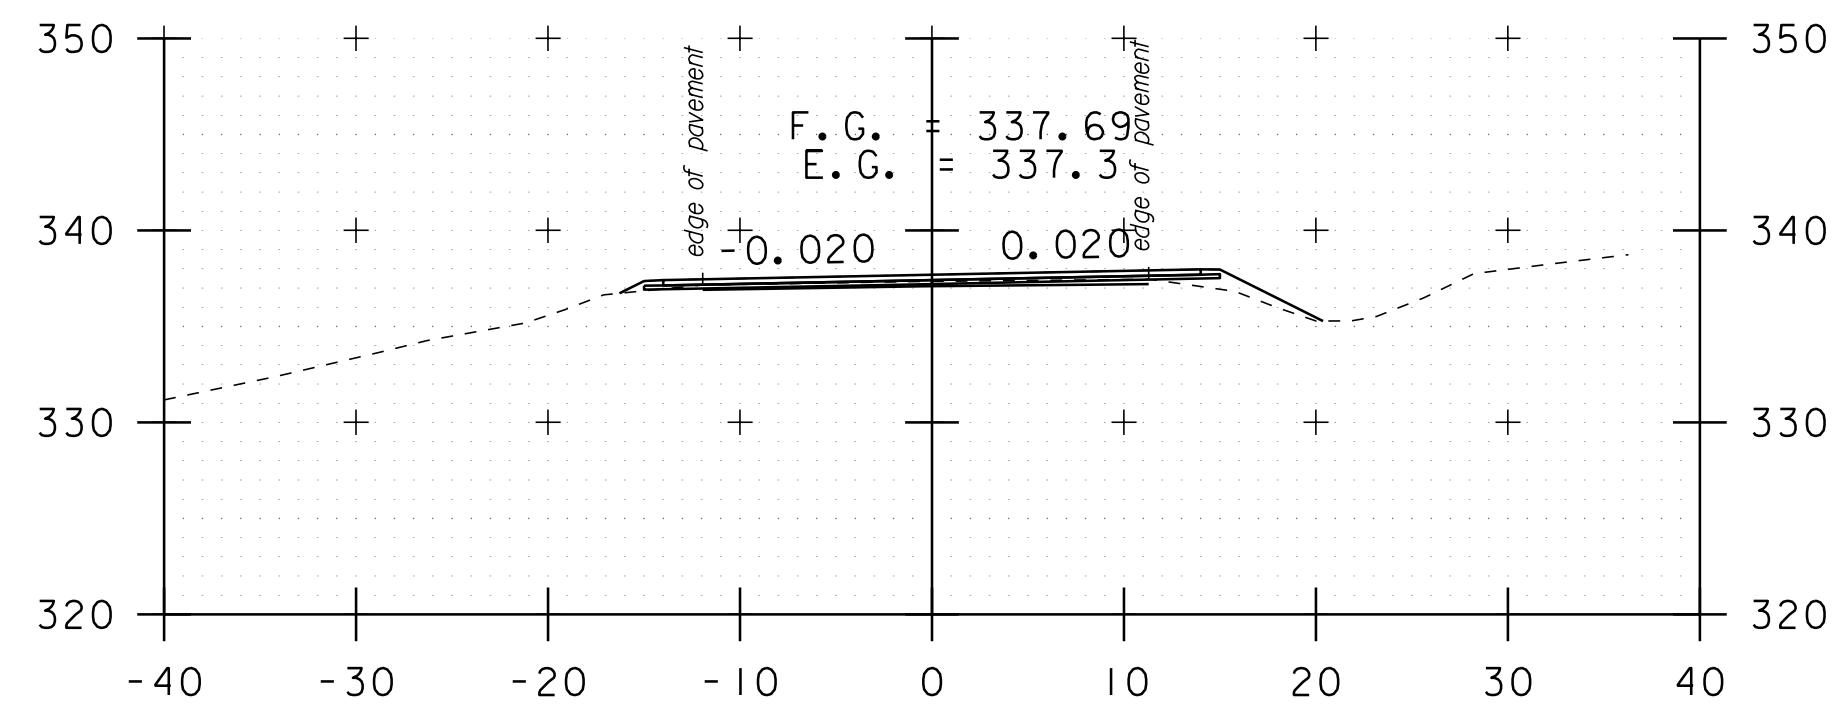


546+95

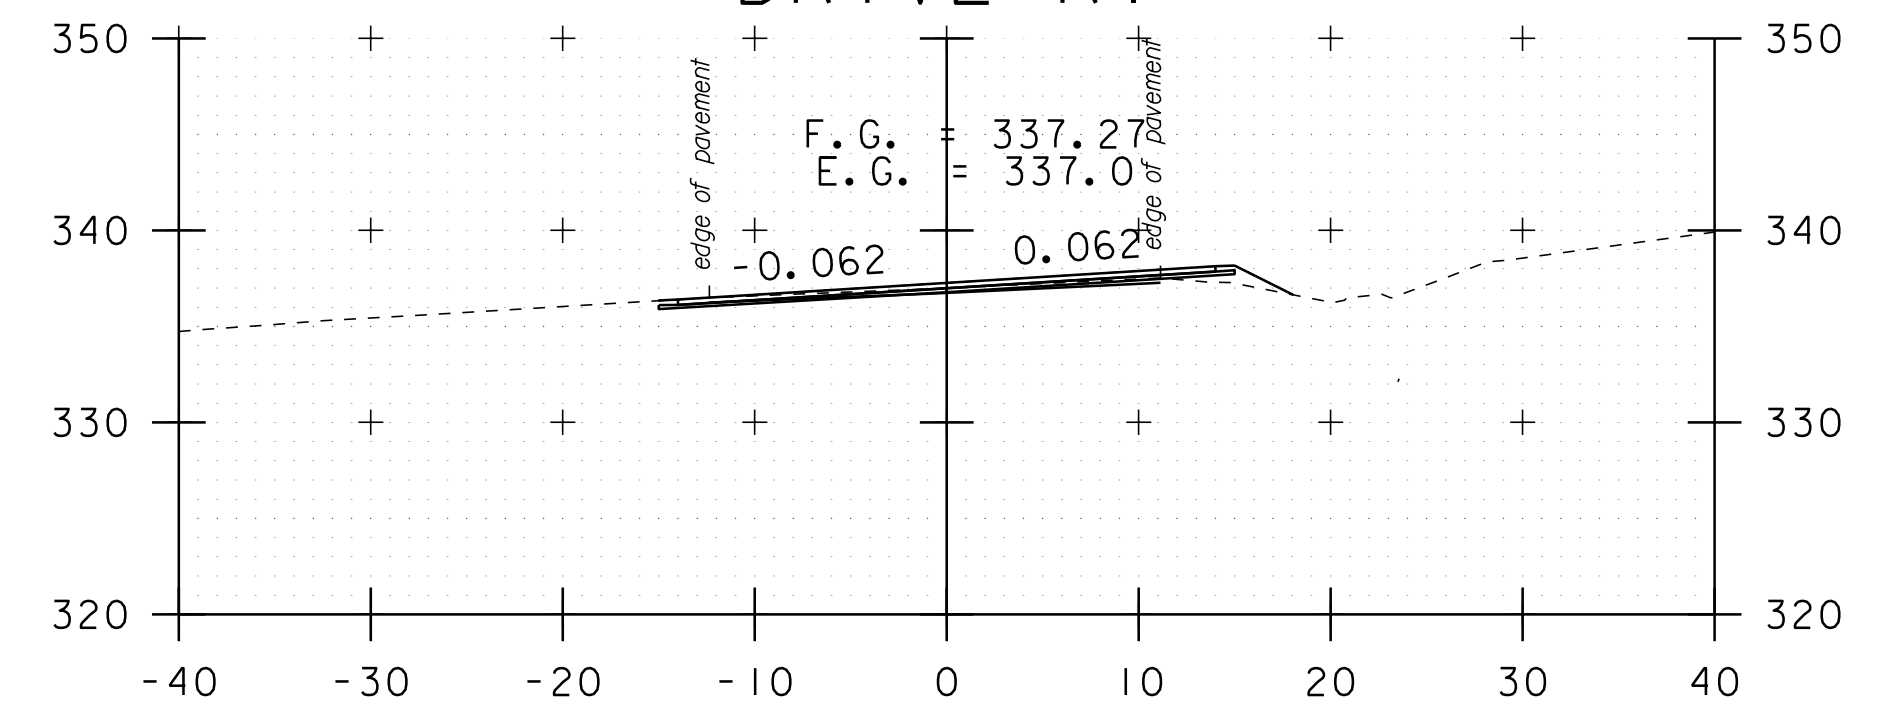


548+00  
TH#6 LT

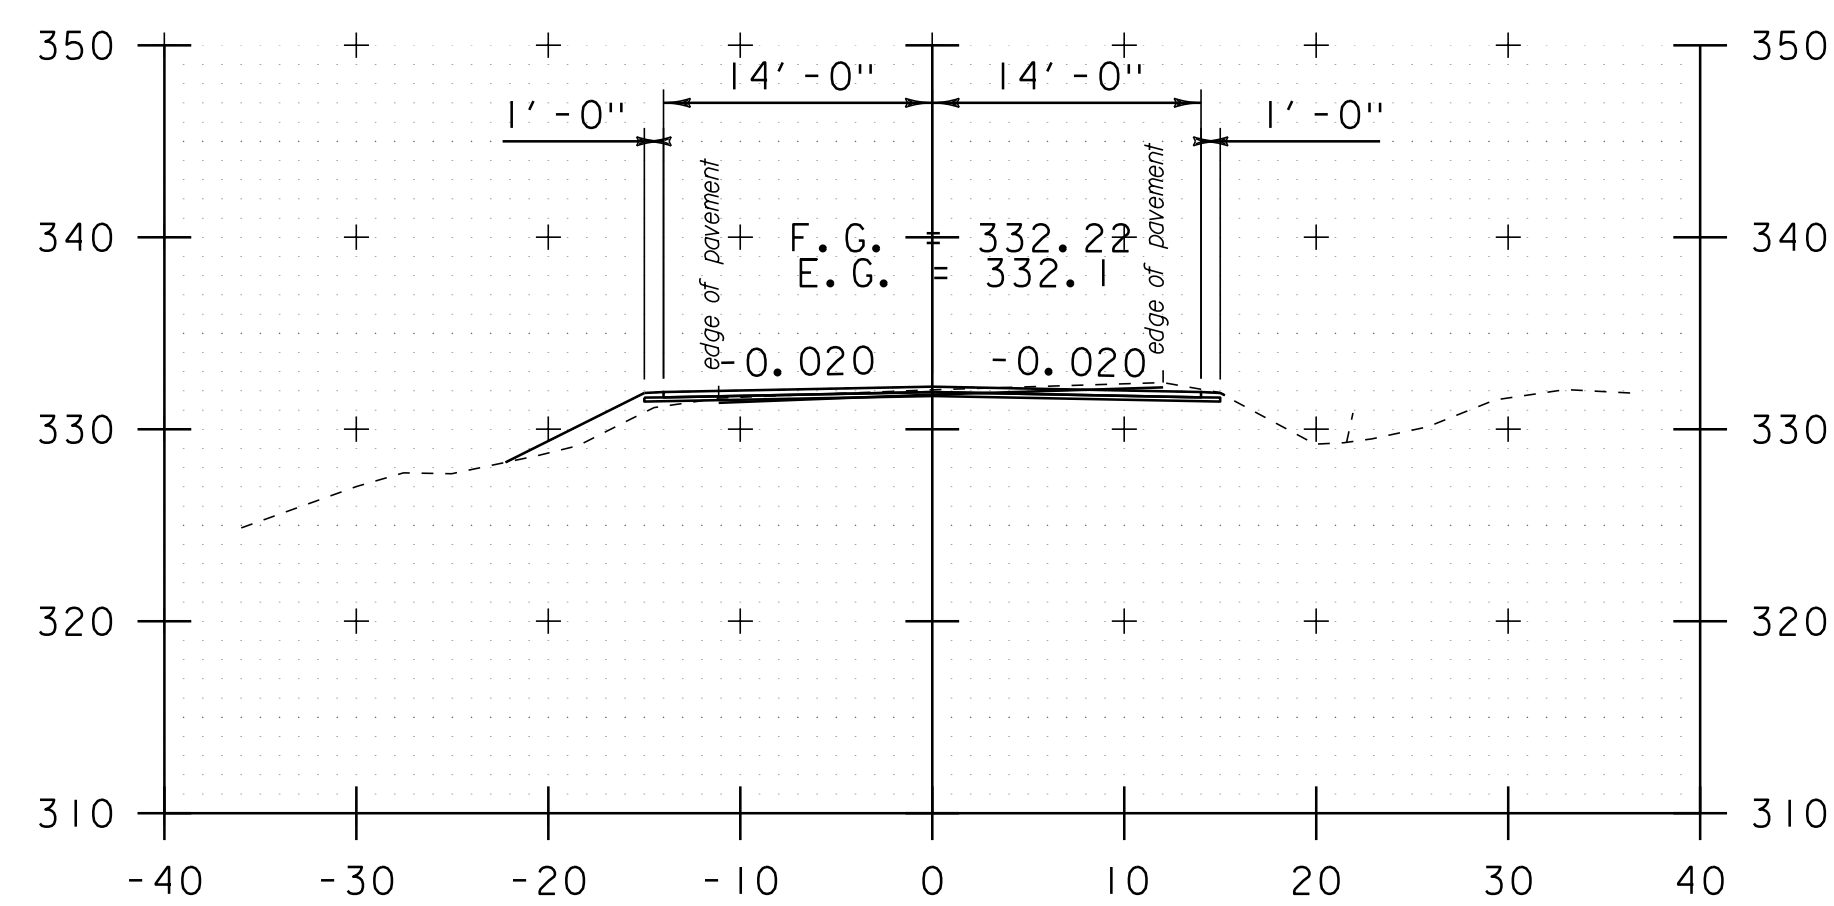

543+00

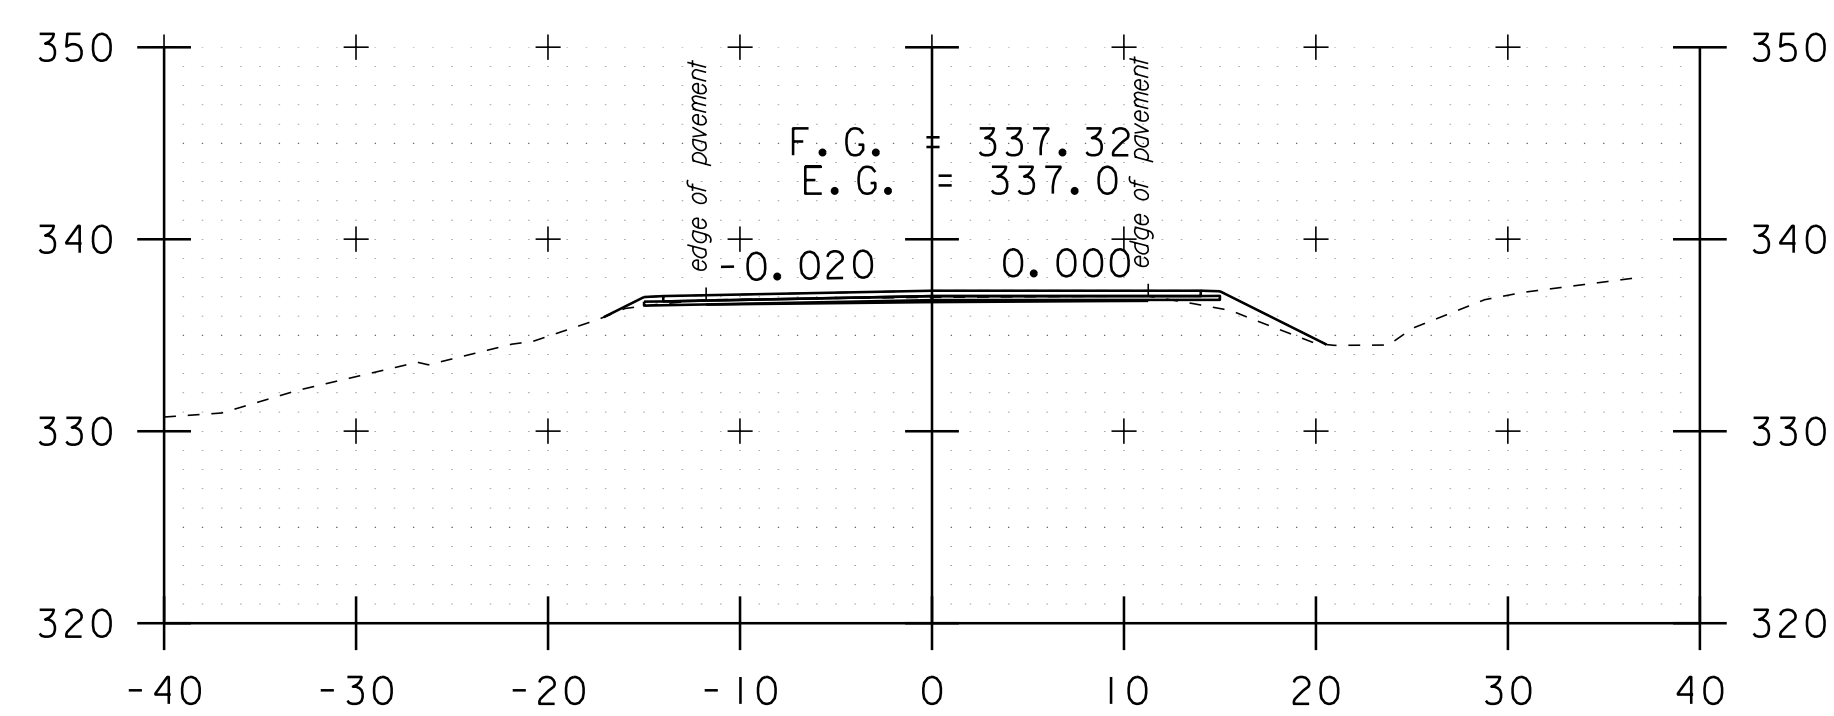


546+50

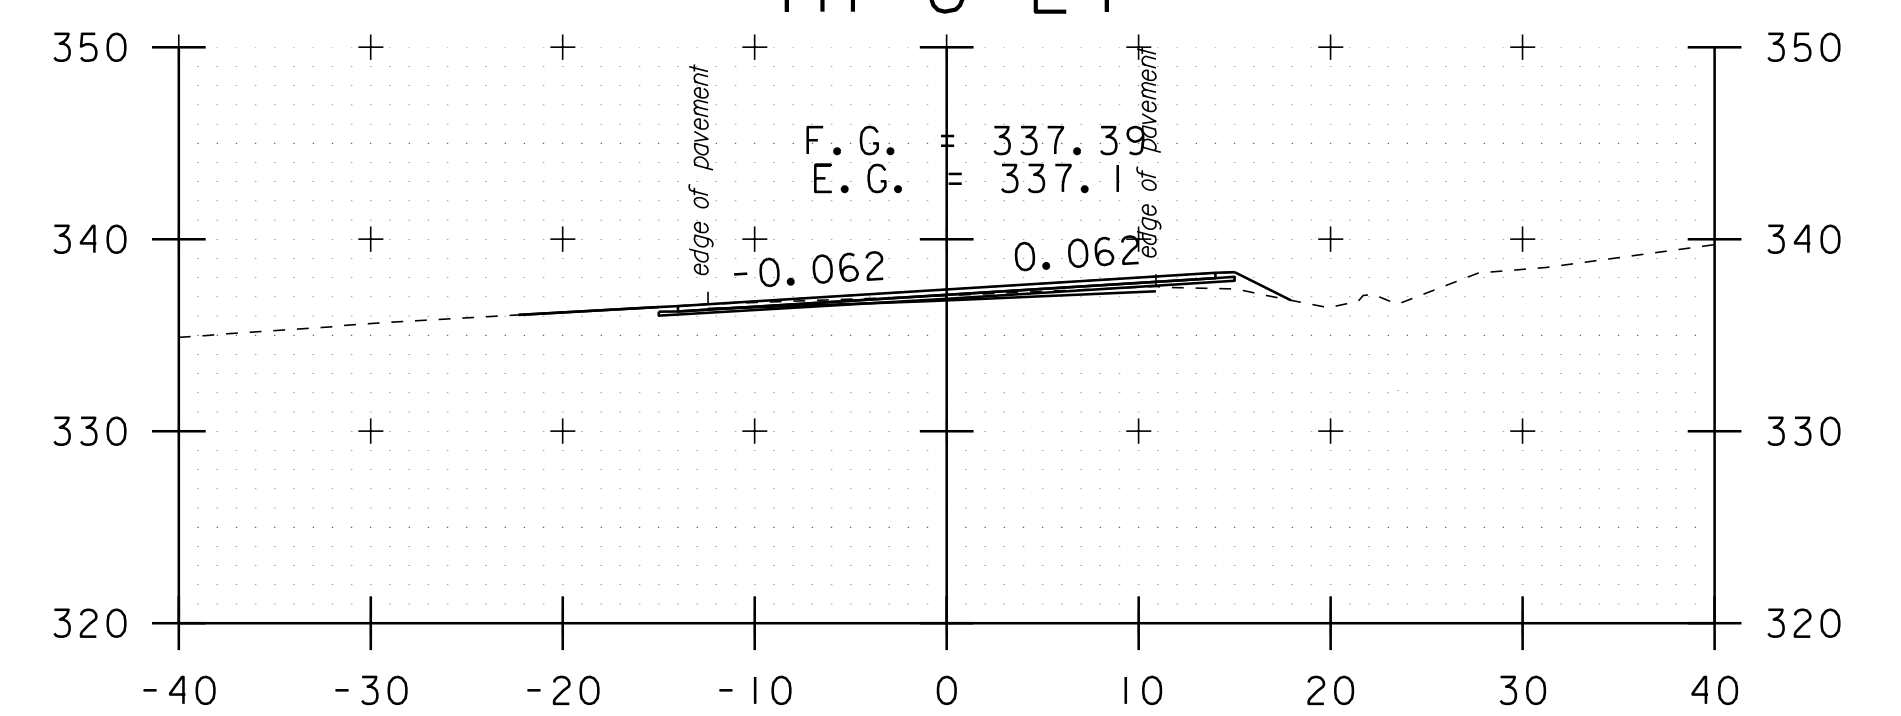

547+90

DATUM	NAVD 88
	NAD 83

STA. 543+00 TO STA. 548+50

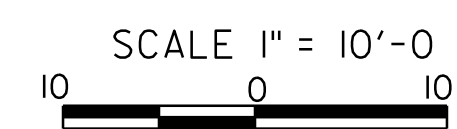

**CROSS SECTION SHEET 12**

PROJECT NAME: ADDISON-NEW HAVEN  
PROJECT NUMBER: STP 9632(1)

FILE NAME: p95B076.dgn  
PROJECT LEADER: CDL  
DESIGNED BY: SJL  
PLOT FILE: p95B076.I17.1

PLOT DATE: 3/13/2012  
DRAWN BY: SJL  
CHECKED BY: EPD  
SHEET 117 OF 186