


DATUM
NAVD 88
NAD 83

STA. 549+00 TO STA. 553+00

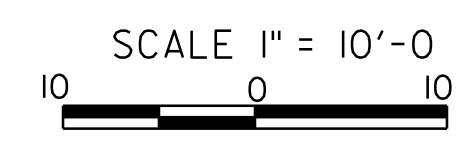

CROSS SECTION SHEET 13

PROJECT NAME: ADDISON-NEW HAVEN
PROJECT NUMBER: STP 9632(1)
FILE NAME: p95B076.dgn
PROJECT LEADER: CDL
DESIGNED BY: SJL
PLOT FILE: p95B076_118.1
PLOT DATE: 3/13/2012
DRAWN BY: SJL
CHECKED BY: EPD
SHEET 118 OF 186