




555+25

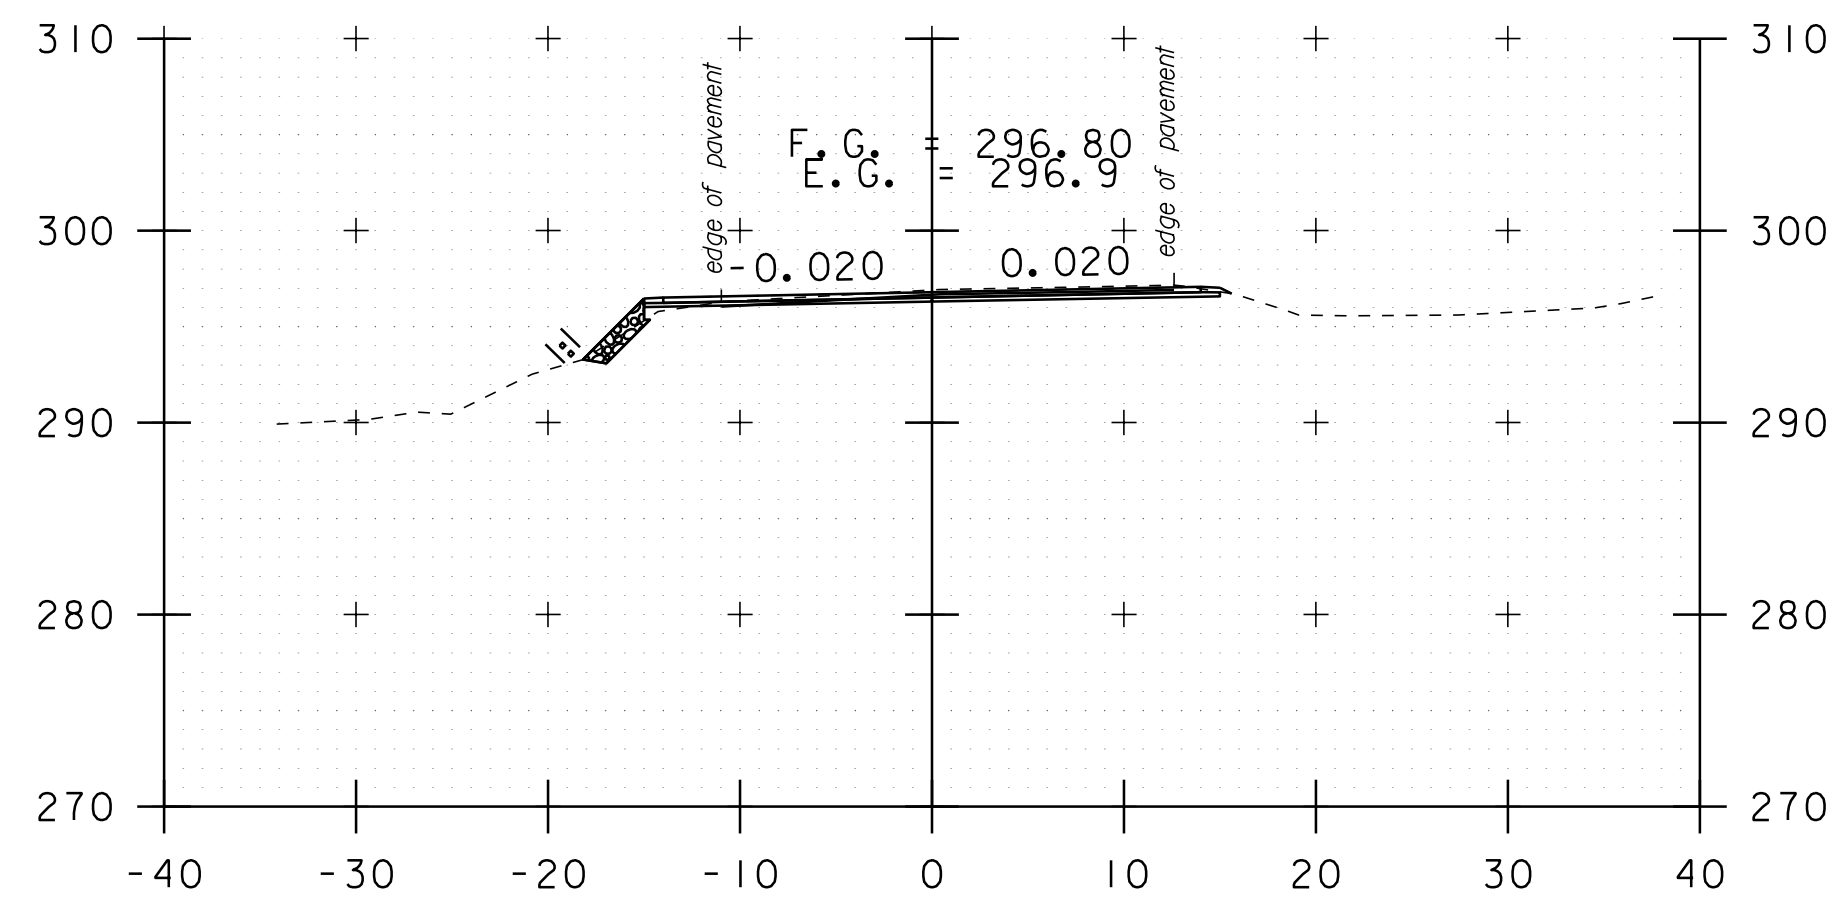


557+50

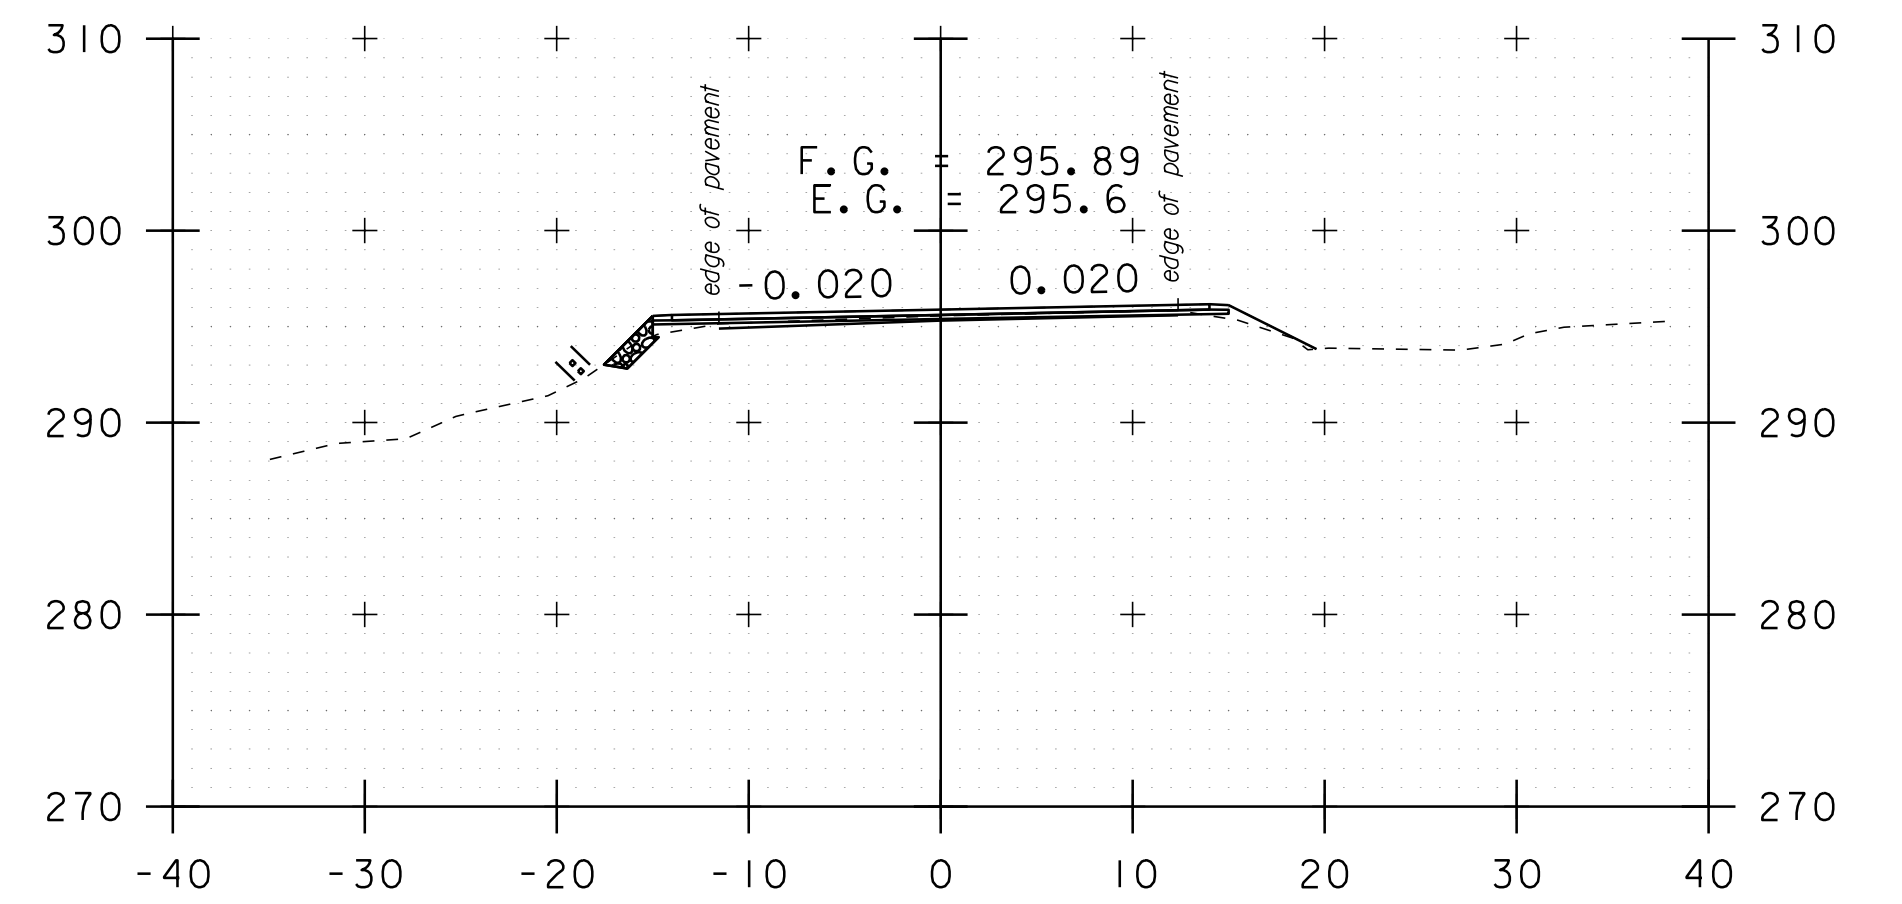


558+50

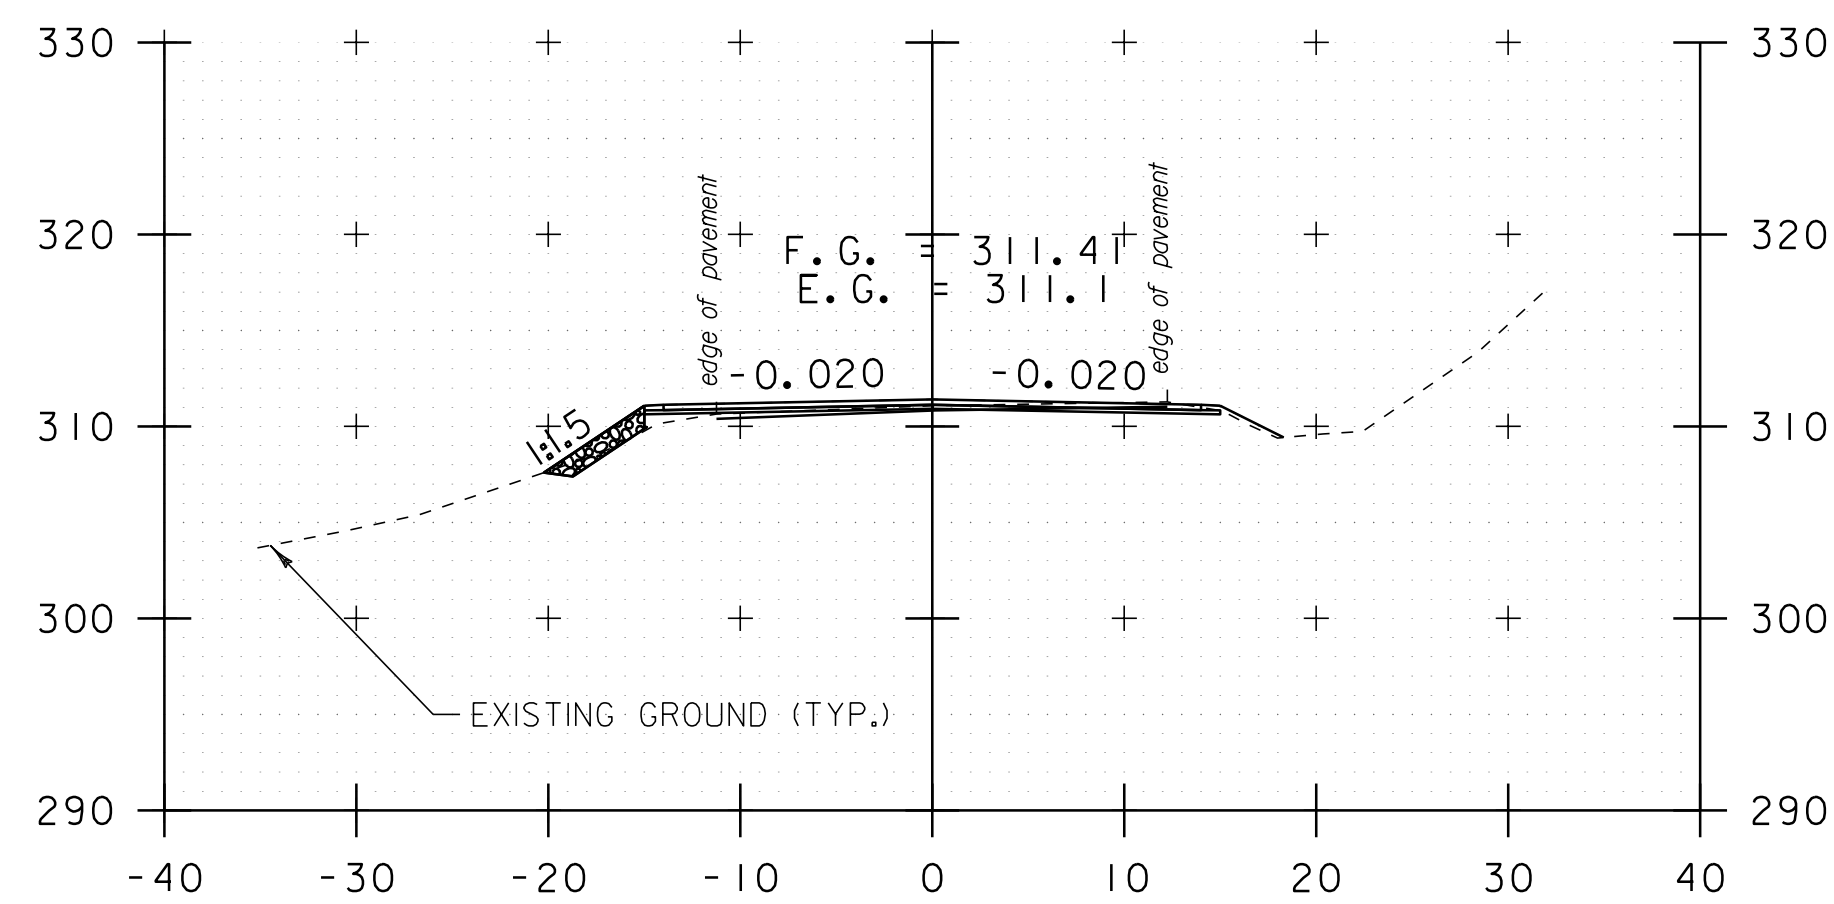


554+25

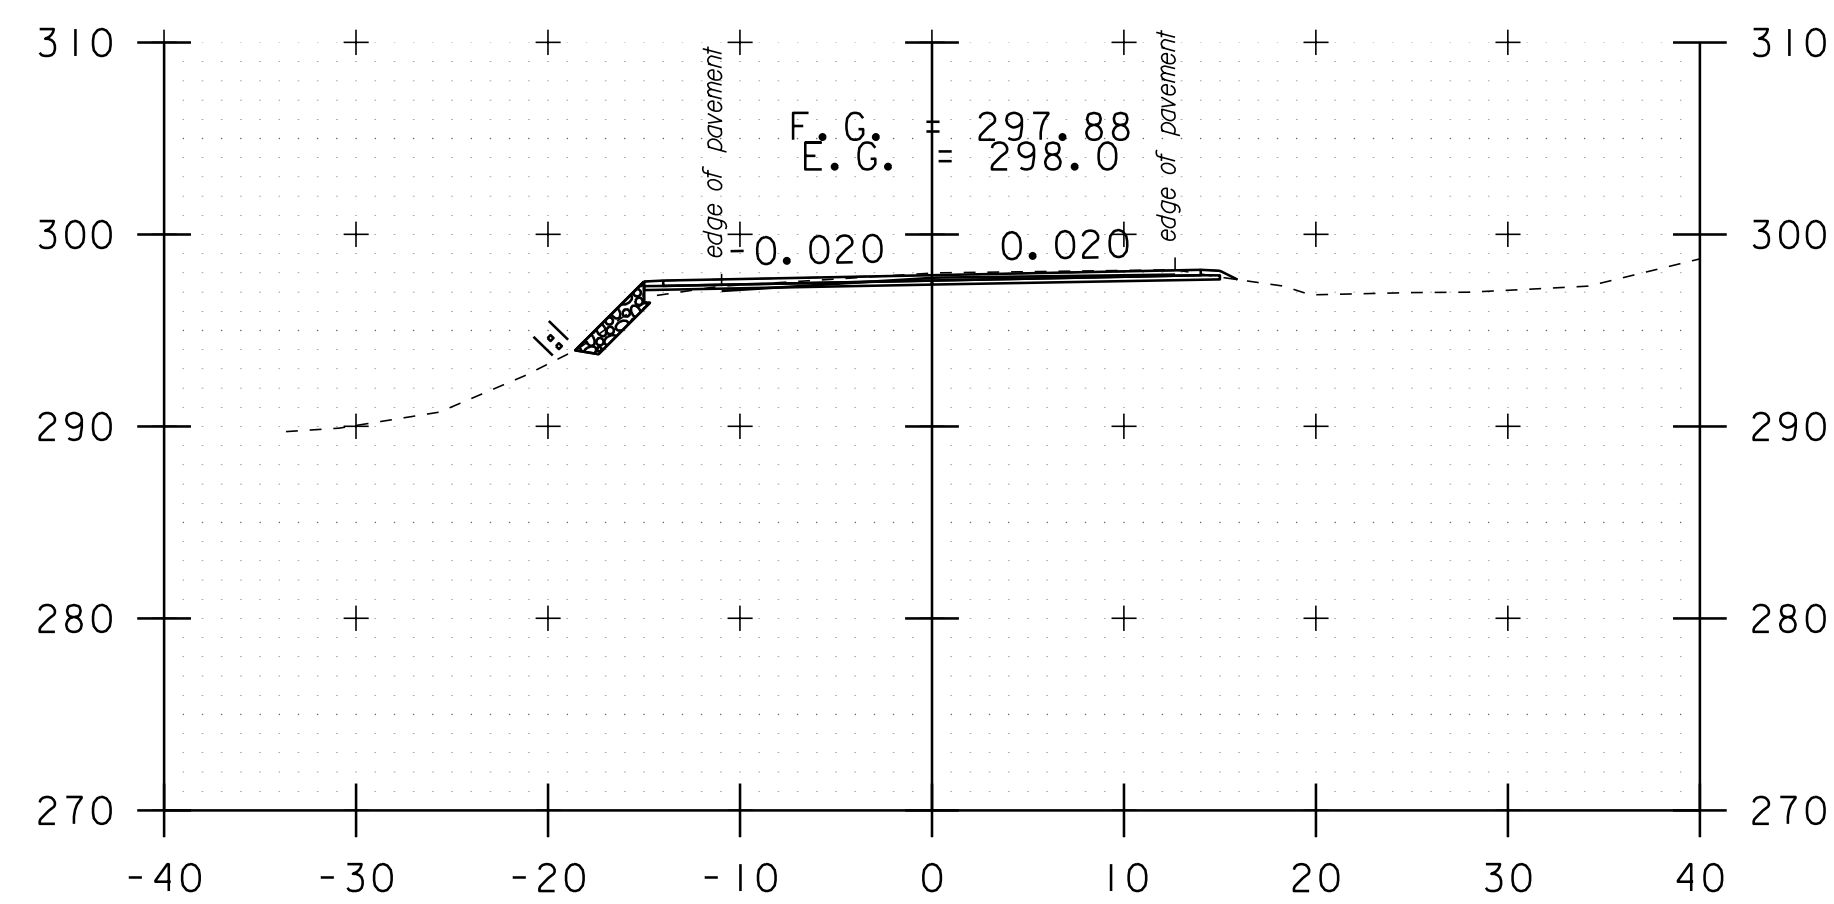


557+00

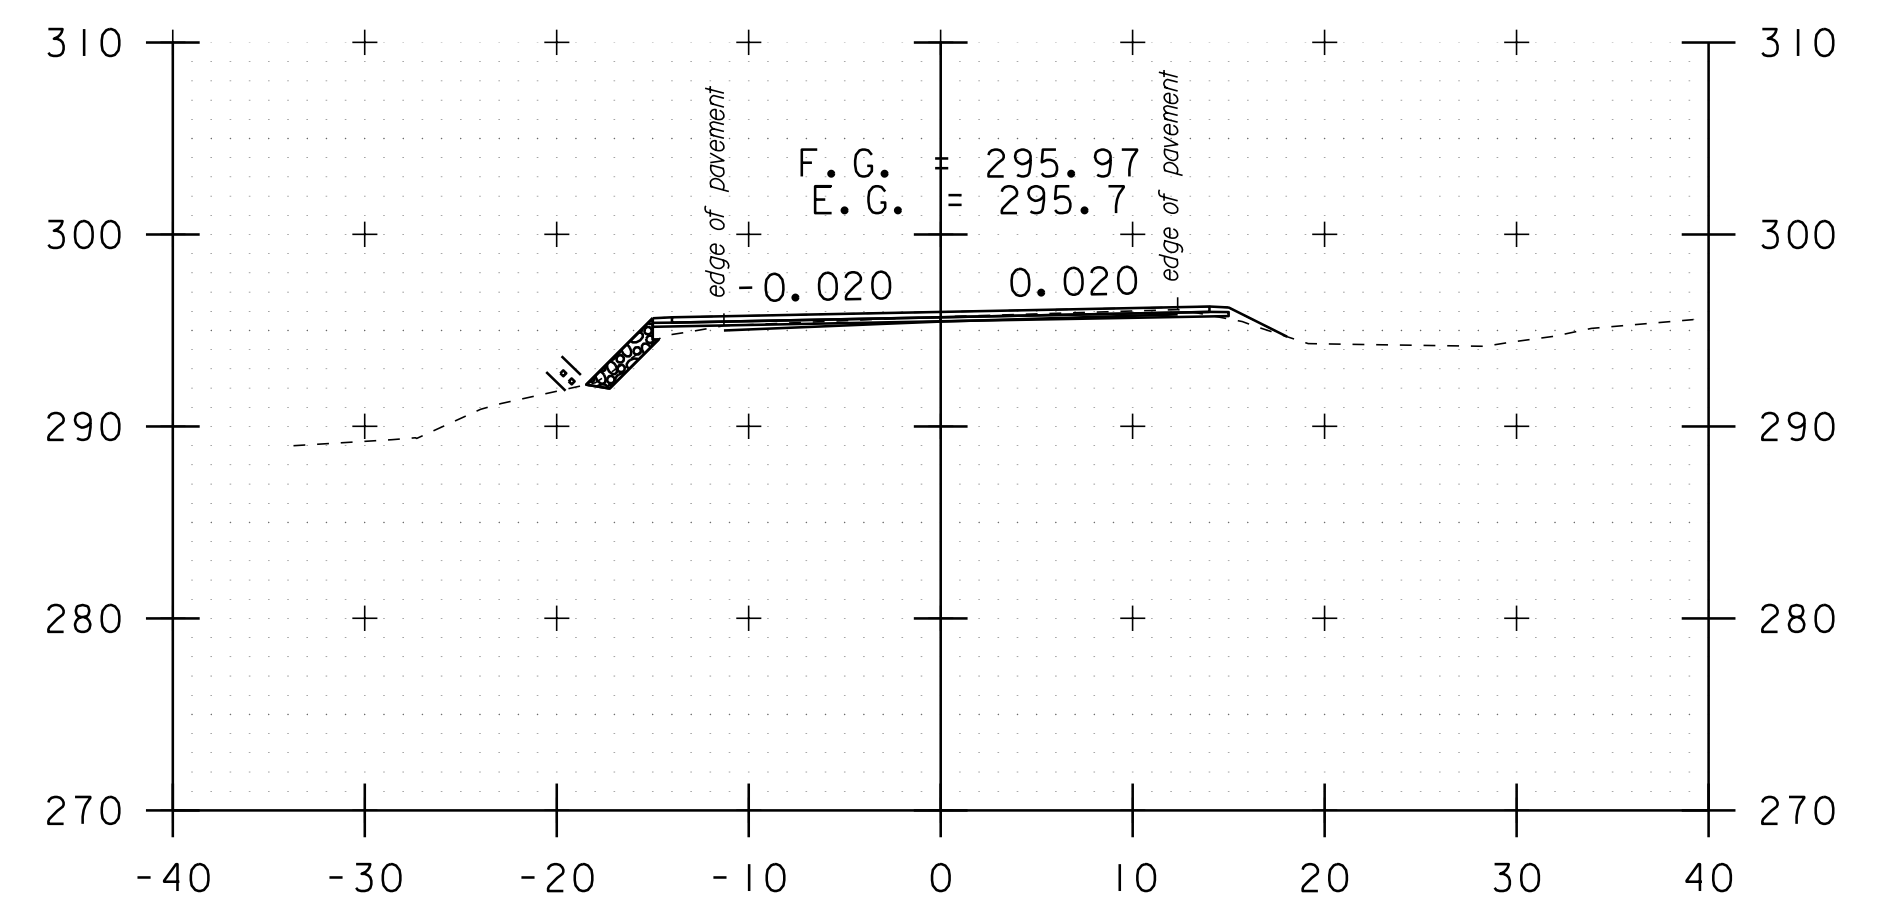


558+24

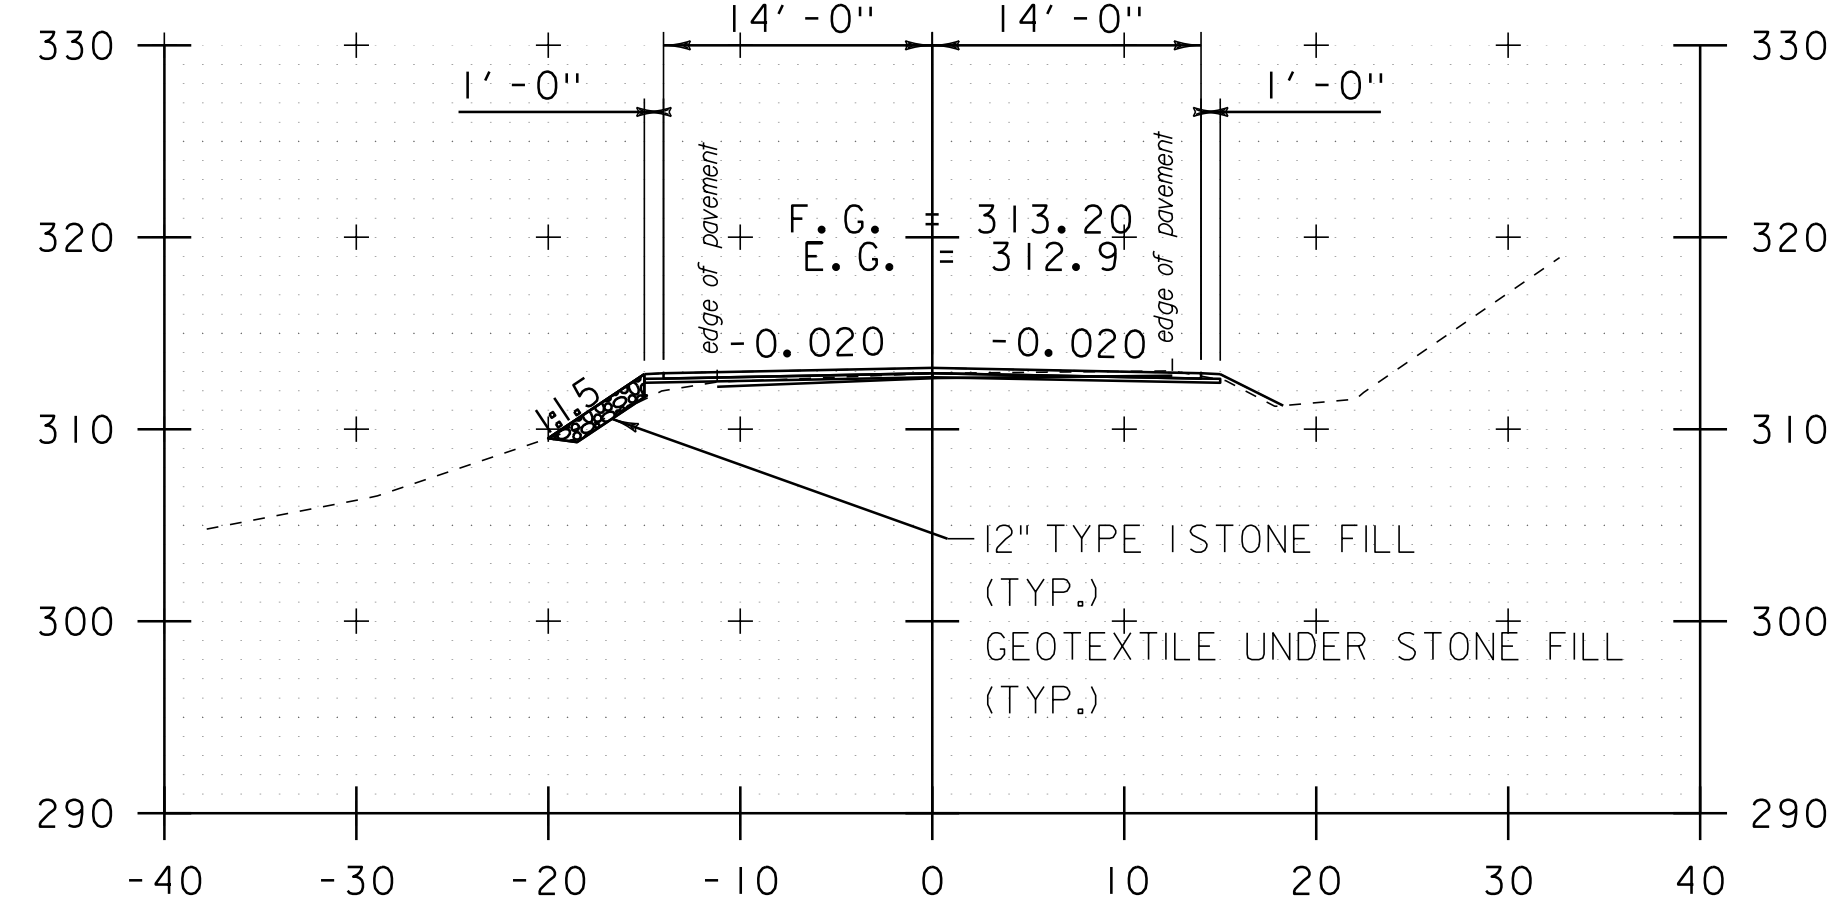

554+00

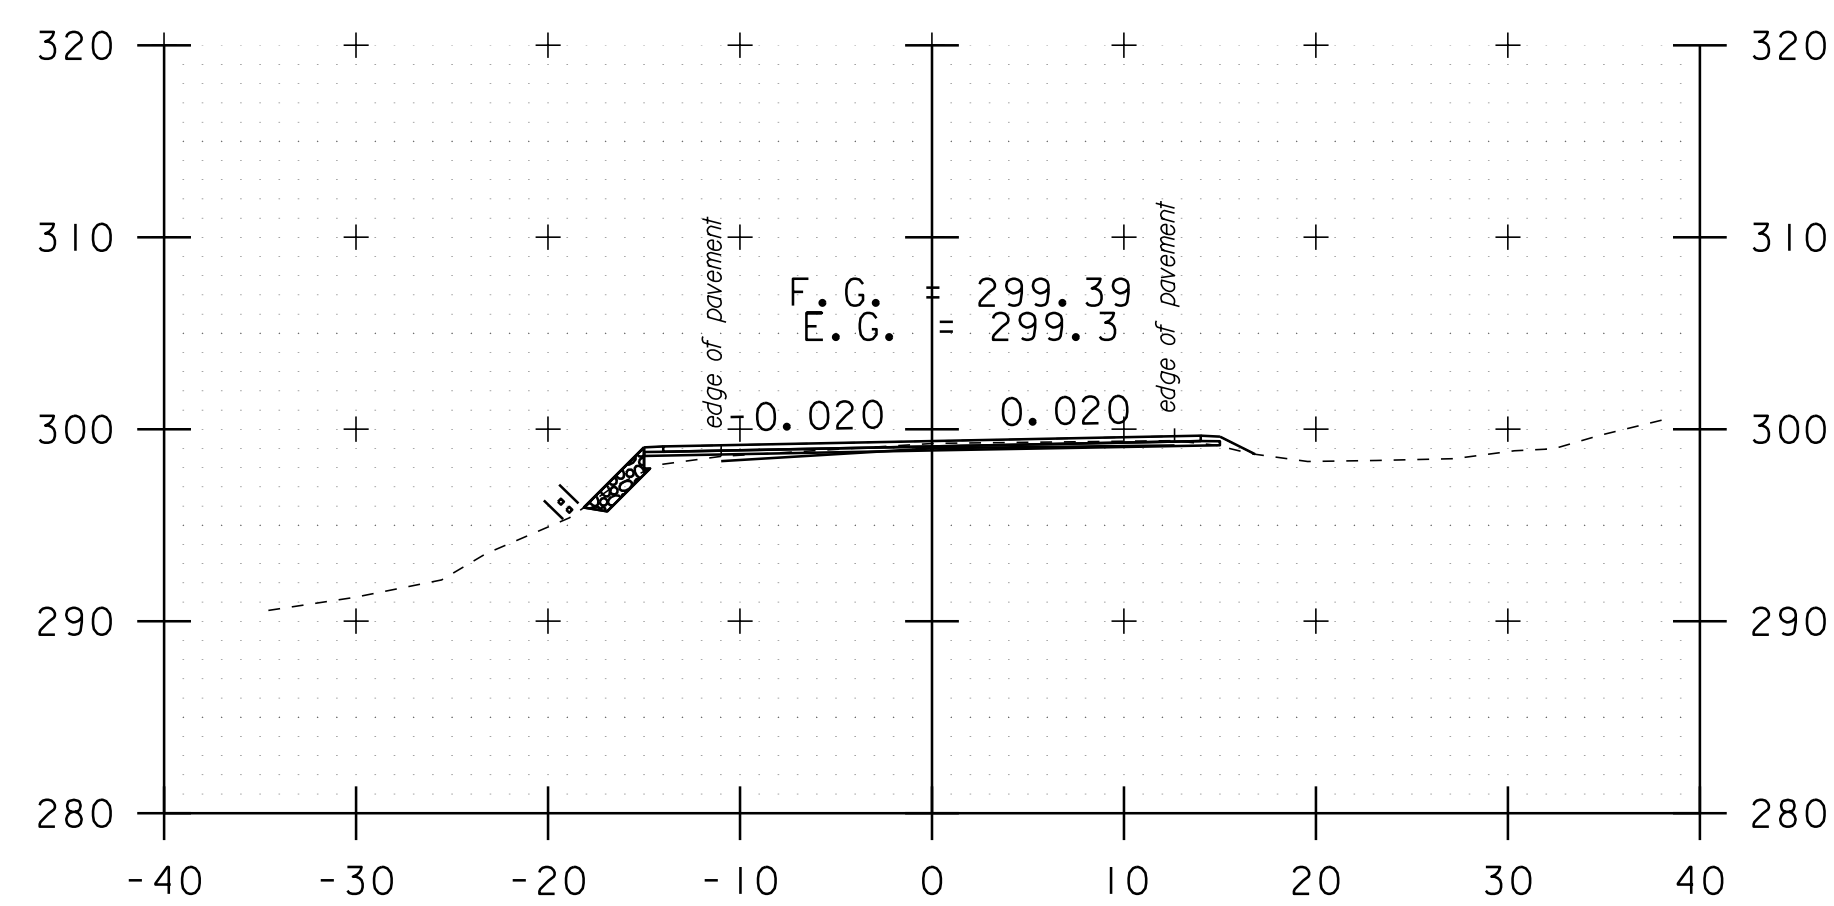


556+50

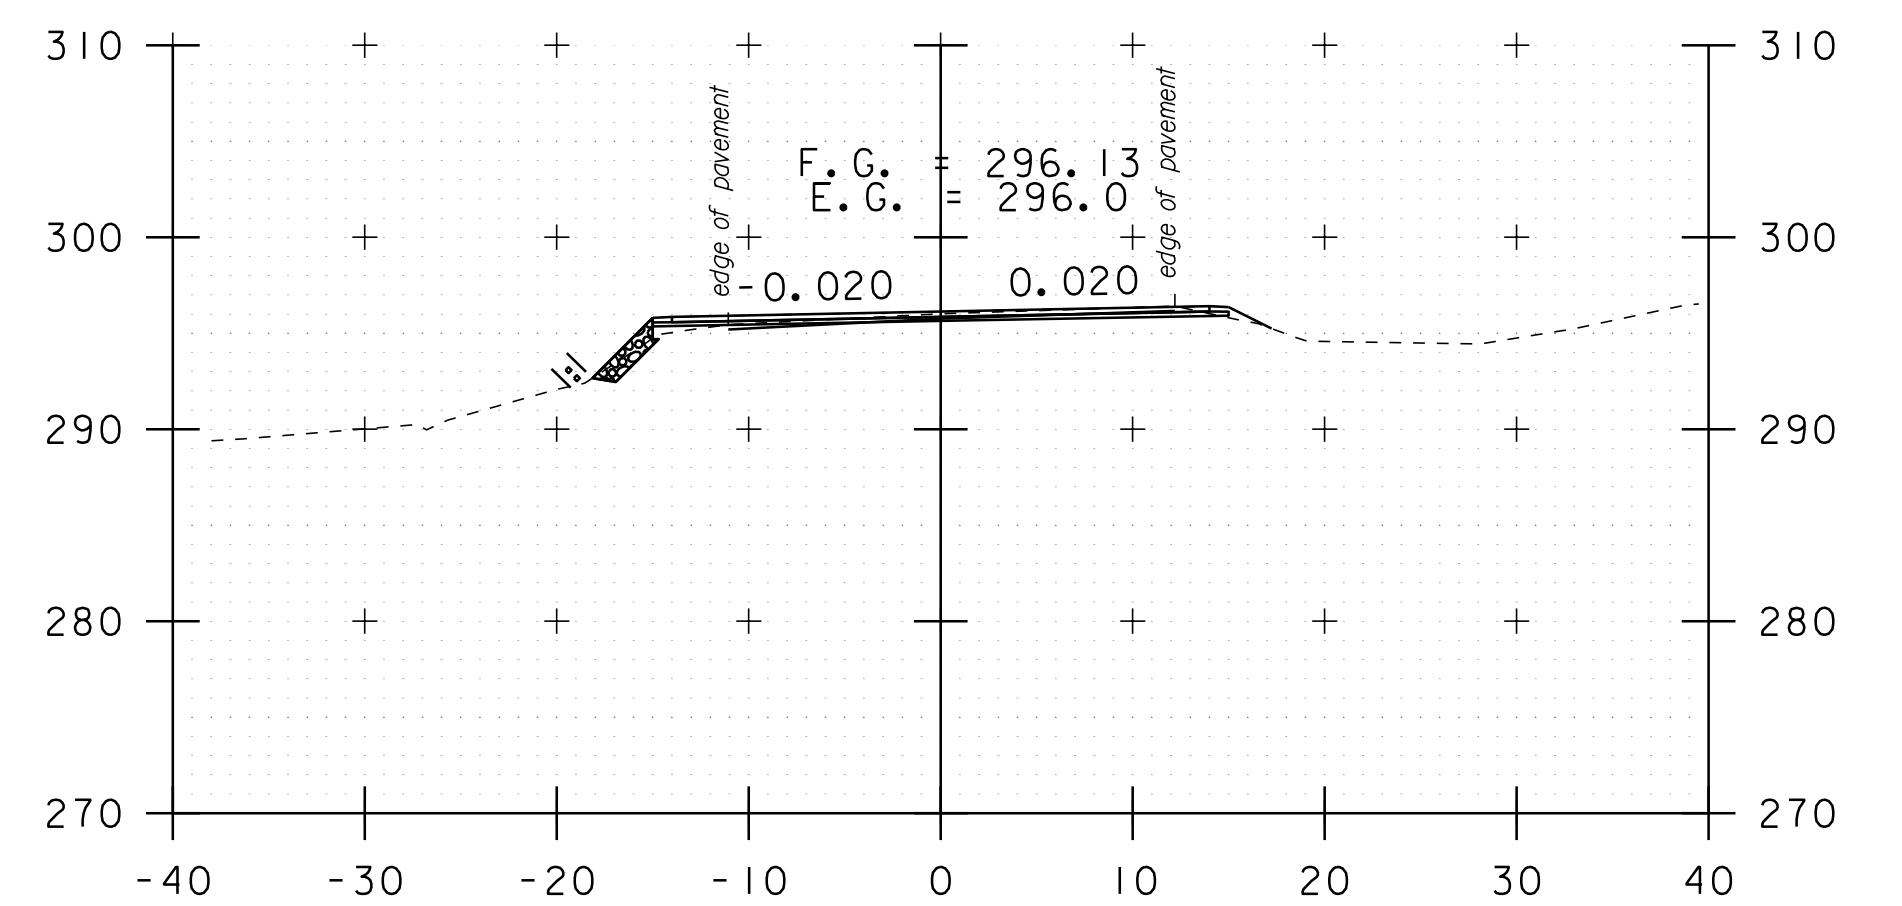

558+00

DATUM	NAVD 88
	NAD 83

STA. 554+00 TO STA. 558+50

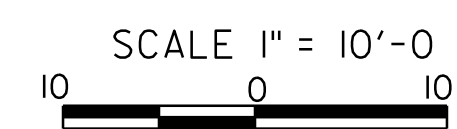

CROSS SECTION SHEET 14

PROJECT NAME: ADDISON-NEW HAVEN
PROJECT NUMBER: STP 9632(1)

FILE NAME: p95B076.dgn
PROJECT LEADER: CDL
DESIGNED BY: SJL
PLOT FILE: p95B076_119.1

PLOT DATE: 3/13/2012
DRAWN BY: SJL
CHECKED BY: EPD
SHEET 119 OF 186