

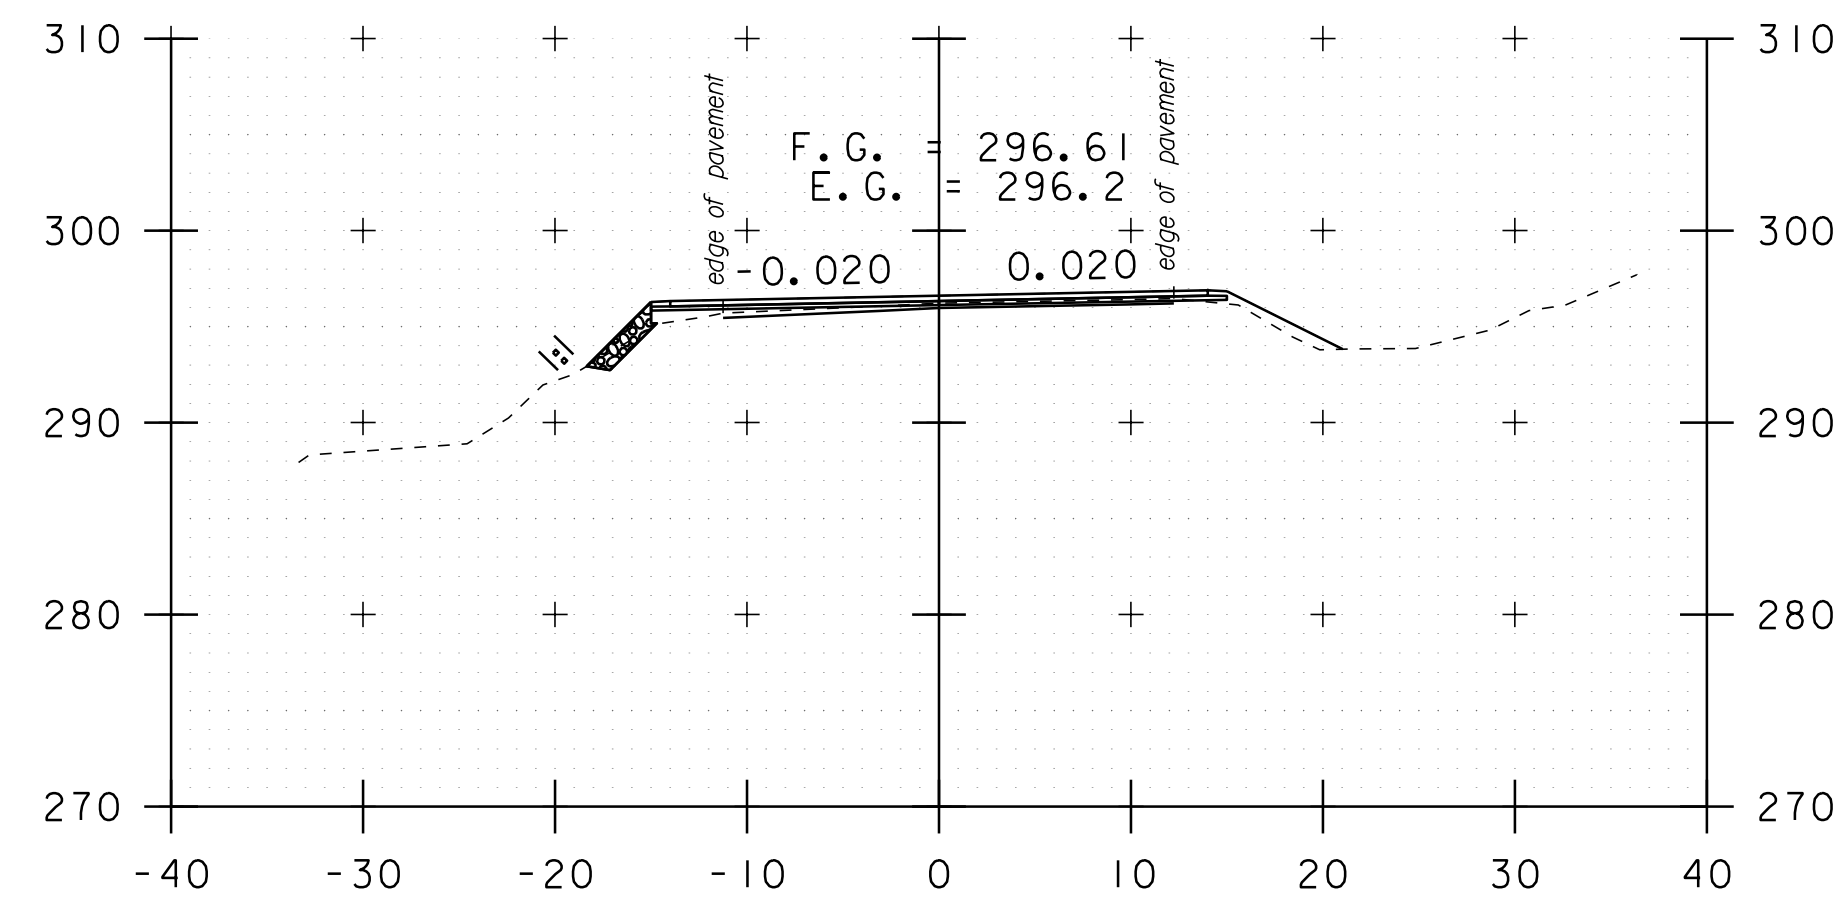
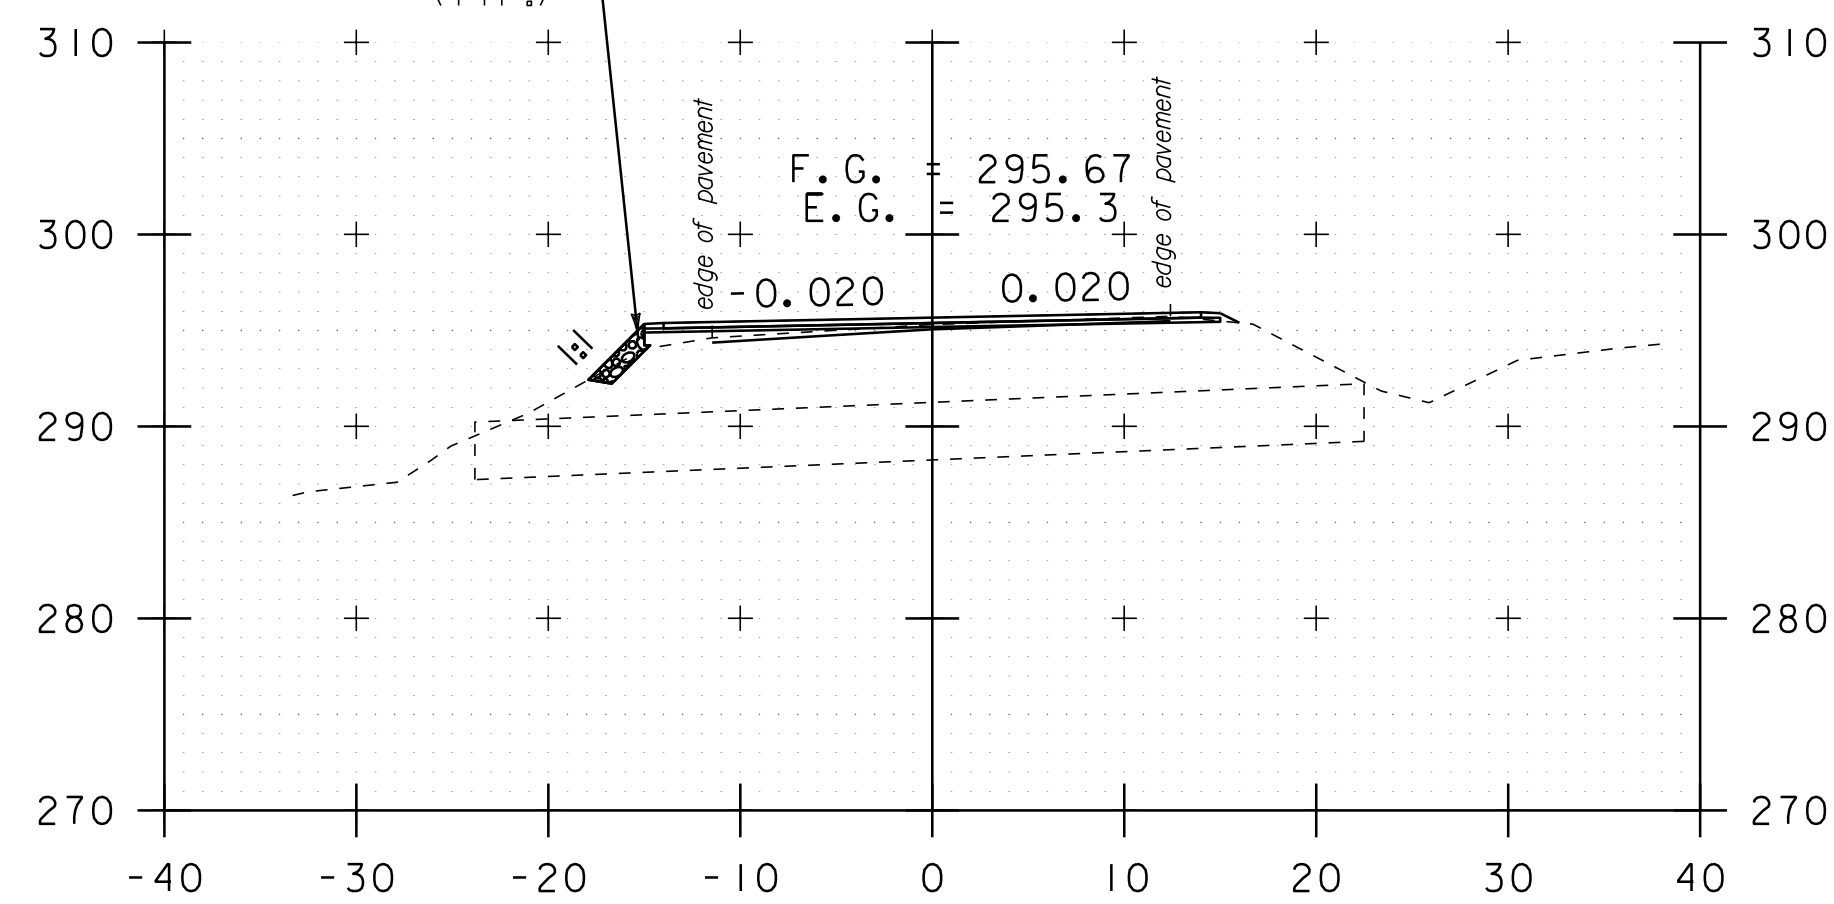


560+00



12" TYPE 1 STONE FILL
(TYP.)
GEOTEXTILE UNDER STONE FILL
(TYP.)

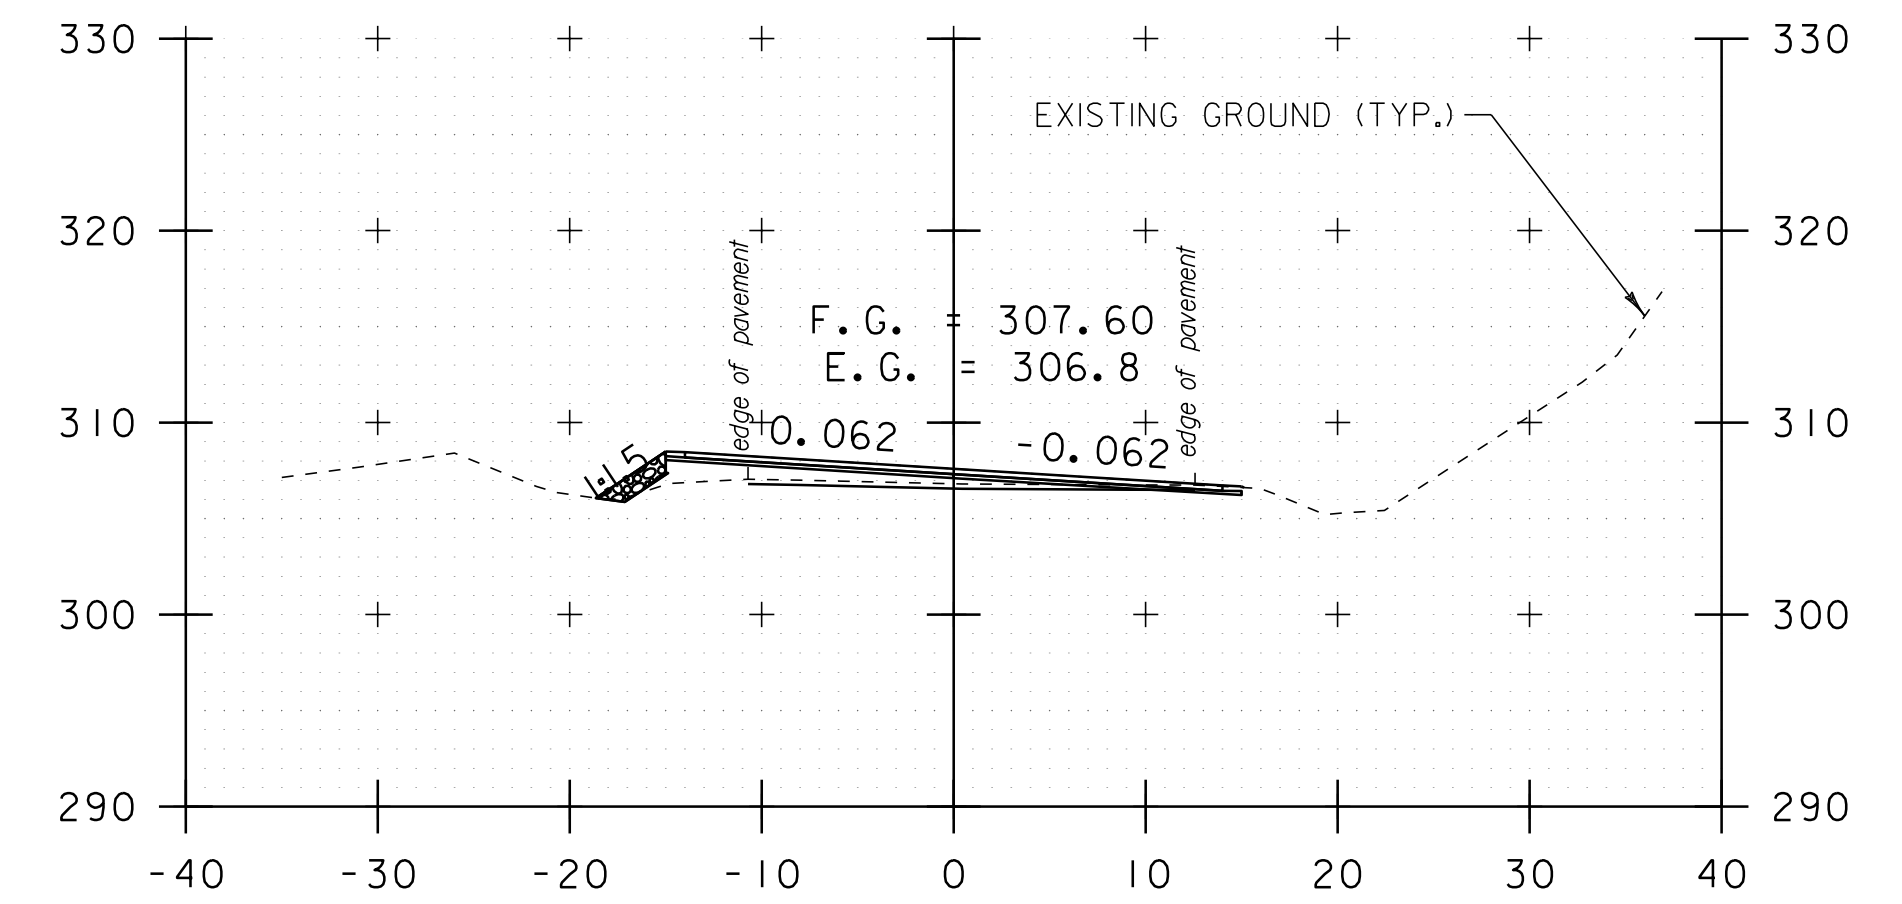

560+75

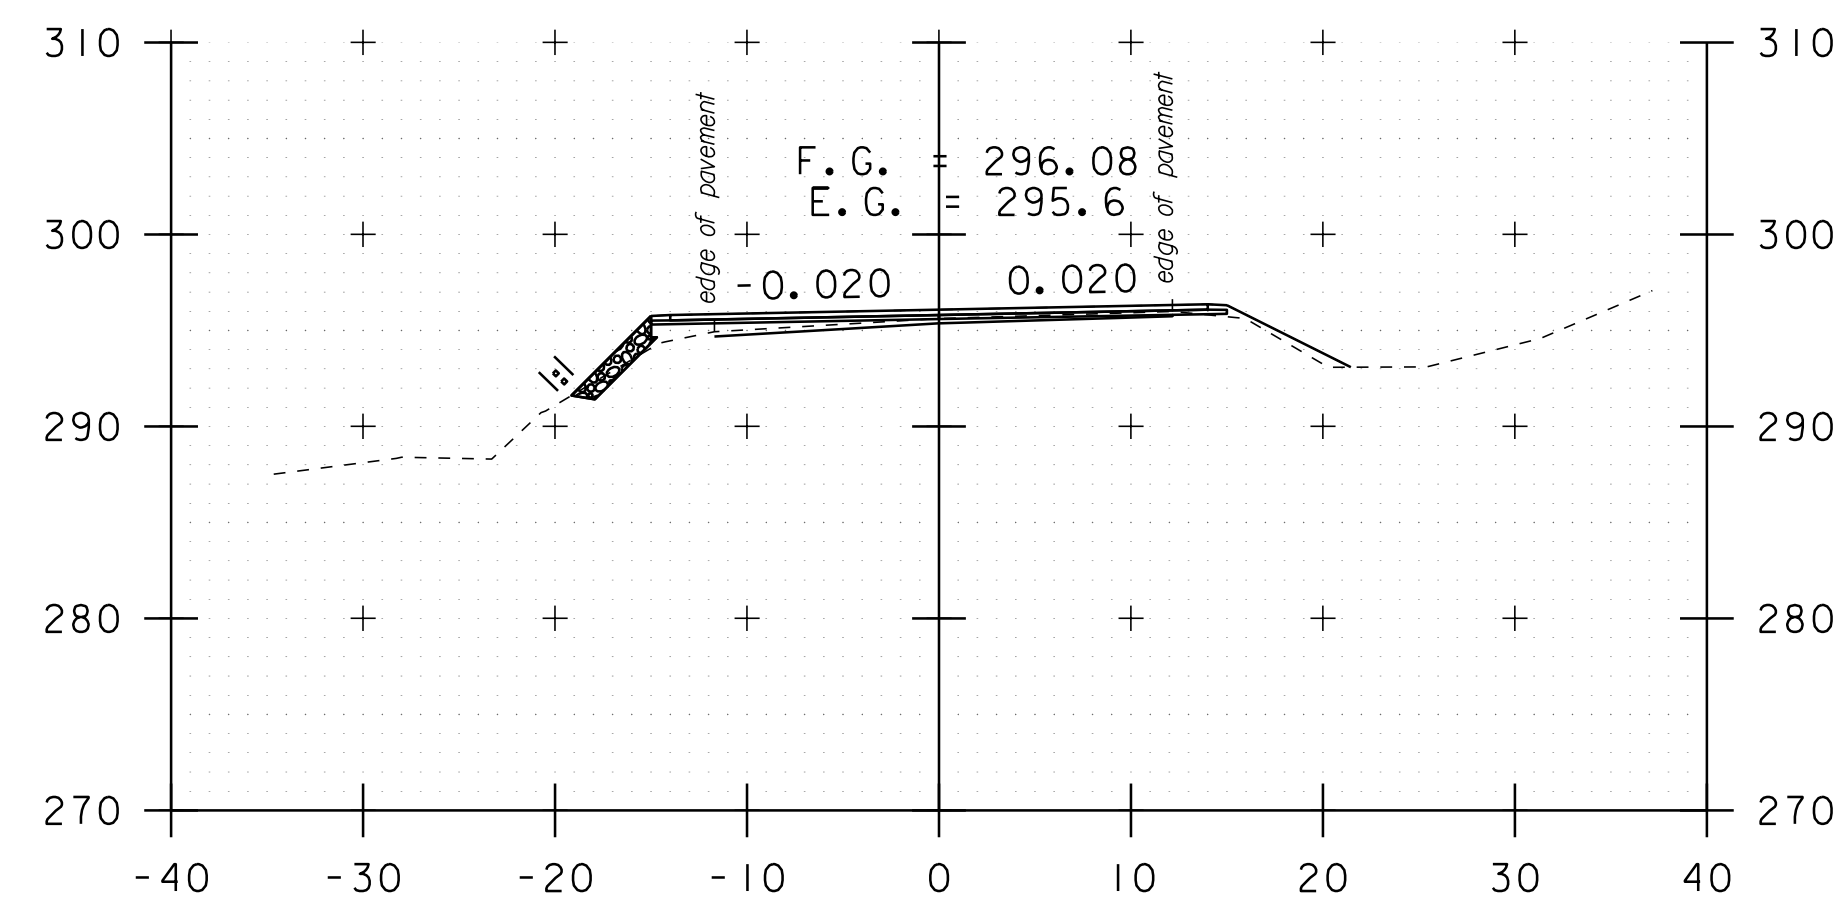


563+30

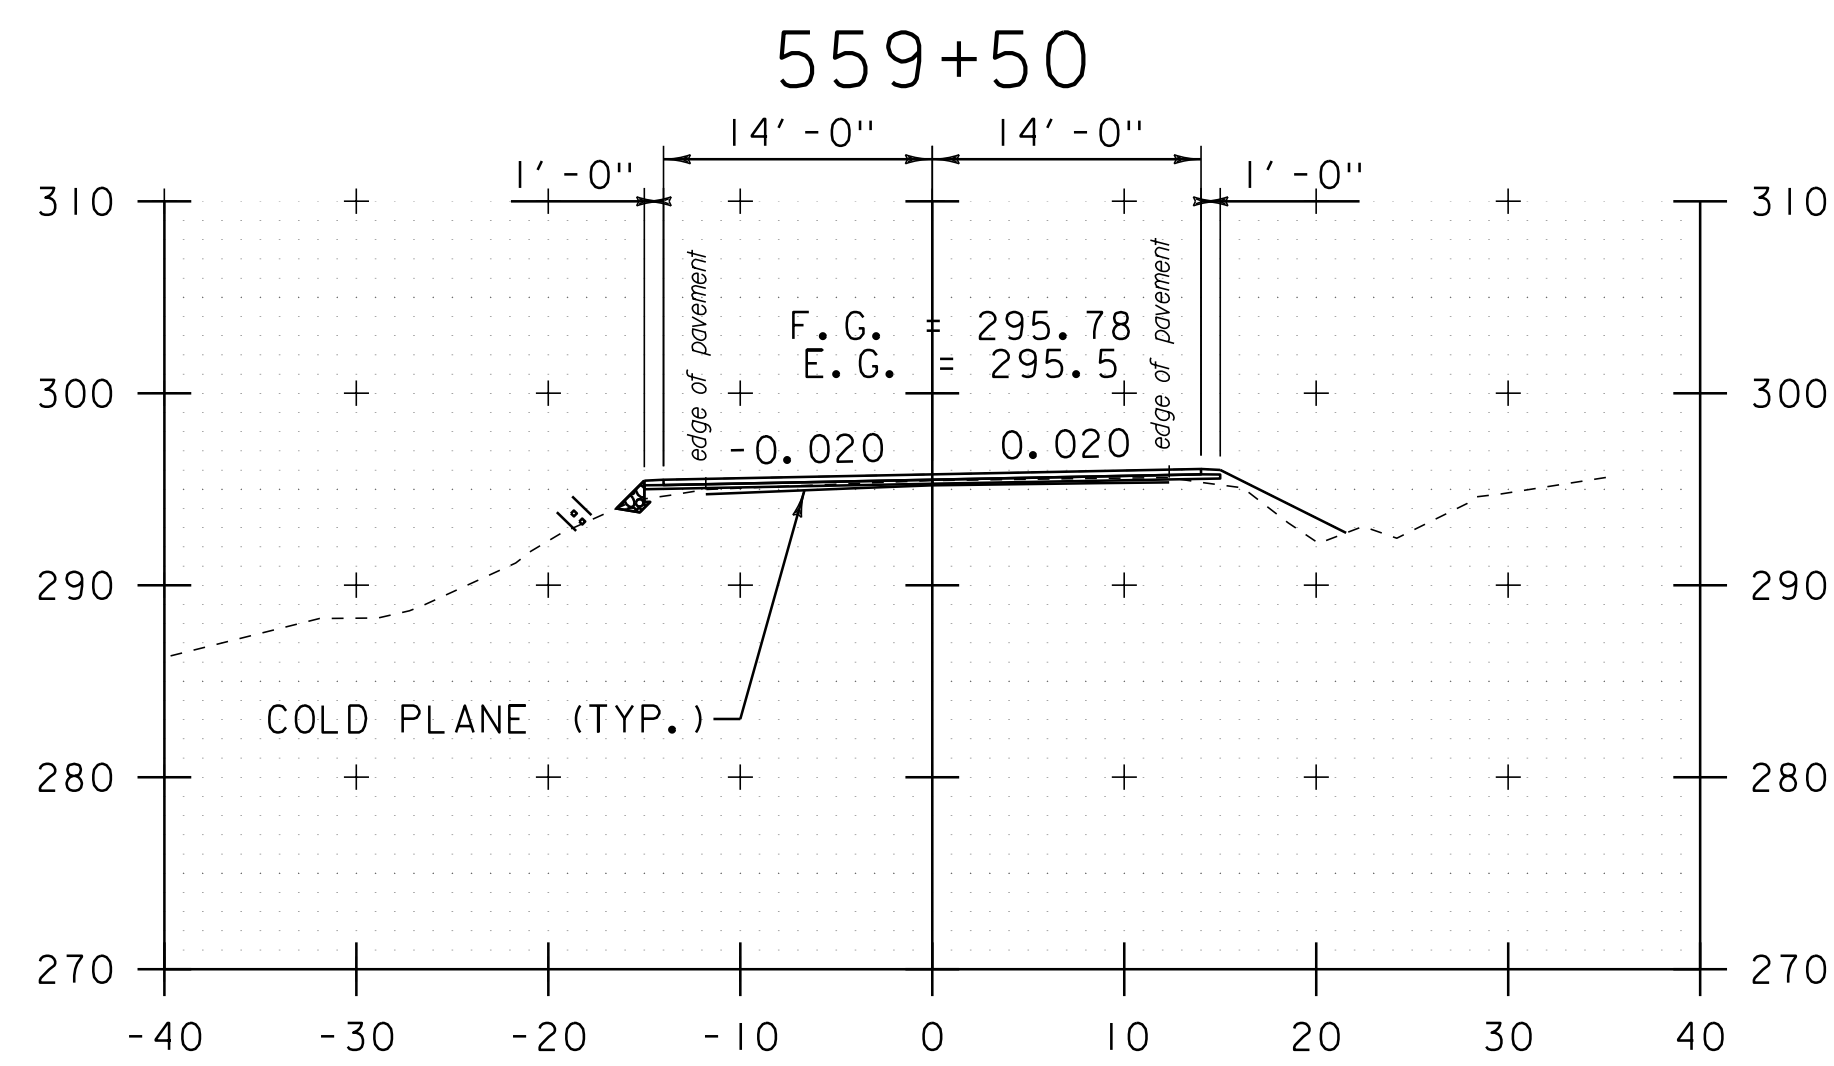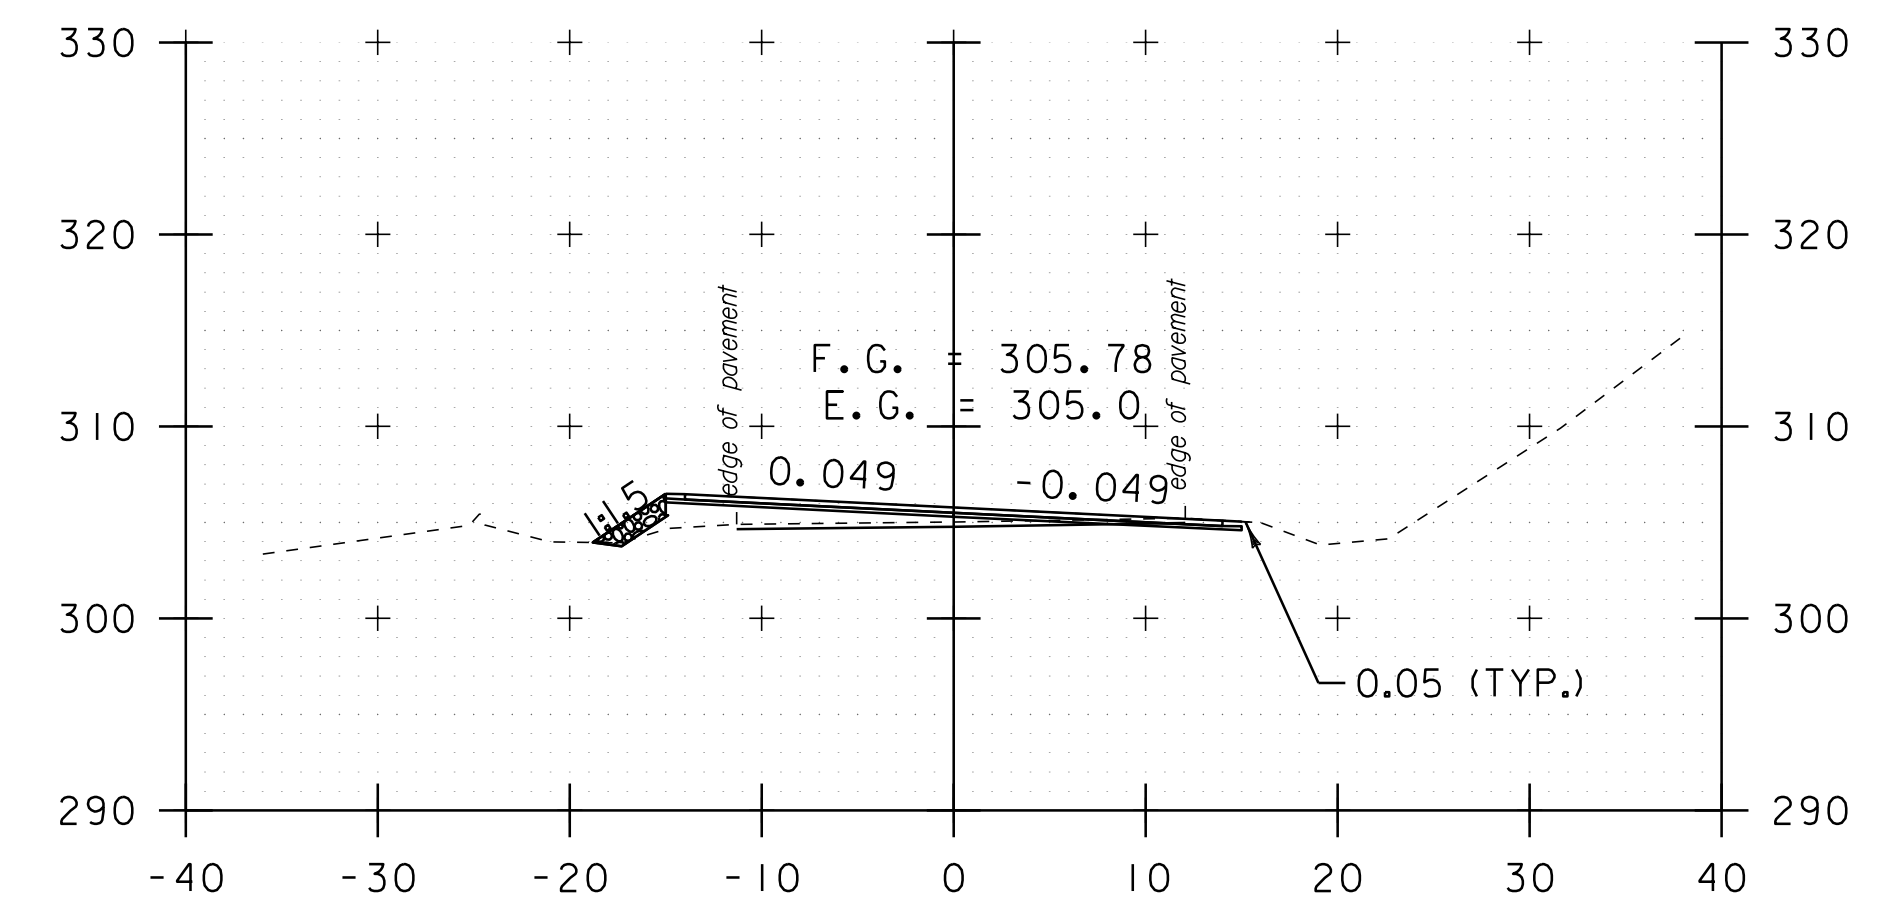


559+50


COLD PLANE (TYP.)

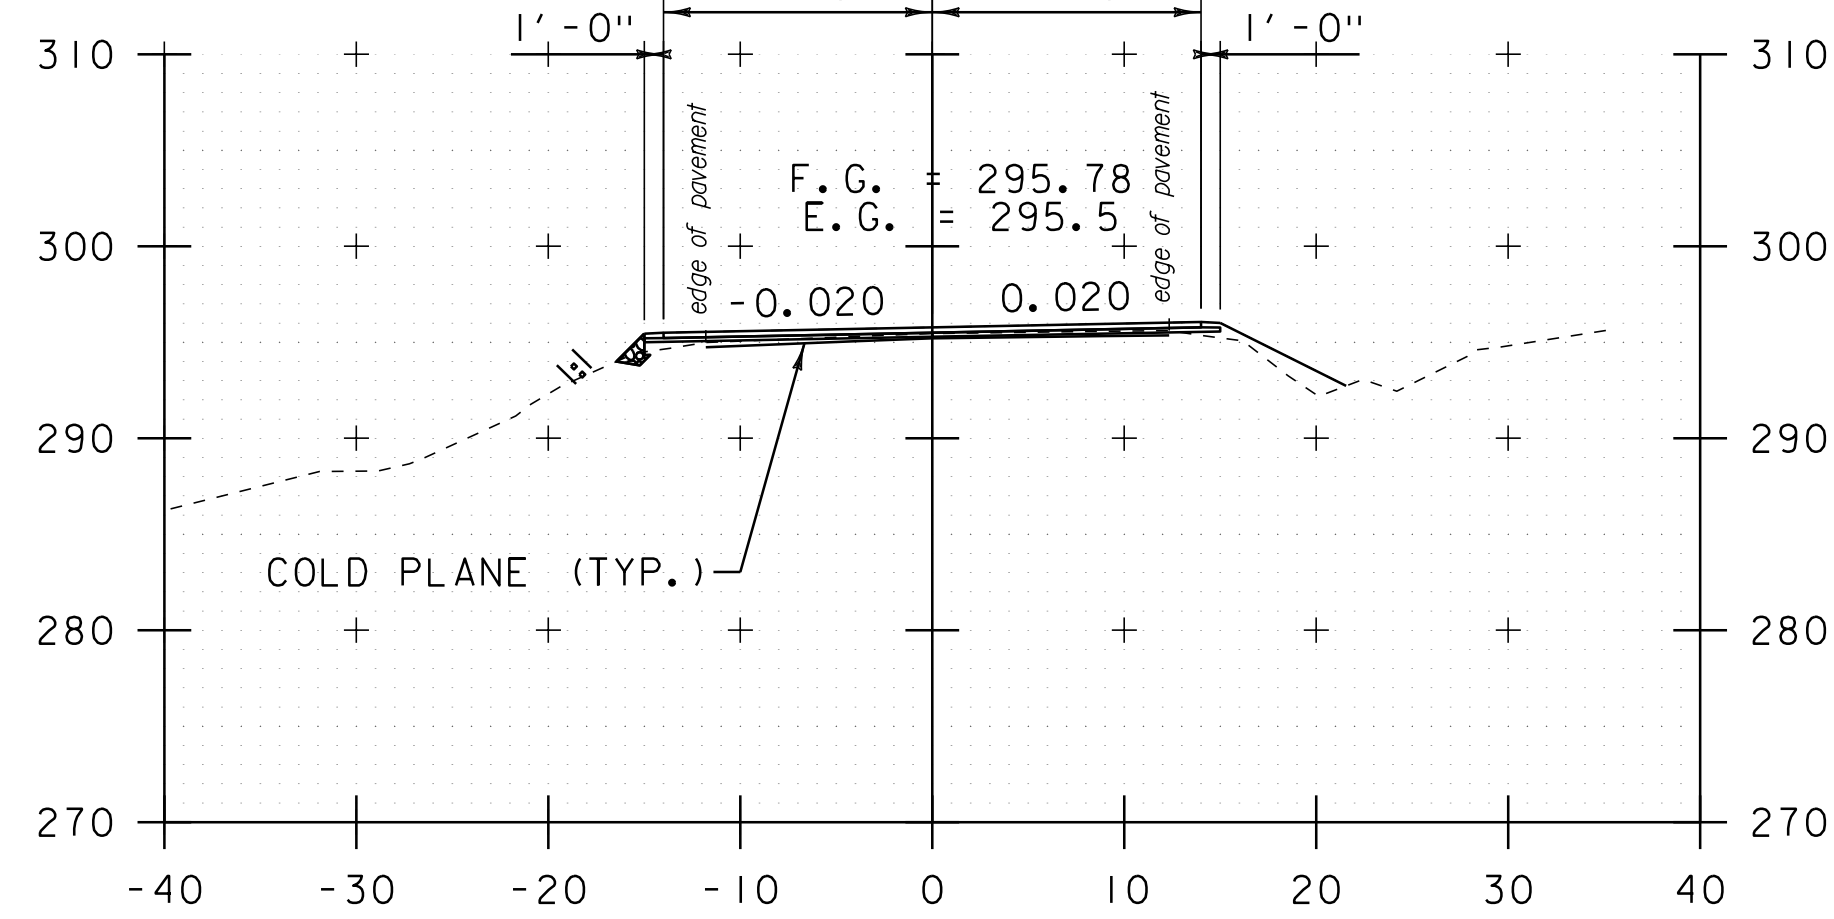


559+00

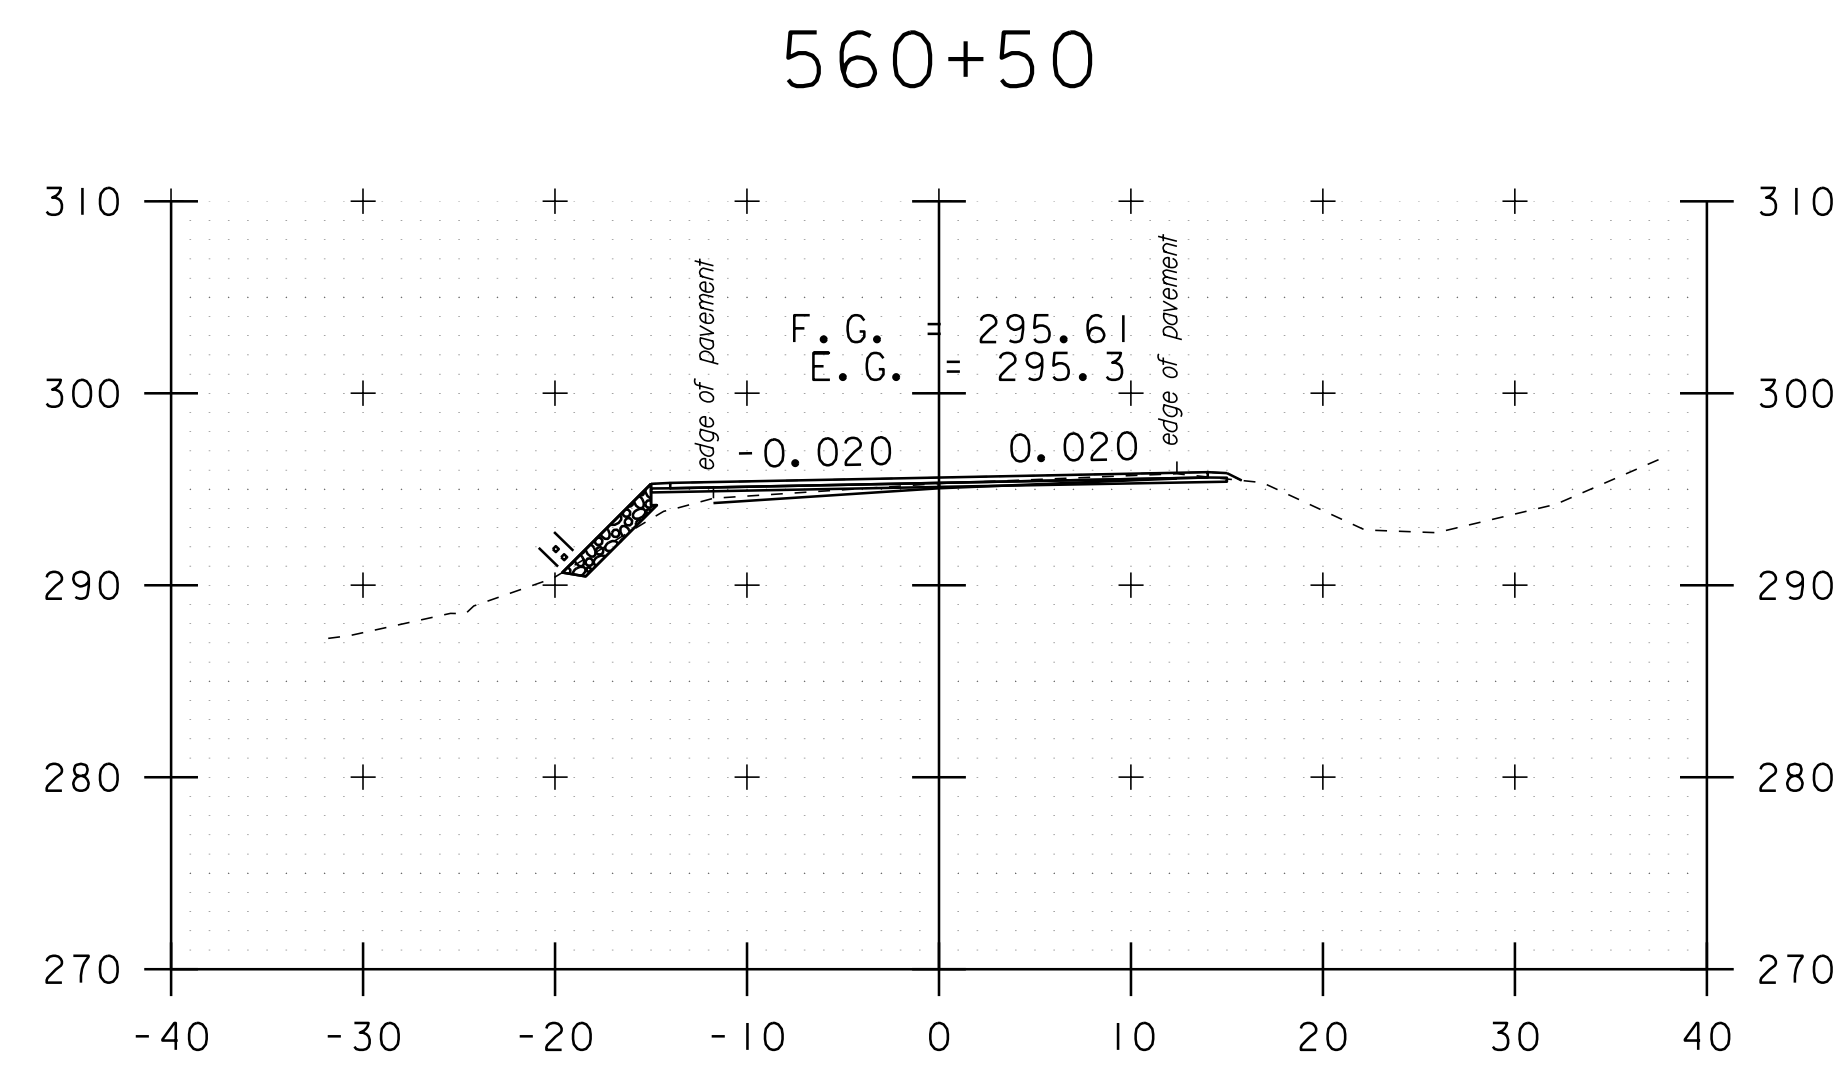


560+50

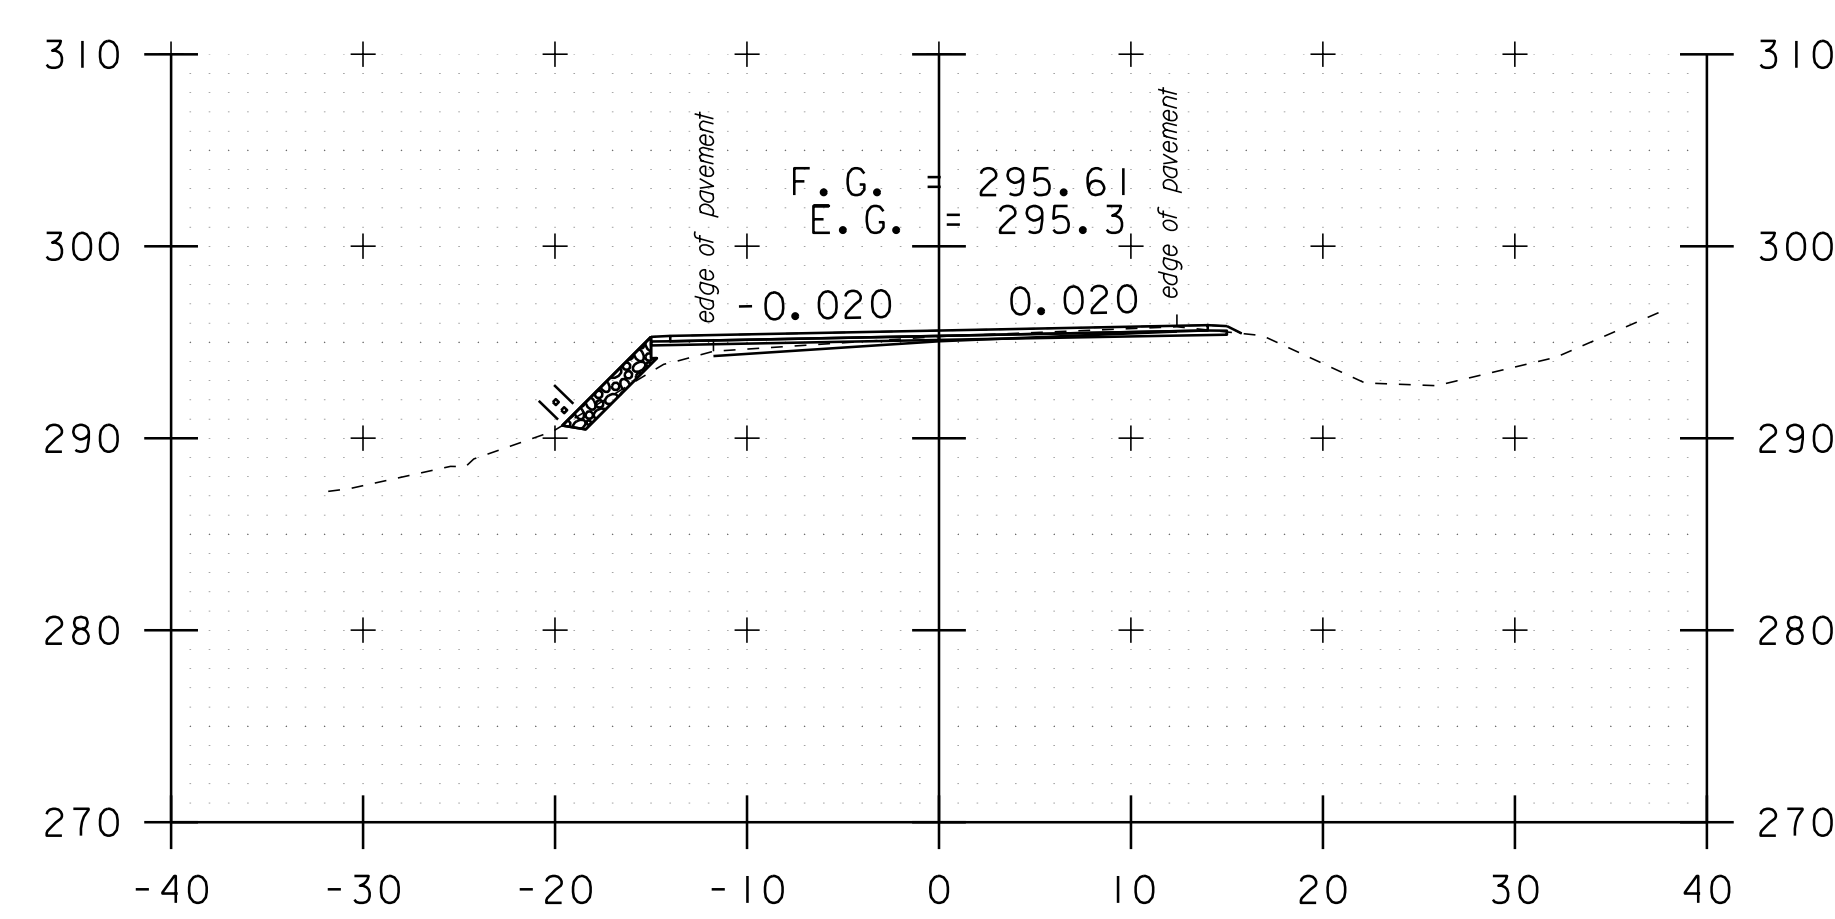

560+06

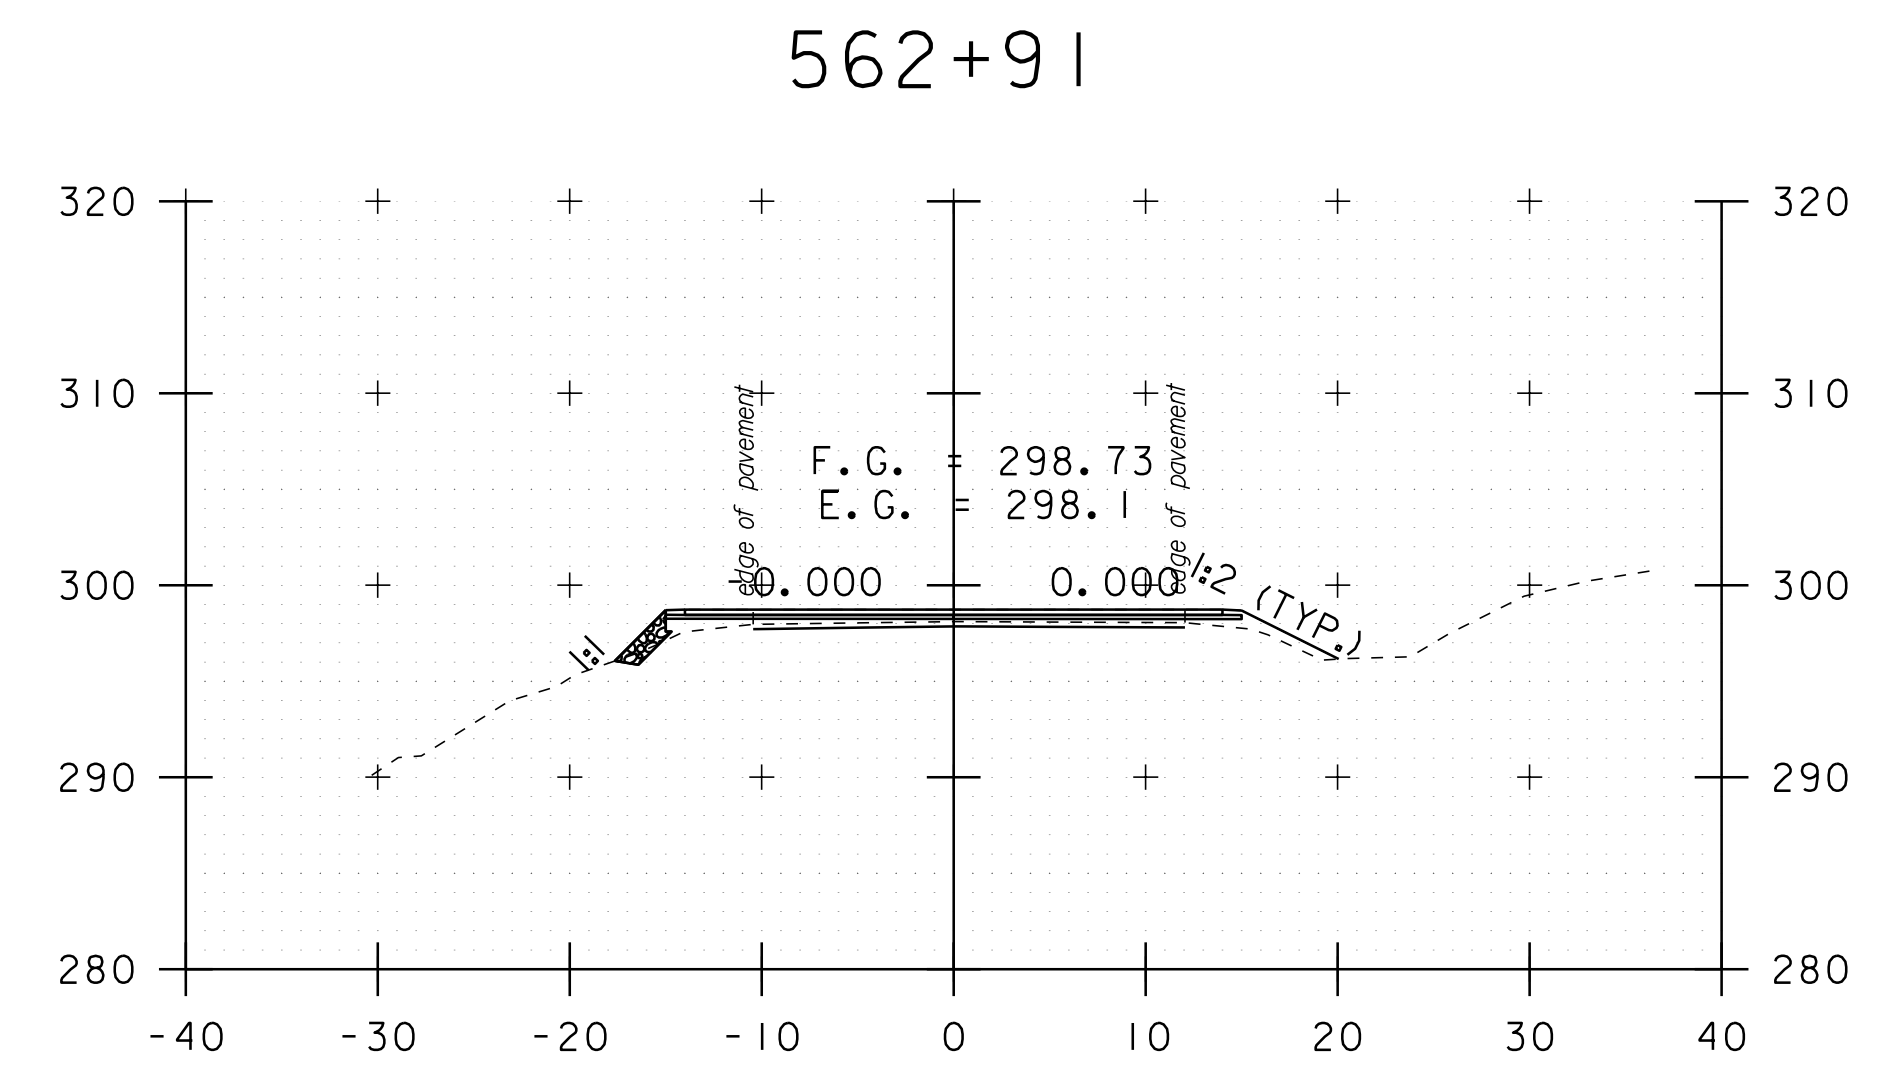

562+91

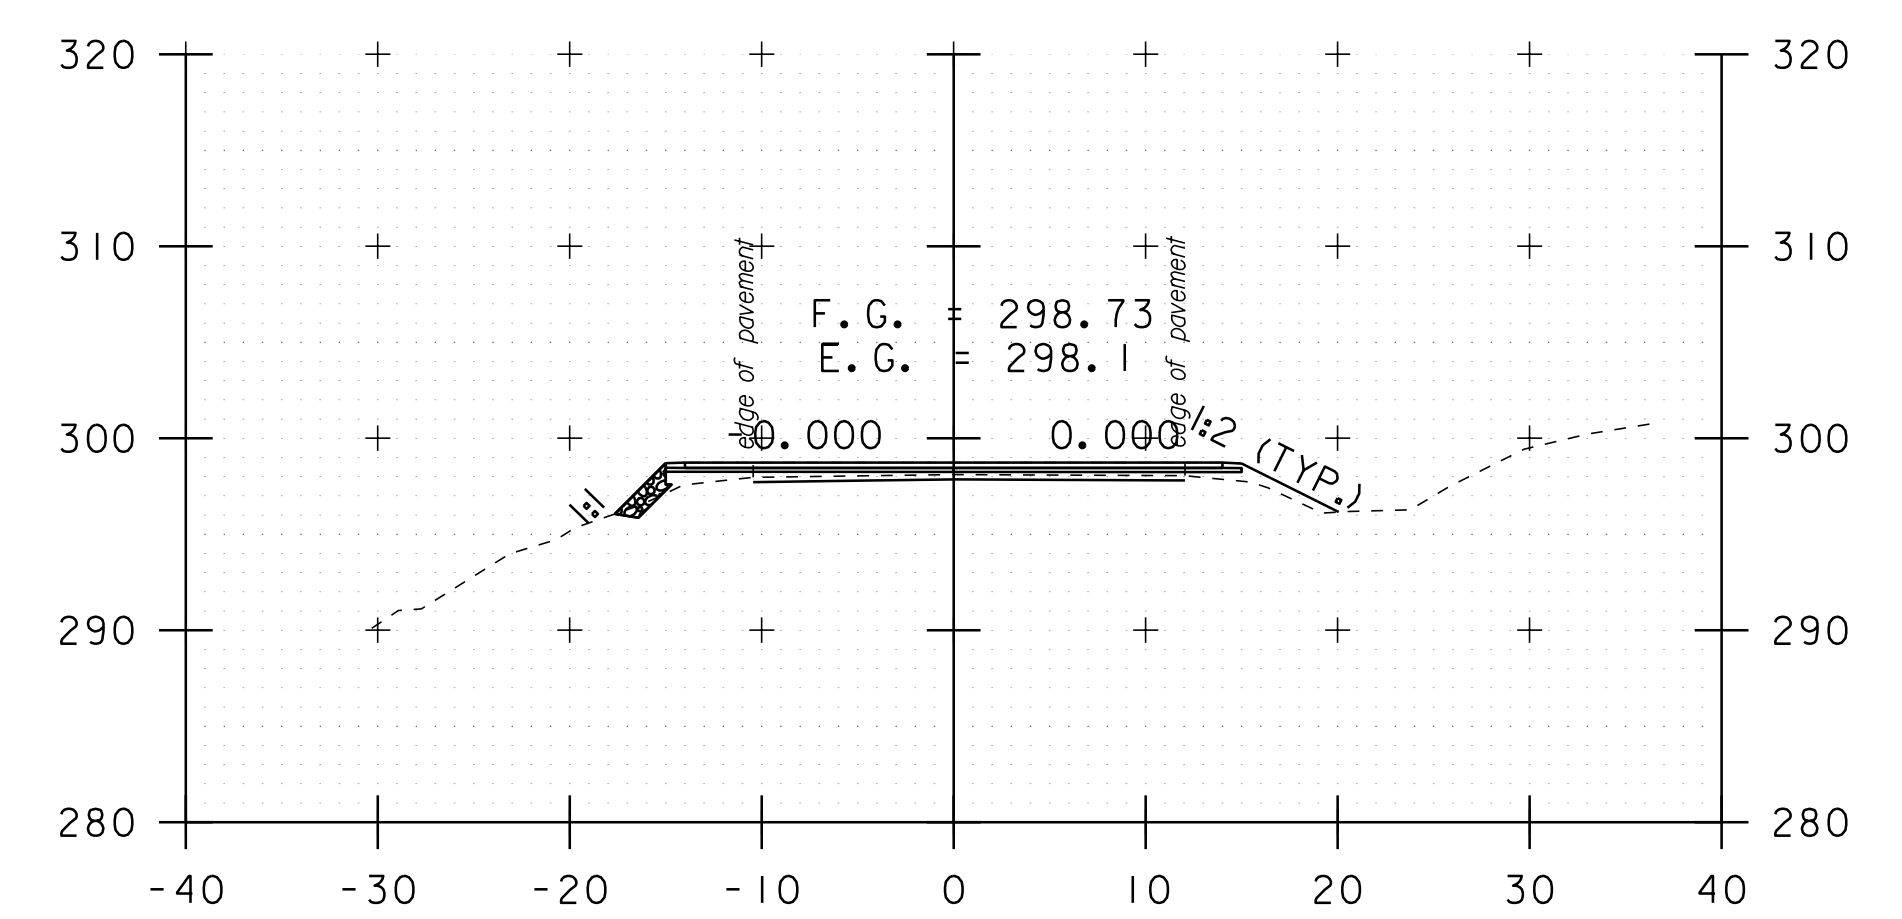

561+37

DATUM	NAVD 88
	NAD 83

STA. 559+00 TO STA. 563+30



CROSS SECTION SHEET 15

PROJECT NAME: ADDISON-NEW HAVEN
PROJECT NUMBER: STP 9632(1)

FILE NAME: p95B076.dgn
PROJECT LEADER: CDL
DESIGNED BY: SJL
PLOT FILE: p95B076_I20.1

PLOT DATE: 3/13/2012
DRAWN BY: SJL
CHECKED BY: EPD
SHEET 120 OF 186