




564+50  
DRIVE LT

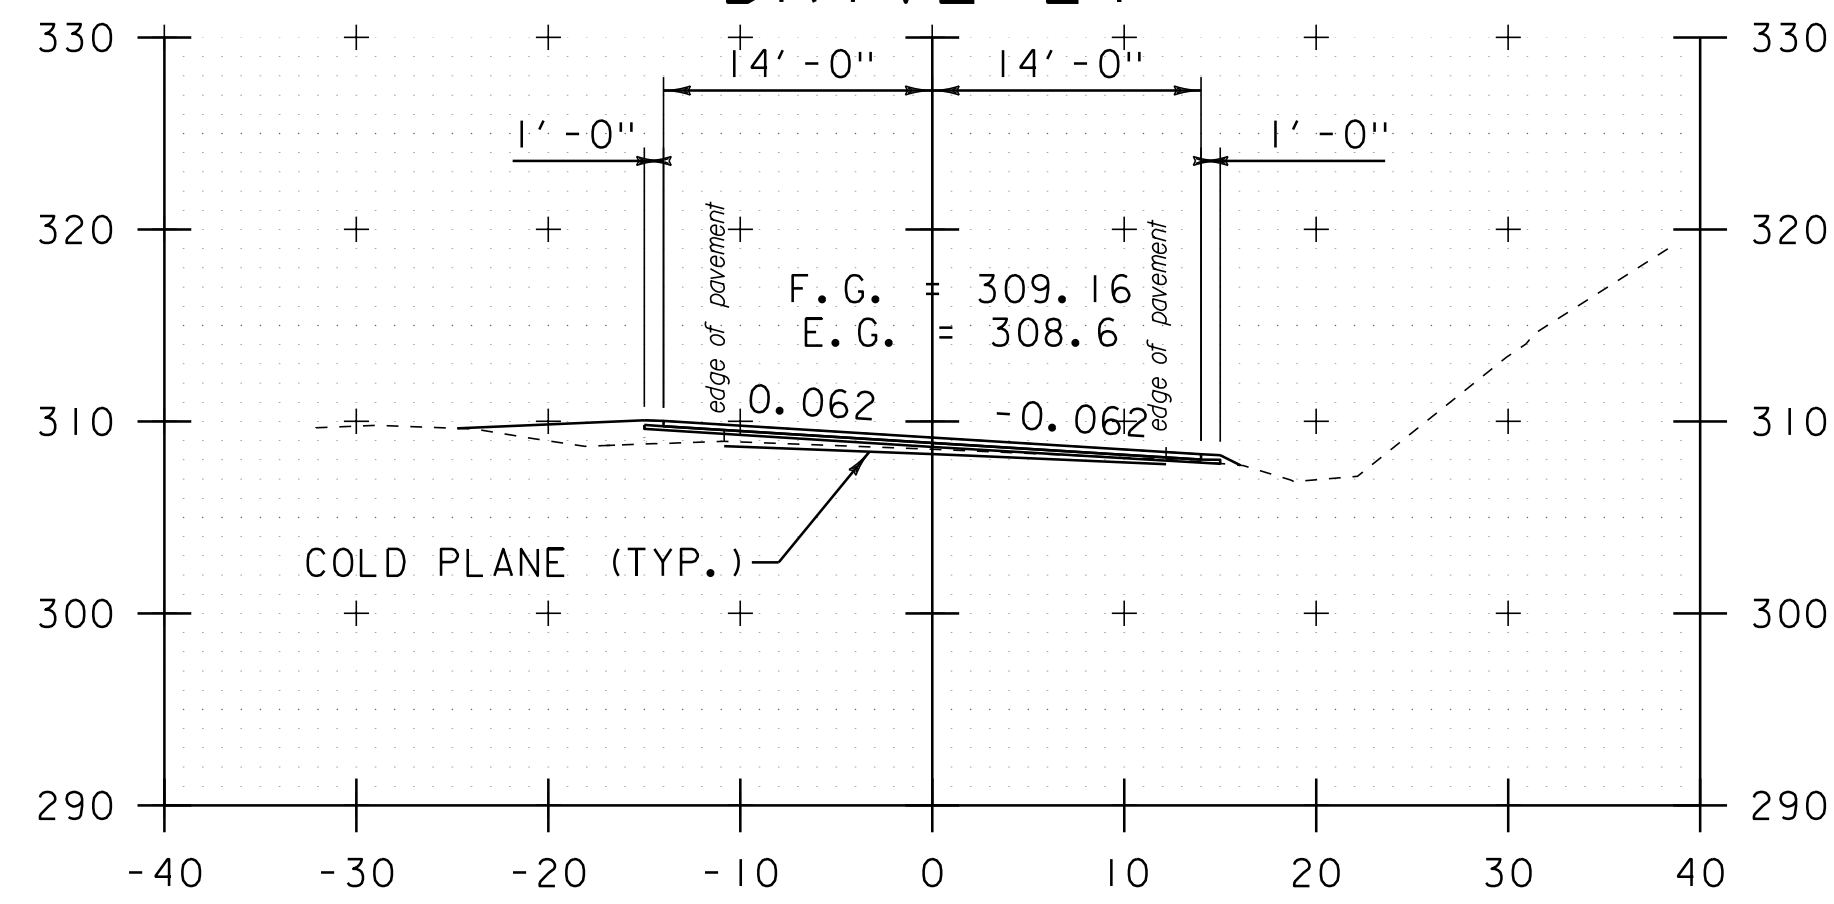


564+00  
DRIVE LT

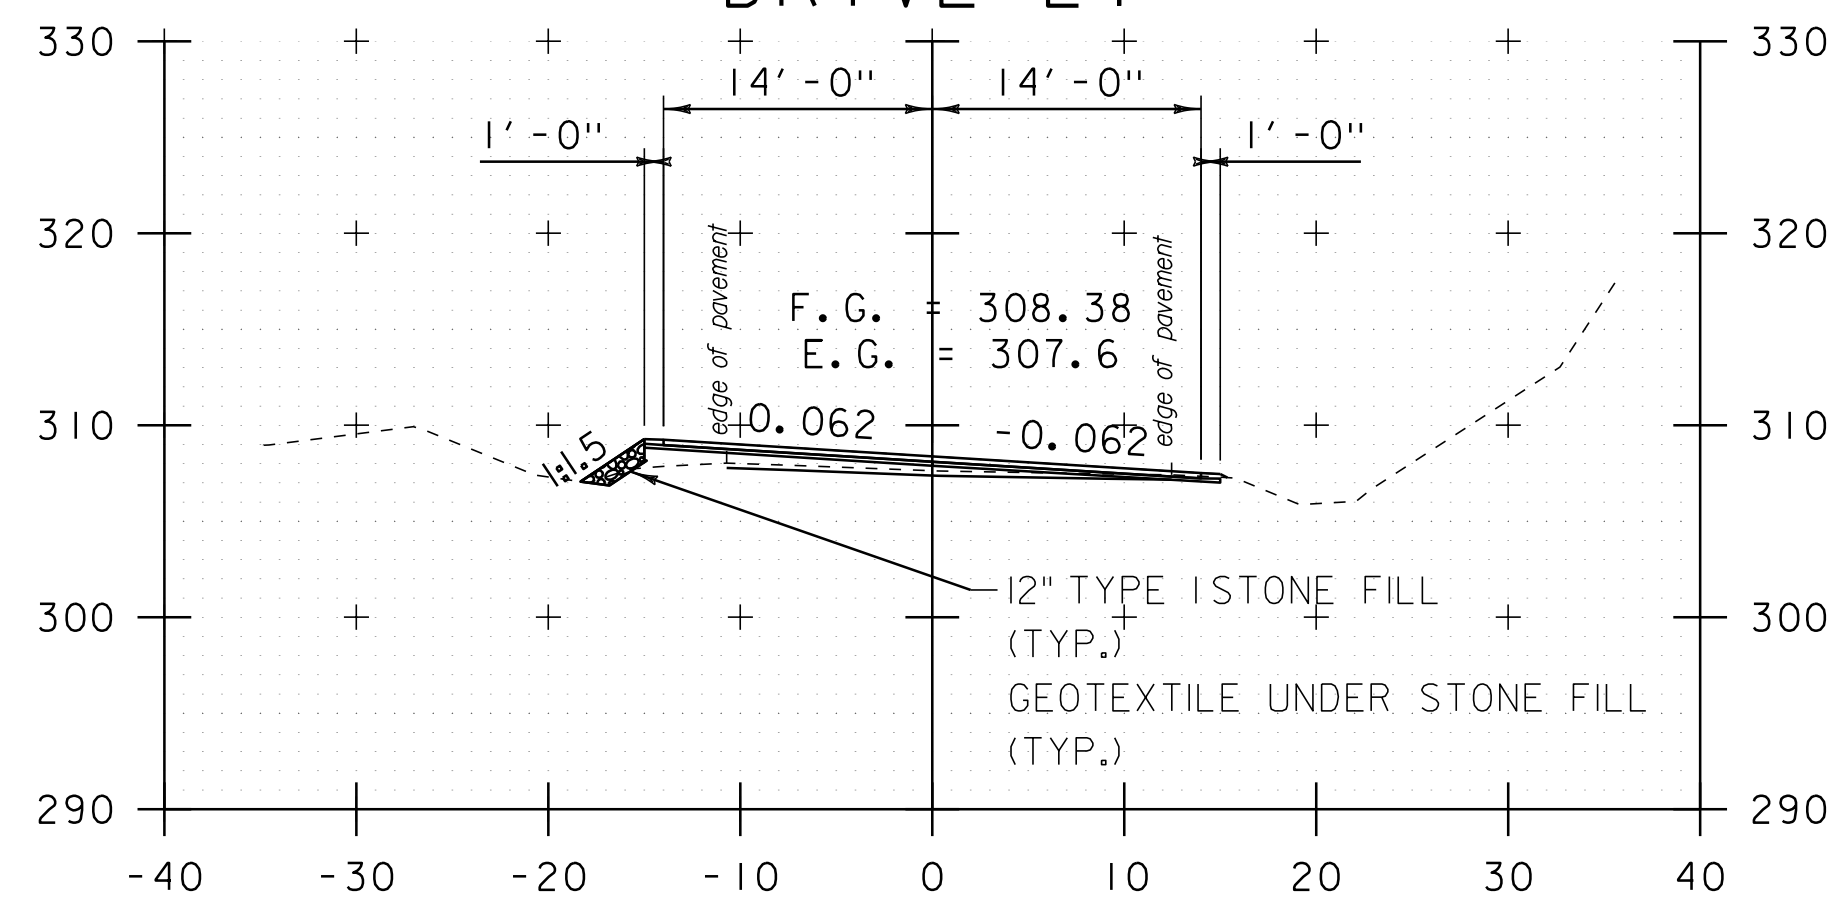


563+50

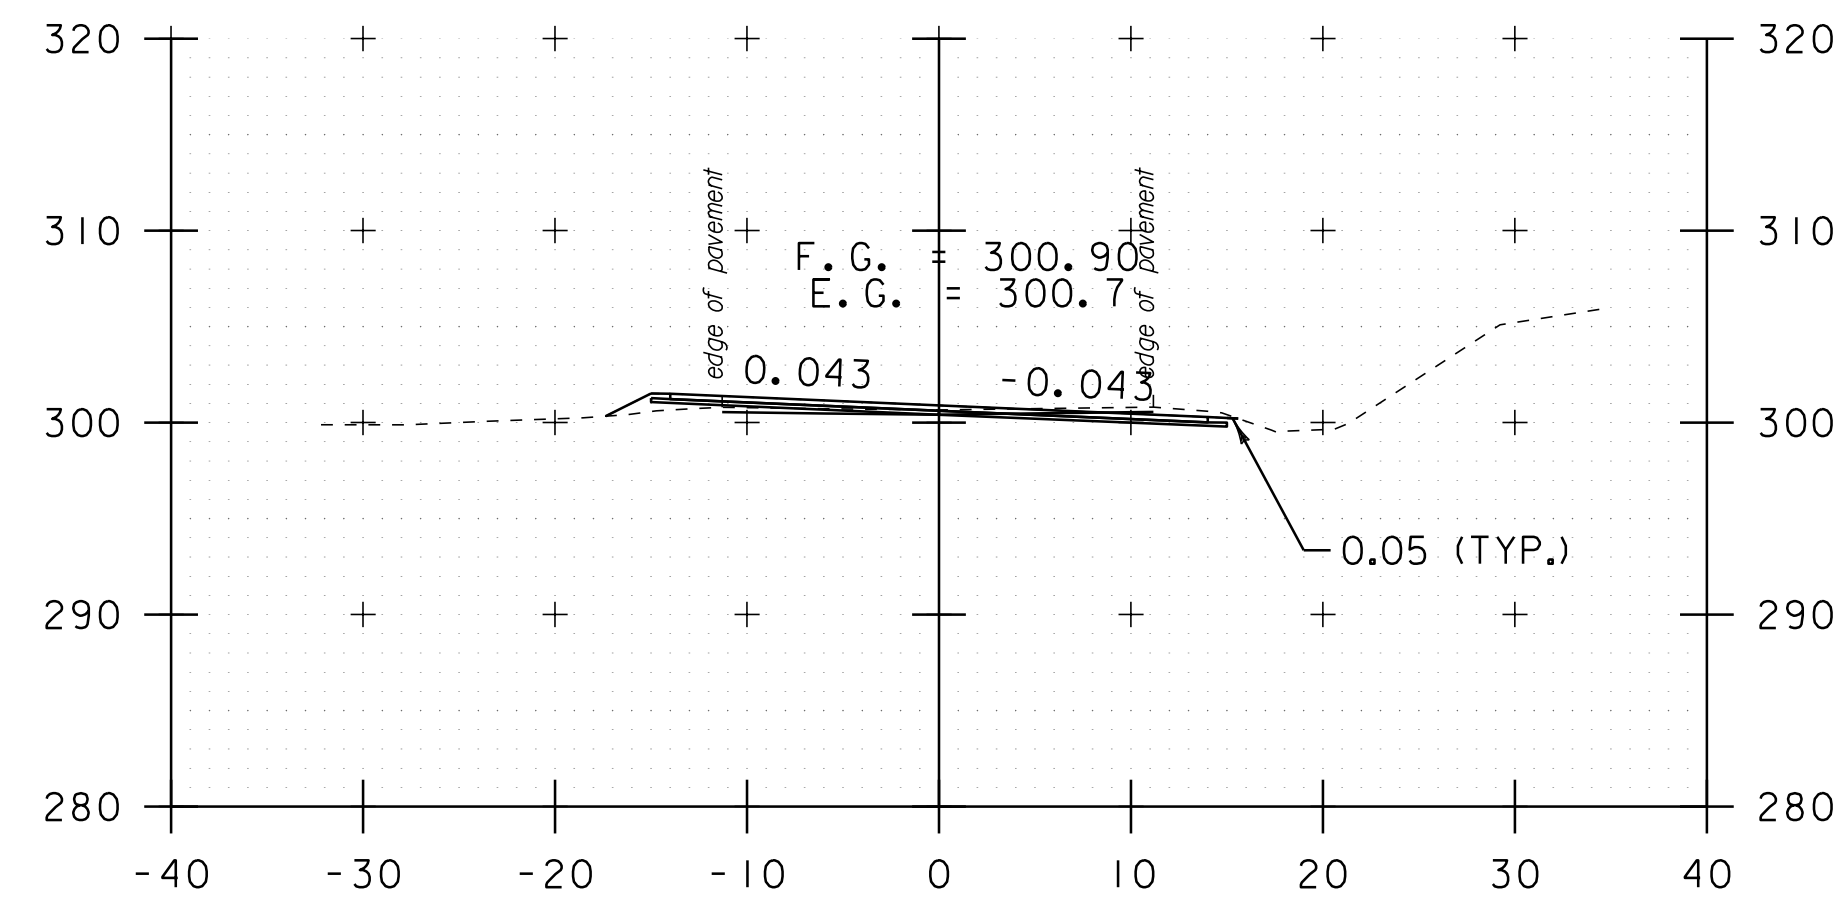


565+57

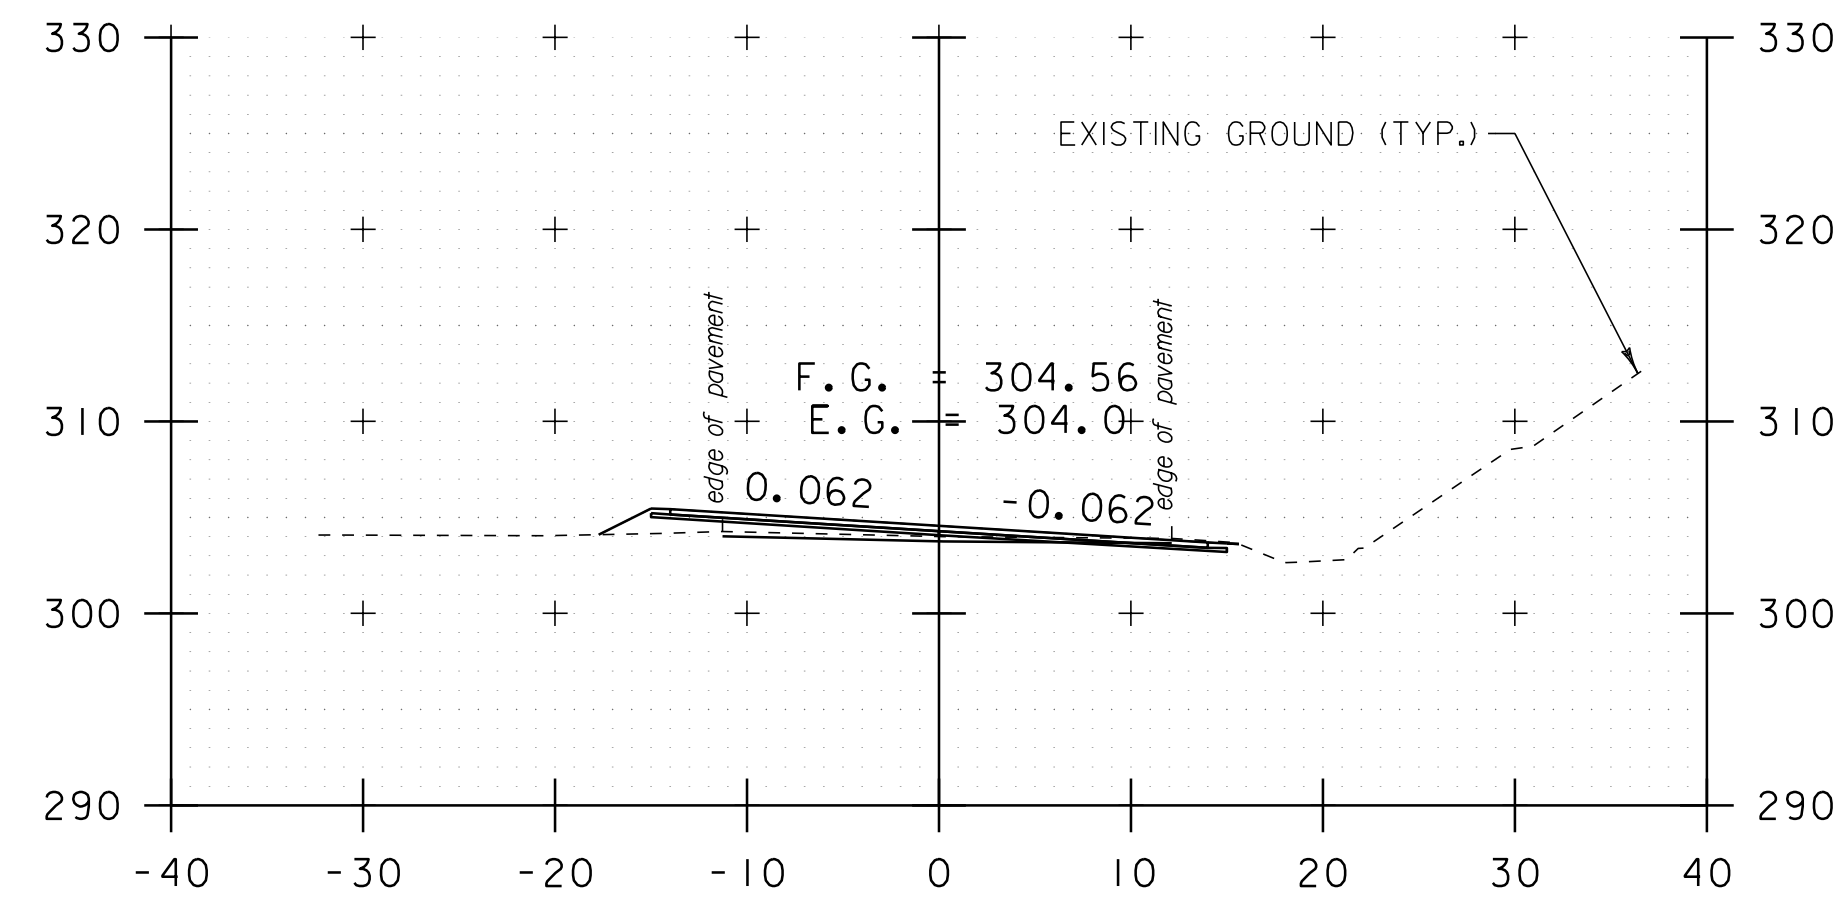


565+15

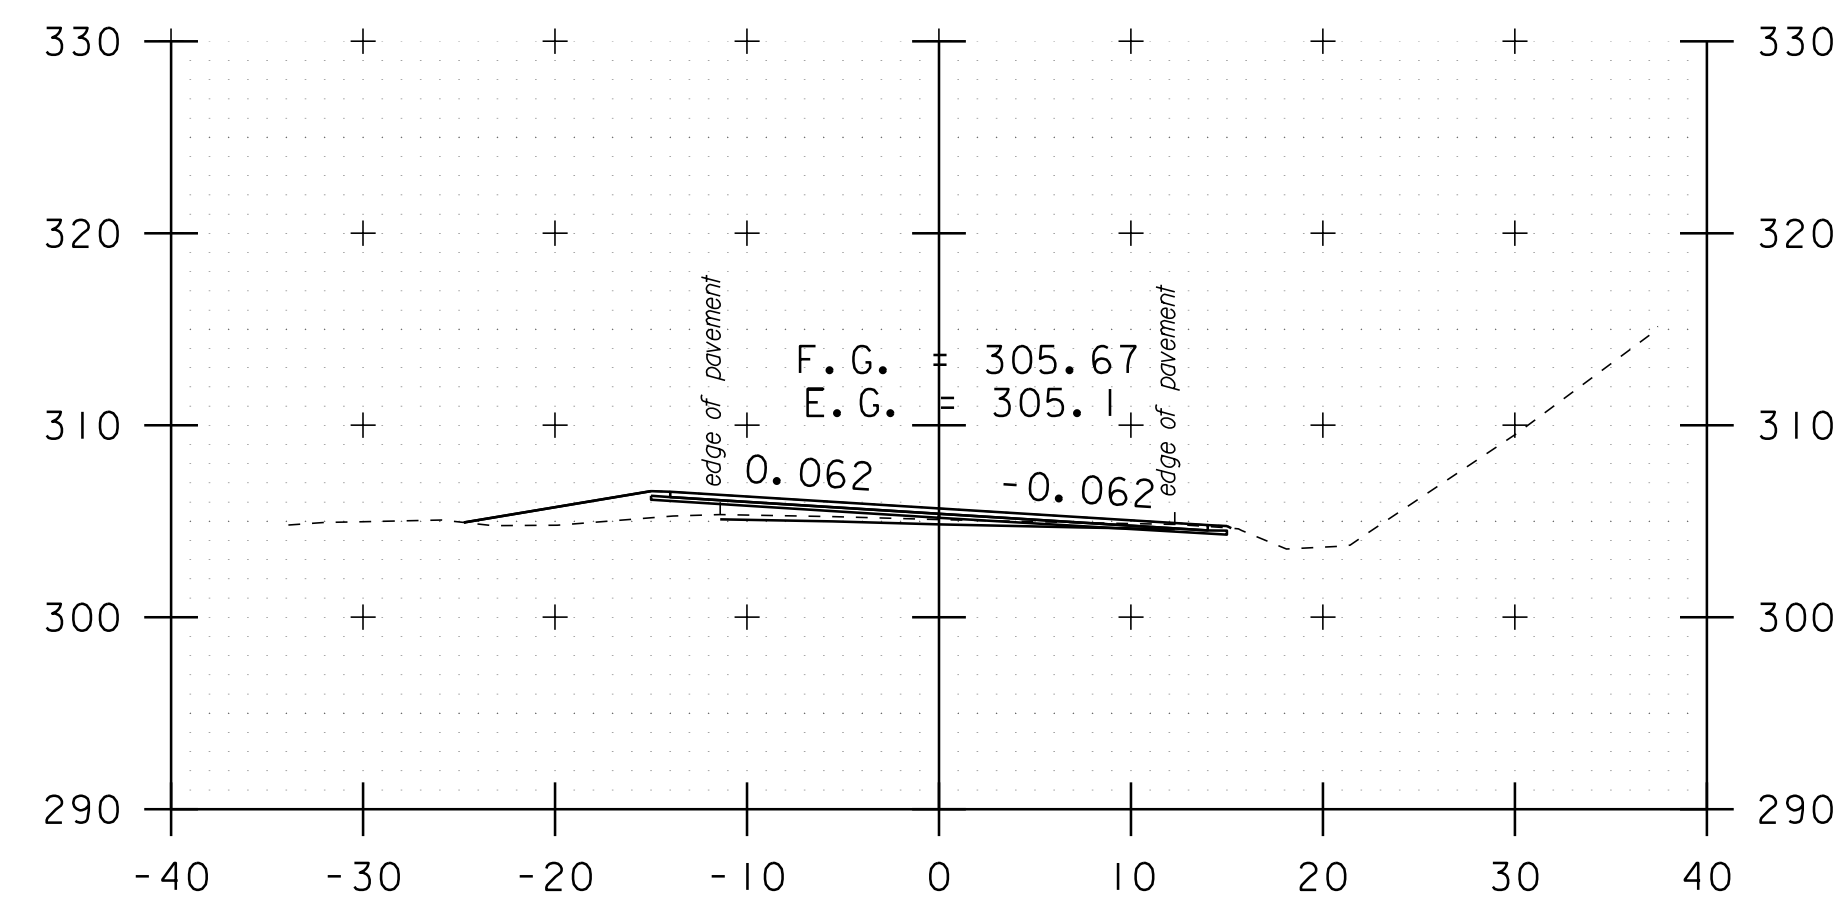


565+00  
DRIVE LT

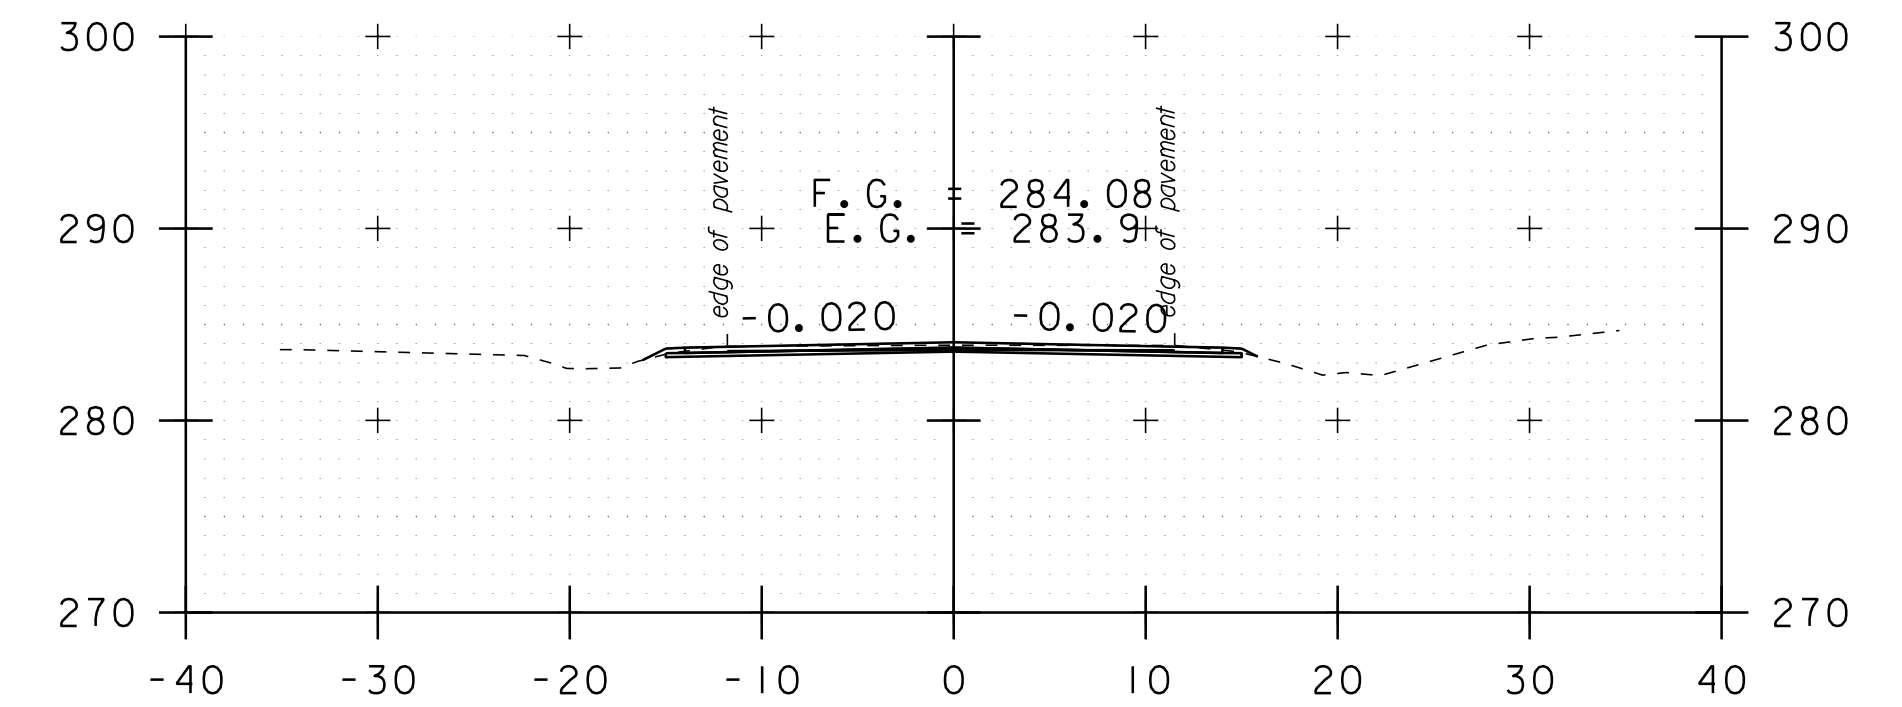

567+55

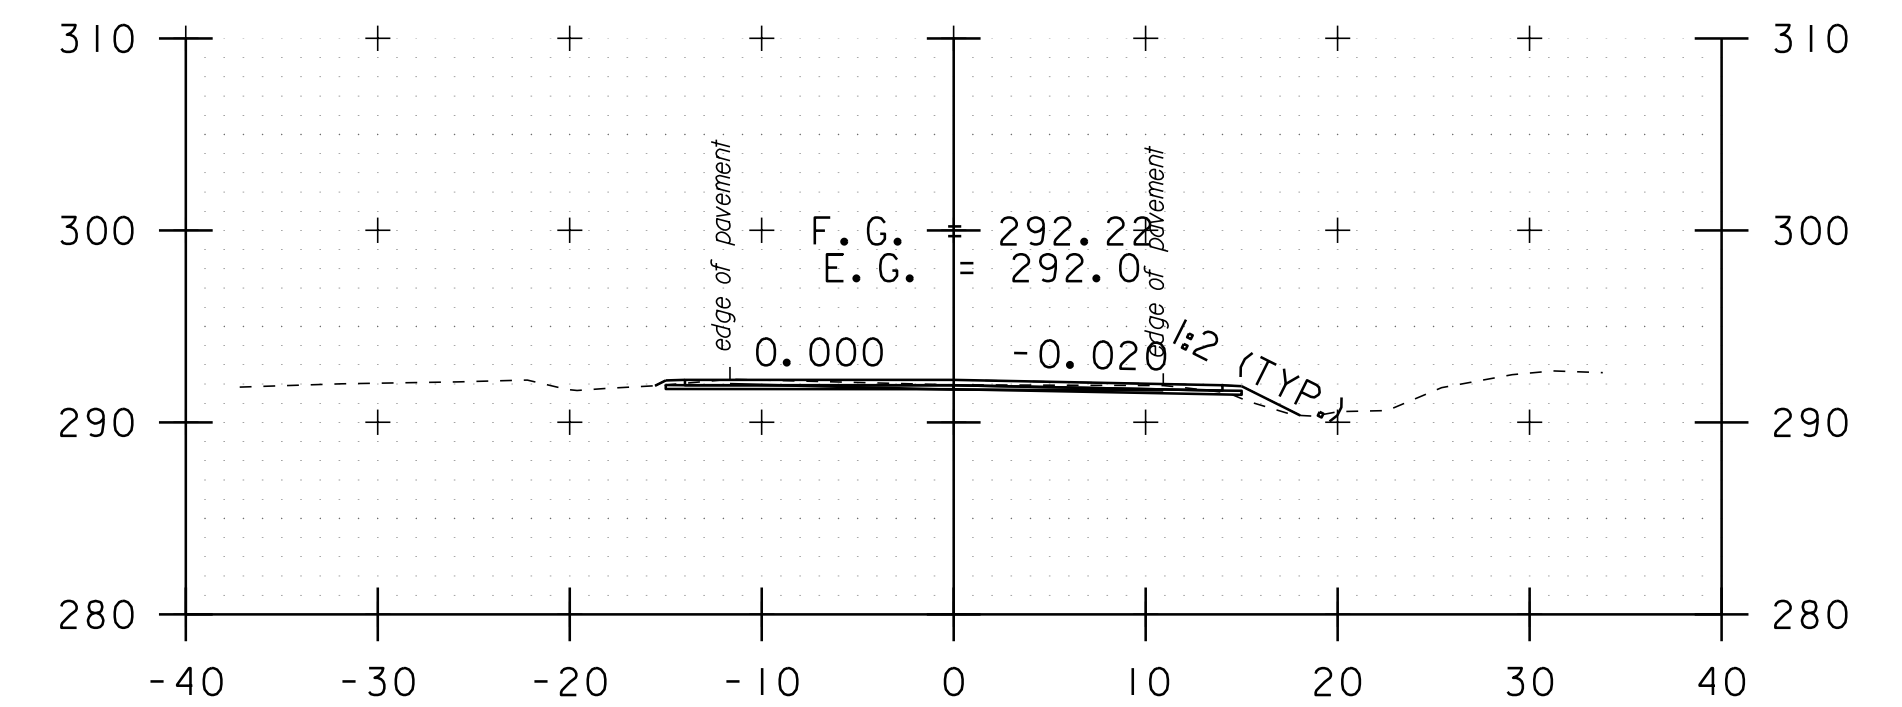

566+55

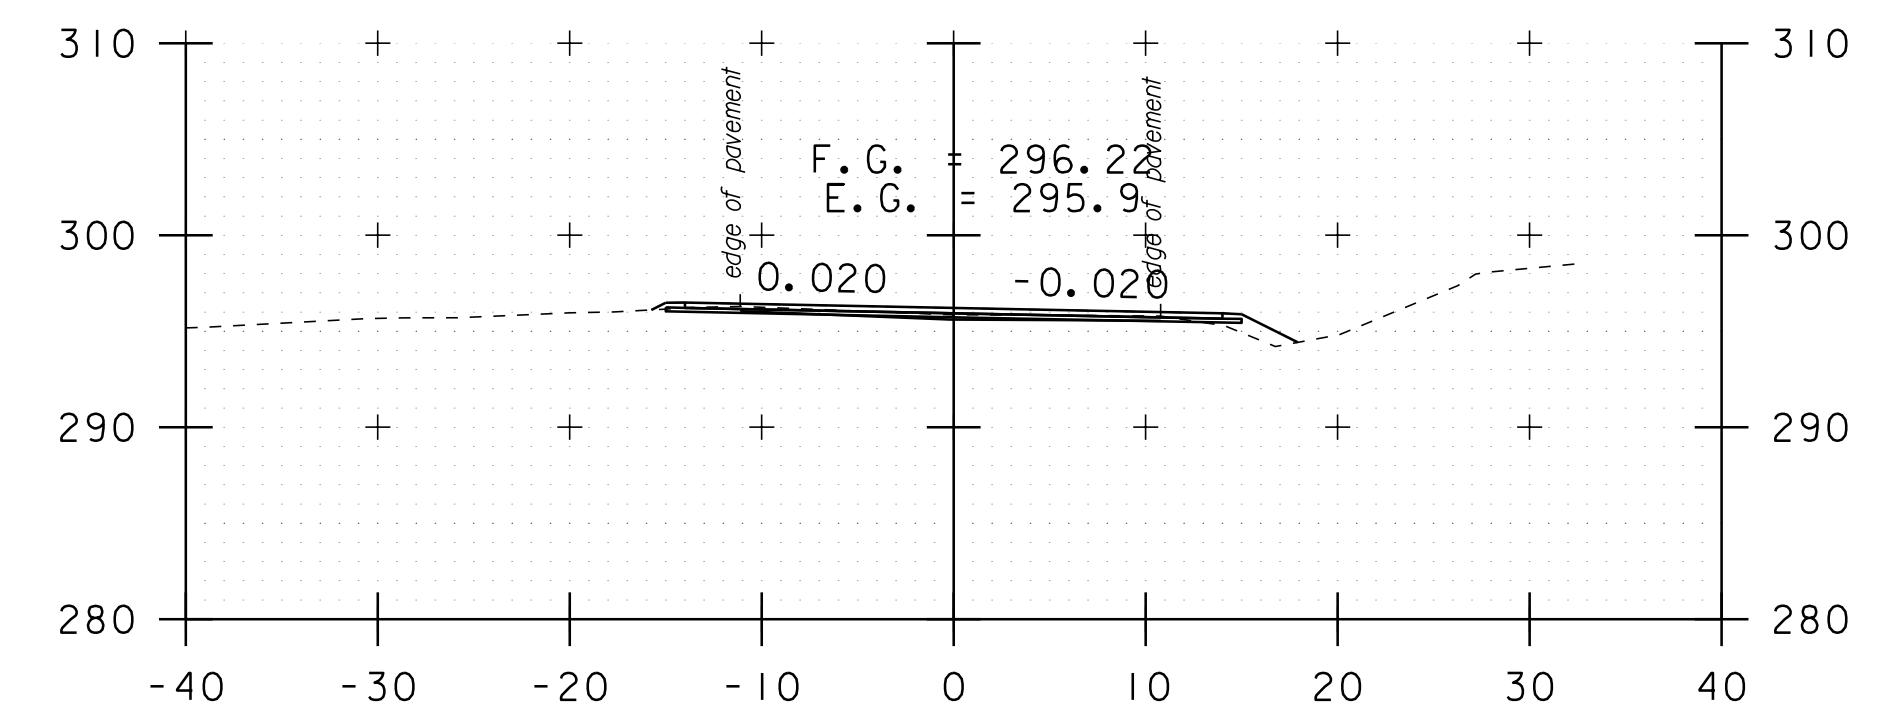

566+10

DATUM	NAVD 88
	NAD 83

STA. 563+50 TO STA. 567+55



**CROSS SECTION SHEET 16**

PROJECT NAME: ADDISON-NEW HAVEN  
PROJECT NUMBER: STP 9632(1)

FILE NAME: p95B076.dgn  
PROJECT LEADER: CDL  
DESIGNED BY: SJL  
PLOT FILE: p95B076\_121.I

PLOT DATE: 3/13/2012  
DRAWN BY: SJL  
CHECKED BY: EPD  
SHEET 121 OF 186