
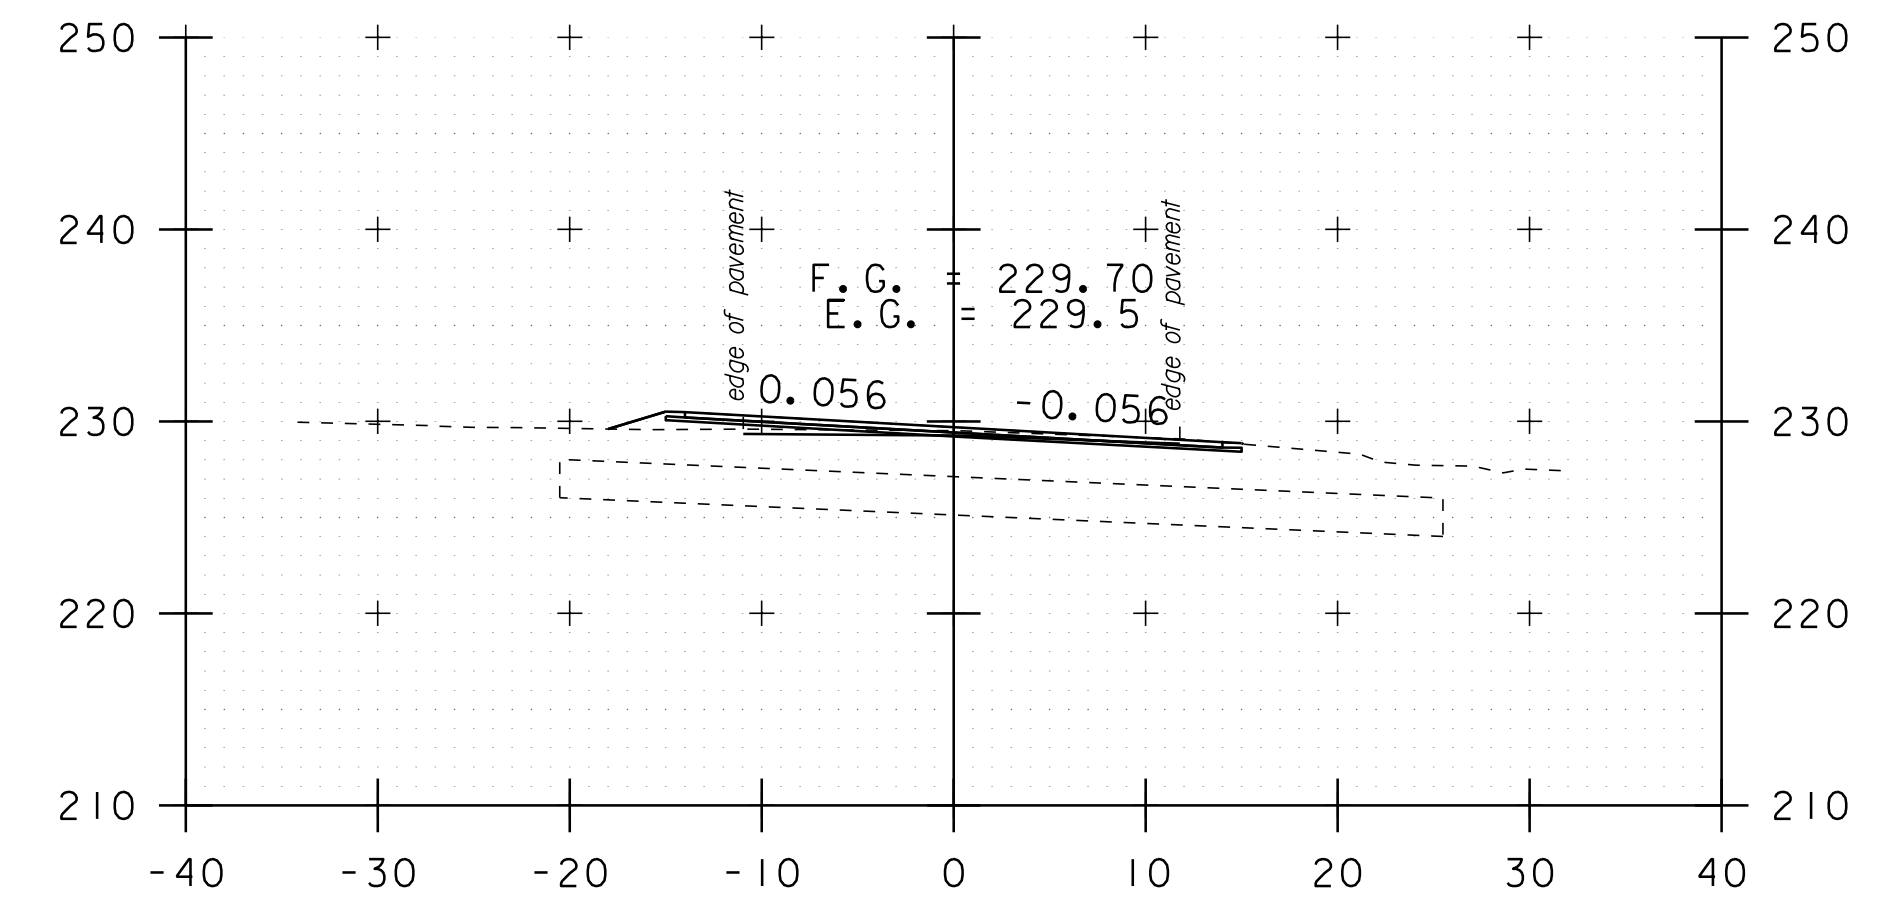
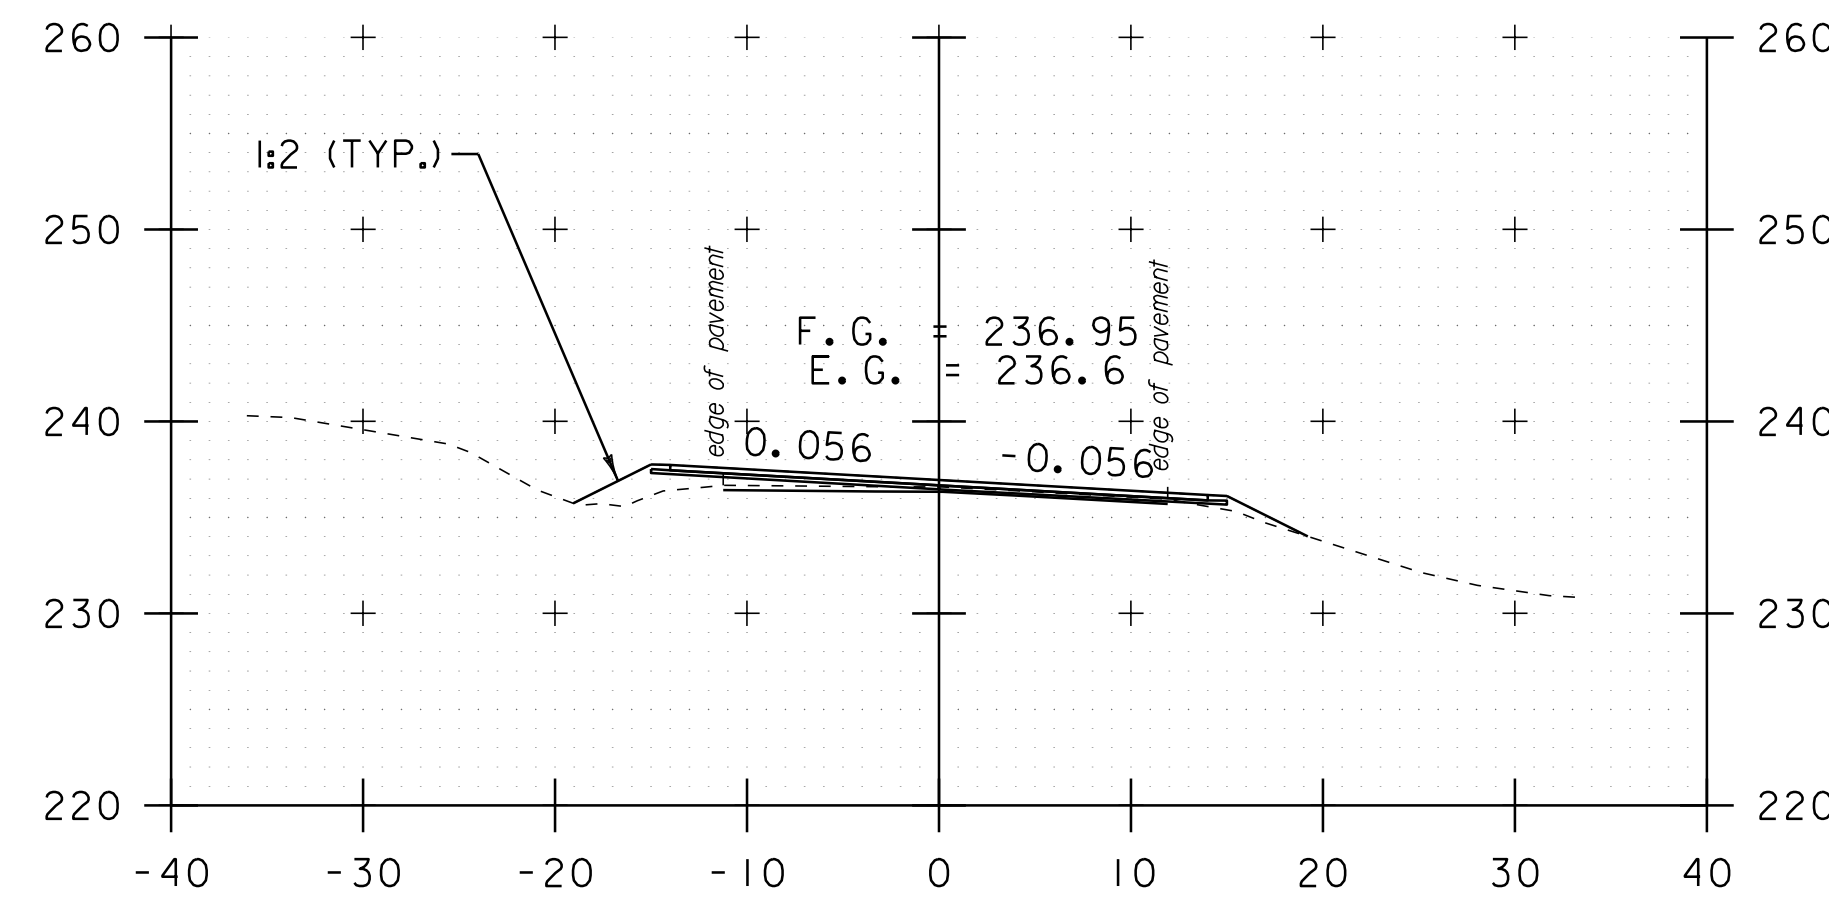


576+18

578+00




579+50

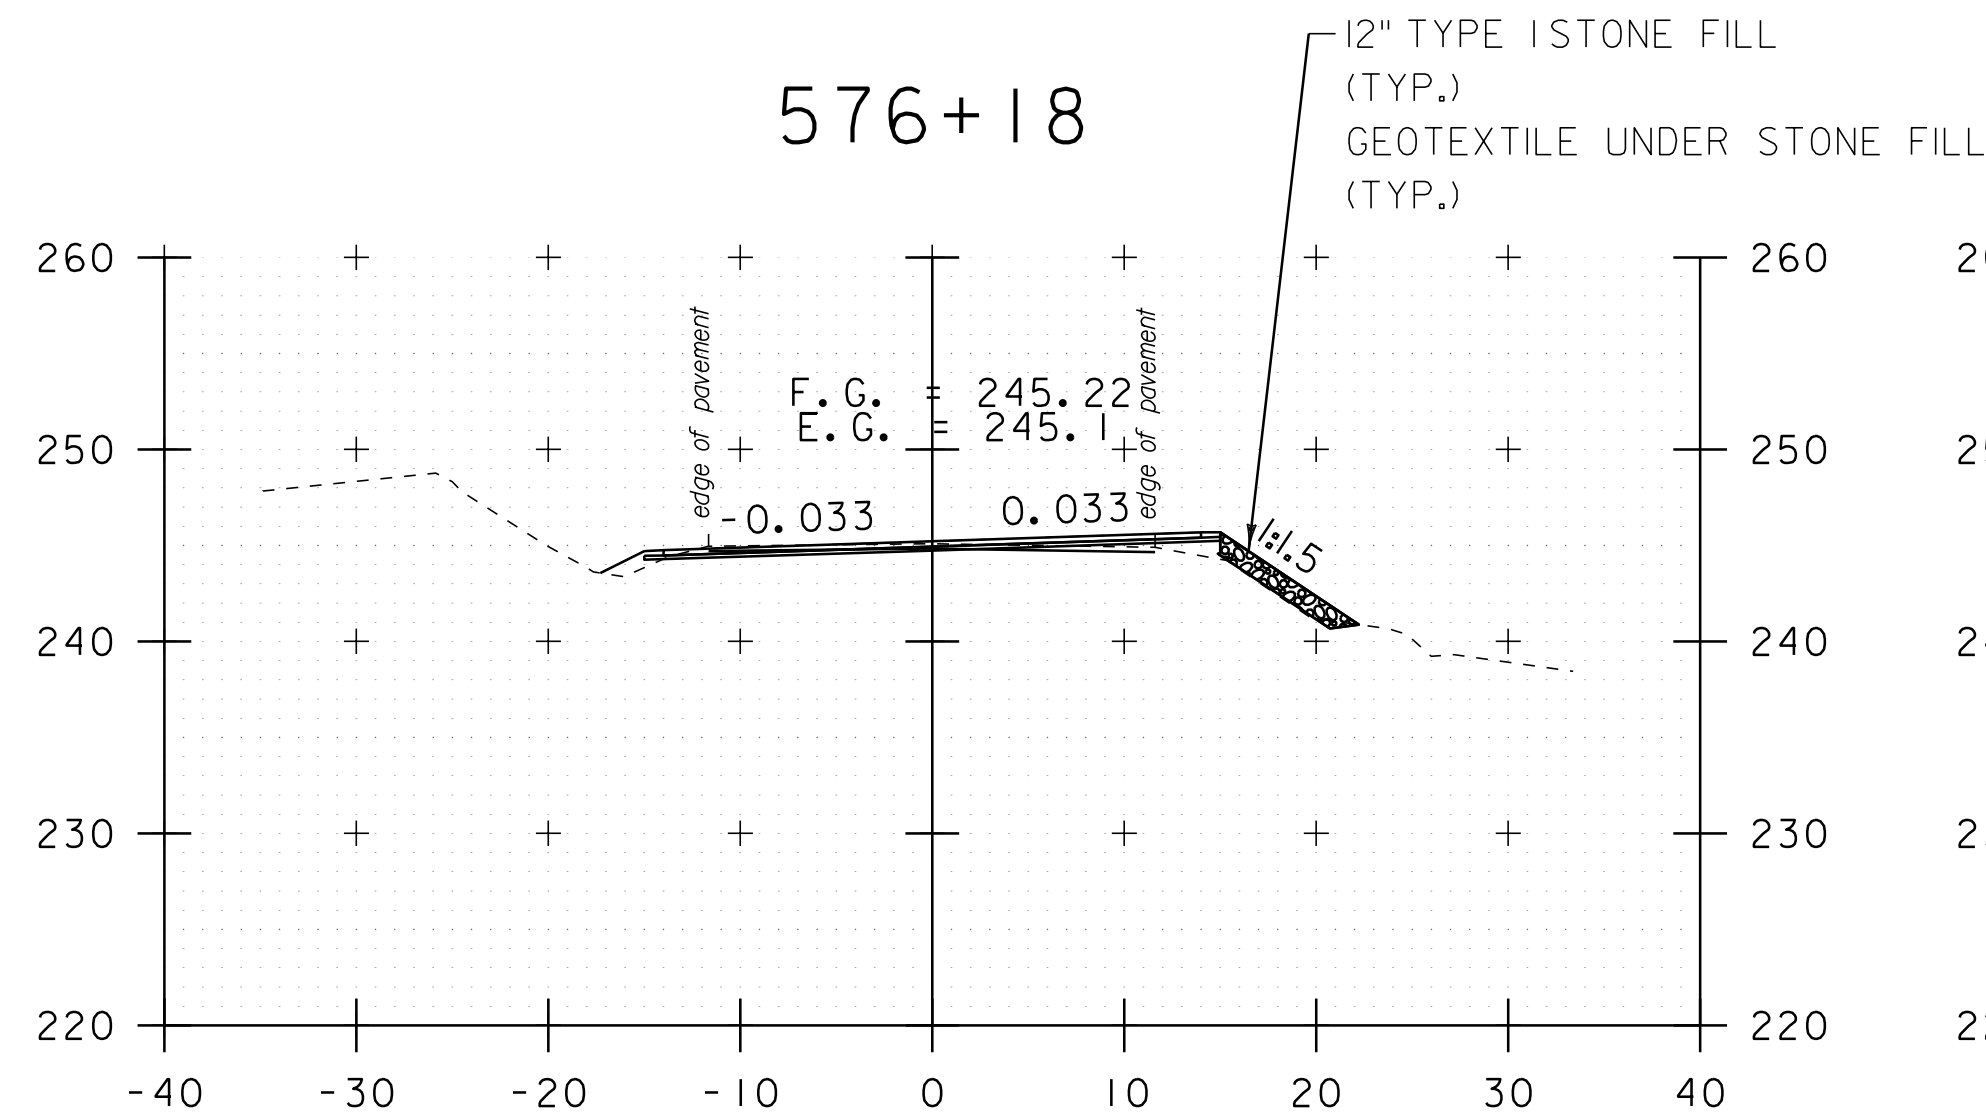

575+39

577+50

579+00  
DRIVE LT

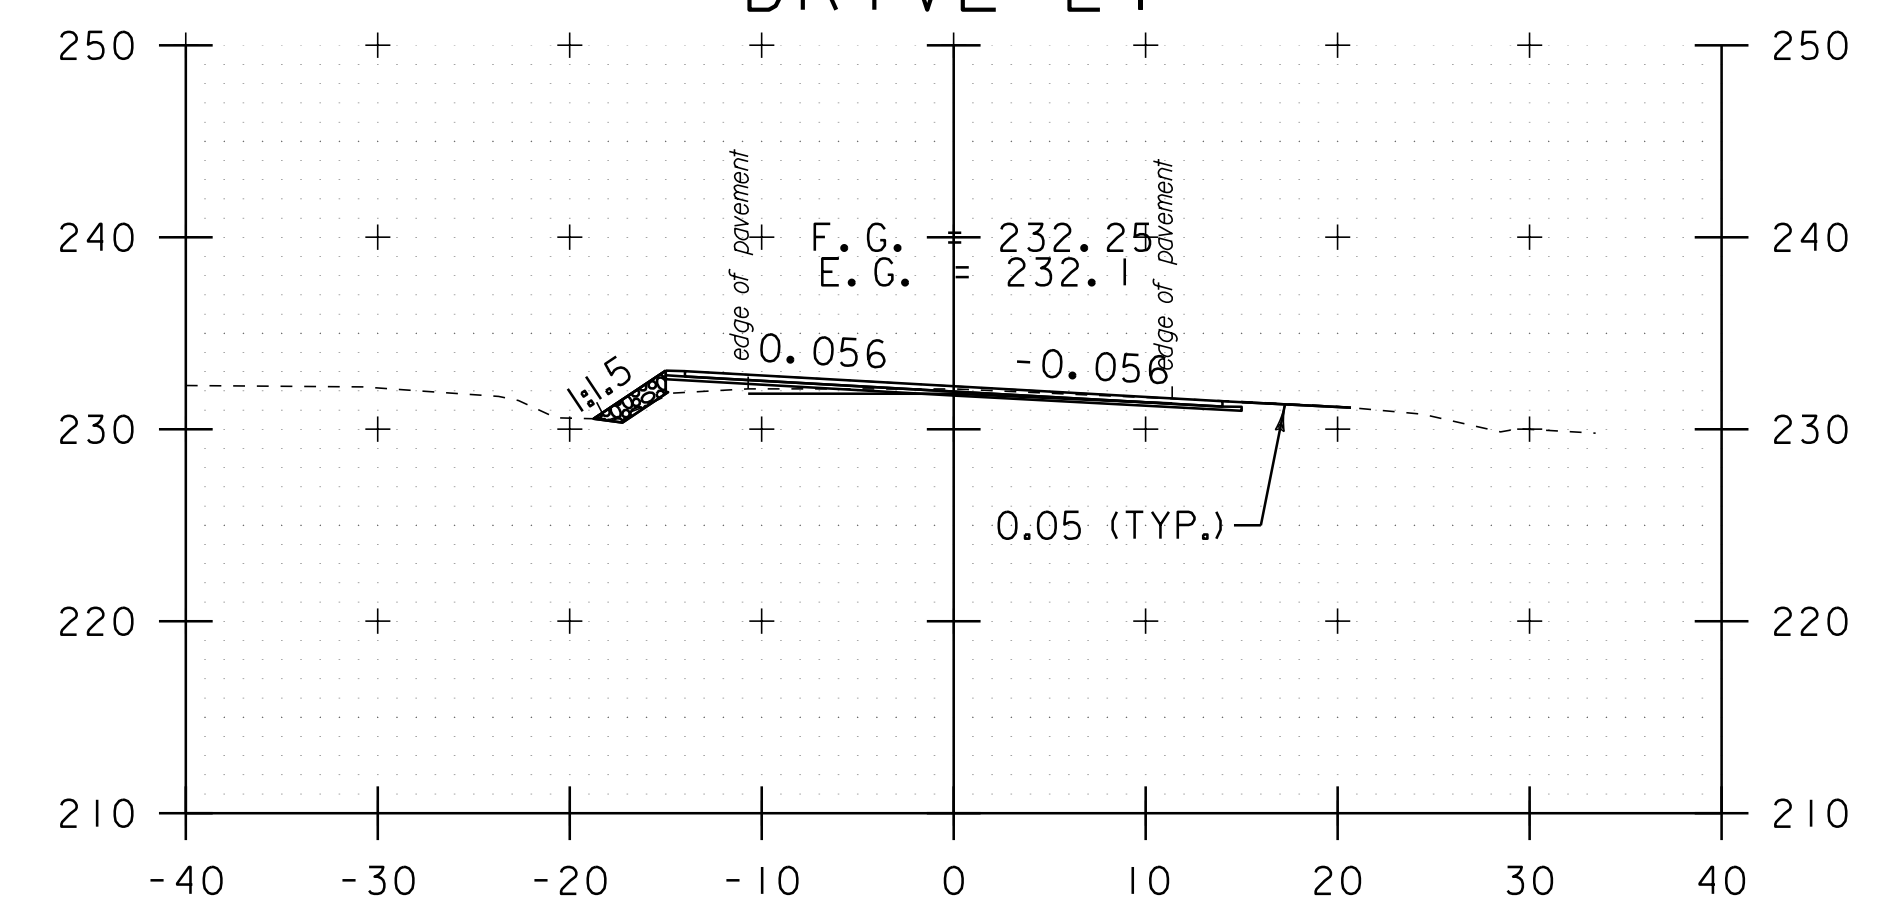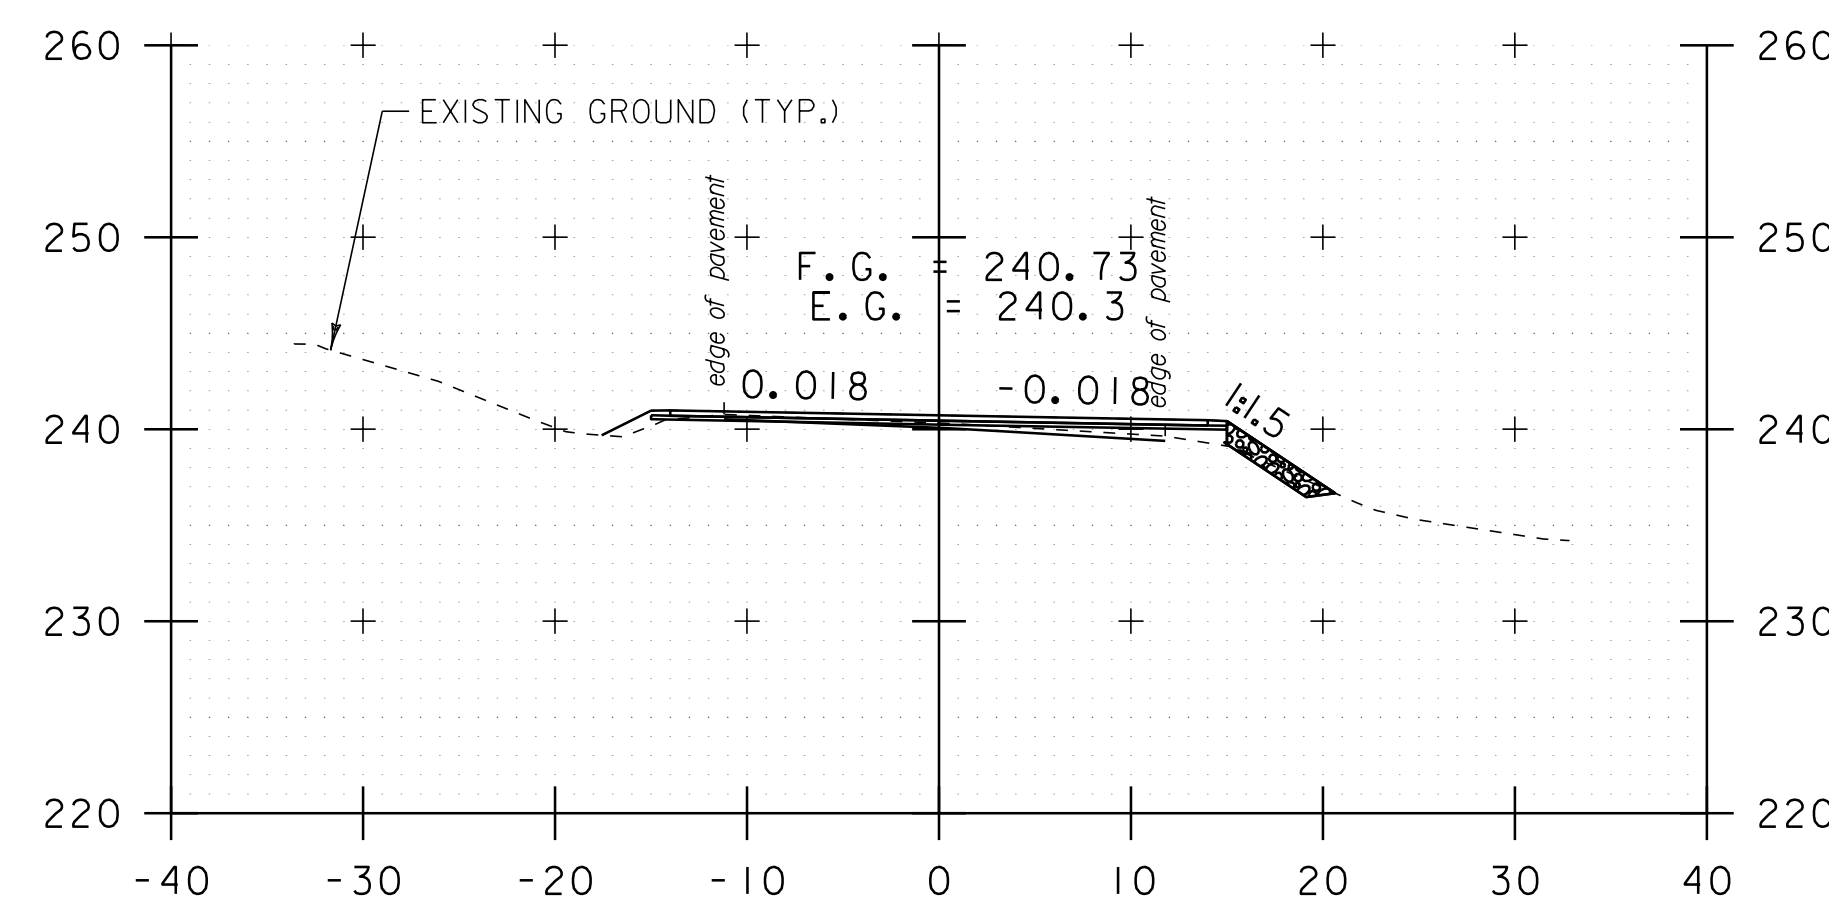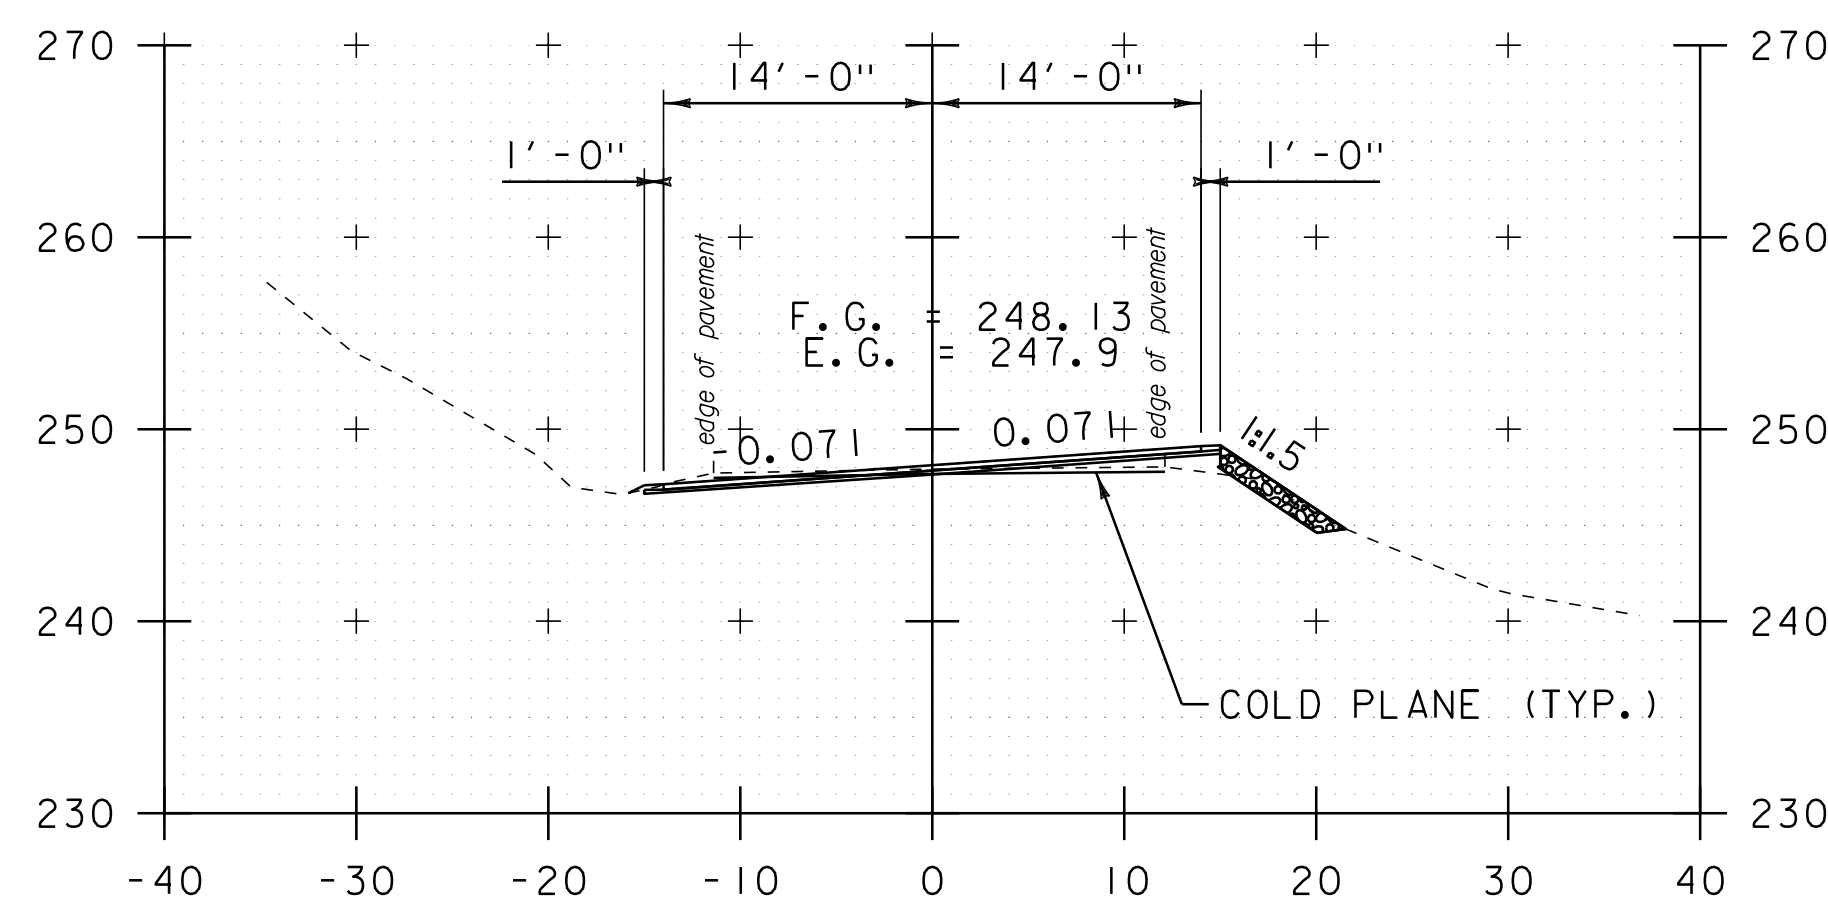

574+50

576+61

578+50

DATUM  
NAVD 88  
NAD 83

STA. 574+50 TO STA. 579+50



**CROSS  
SECTION  
SHEET 18**

PROJECT NAME: ADDISON-NEW HAVEN  
PROJECT NUMBER: STP 9632(1)

FILE NAME: p95B076.dgn  
PROJECT LEADER: CDL  
DESIGNED BY: SJL  
PLOT FILE: p95B076\_I23.1

PLOT DATE: 3/13/2012  
DRAWN BY: SJL  
CHECKED BY: EPD  
SHEET 123 OF 186