




a 3+25

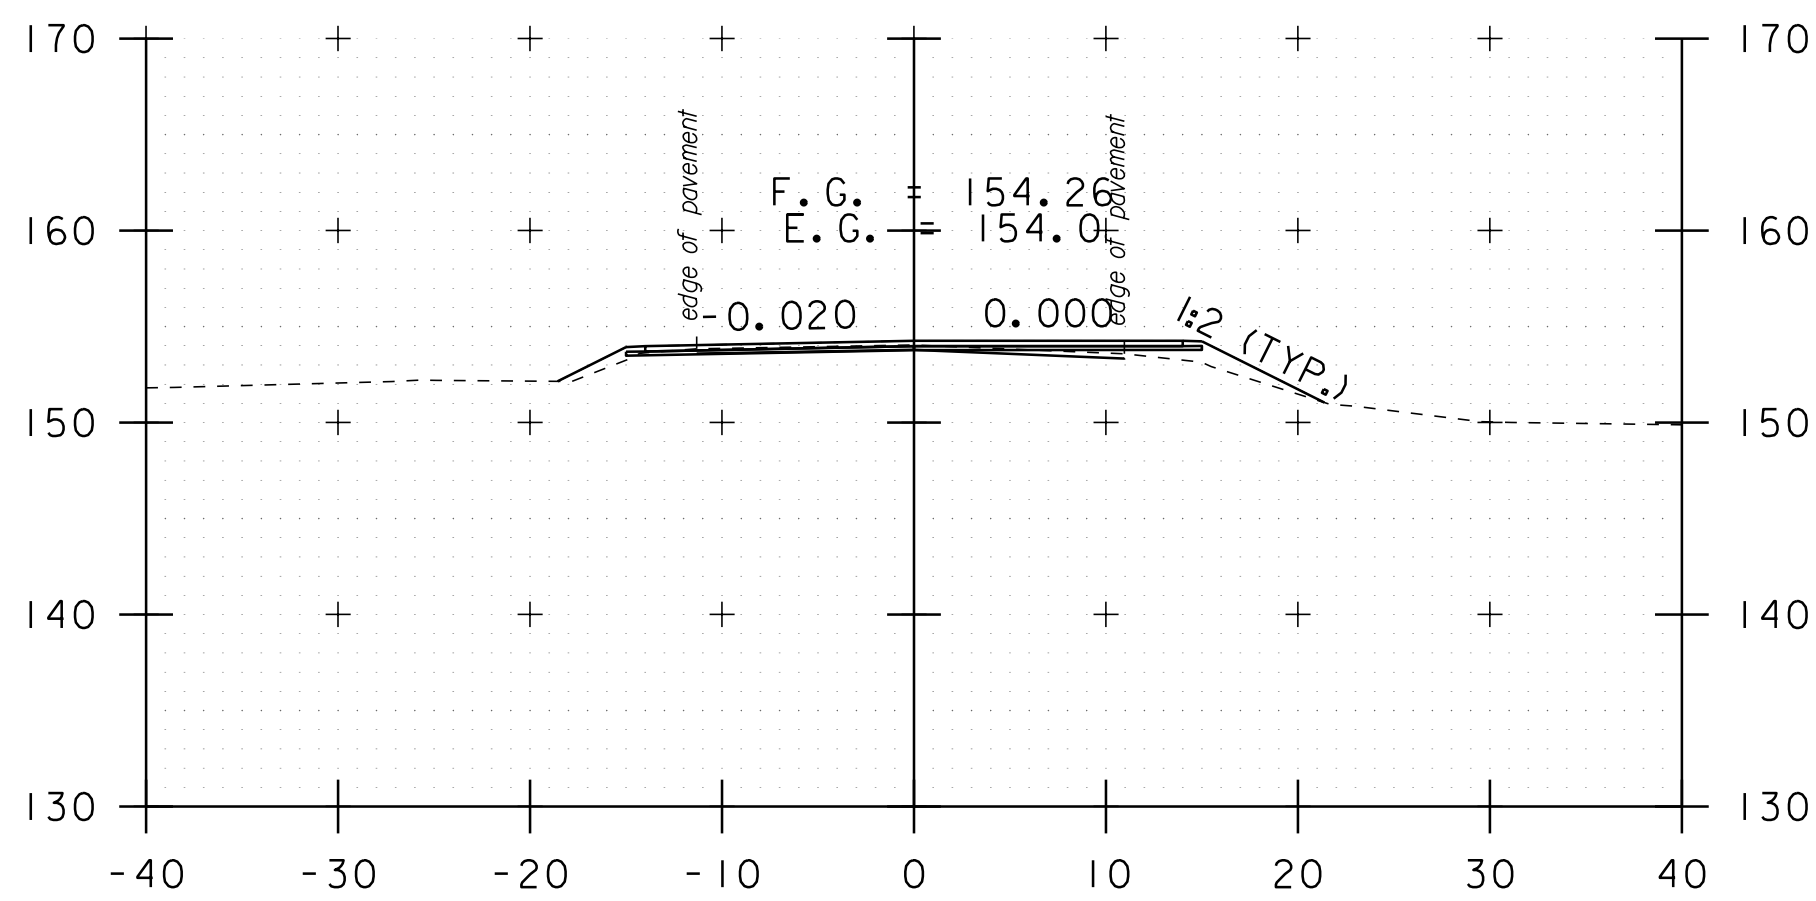


a 4+65

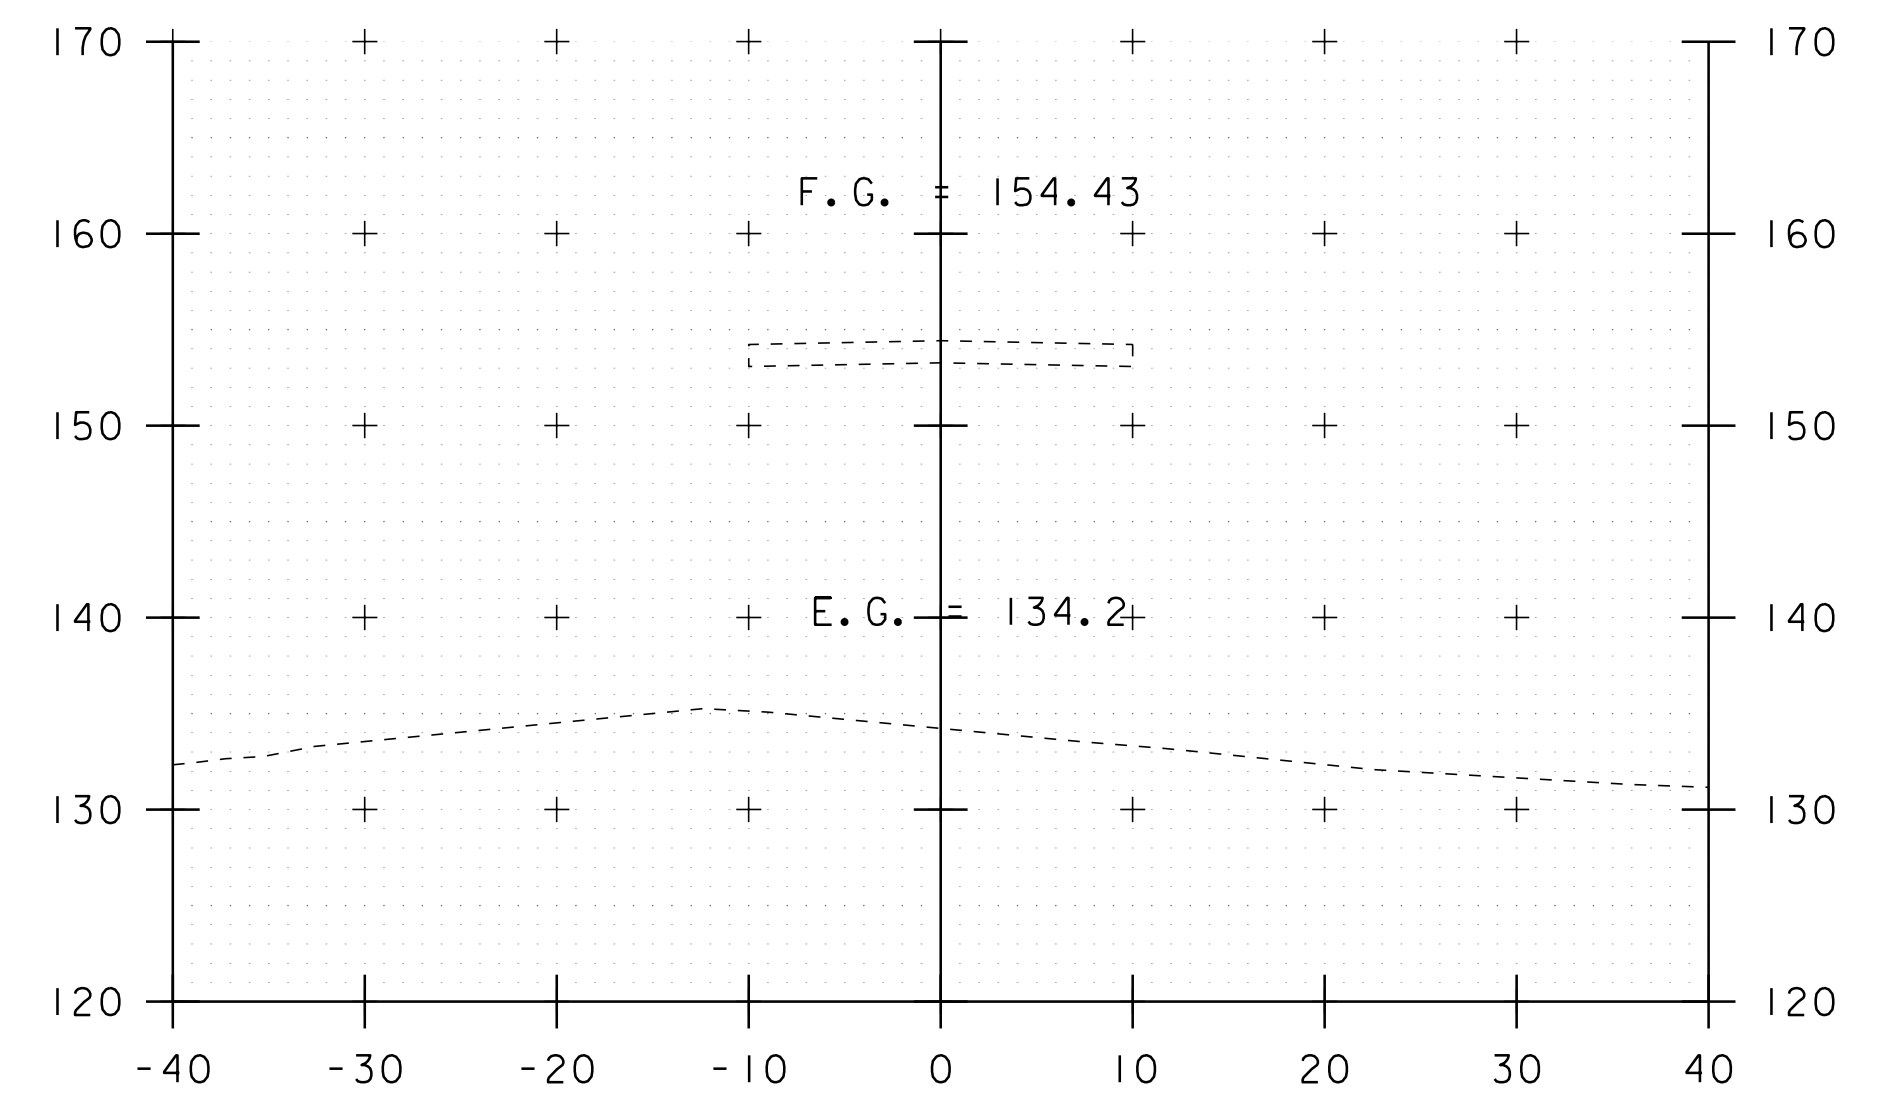


a 11+00
BRIDGE SECTION

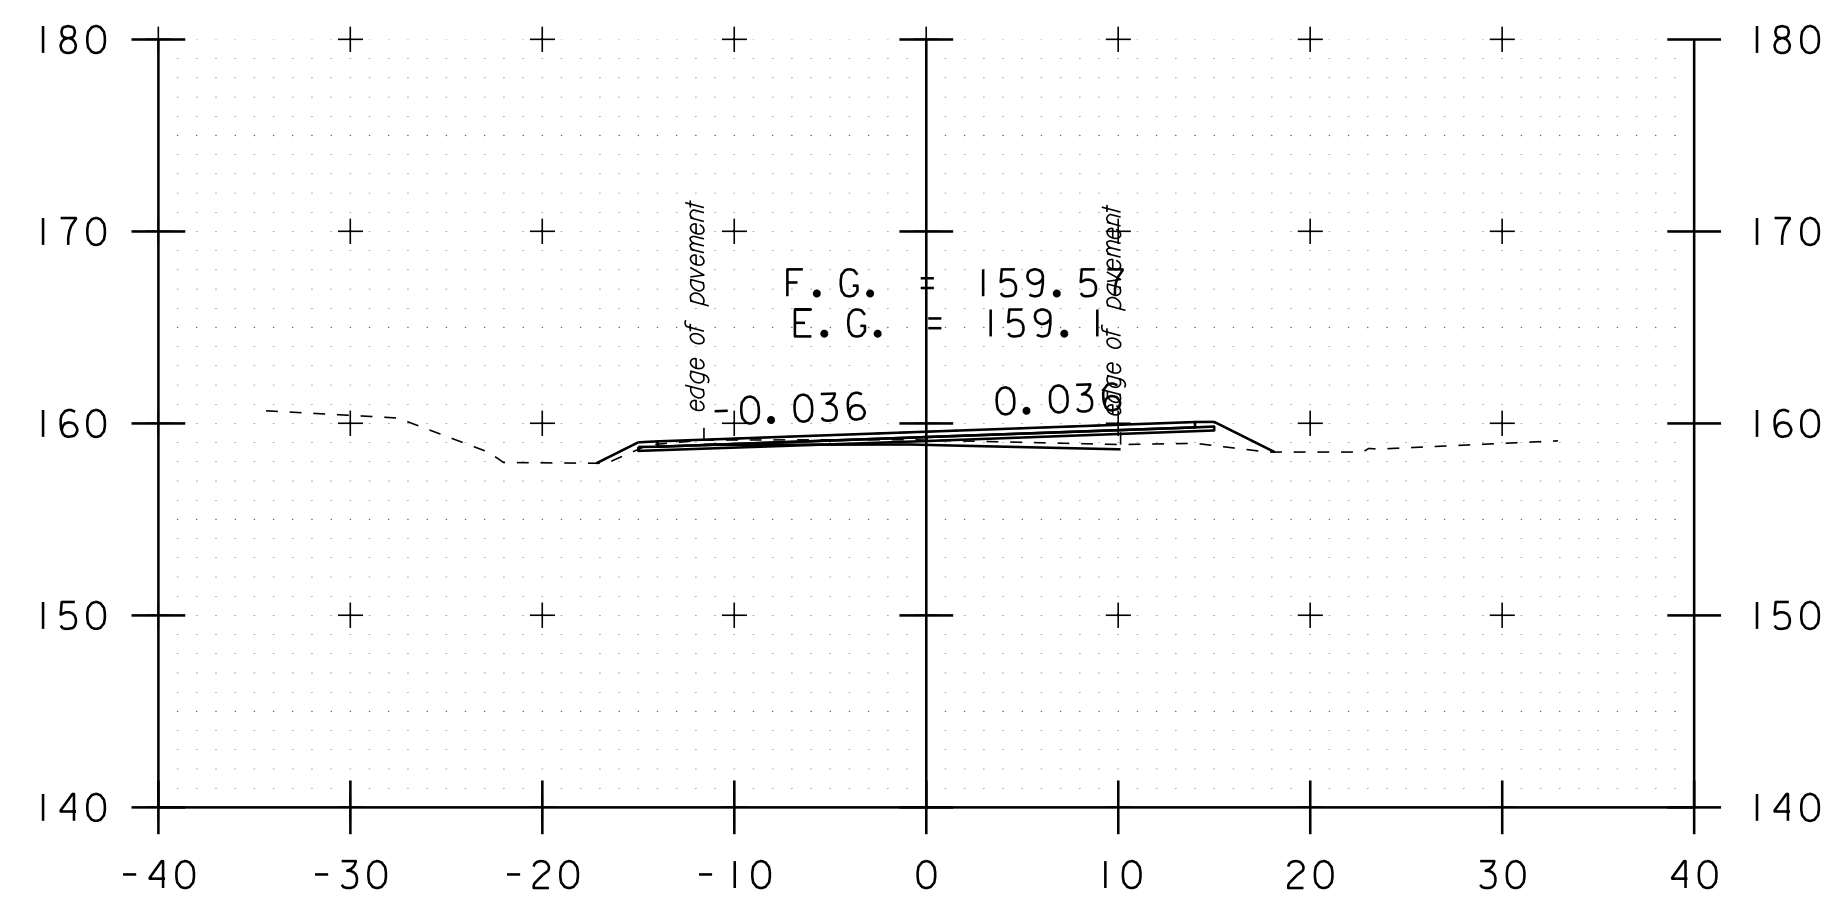


a 3+00

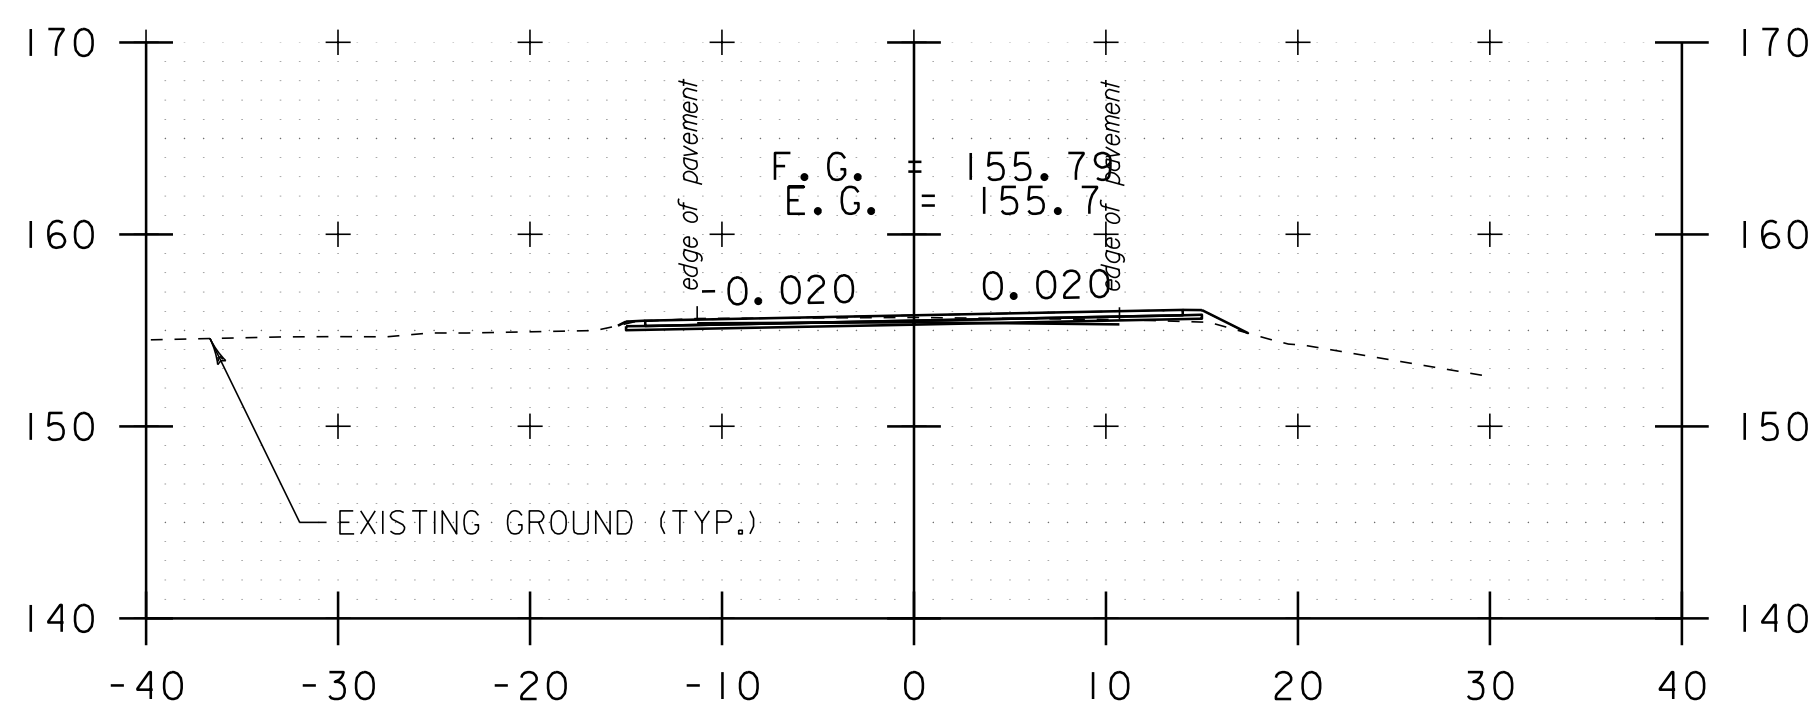


a 3+87

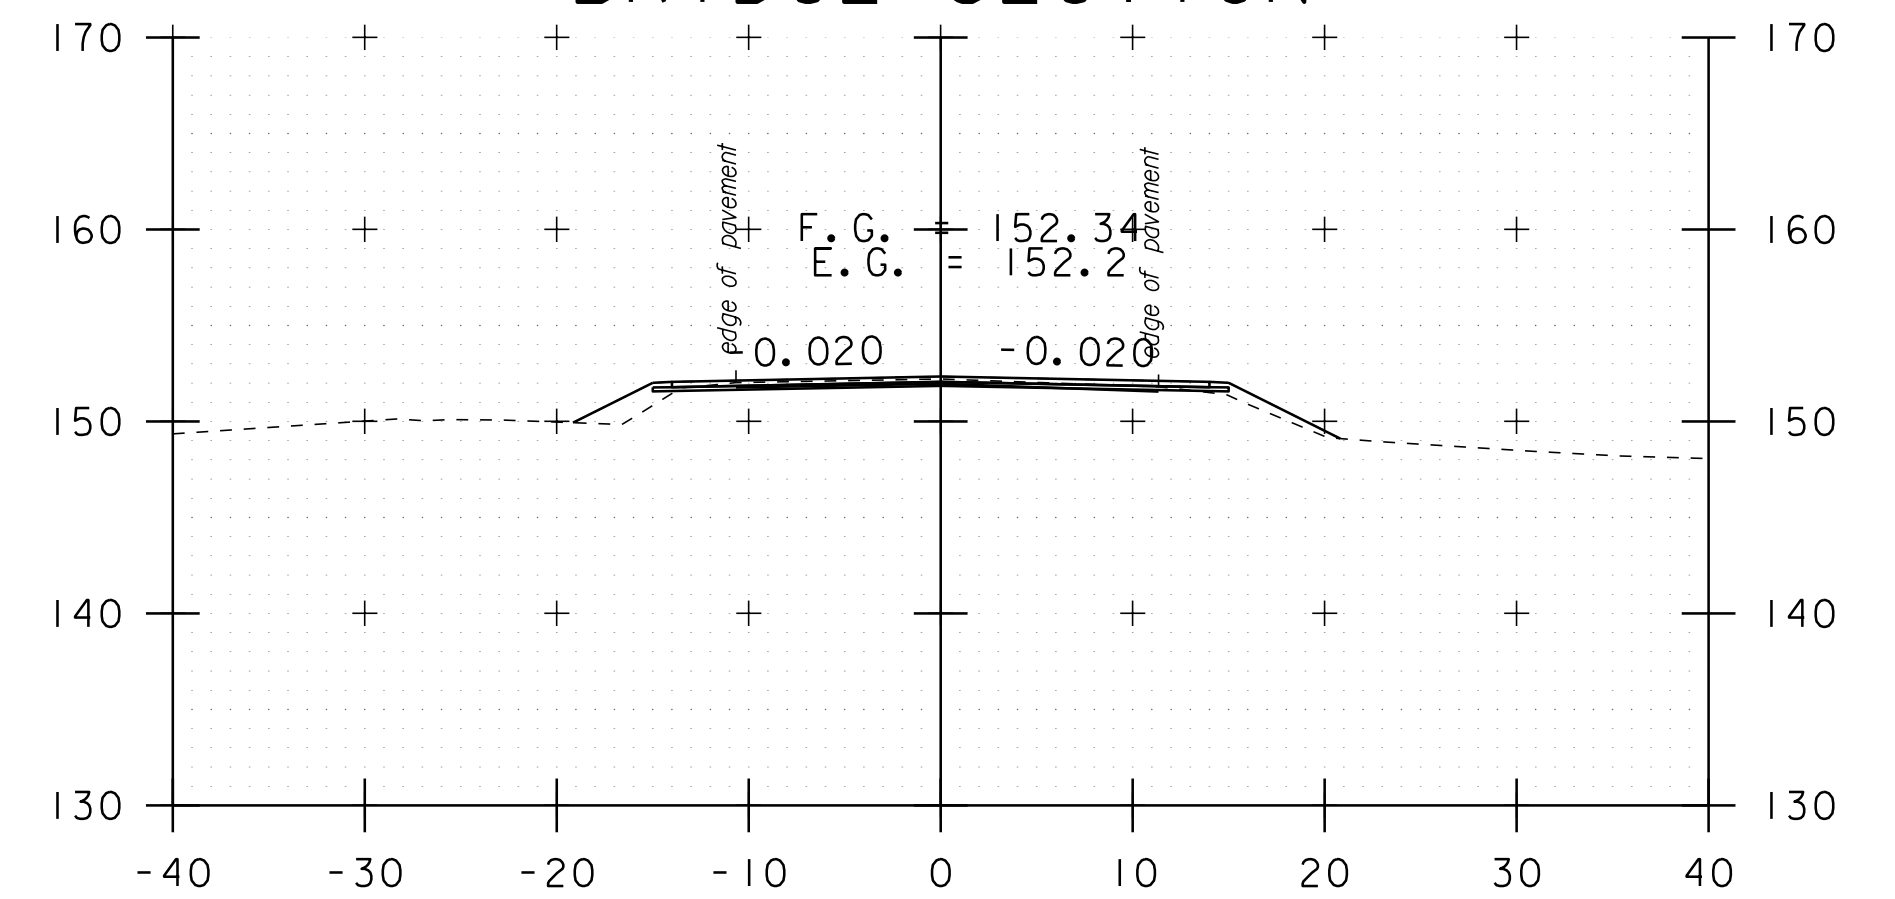


a 6+00

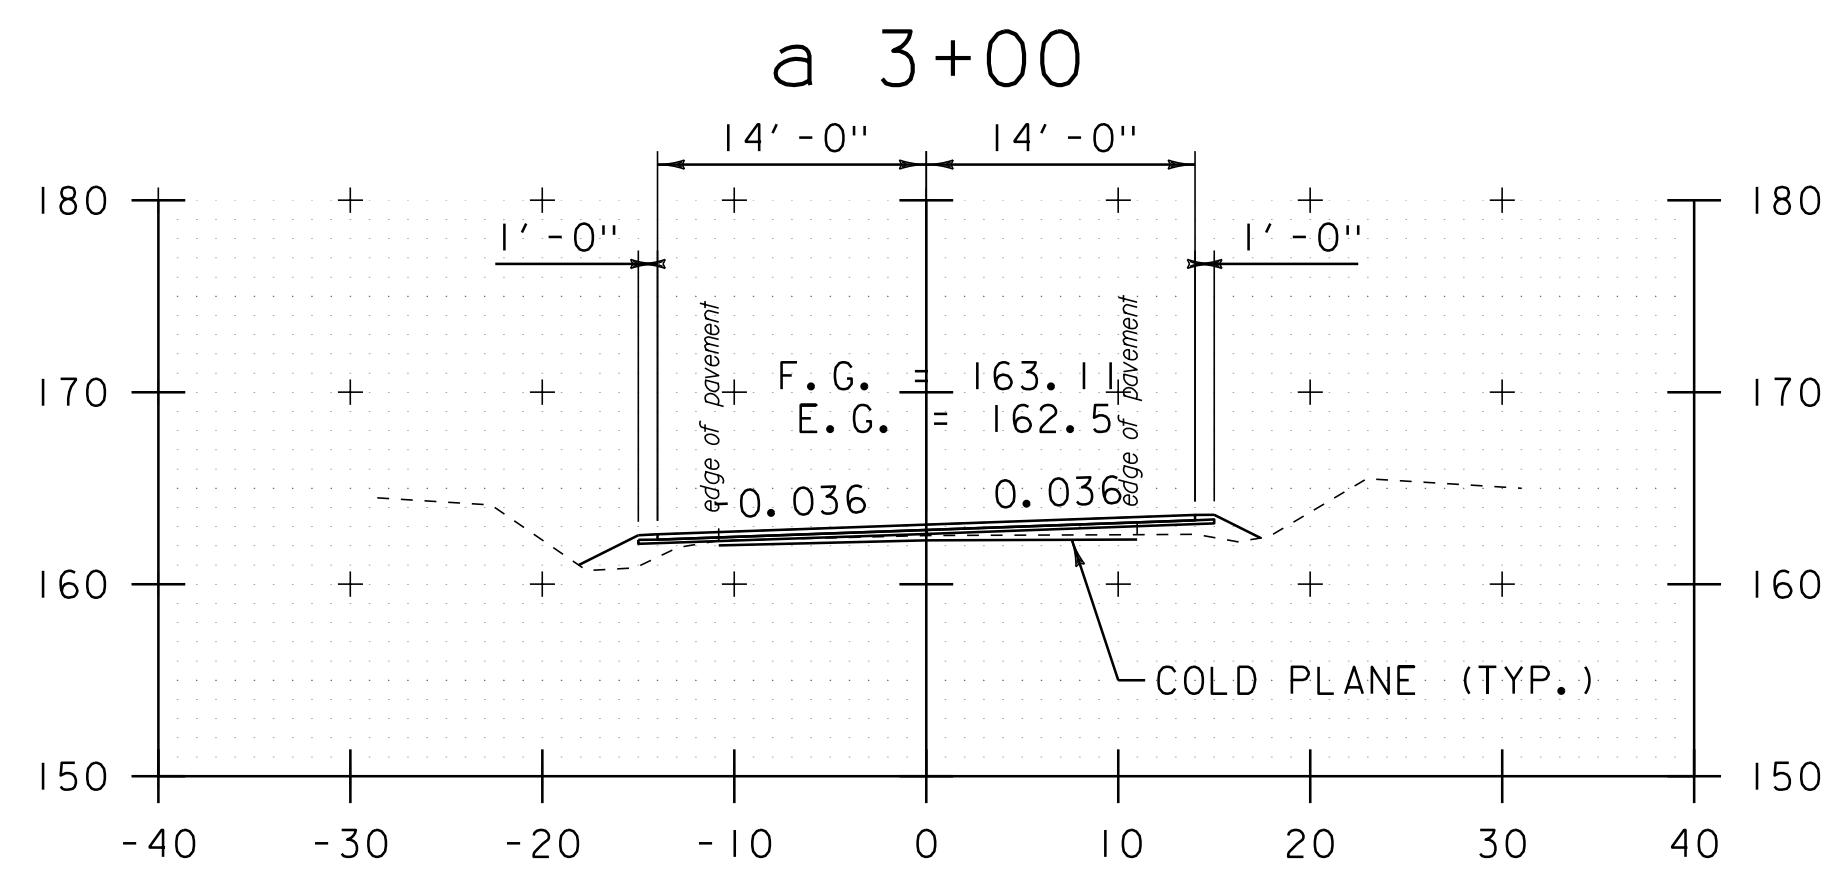

a 2+50

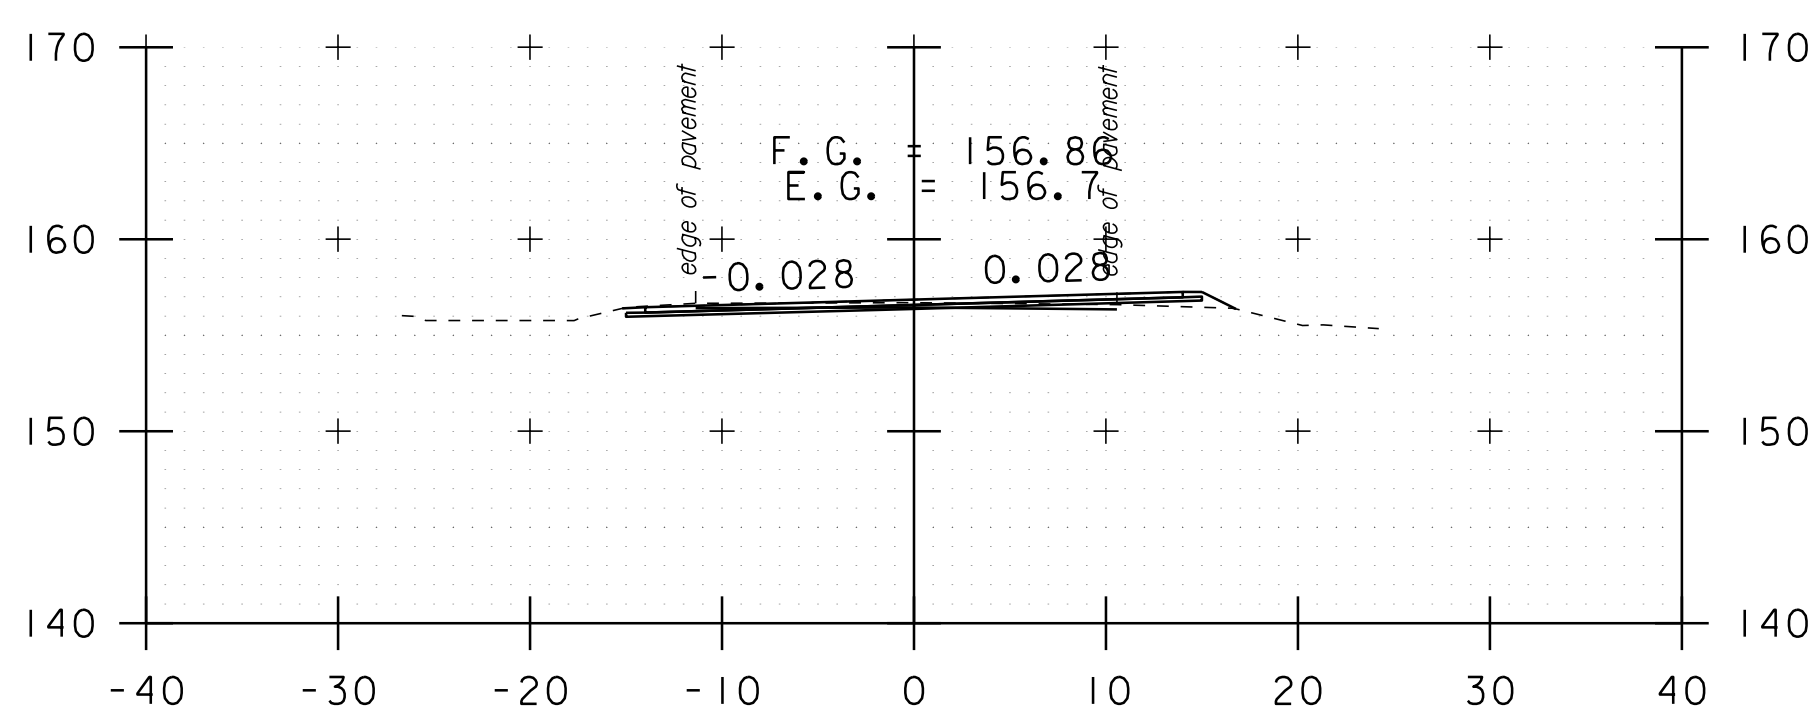


a 3+54

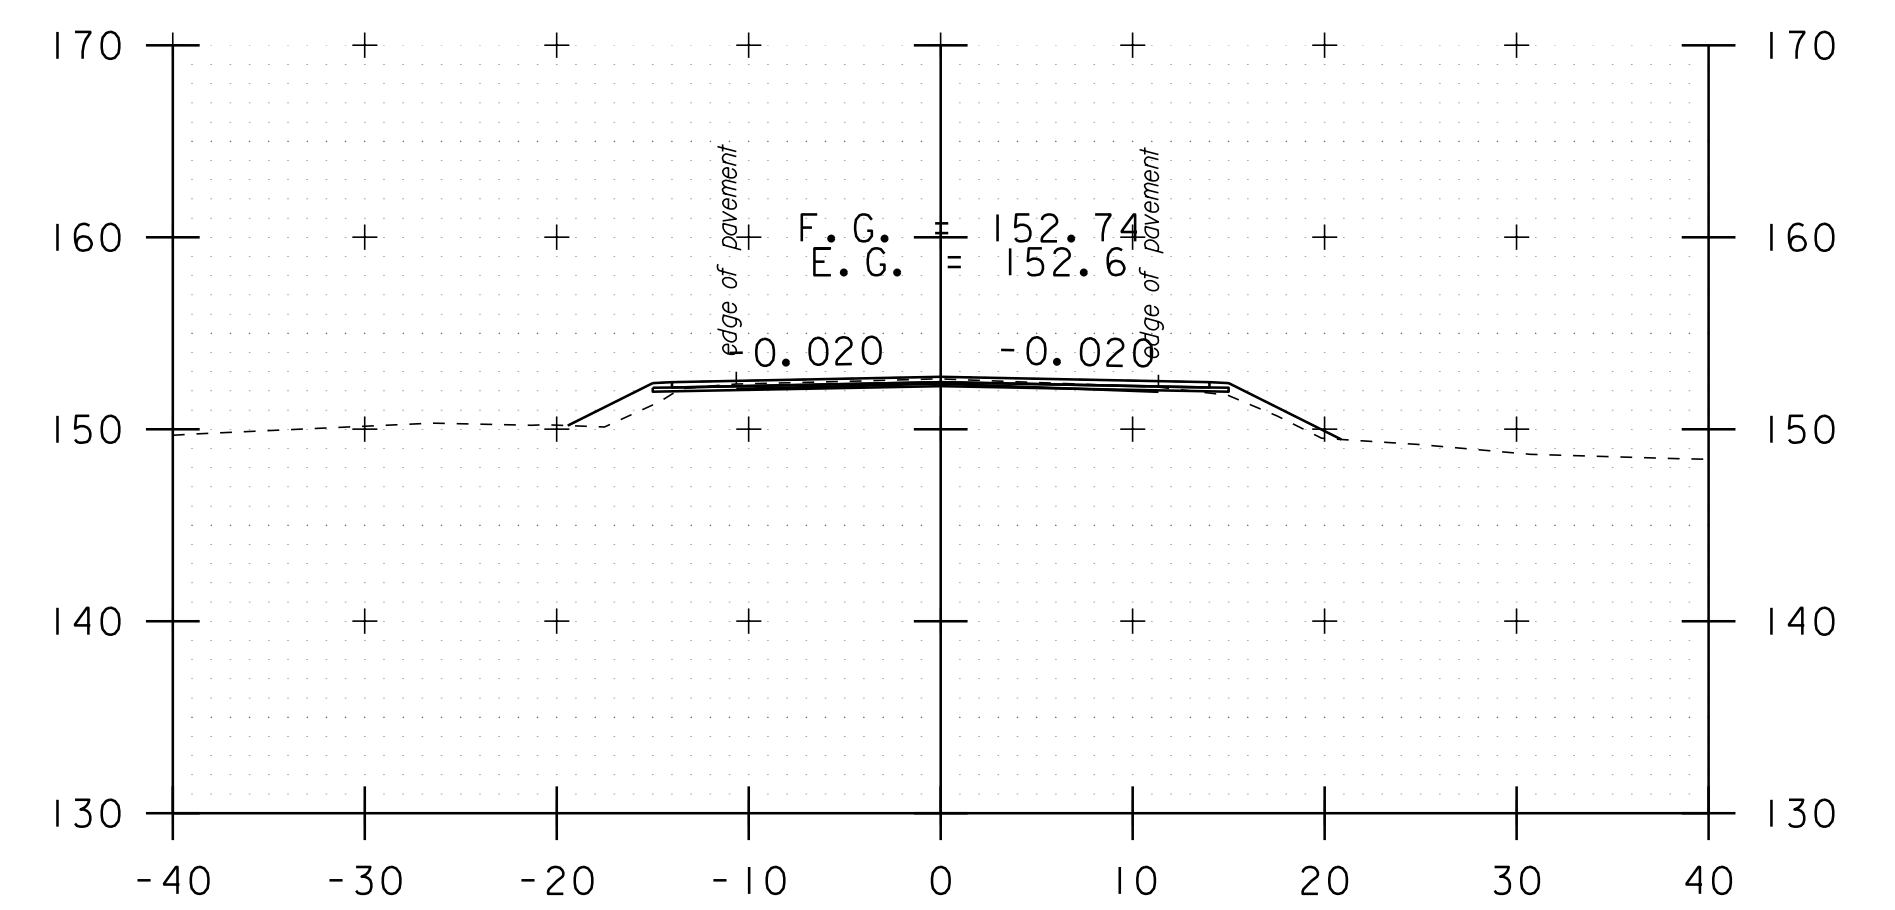

a 5+65

DATUM	NAVD 88
	NAD 83

STA. a 2+50 TO STA. a 11+00

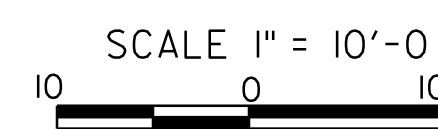

CROSS SECTION SHEET 21

PROJECT NAME: ADDISON-NEW HAVEN
PROJECT NUMBER: STP 9632(1)

FILE NAME: p95B076.dgn
PROJECT LEADER: CDL
DESIGNED BY: SJL
PLOT FILE: p95B076_I26.1

PLOT DATE: 3/13/2012
DRAWN BY: SJL
CHECKED BY: EPD
SHEET 126 OF 186