




b 19+50

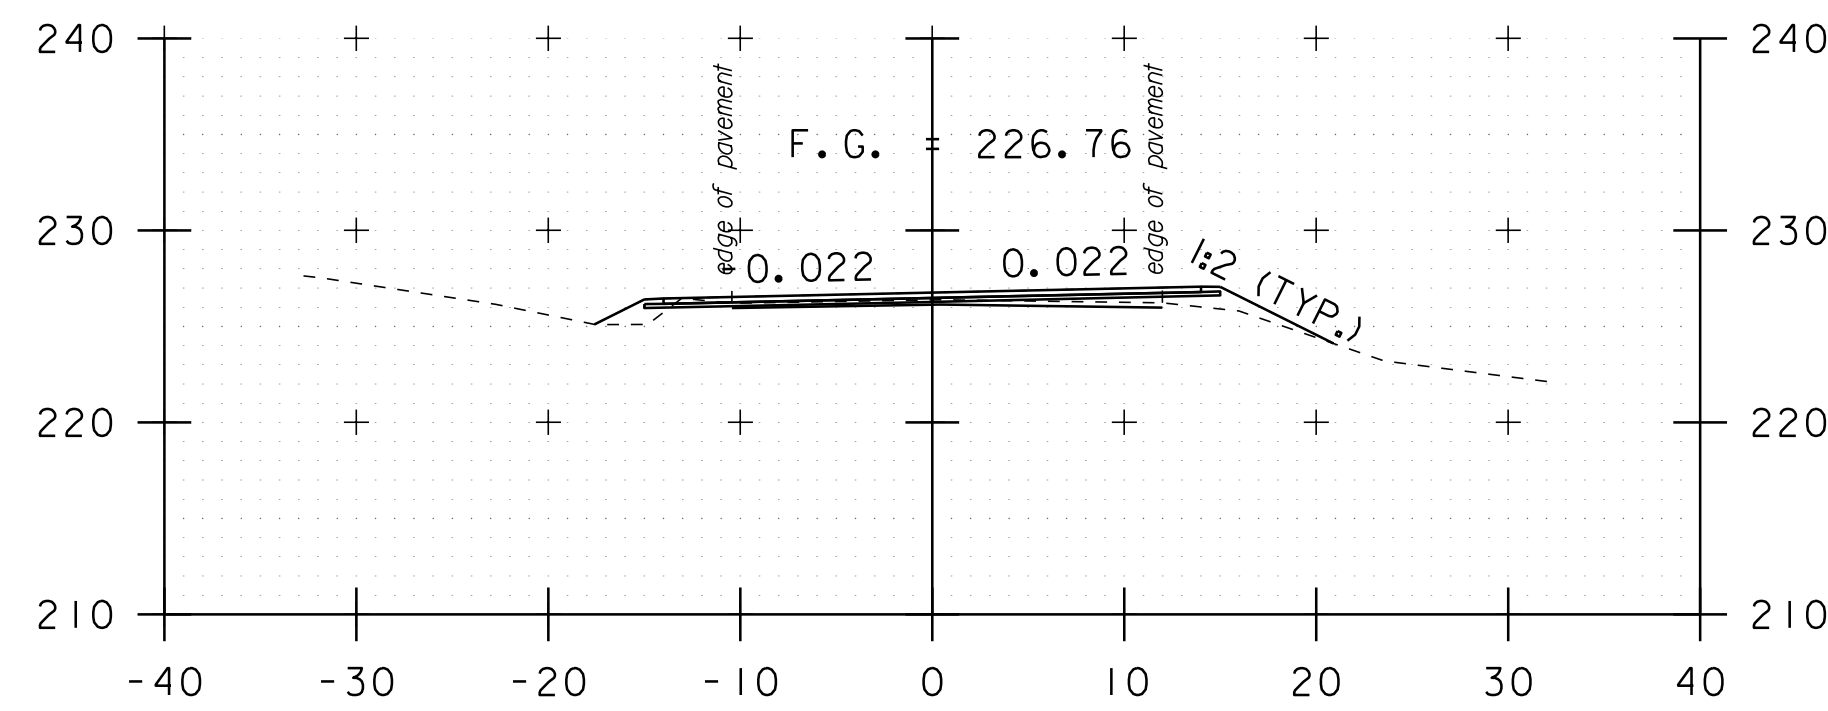


b 19+00

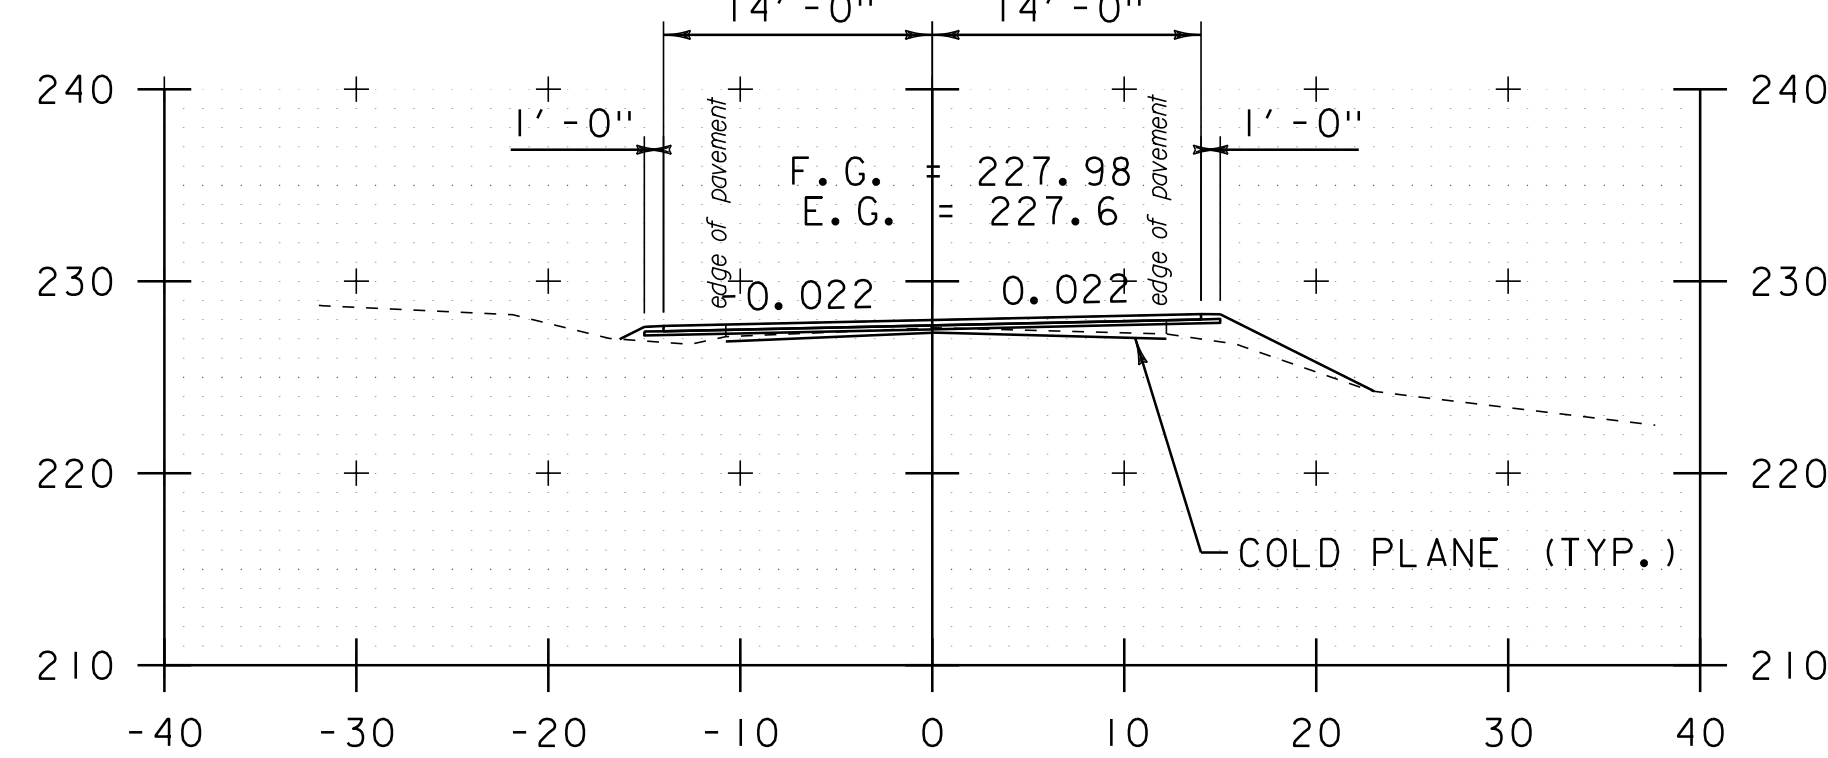


b 18+50

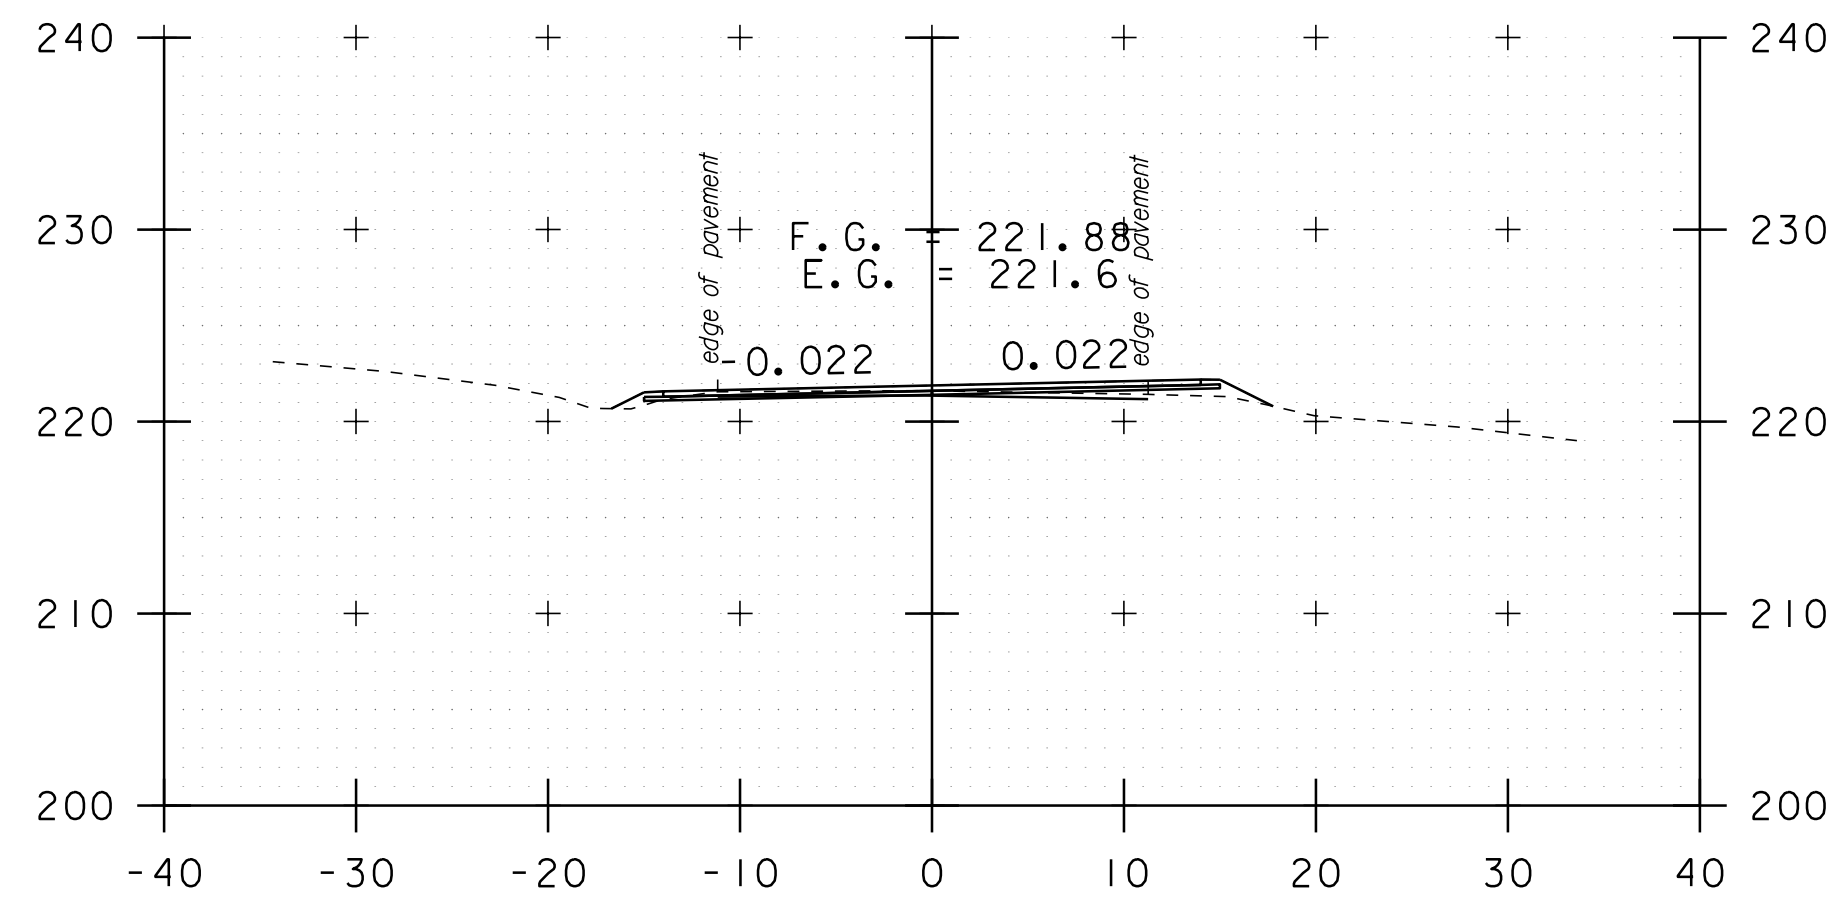


b 21+00

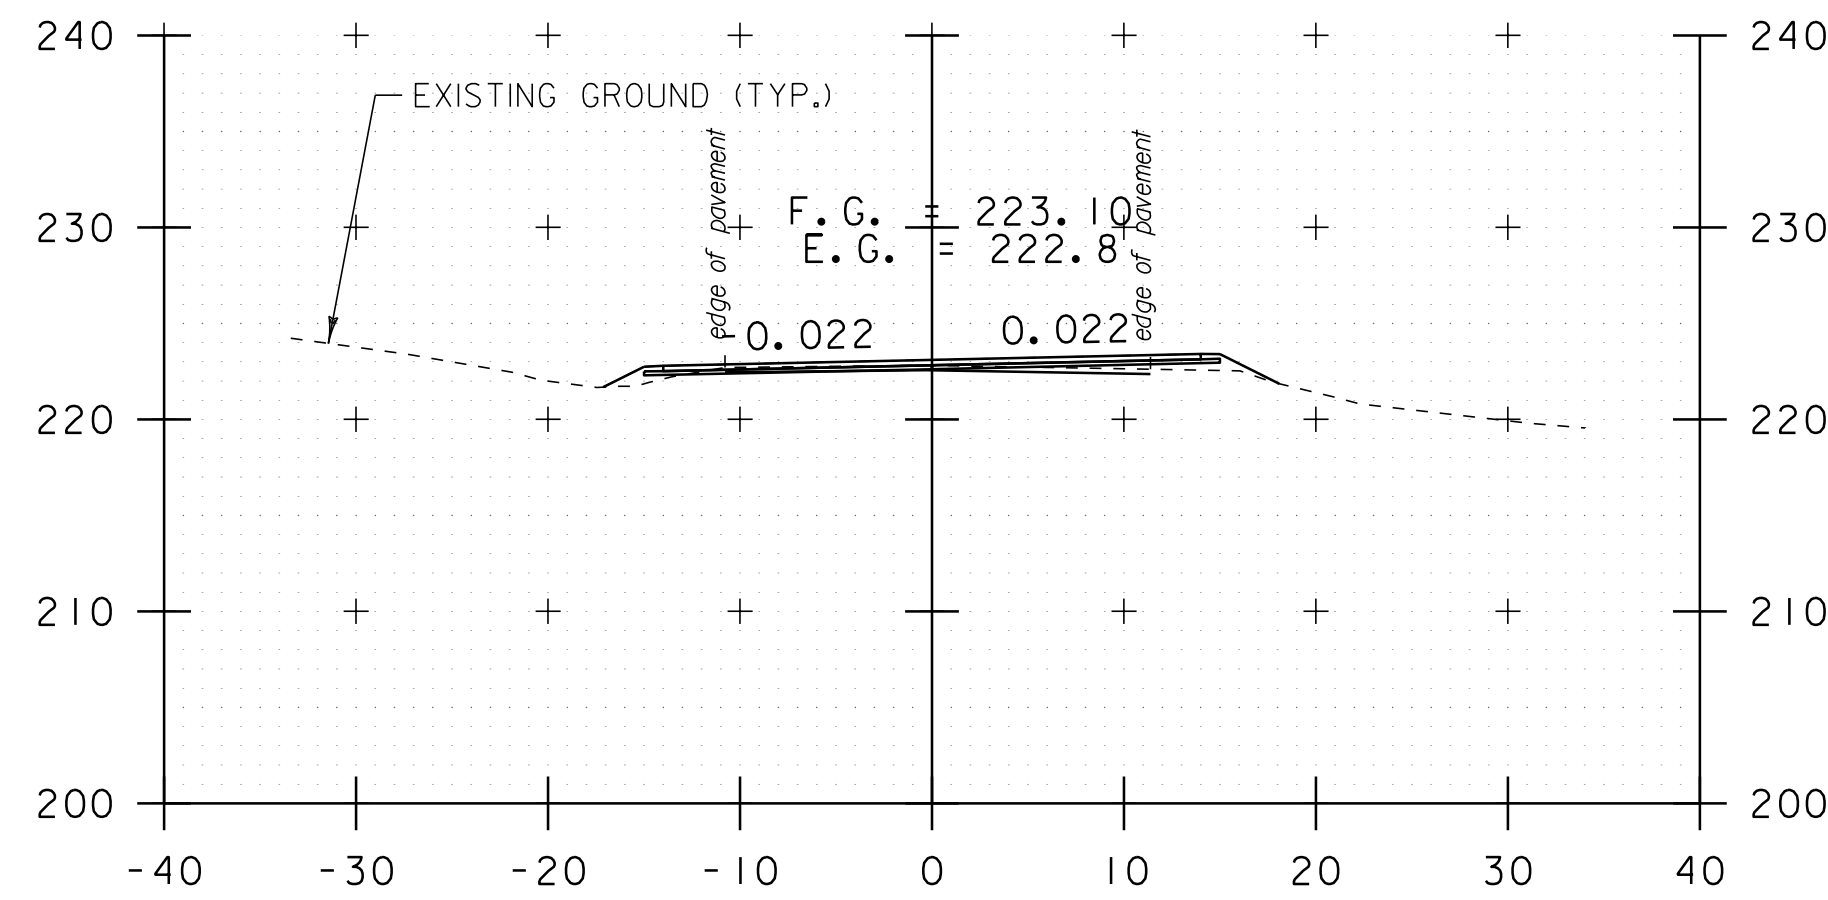


b 20+50

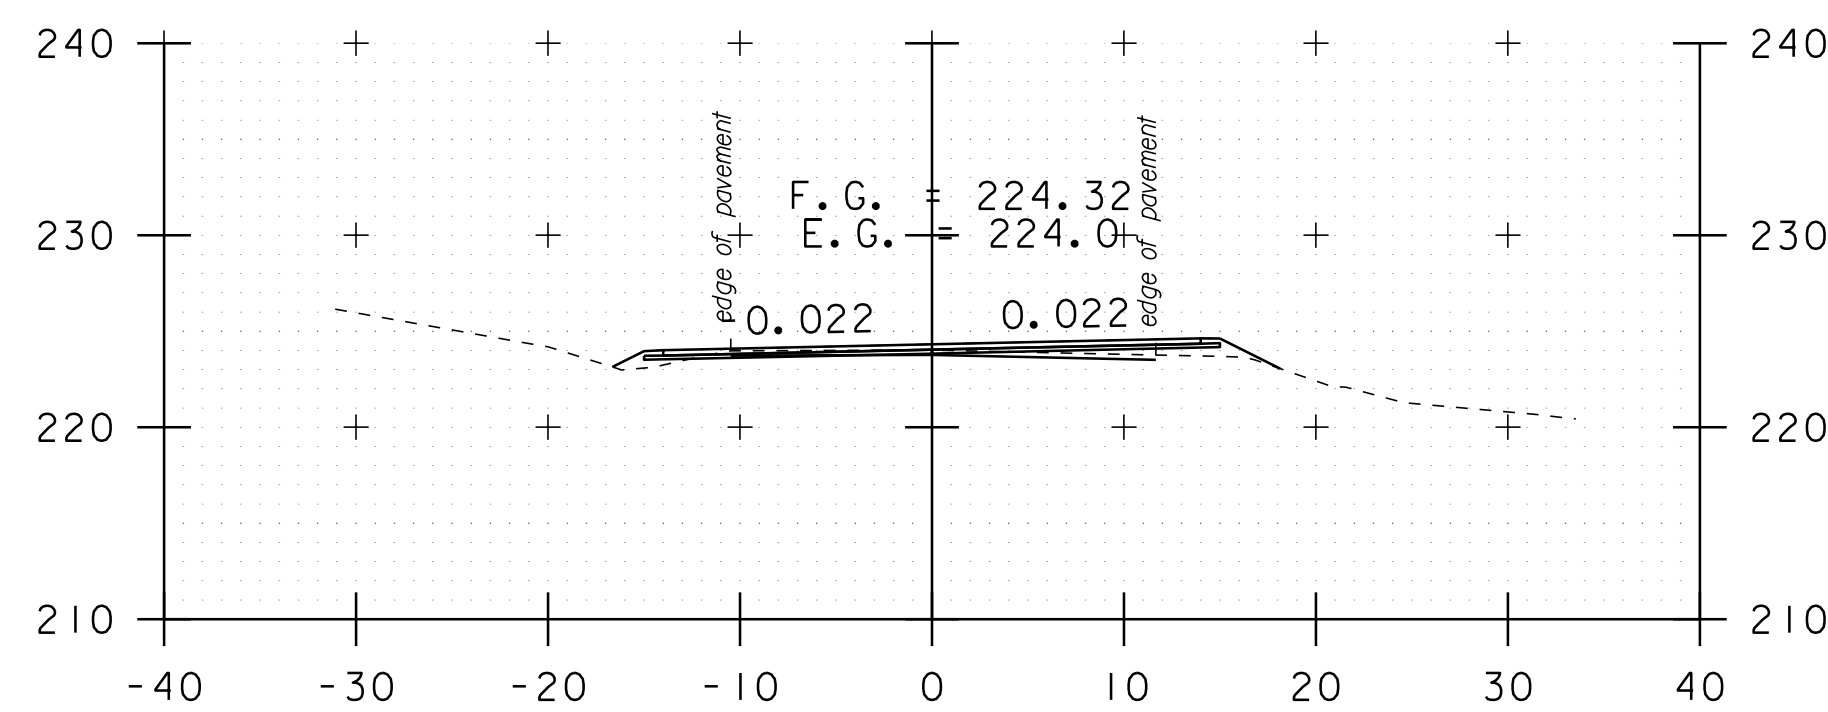


b 20+00

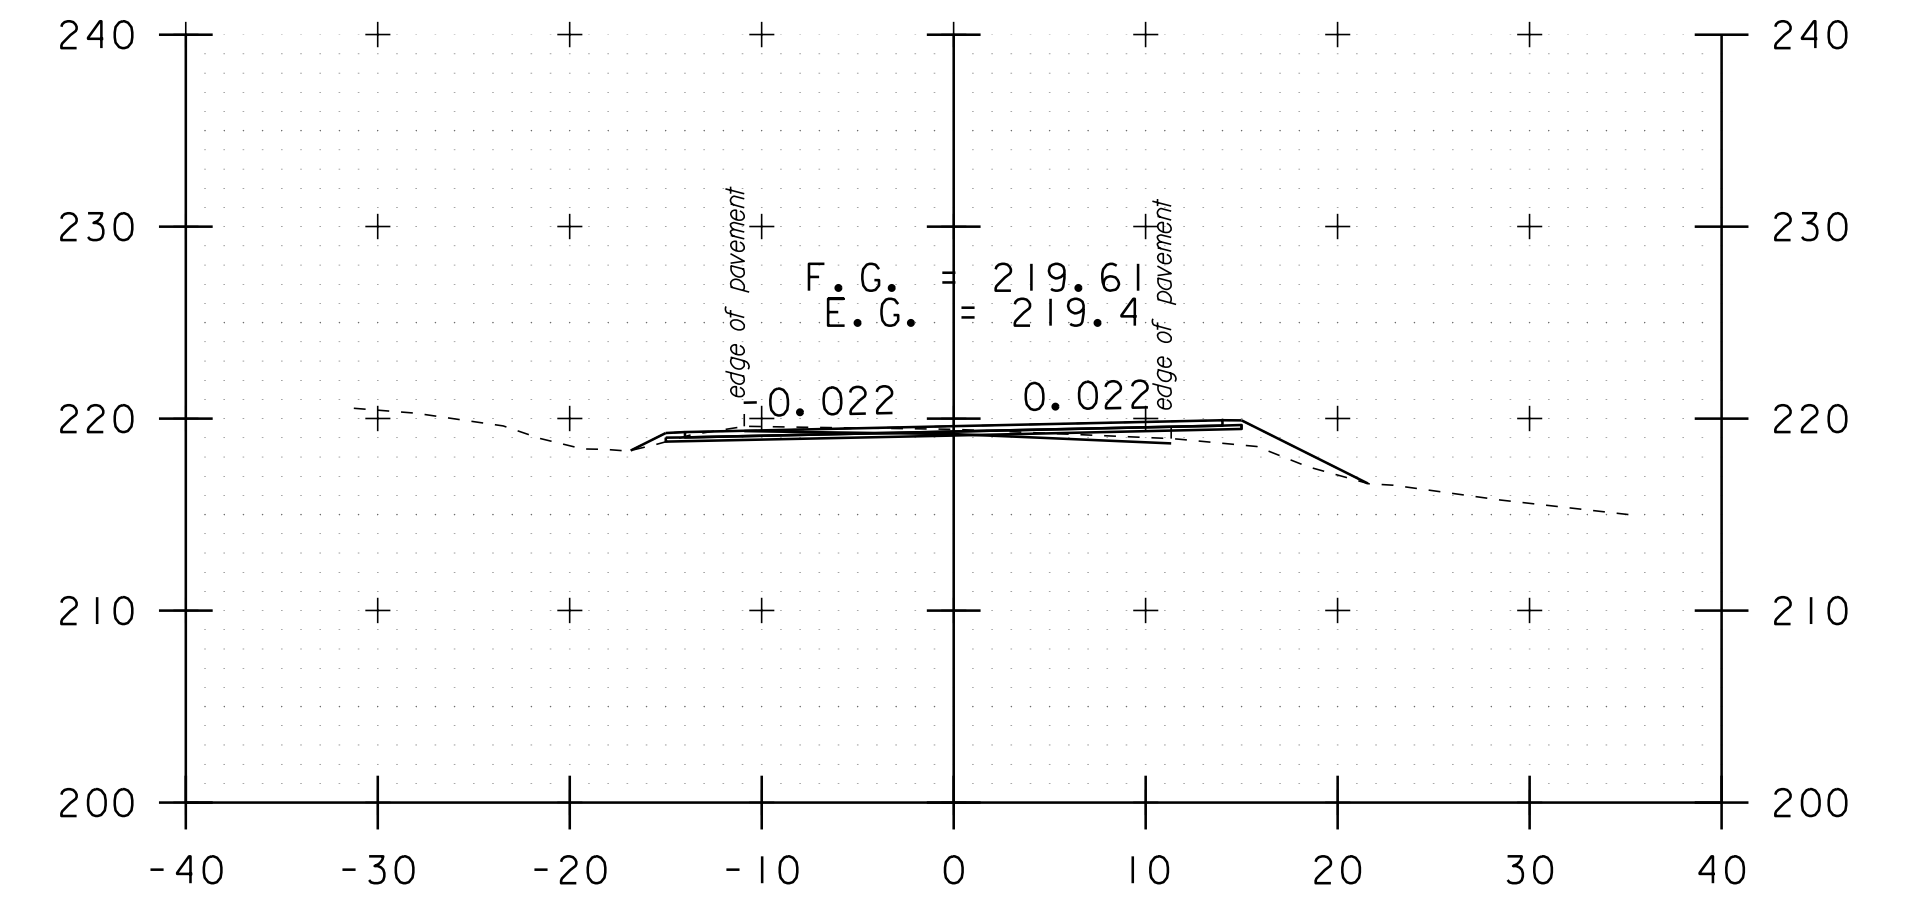

b 22+00

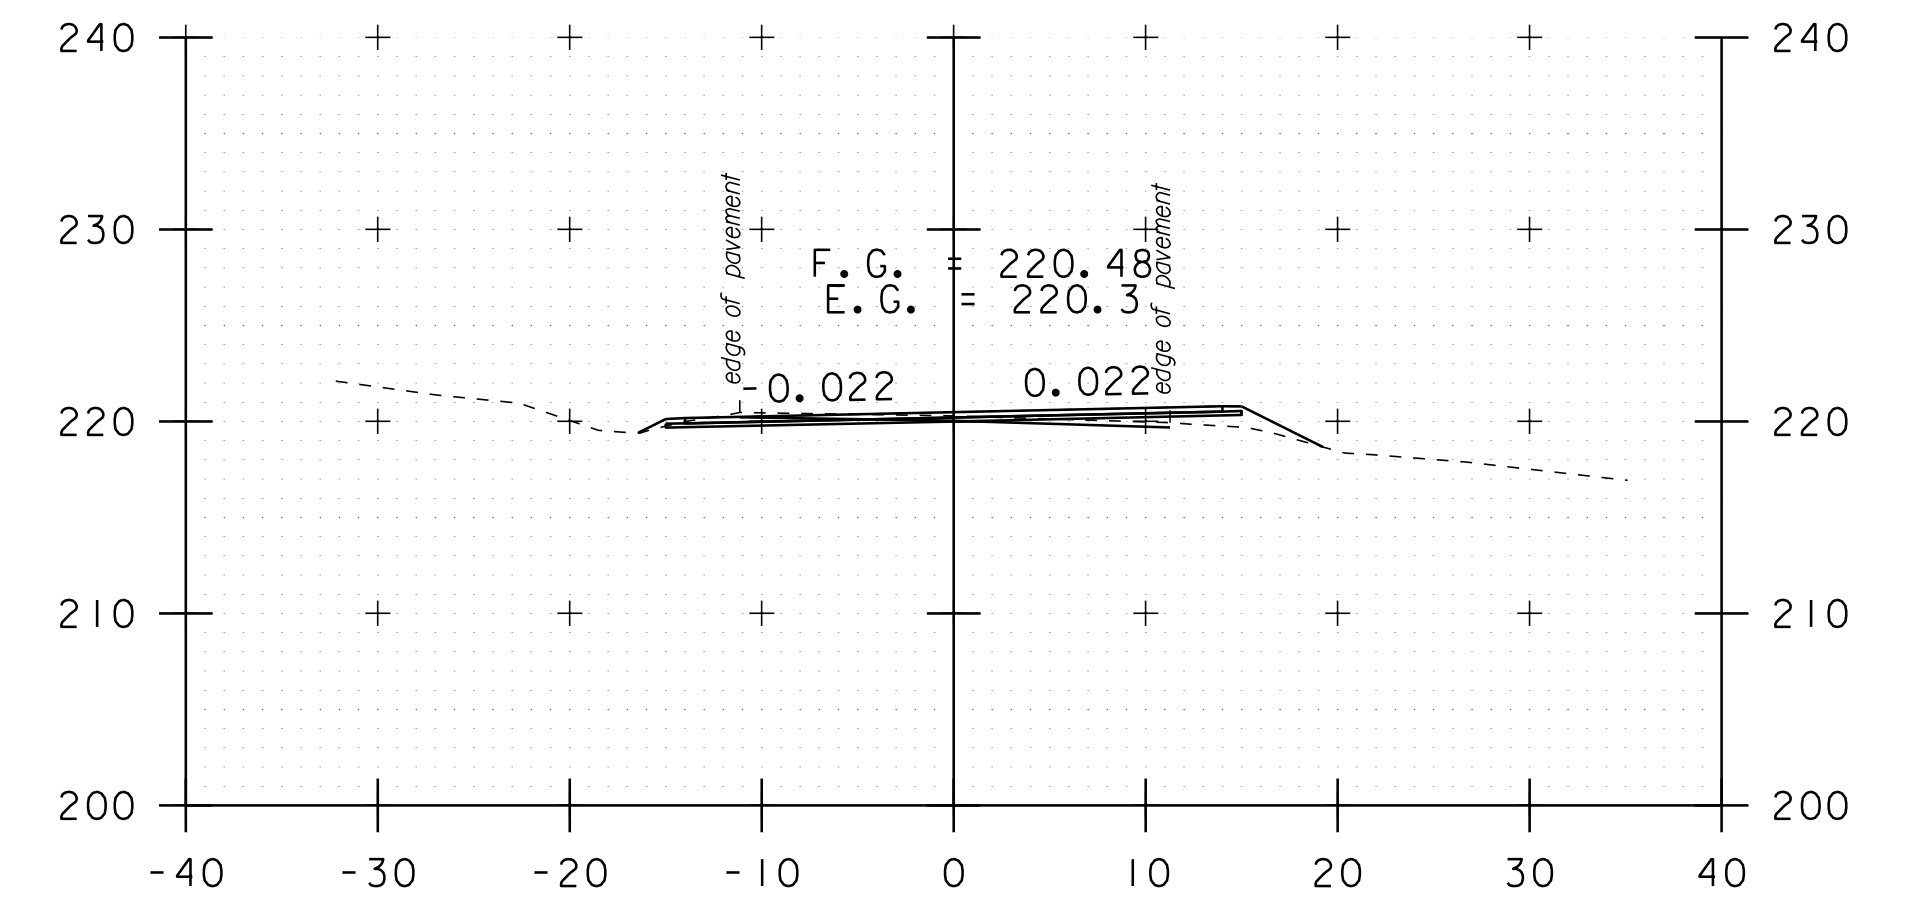


b 21+58

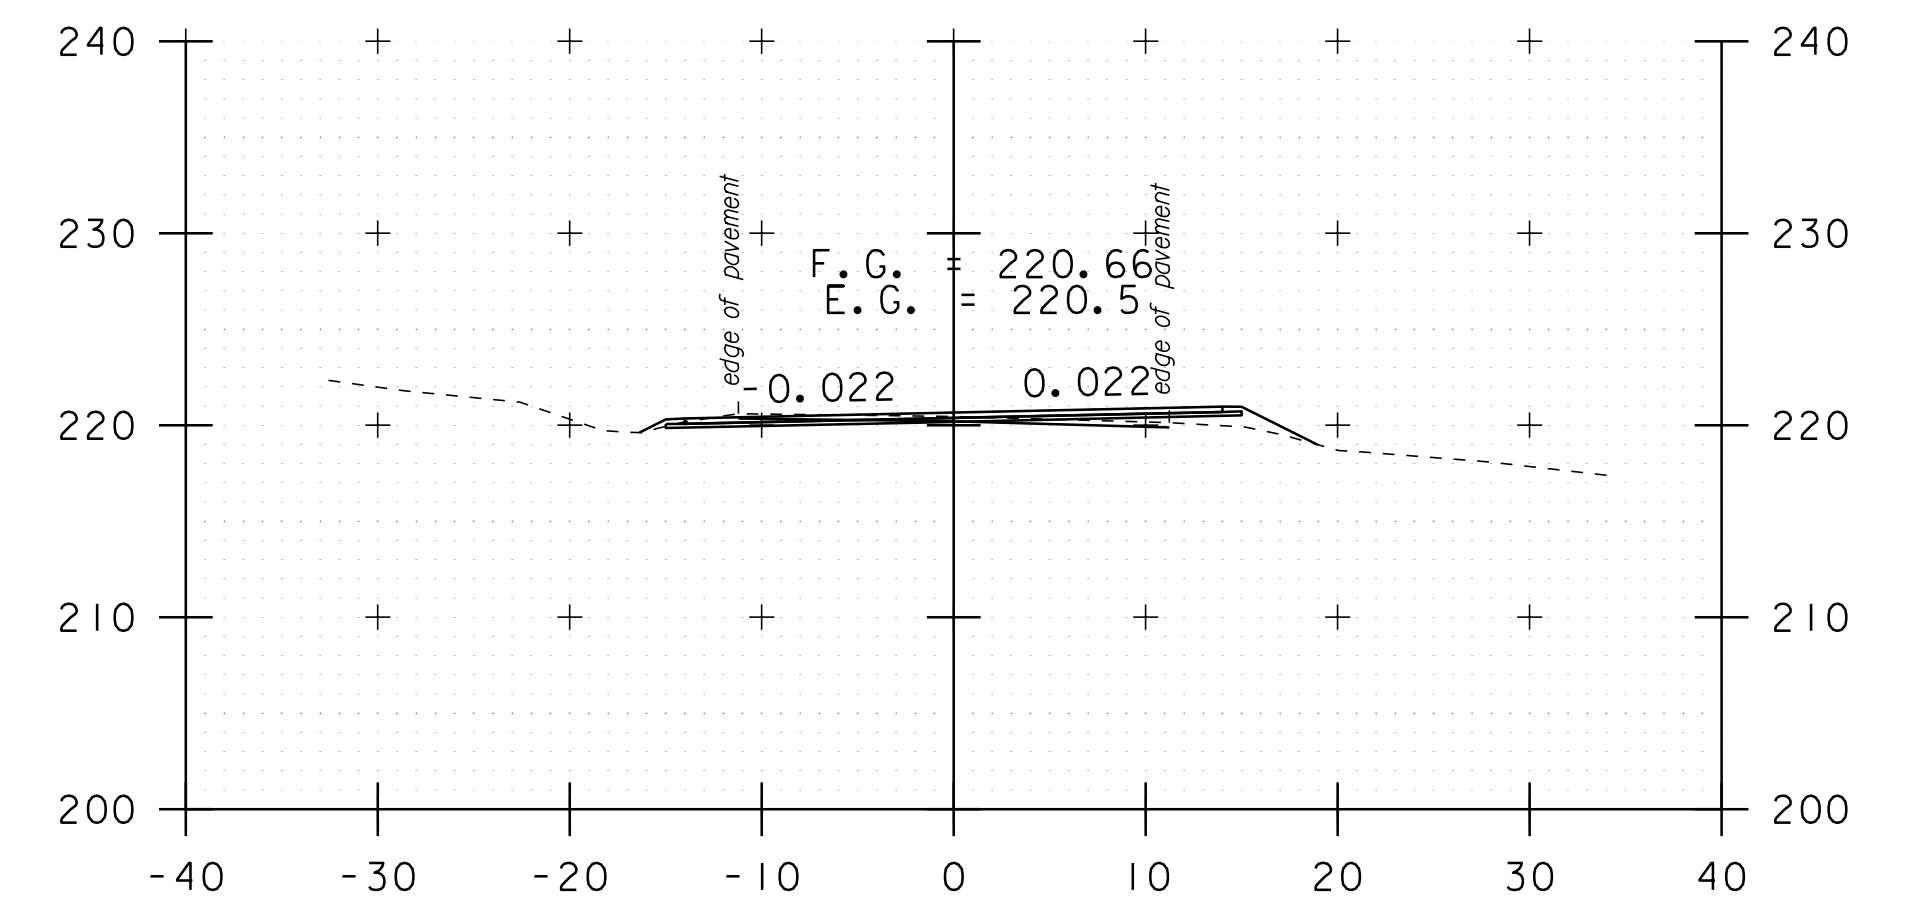

b 21+50

DATUM	NAVD 88
	NAD 83

STA. b 18+50 TO STA. b 22+00

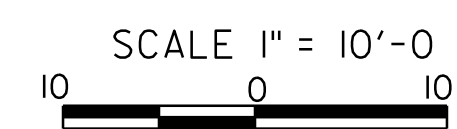

CROSS SECTION SHEET 26

PROJECT NAME: ADDISON-NEW HAVEN
PROJECT NUMBER: STP 9632(1)

FILE NAME: p95B076.dgn
PROJECT LEADER: CDL
DESIGNED BY: SJL
PLOT FILE: p95B076_131.I

PLOT DATE: 3/13/2012
DRAWN BY: SJL
CHECKED BY: EPD
SHEET 131 OF 186