




b 23+00

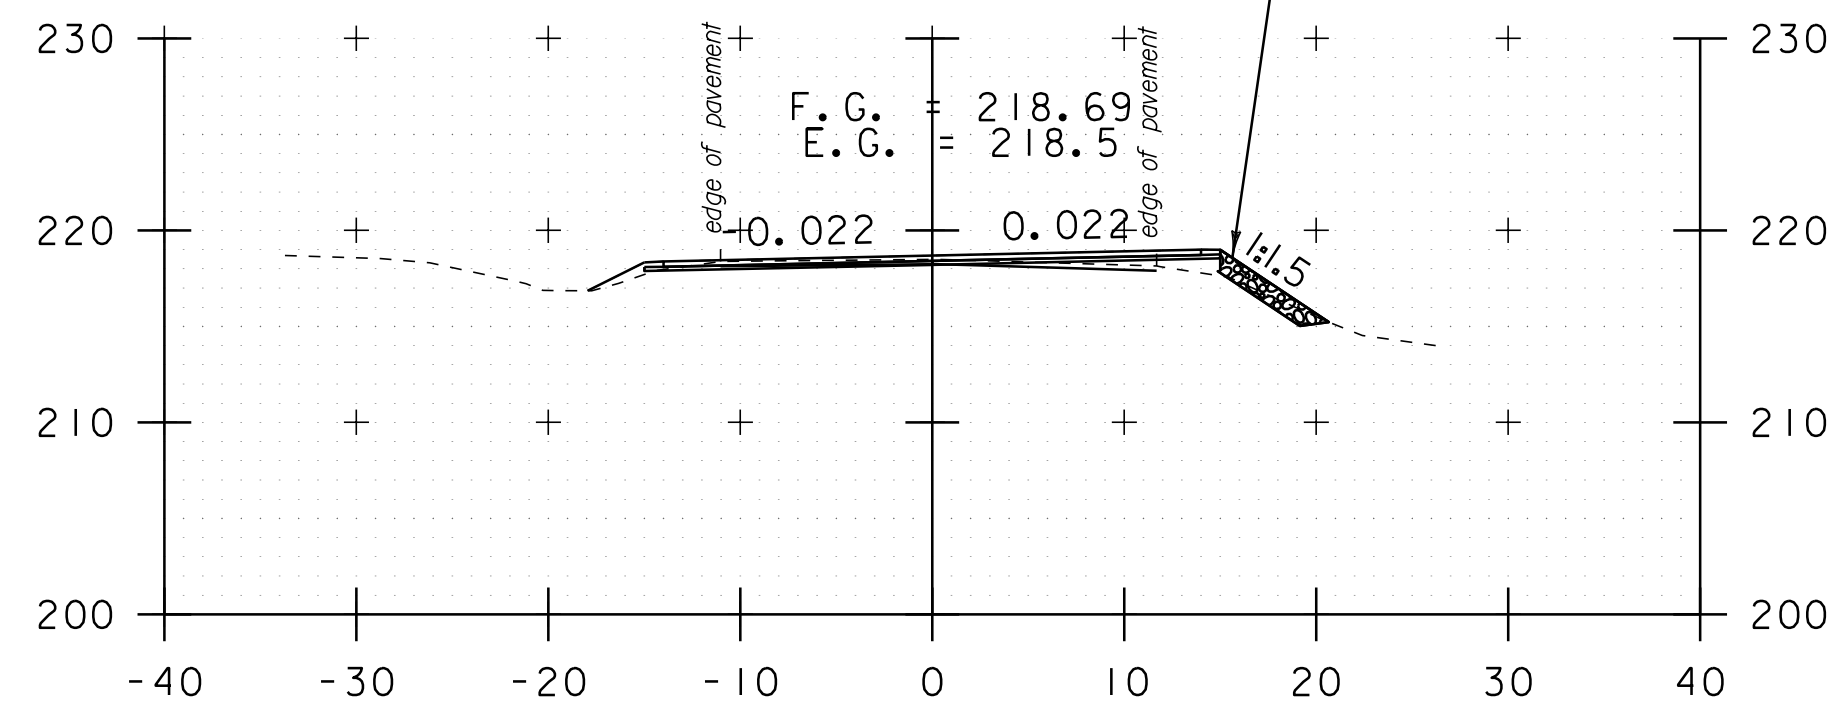


b 22+61

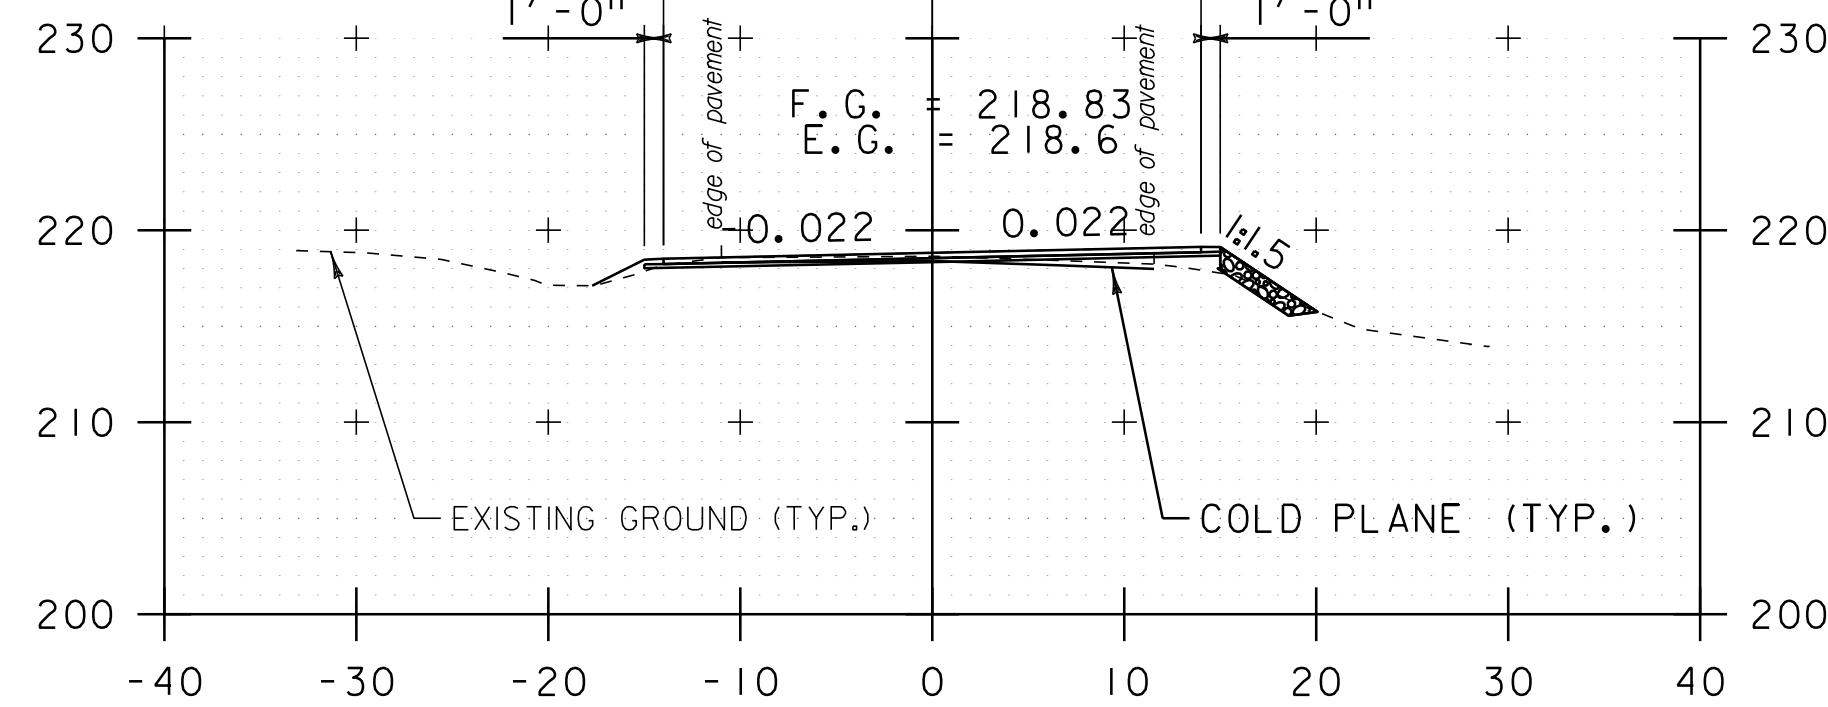


b 22+50

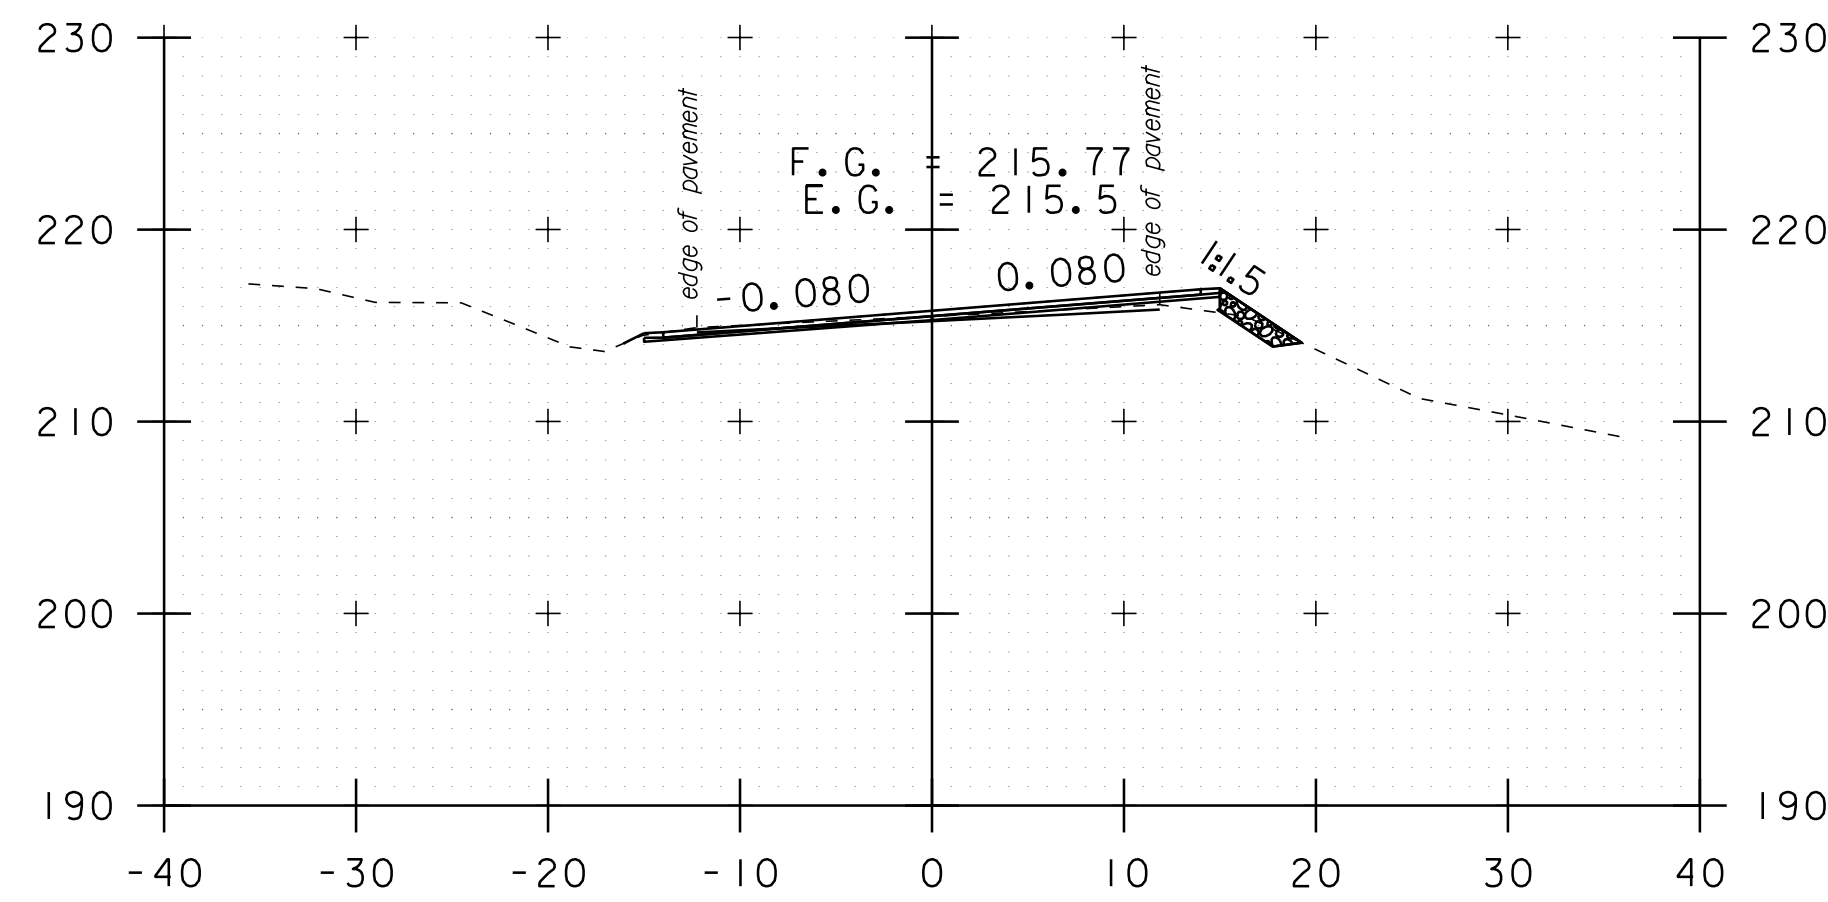


b 24+60

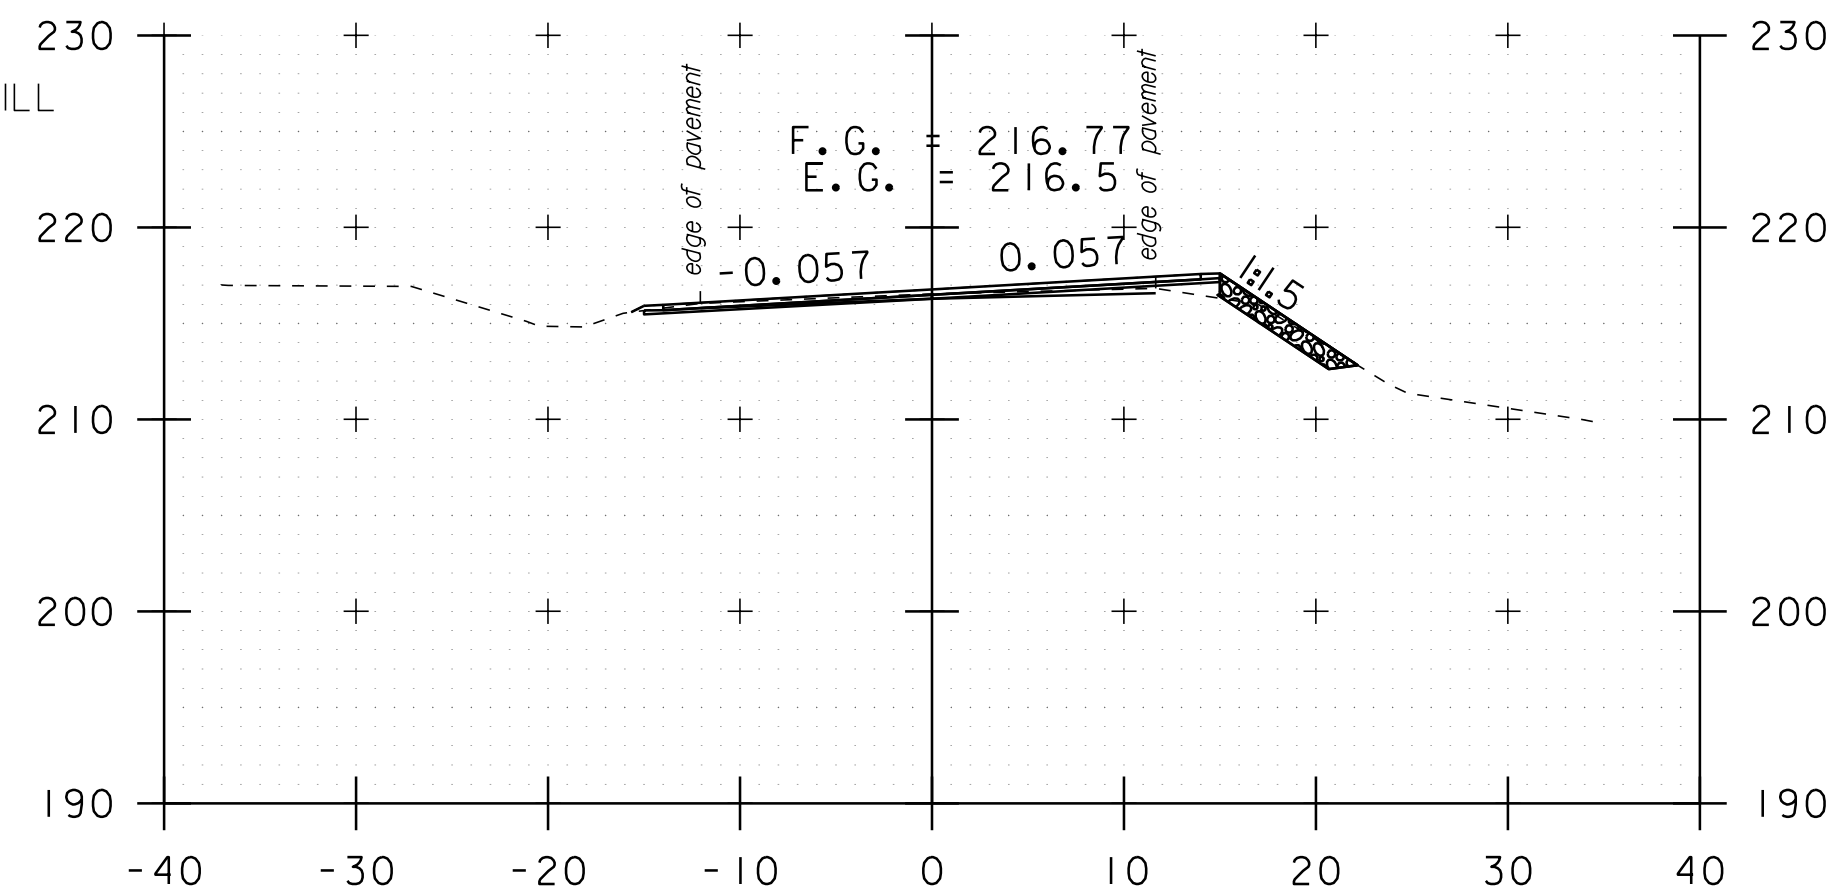


b 24+07

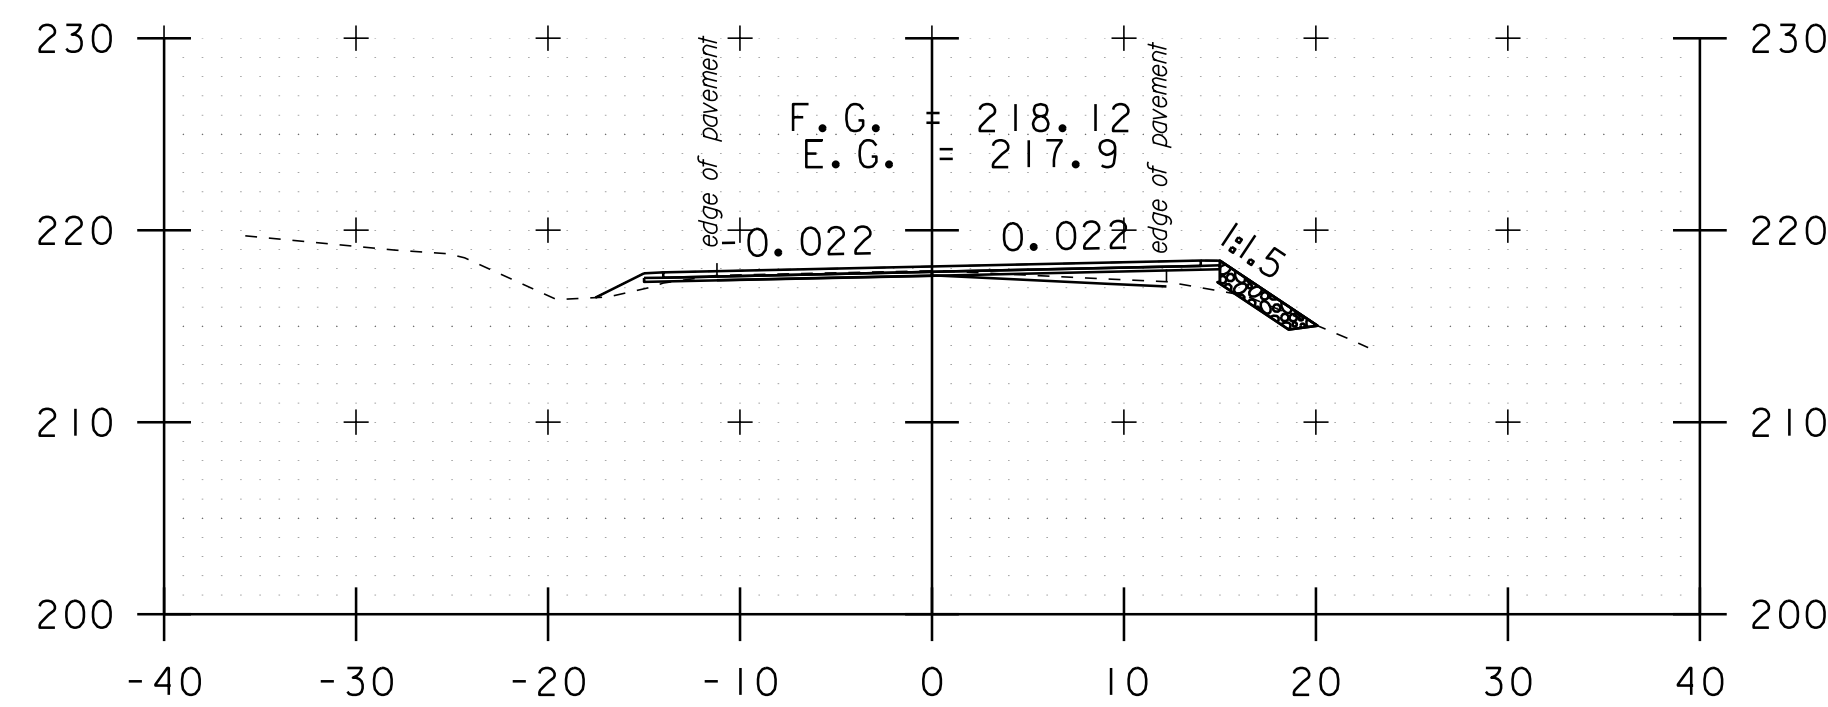


b 23+25

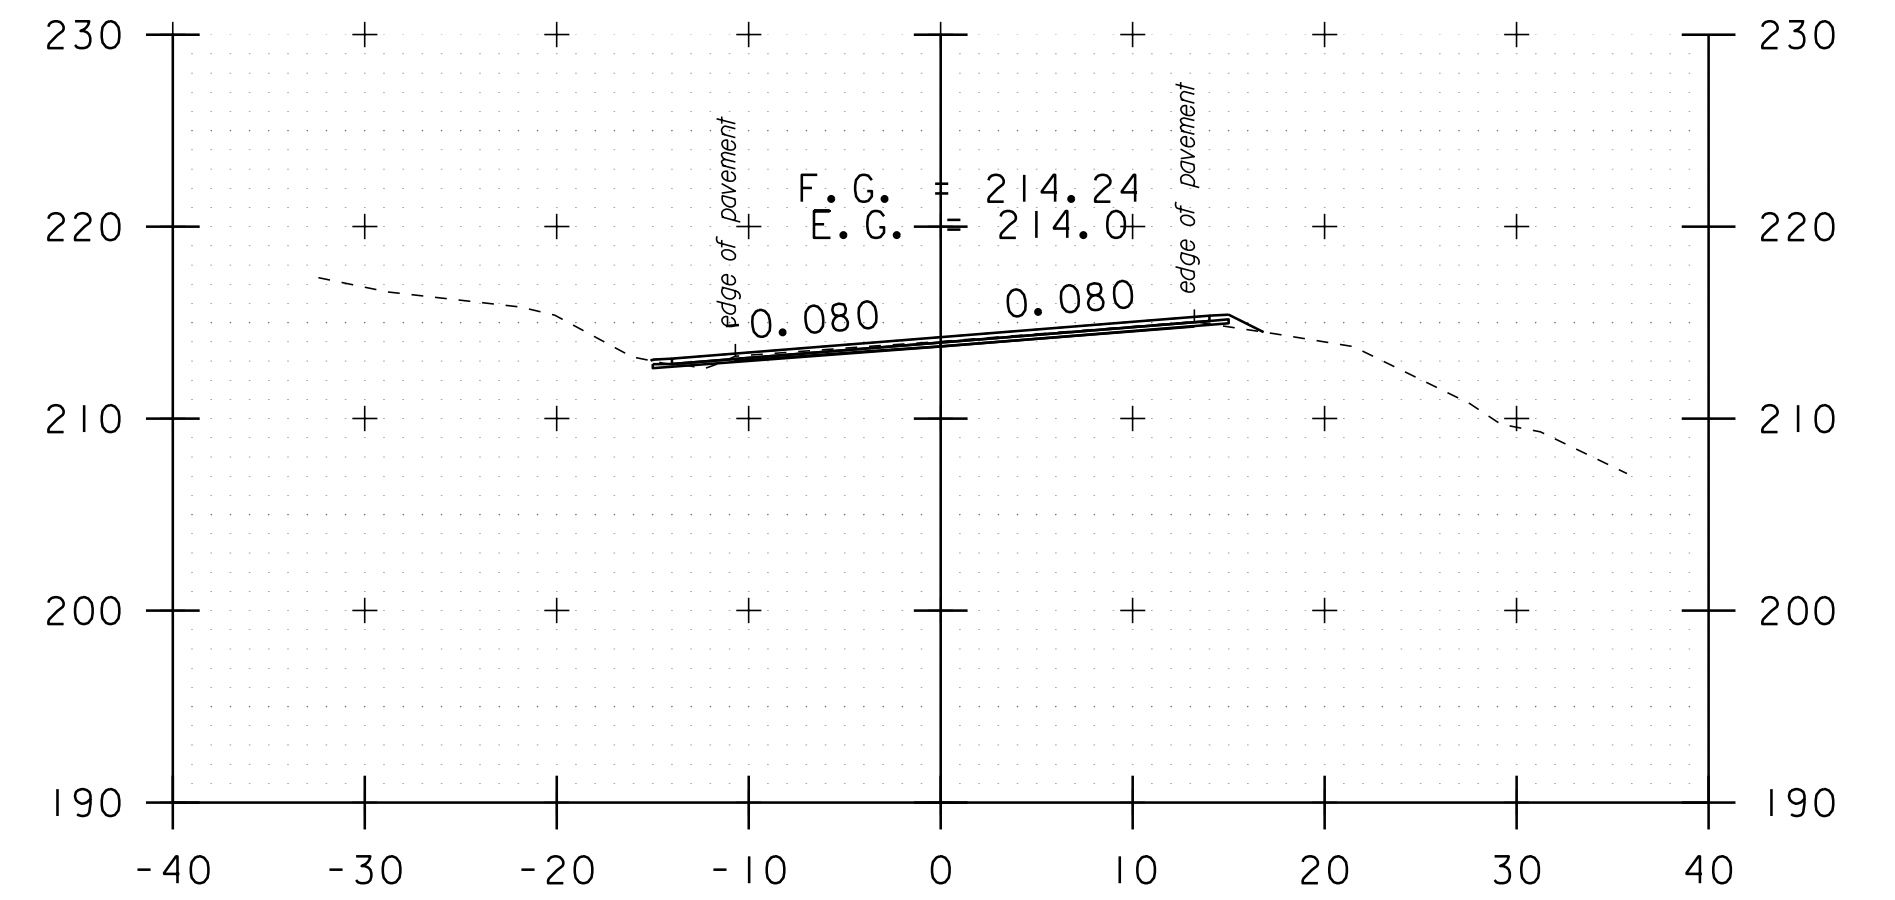

b 25+50

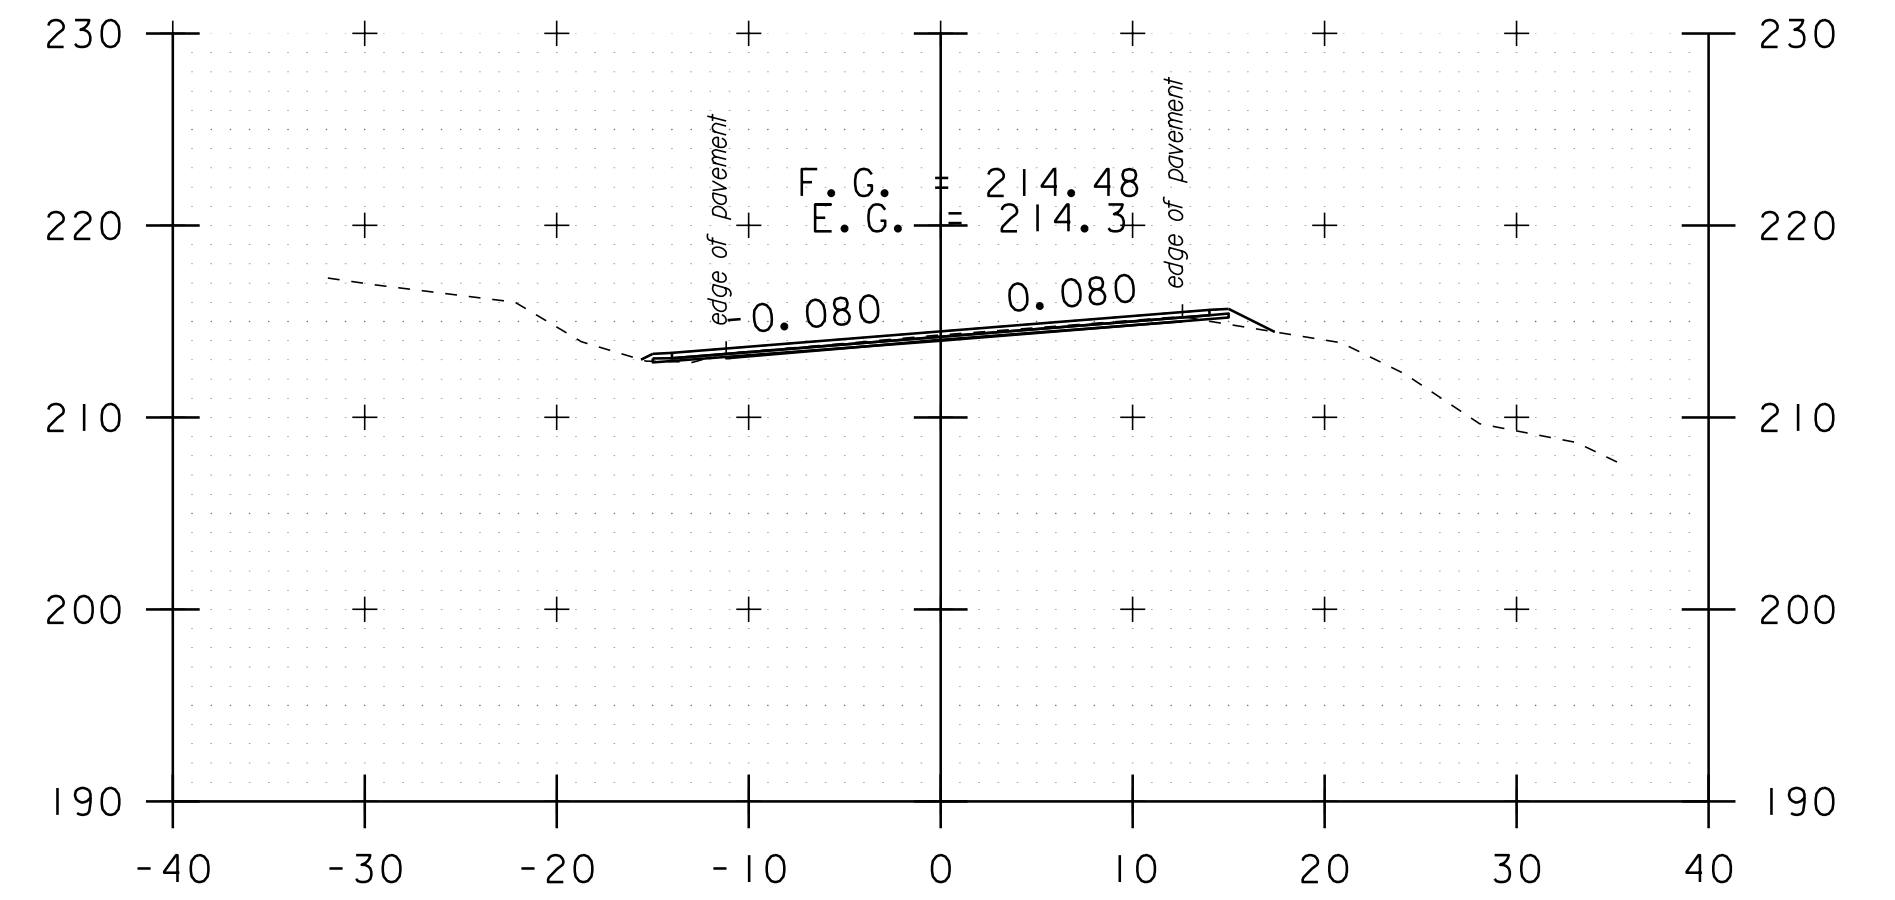


b 25+32

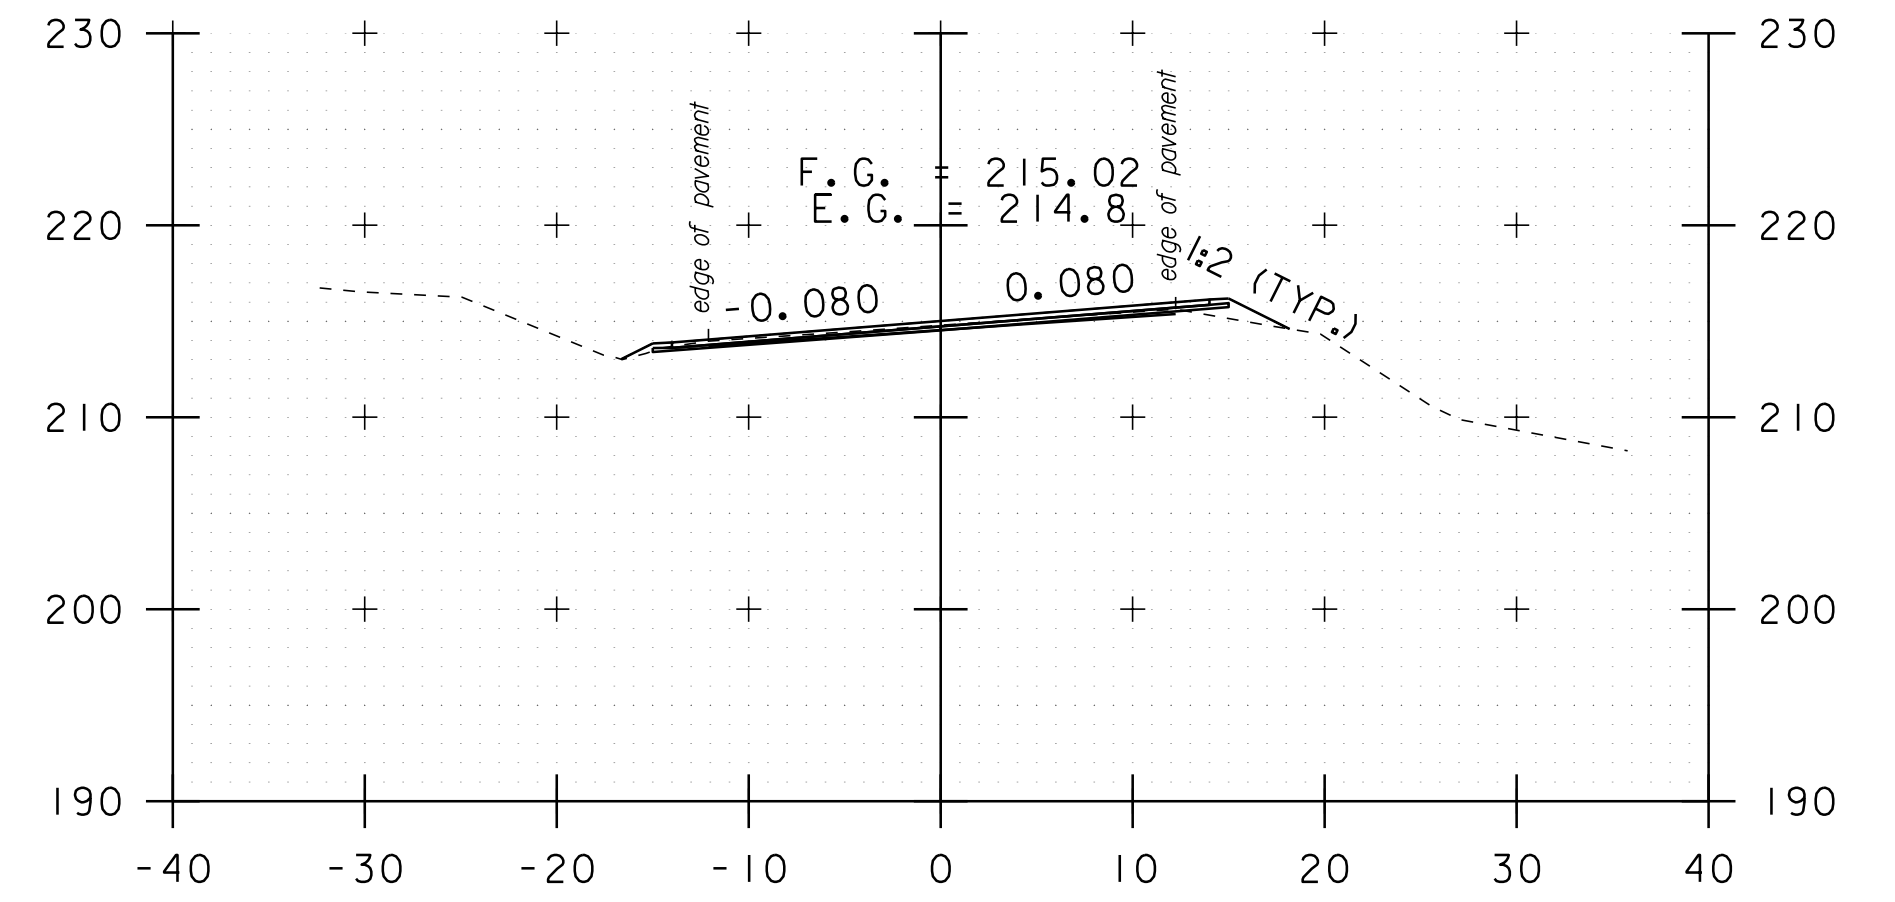

b 25+00

DATUM	NAVD 88
	NAD 83

STA. b 22+50 TO STA. b 25+50

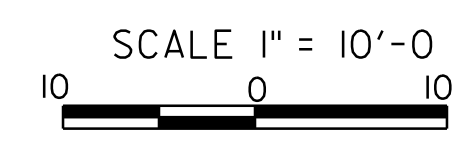

**CROSS SECTION SHEET 27**

PROJECT NAME:	ADDISON-NEW HAVEN
PROJECT NUMBER:	STP 9632(1)
FILE NAME:	p95B076.dgn
PROJECT LEADER:	CDL
DESIGNED BY:	SJL
PLOT FILE:	p95B076_I32.1
PLOT DATE:	3/13/2012
DRAWN BY:	SJL
CHECKED BY:	EPD
SHEET	132 OF 186