




b 69+90

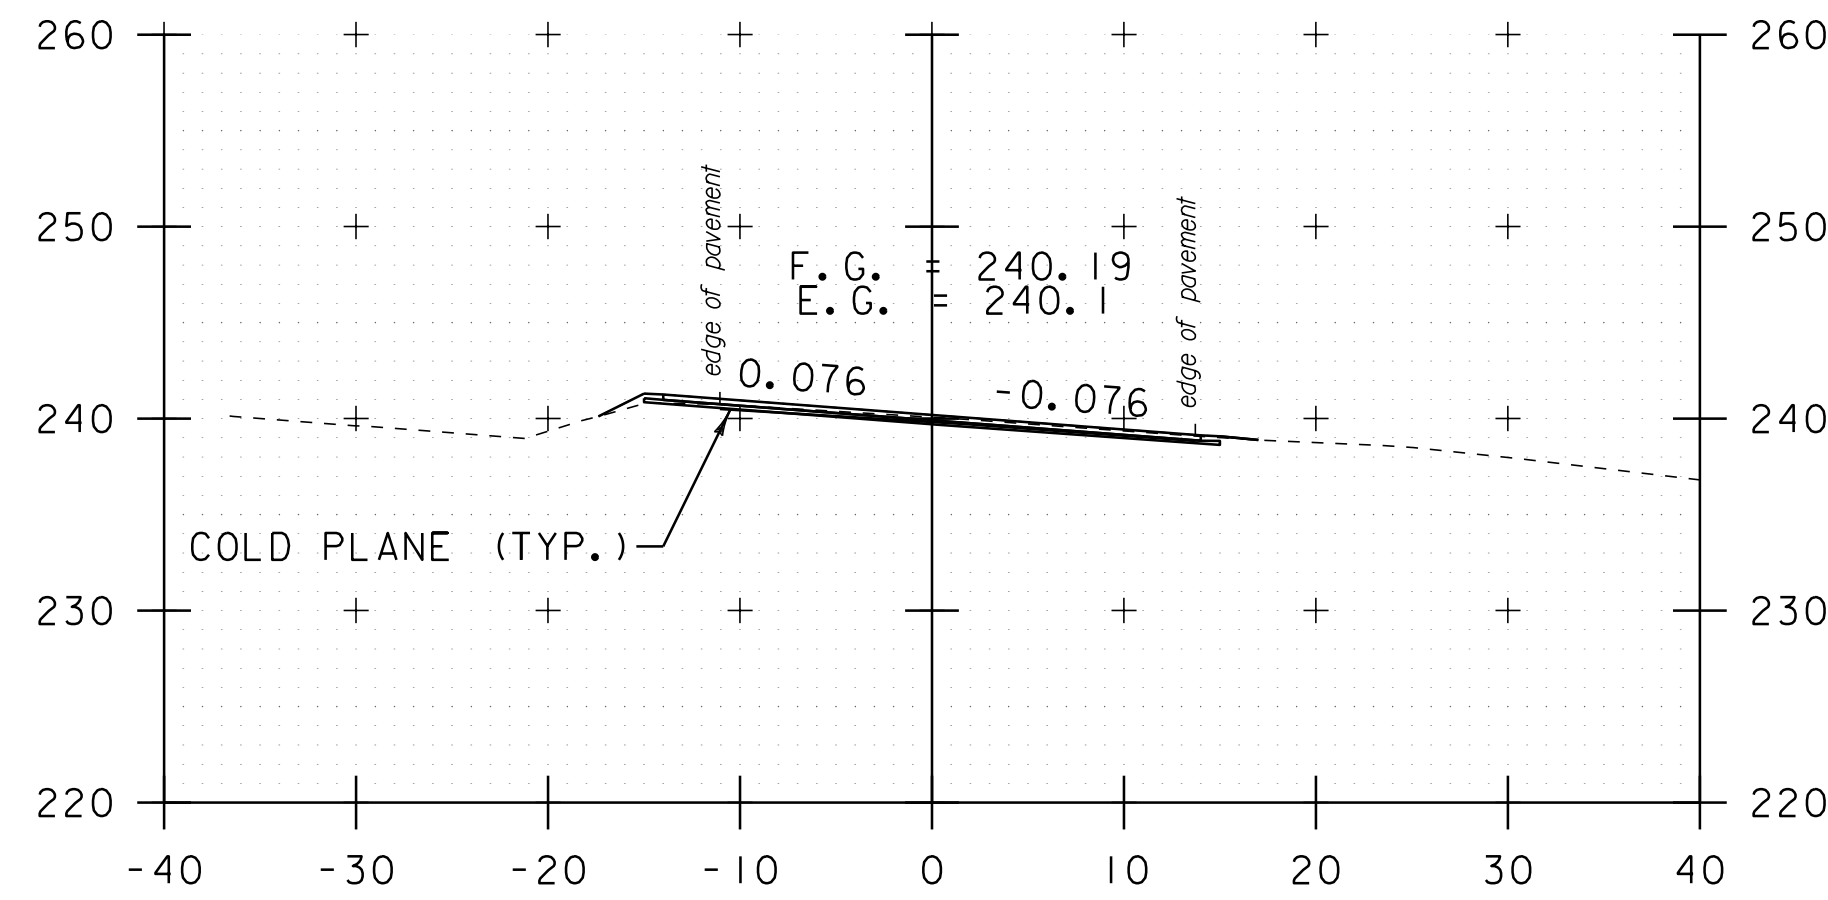


b 71+00
DRIVE RT

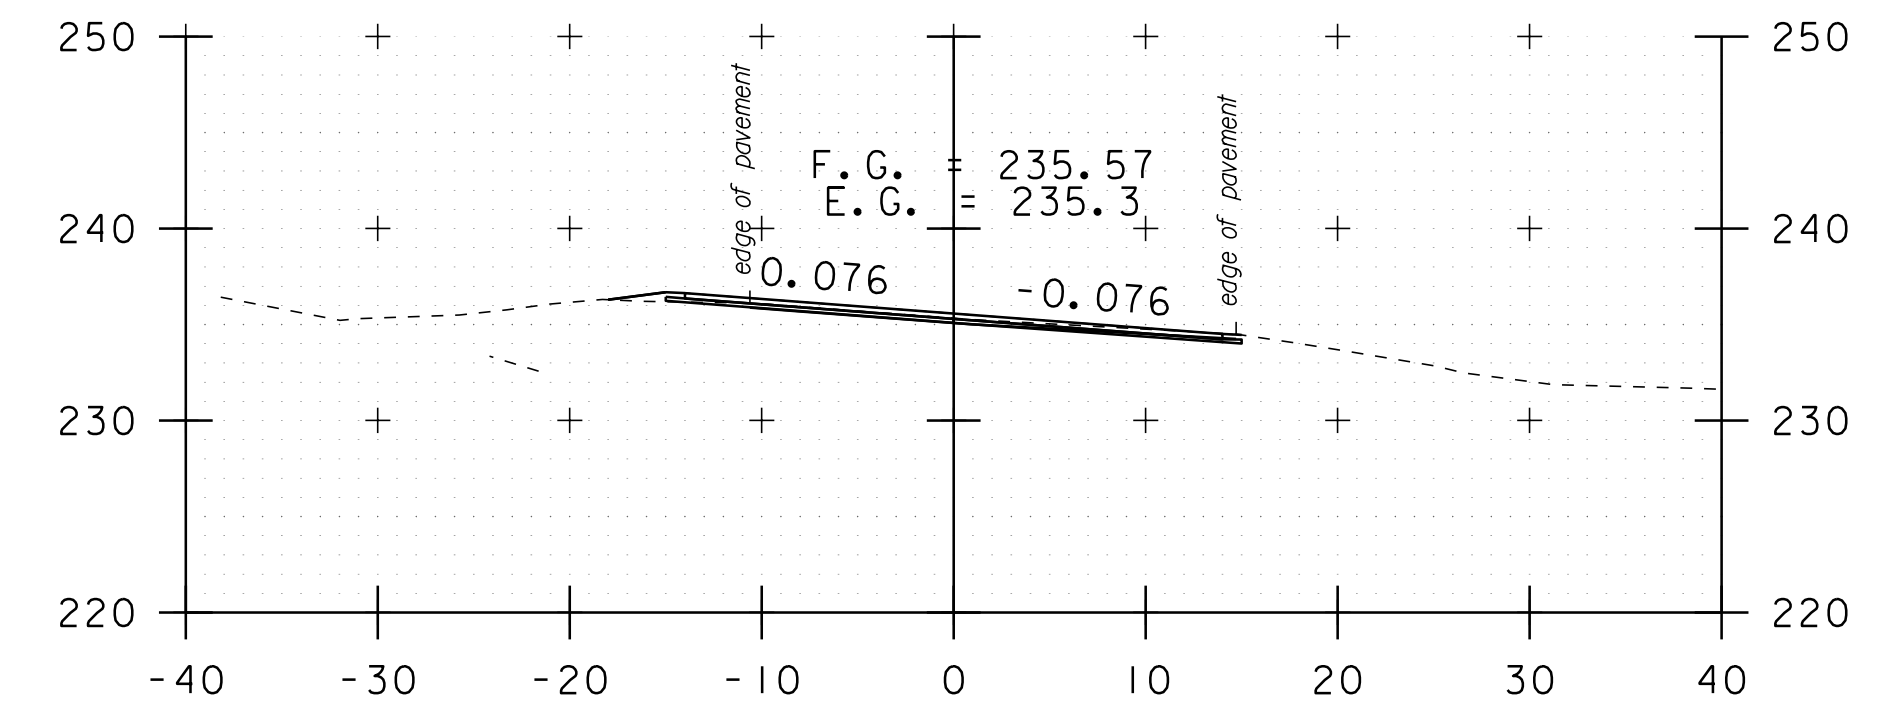


b 72+50
DRIVE LT

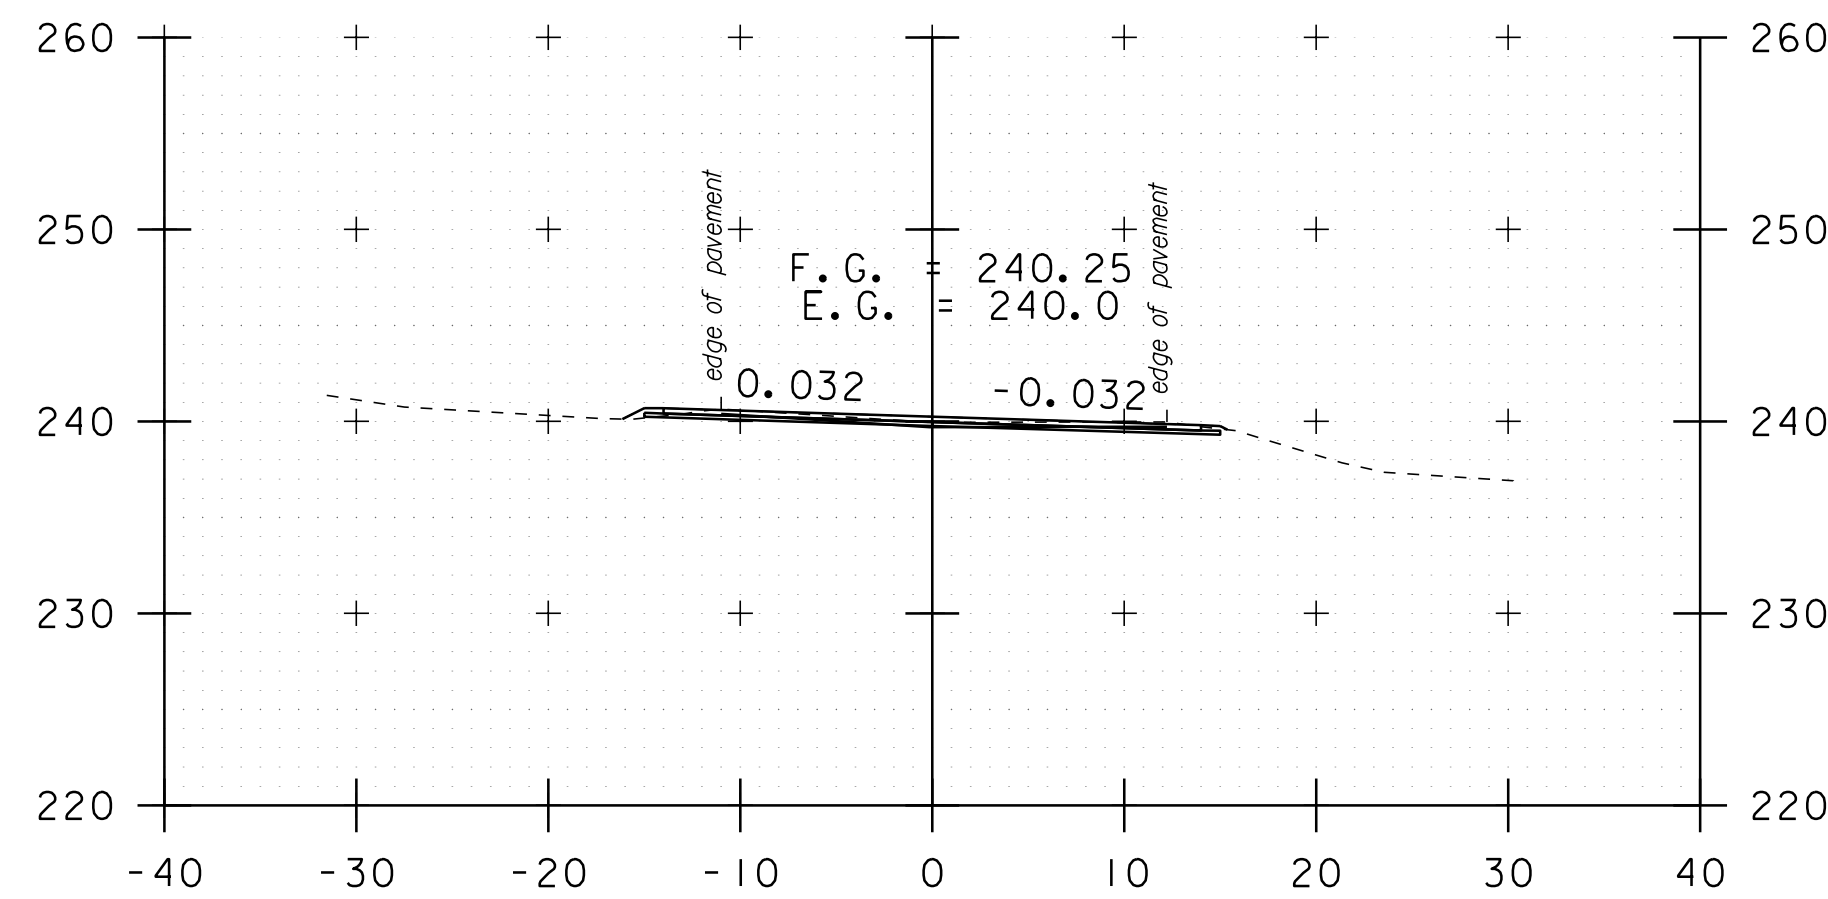


b 69+16

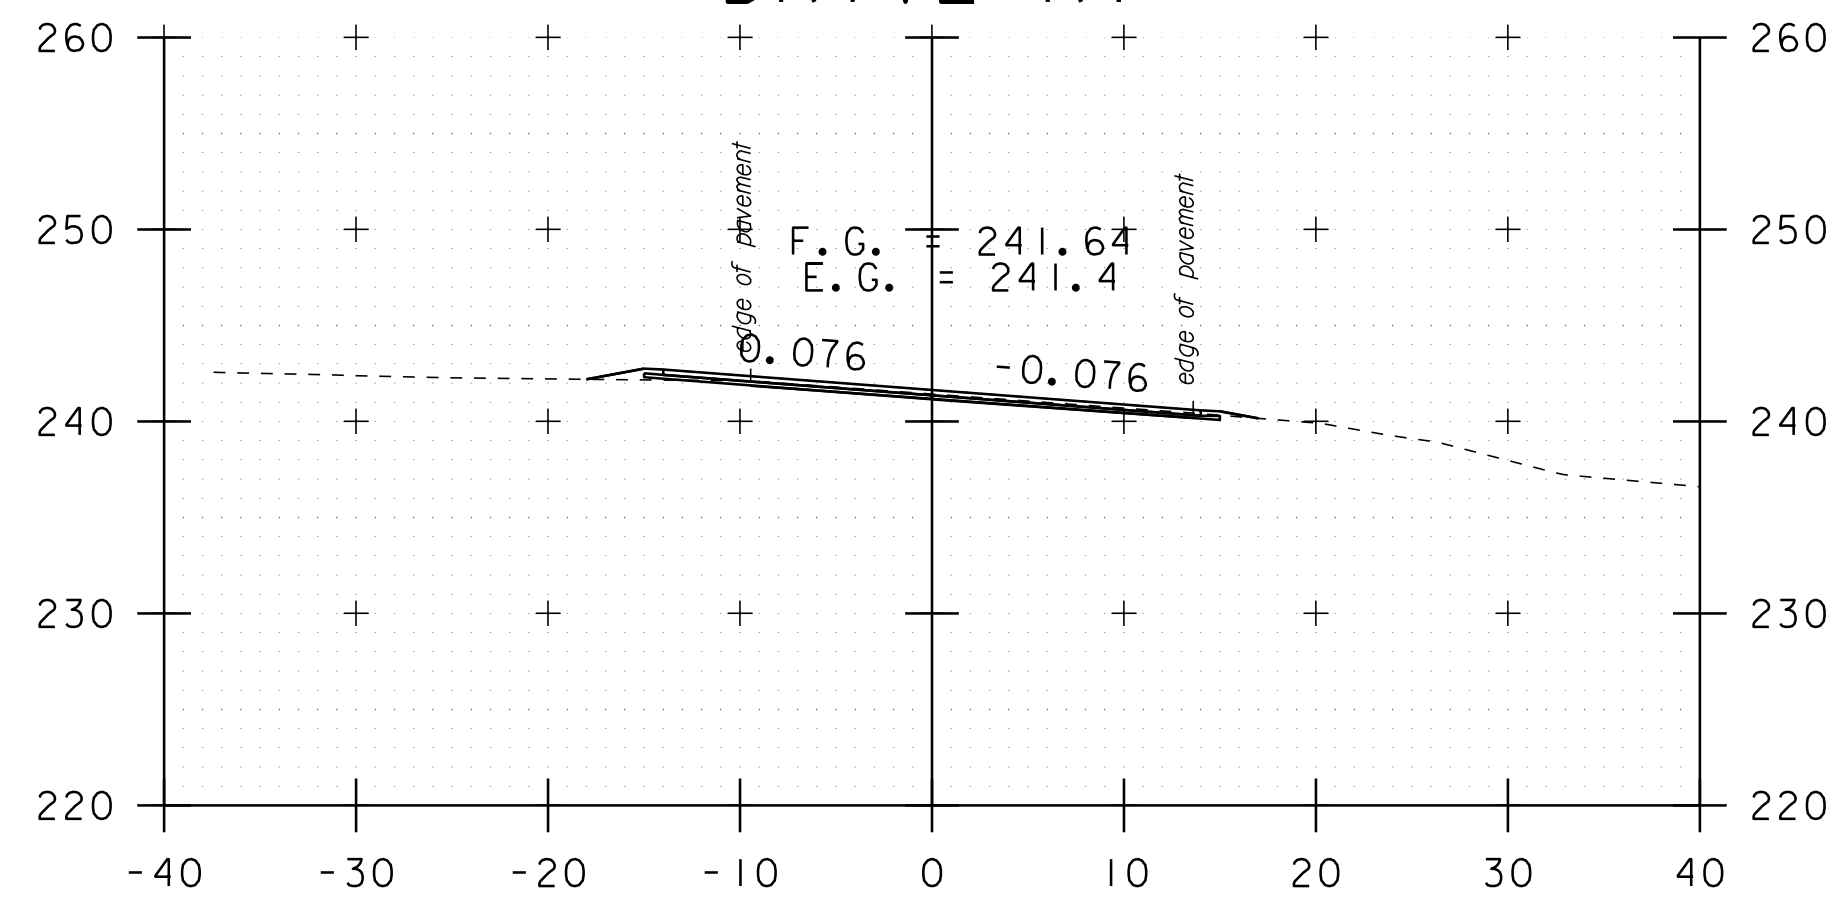


b 70+50
DRIVE LT & RT

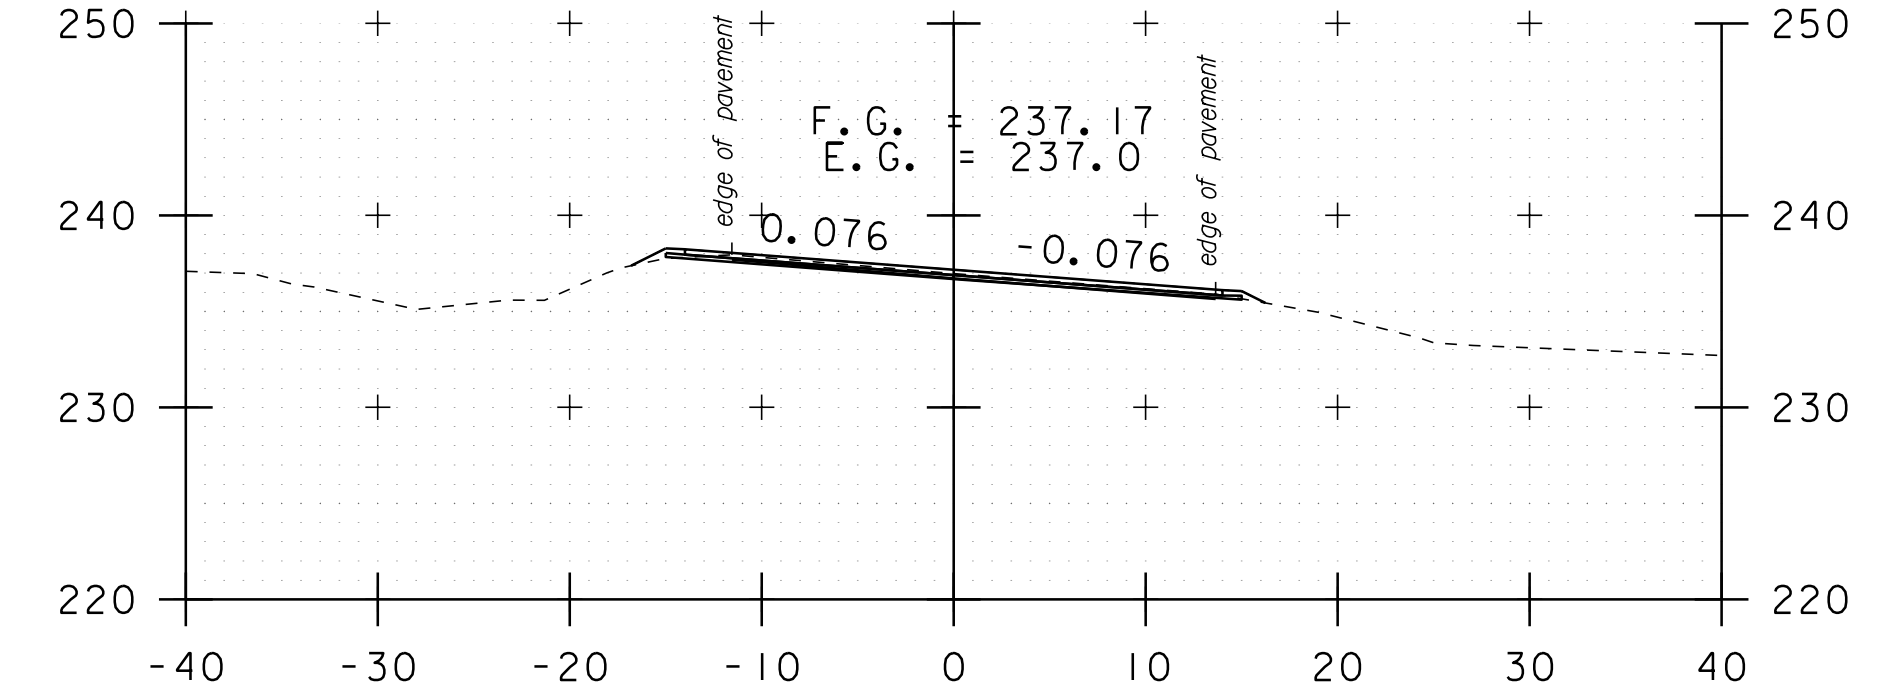


b 72+00

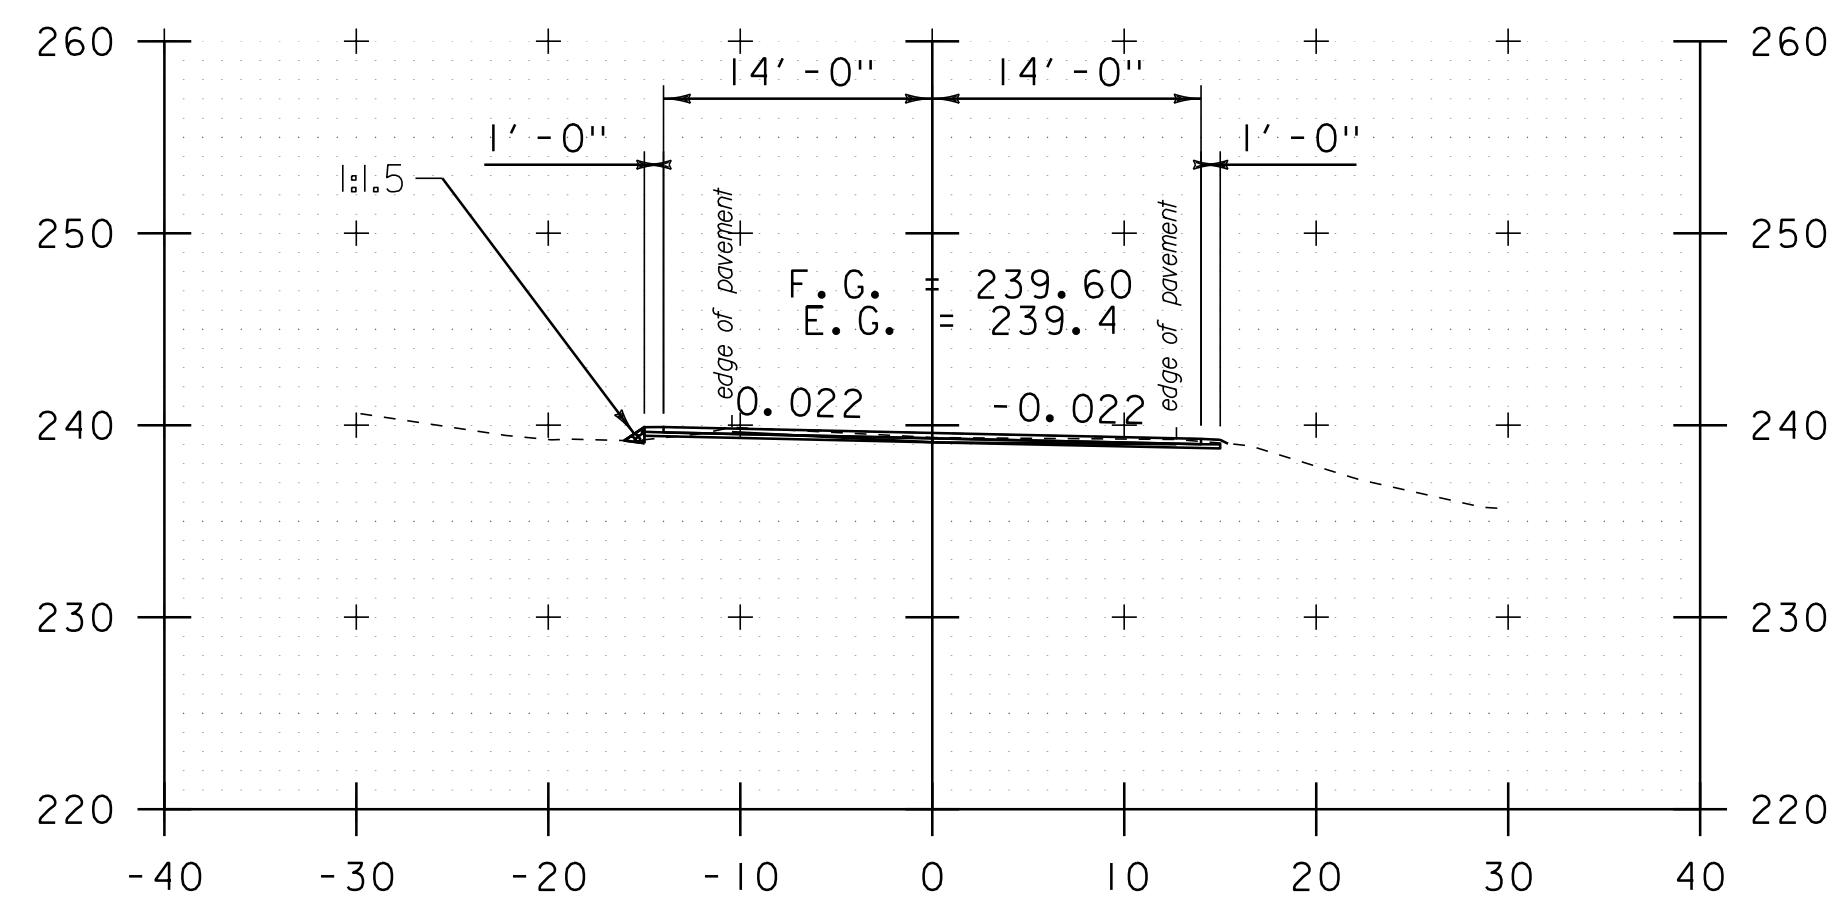

b 68+90

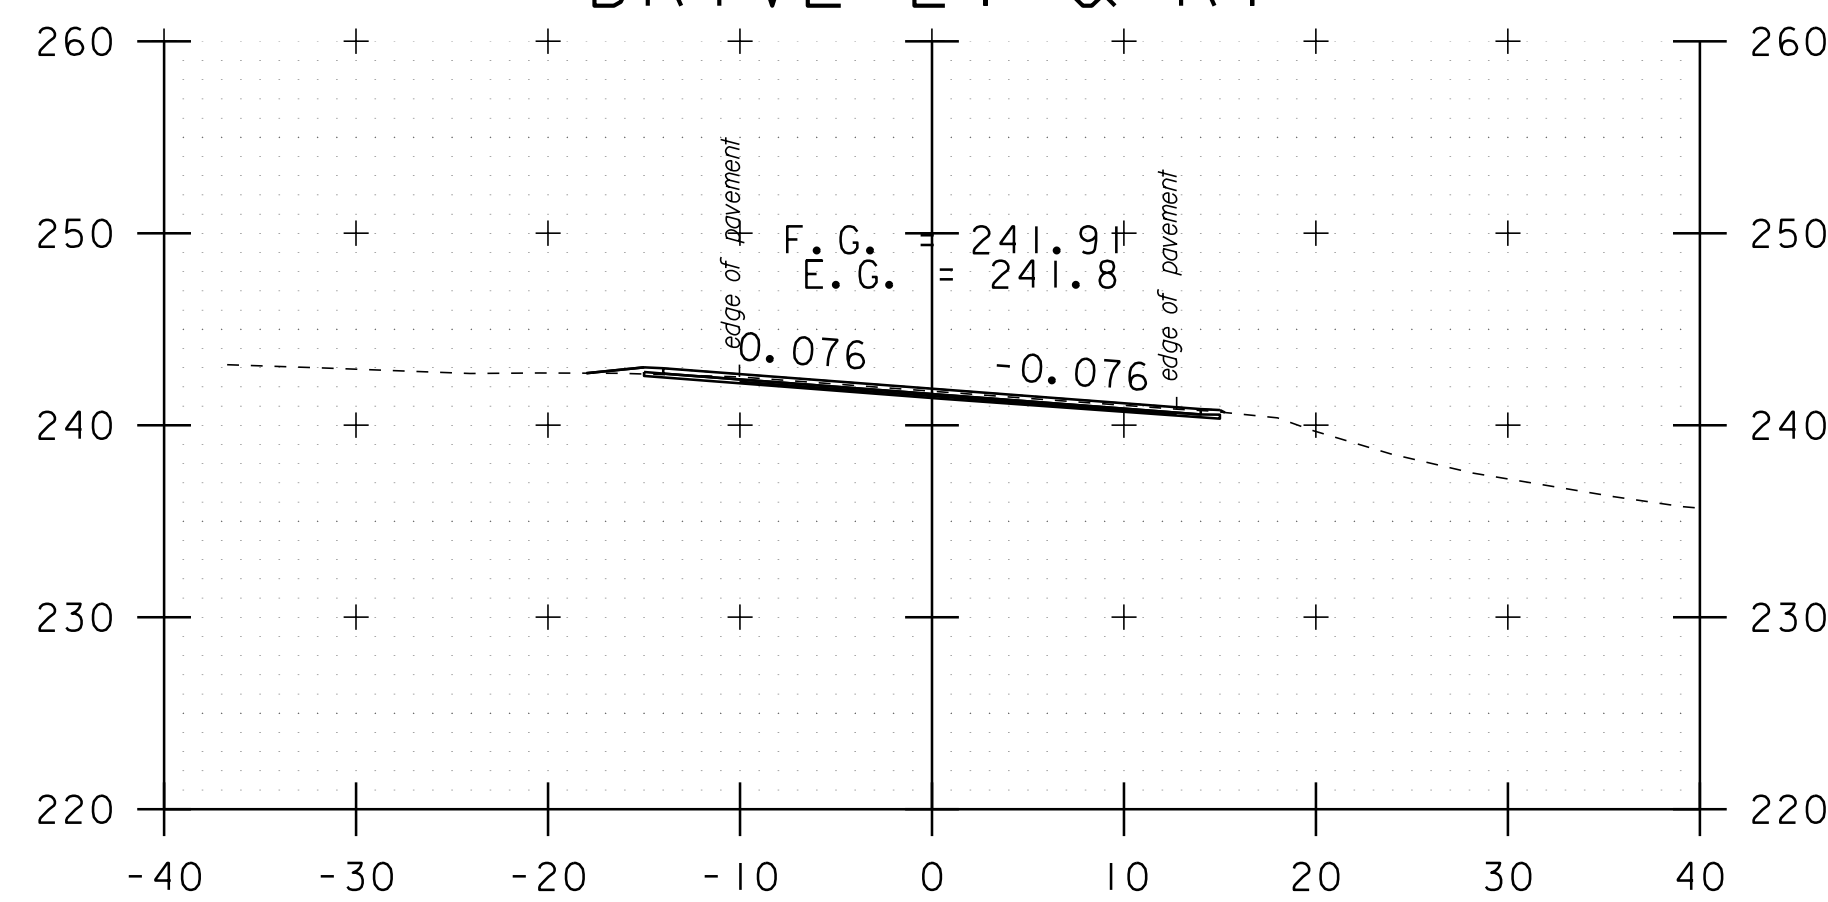


b 70+35
DRIVE LT

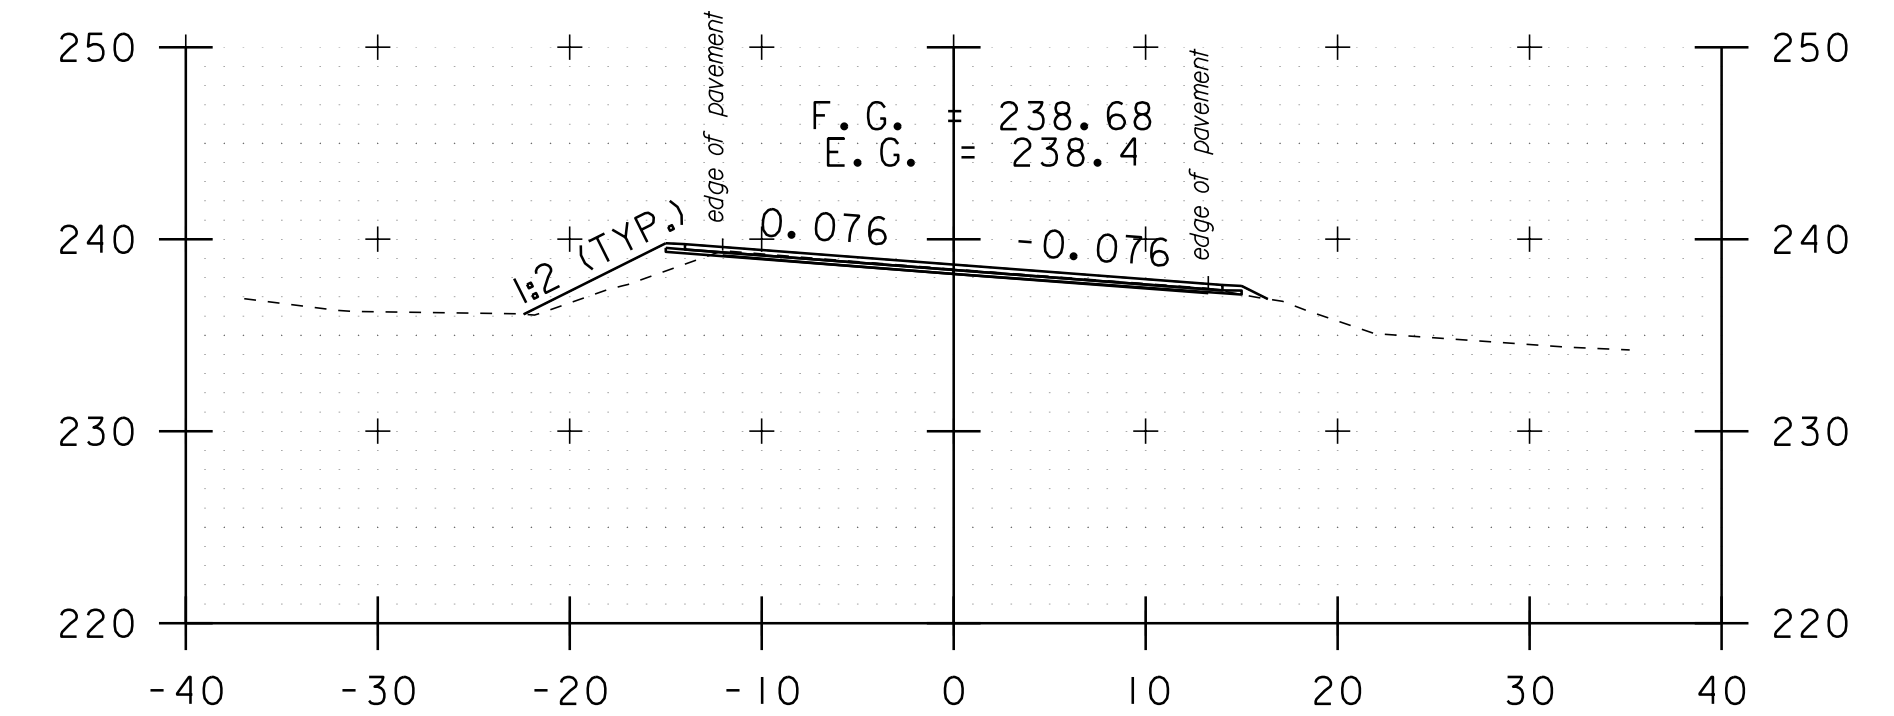

b 71+50

DATUM	NAVD 88
	NAD 83

STA. b 68+90 TO STA. b 72+50

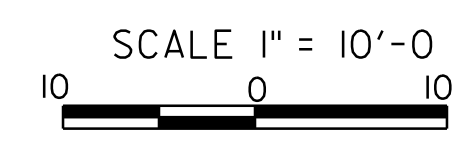

CROSS SECTION SHEET 31

PROJECT NAME:	ADDISON-NEW HAVEN
PROJECT NUMBER:	STP 9632(1)
FILE NAME:	p95B076.dgn
PROJECT LEADER:	CDL
DESIGNED BY:	SJL
PLOT FILE:	p95B076_136.1
PLOT DATE:	3/13/2012
DRAWN BY:	SJL
CHECKED BY:	EPD
SHEET	136 OF 186