




b 74+55

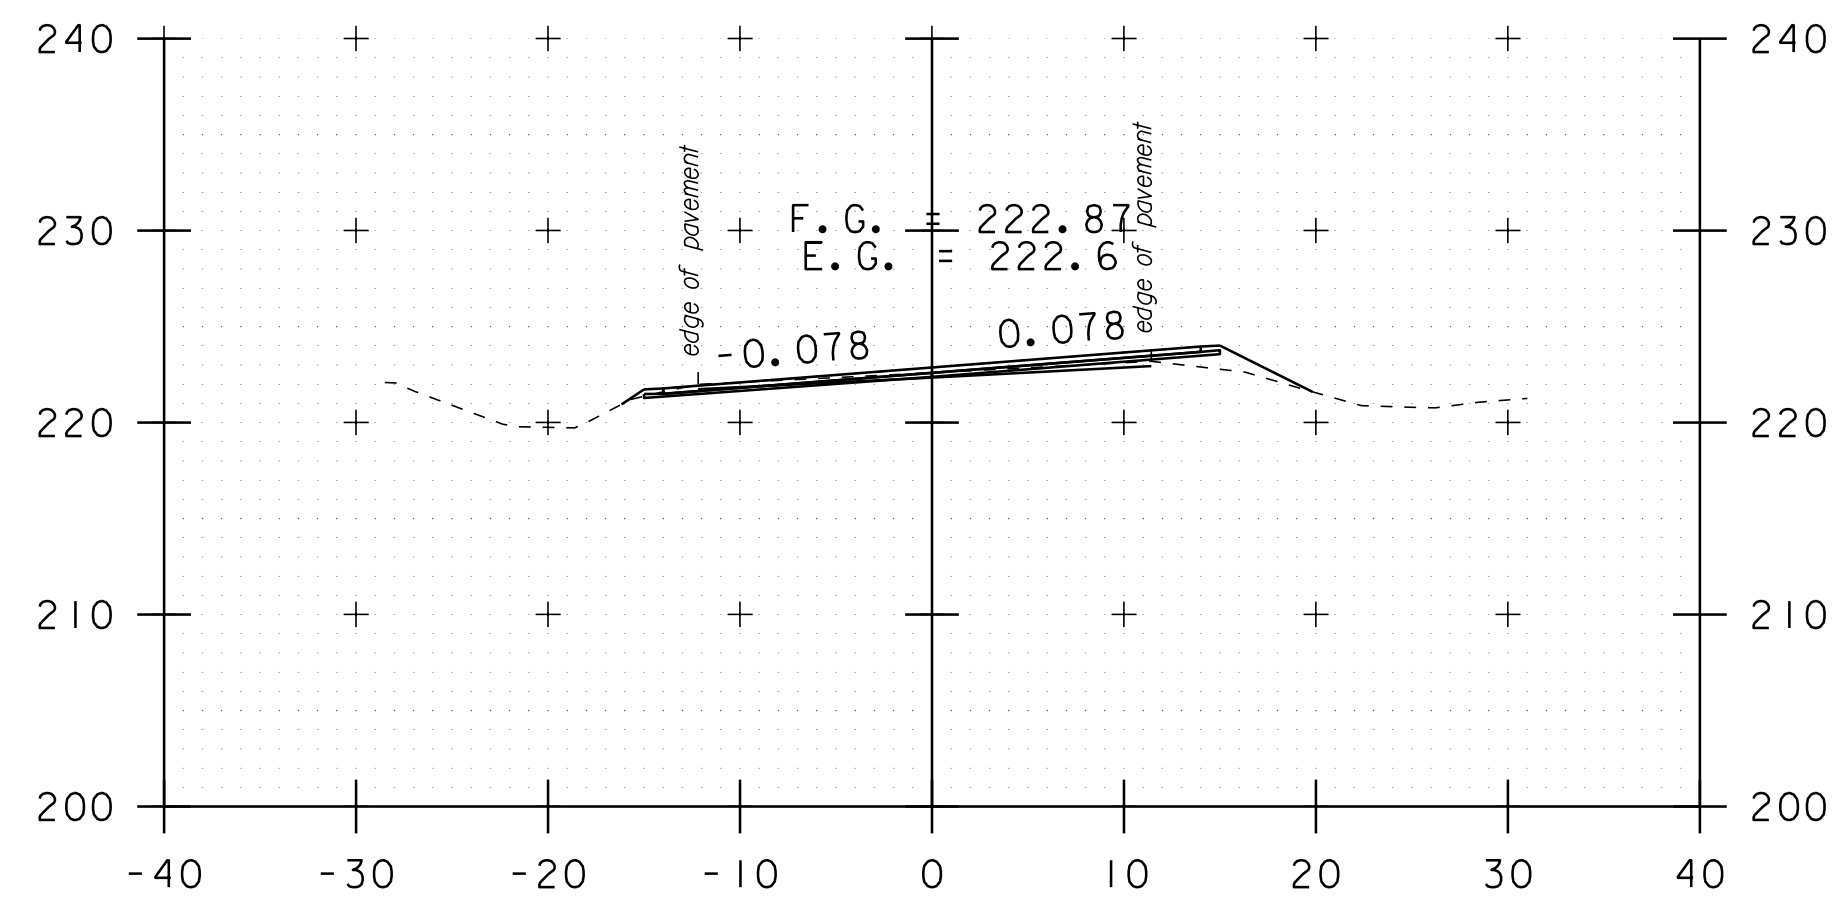


b 76+50

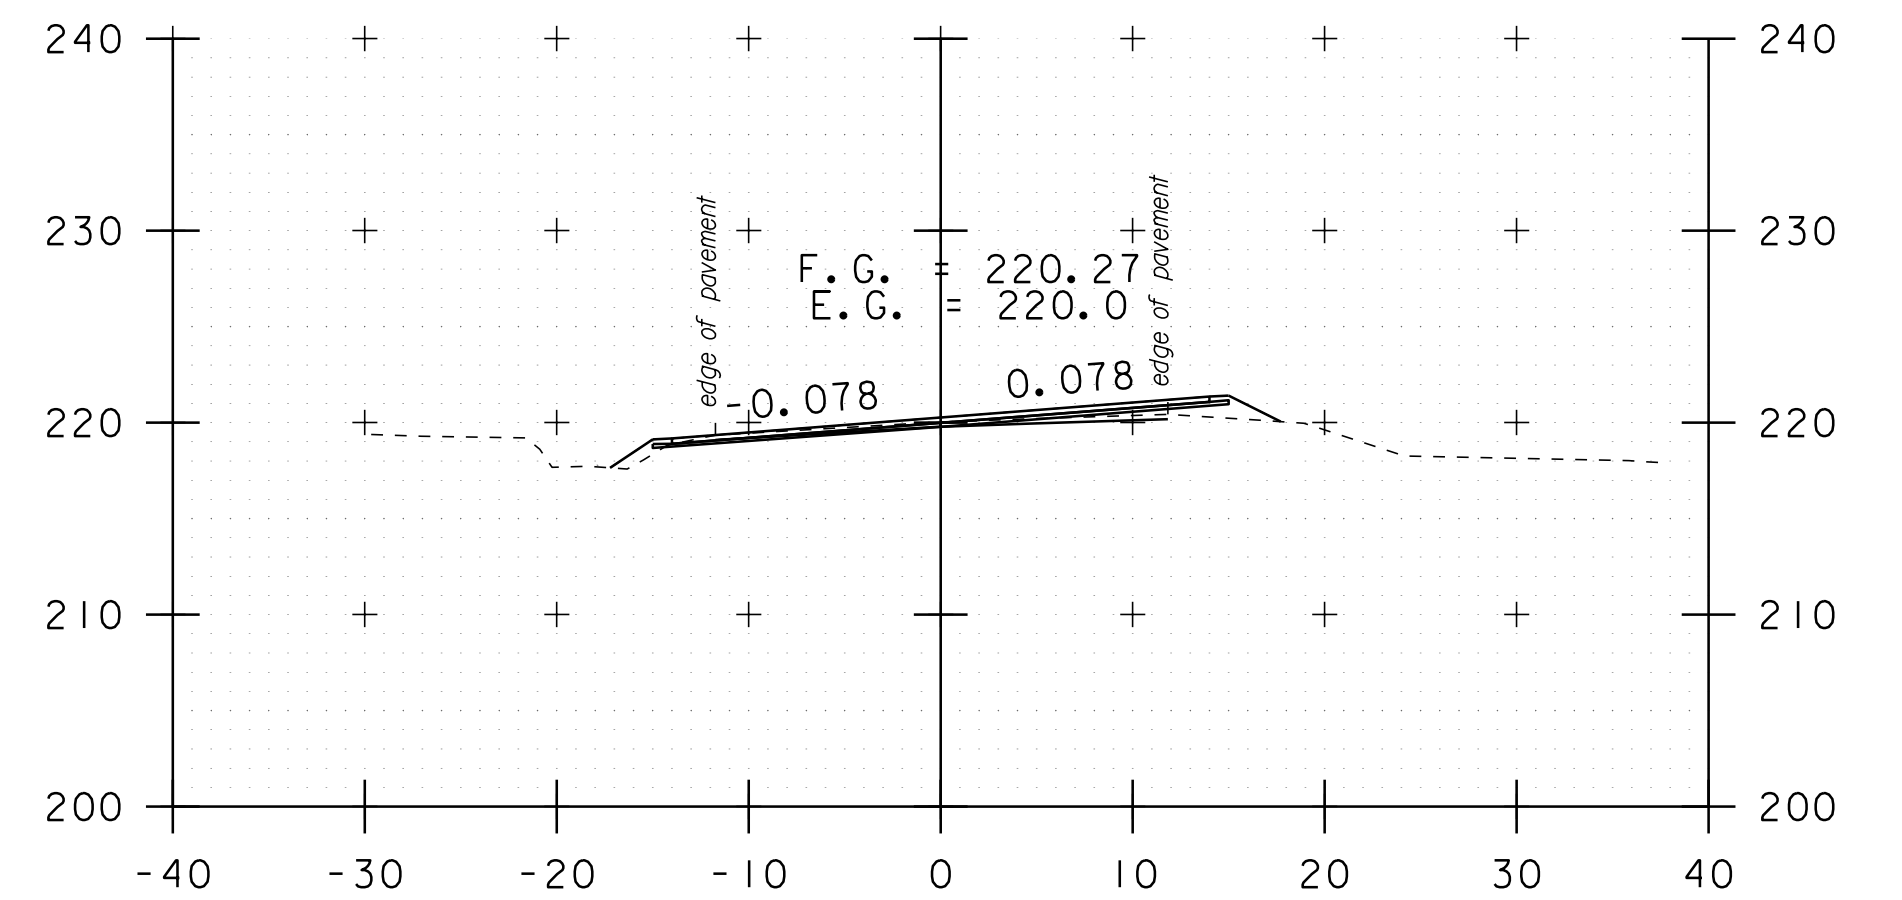


b 78+00

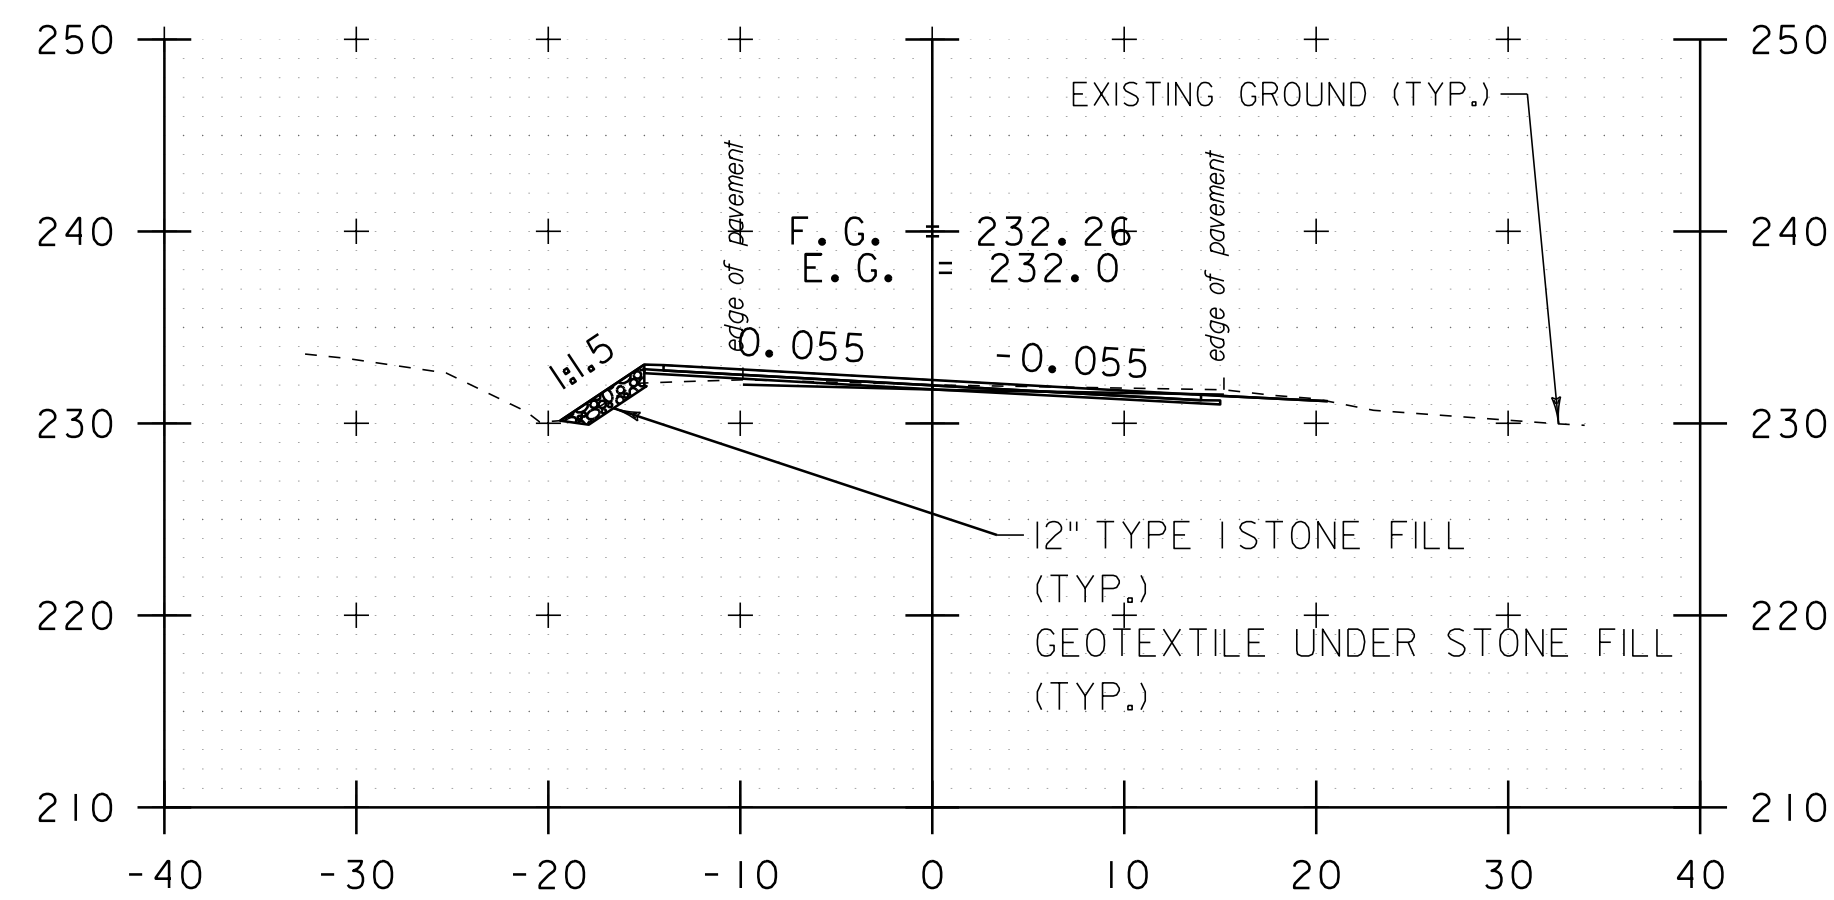


b 73+31

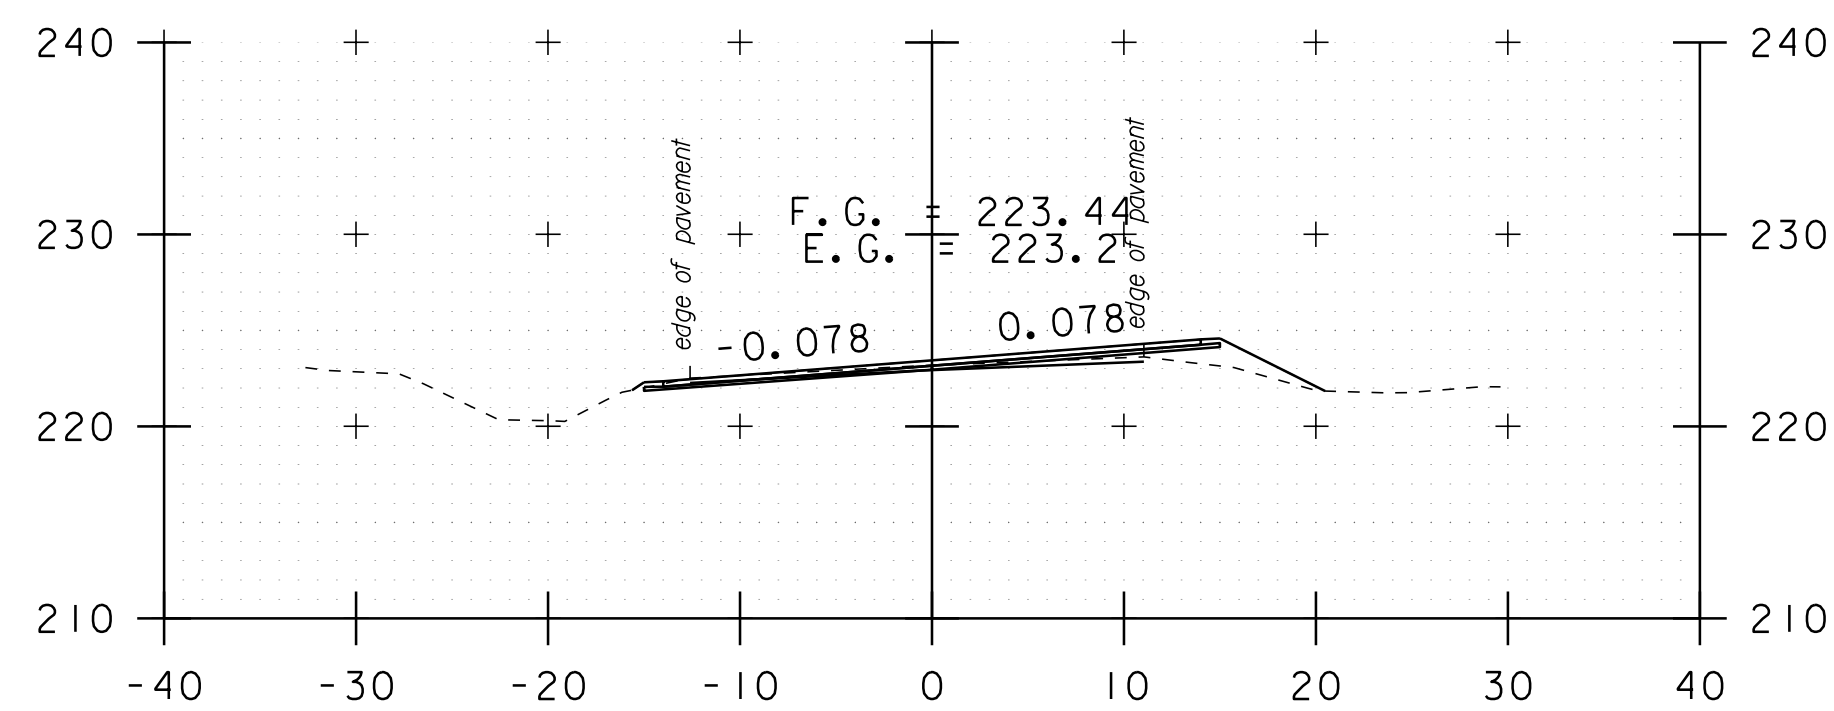


b 76+30

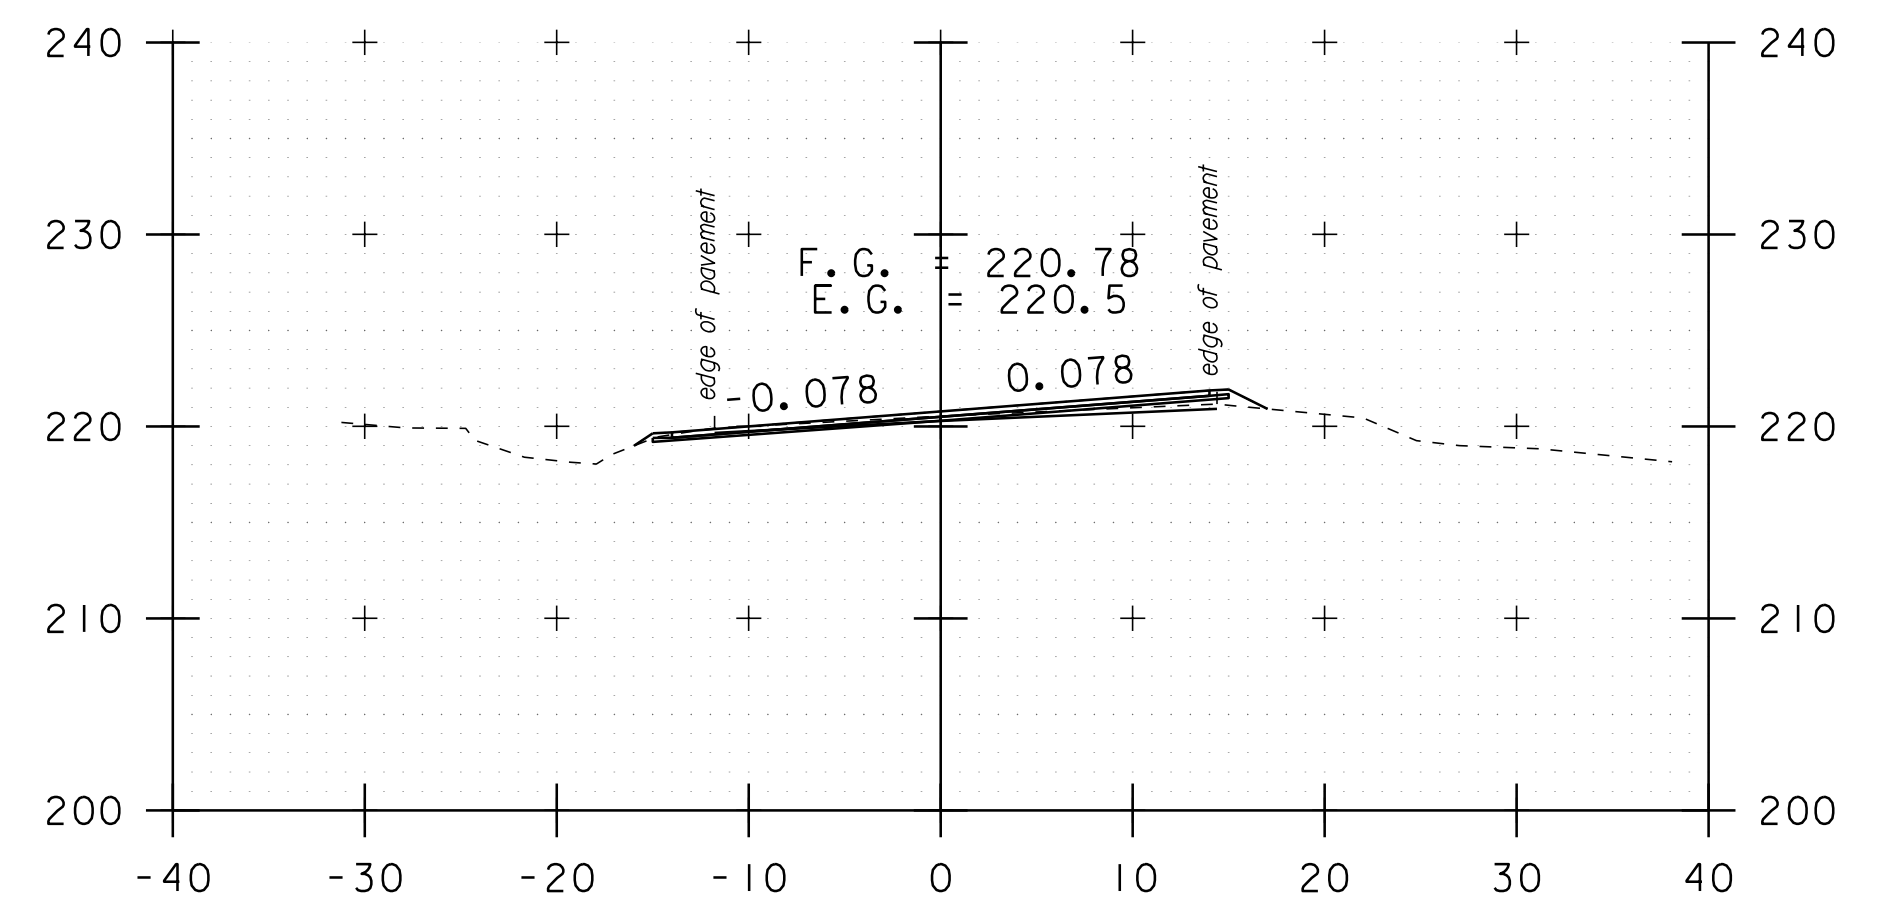


b 77+50

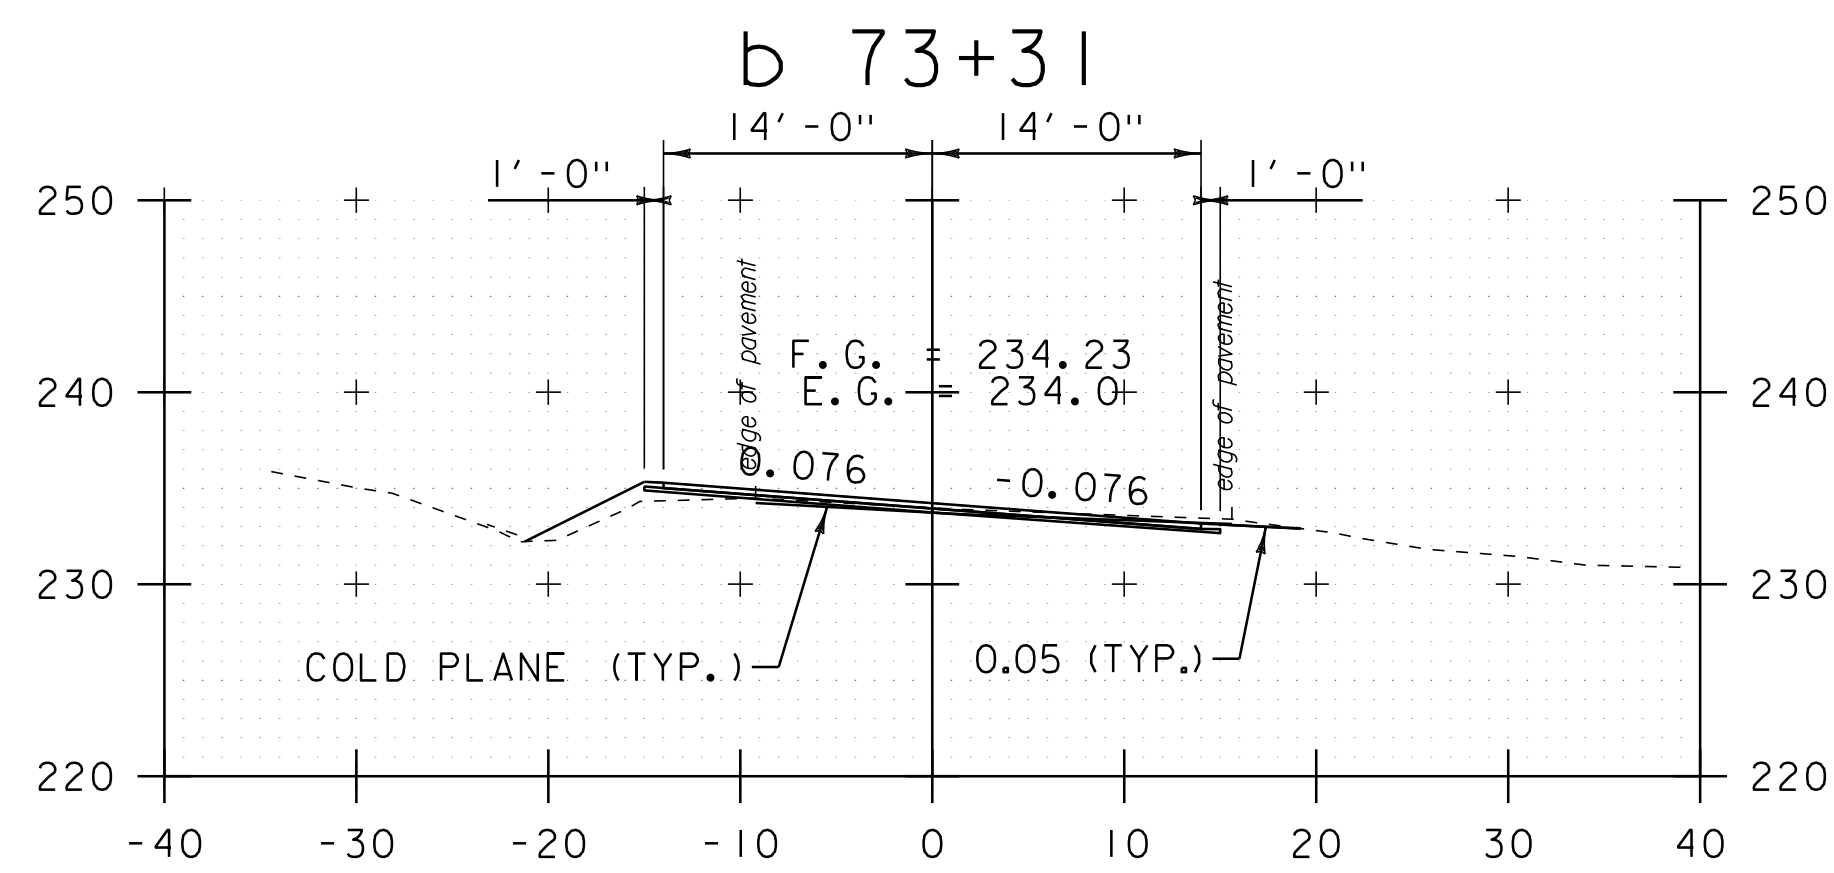

b 72+85

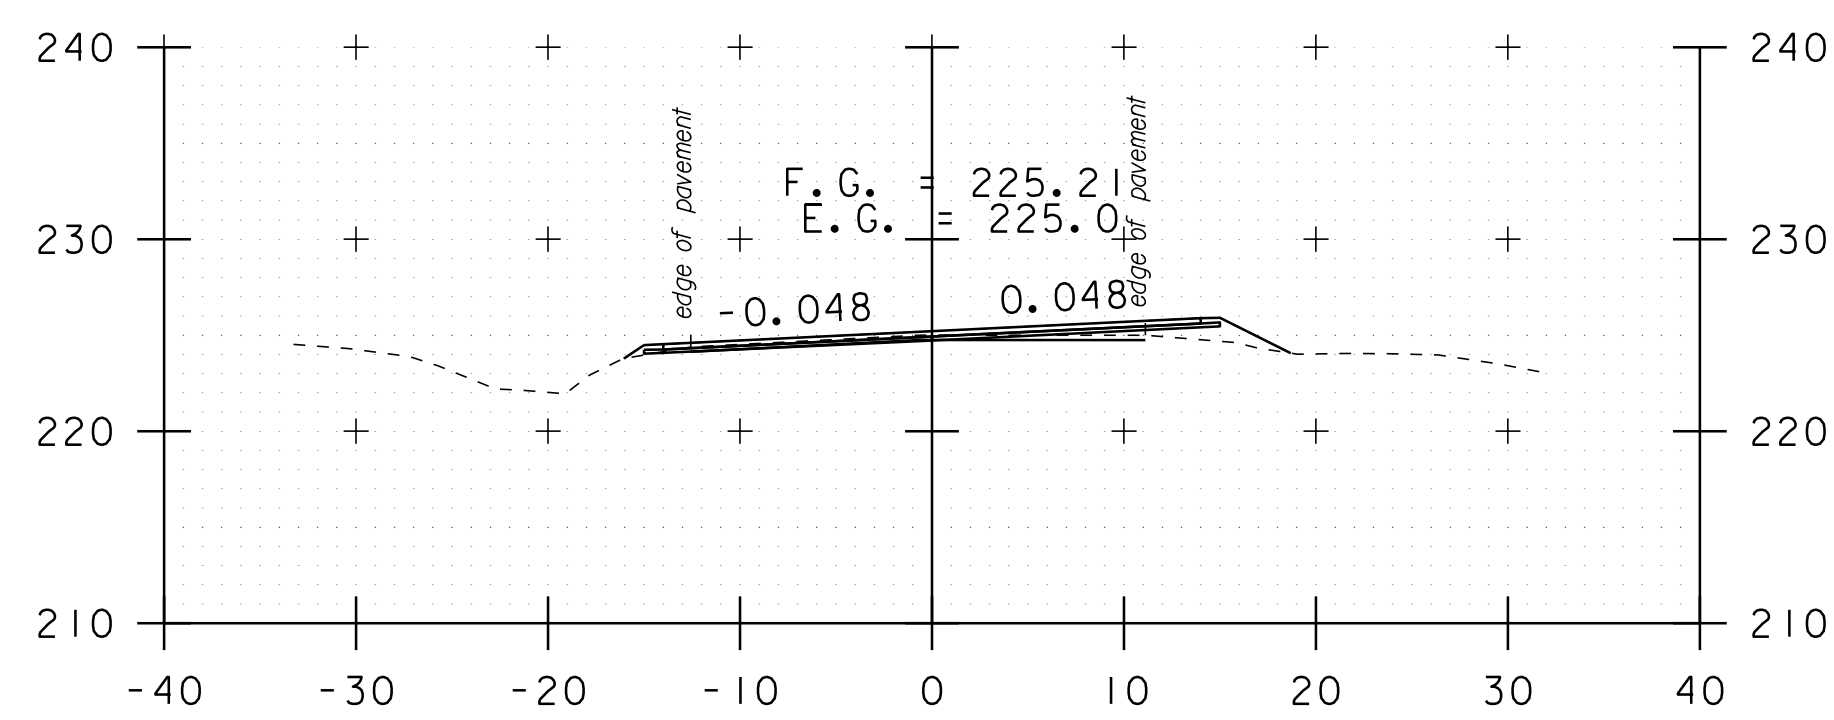


b 75+64

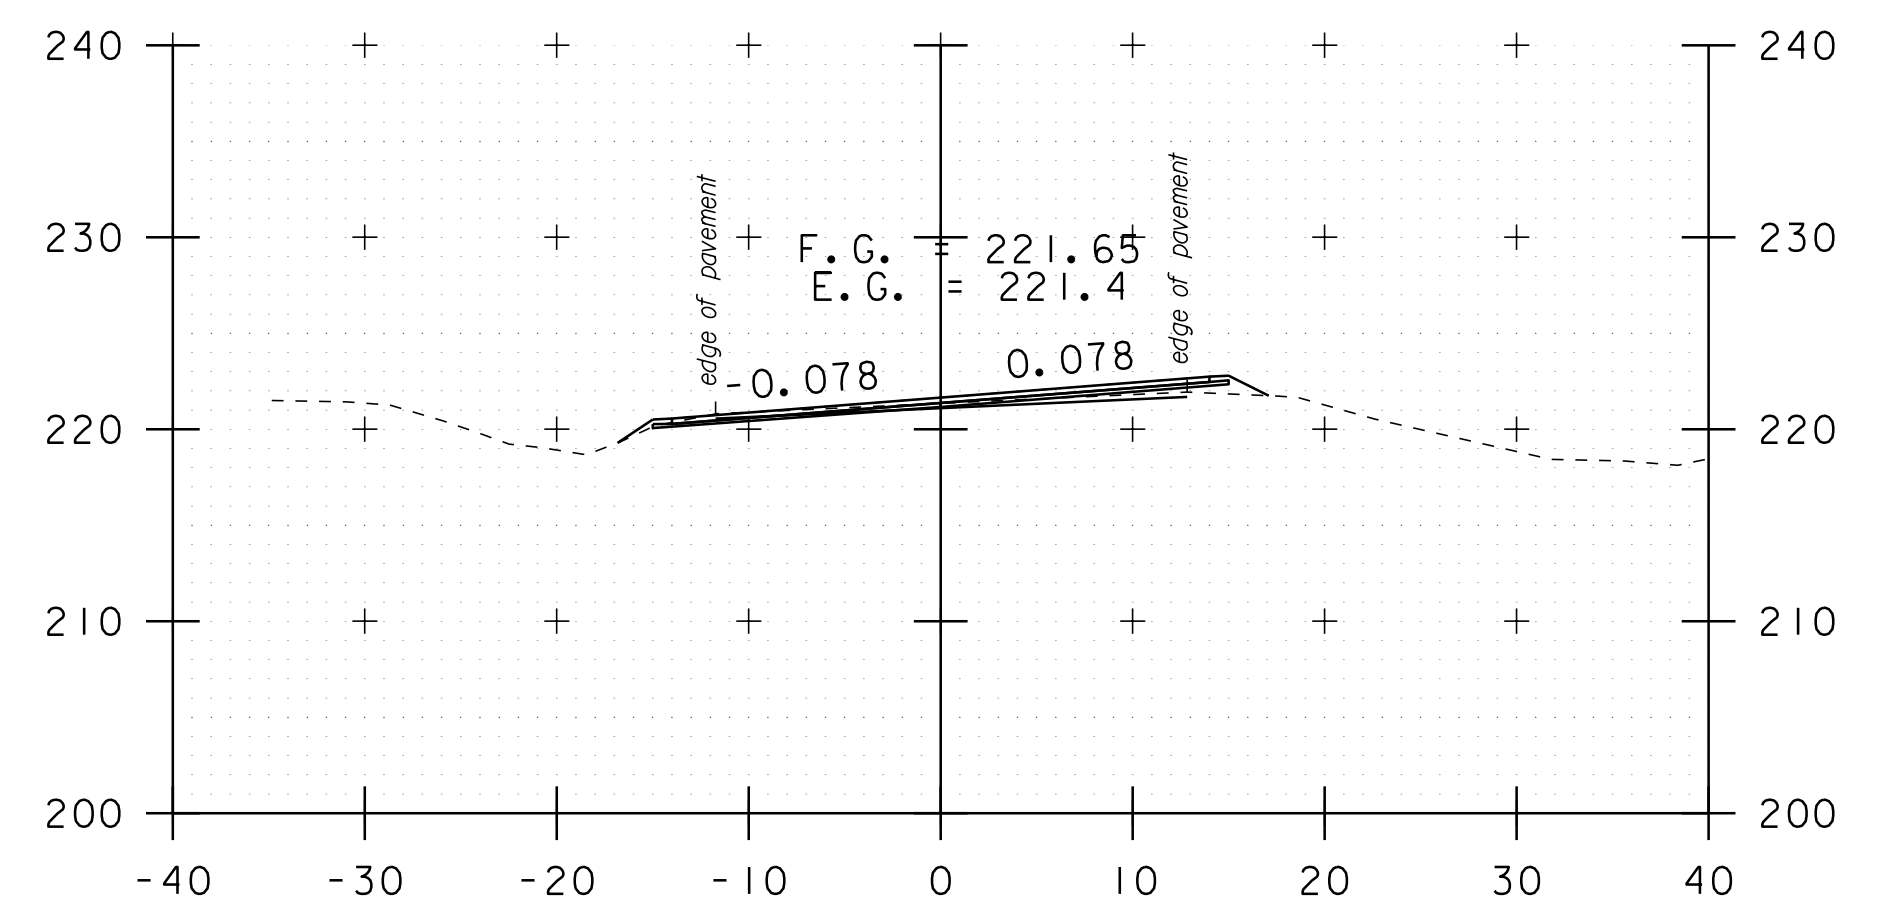

b 77+00

DATUM	NAVD 88
	NAD 83

STA. b 72+85 TO STA. b 78+00

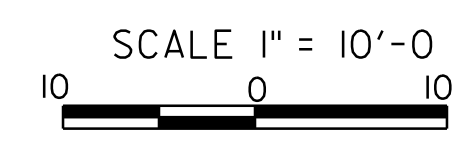

CROSS SECTION SHEET 32

PROJECT NAME:	ADDISON-NEW HAVEN	PLOT DATE:	3/13/2012
PROJECT NUMBER:	STP 9632(1)	DRAWN BY:	SJL
FILE NAME:	p95B076.dgn	CHECKED BY:	EPD
PROJECT LEADER:	CDL	SHEET	137 OF 186
DESIGNED BY:	SJL		
PLOT FILE:	p95B076_137.1		