




b 78+65

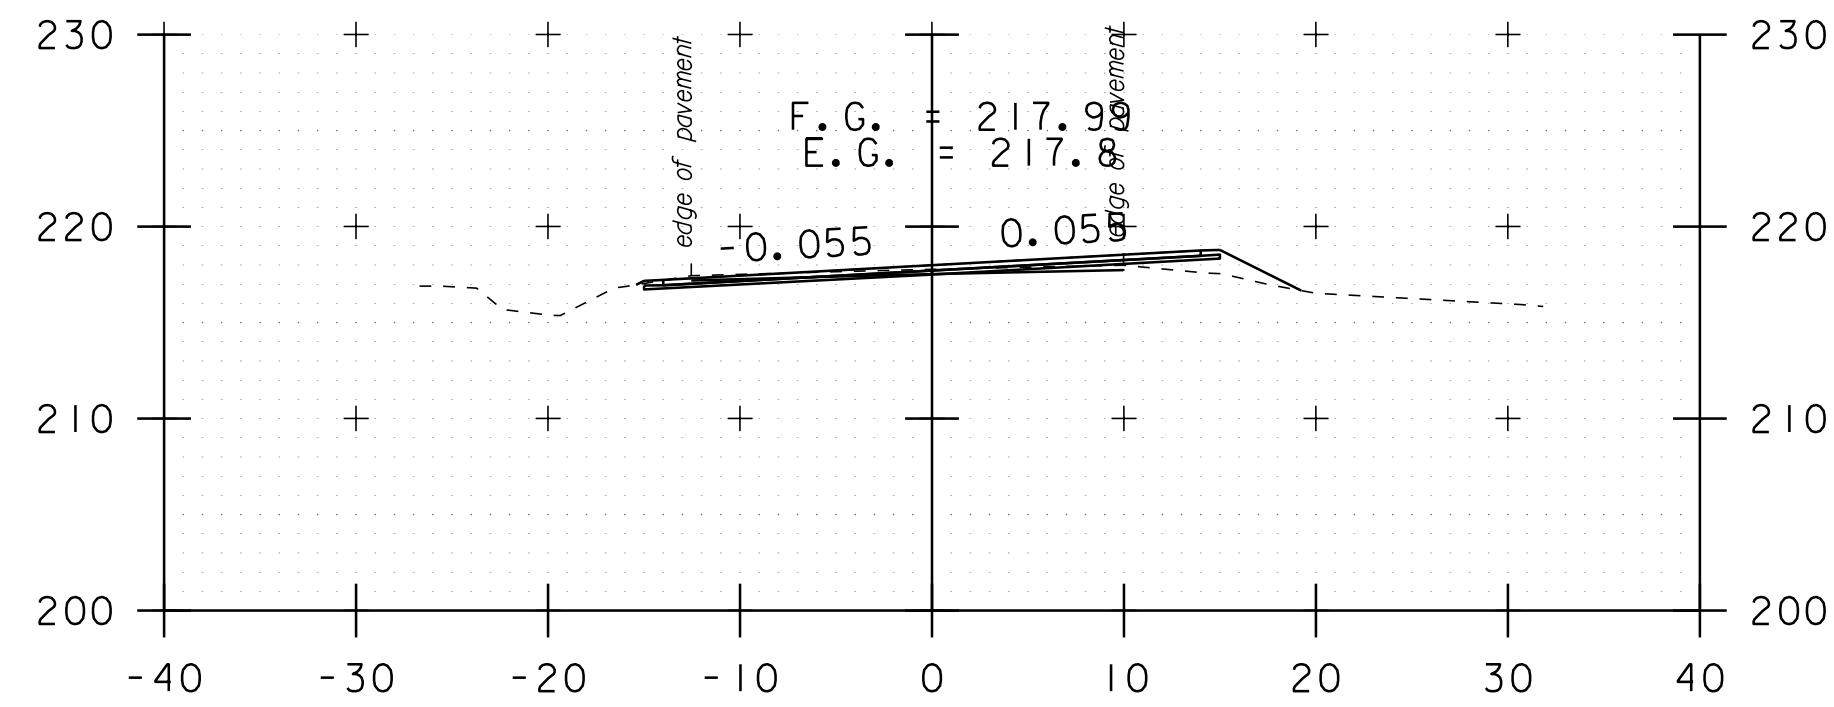


b 79+62

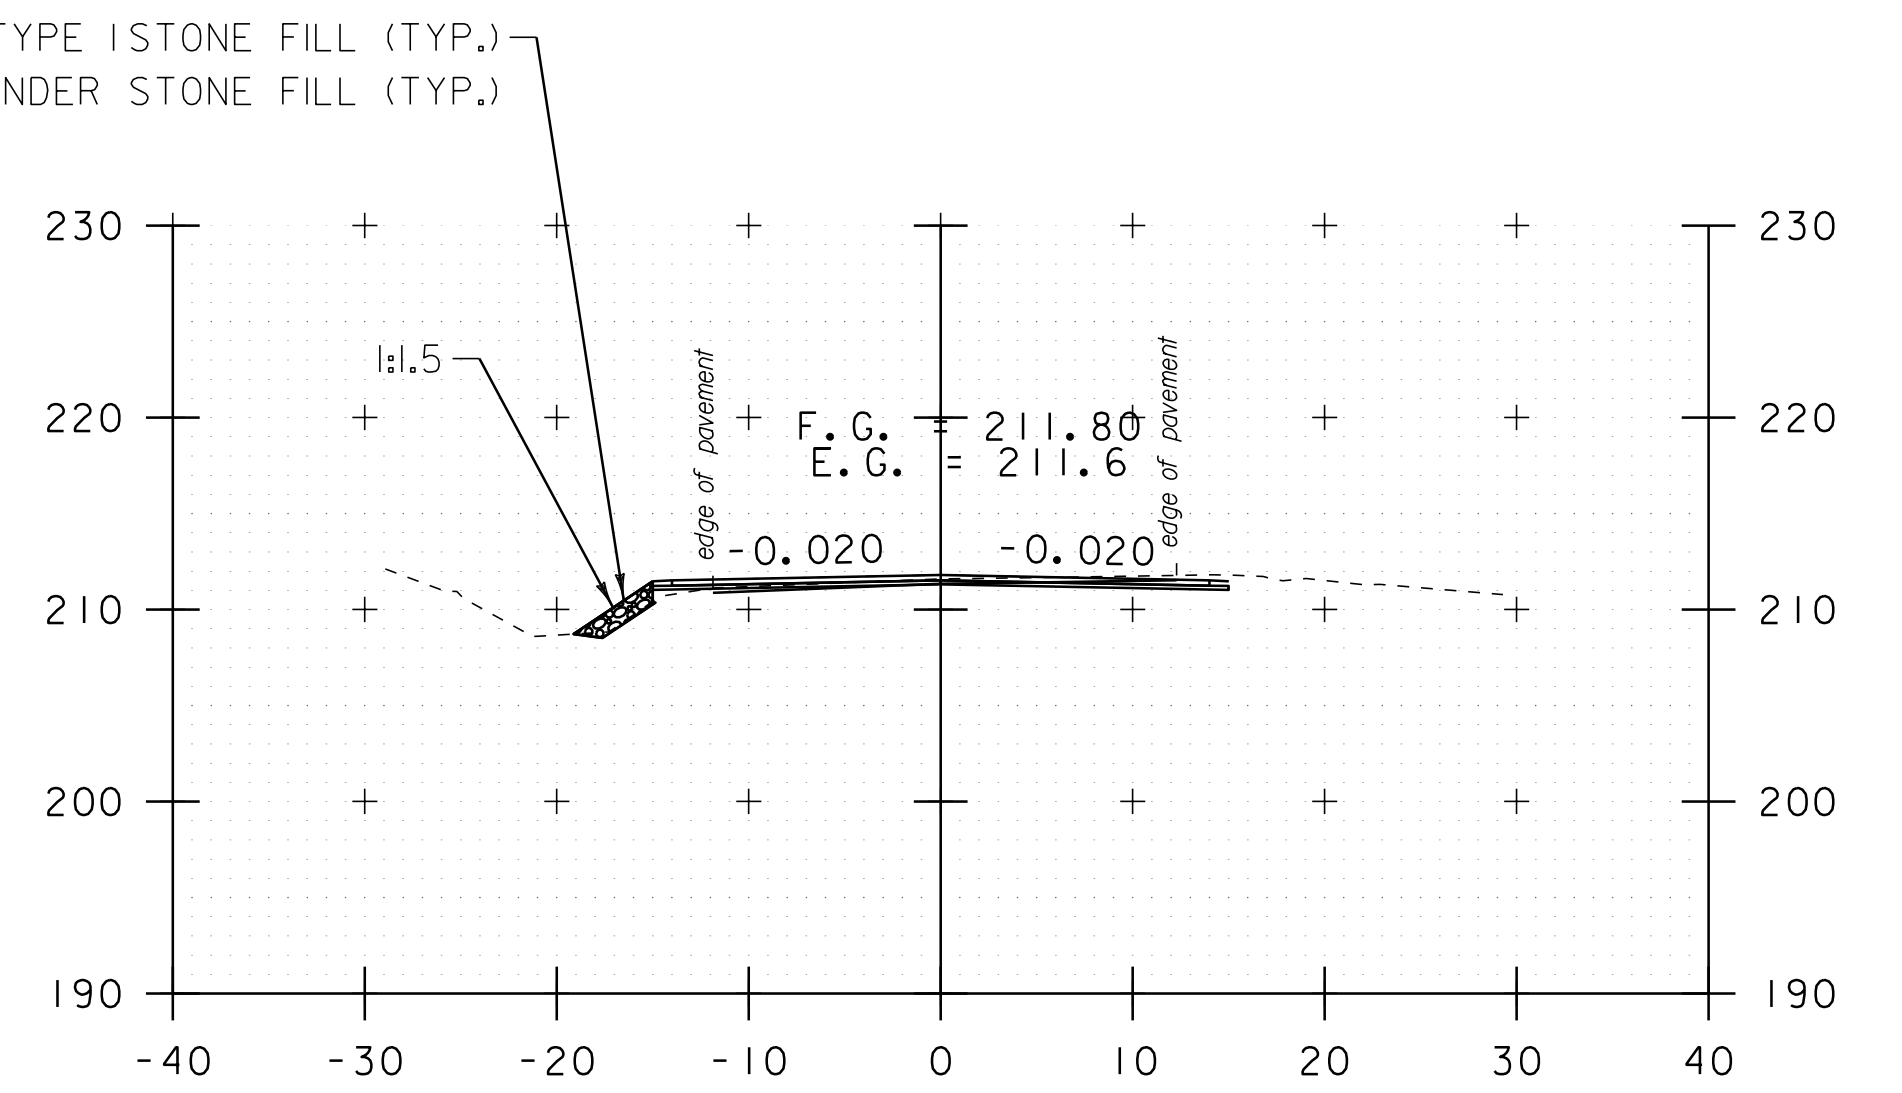


b 81+90

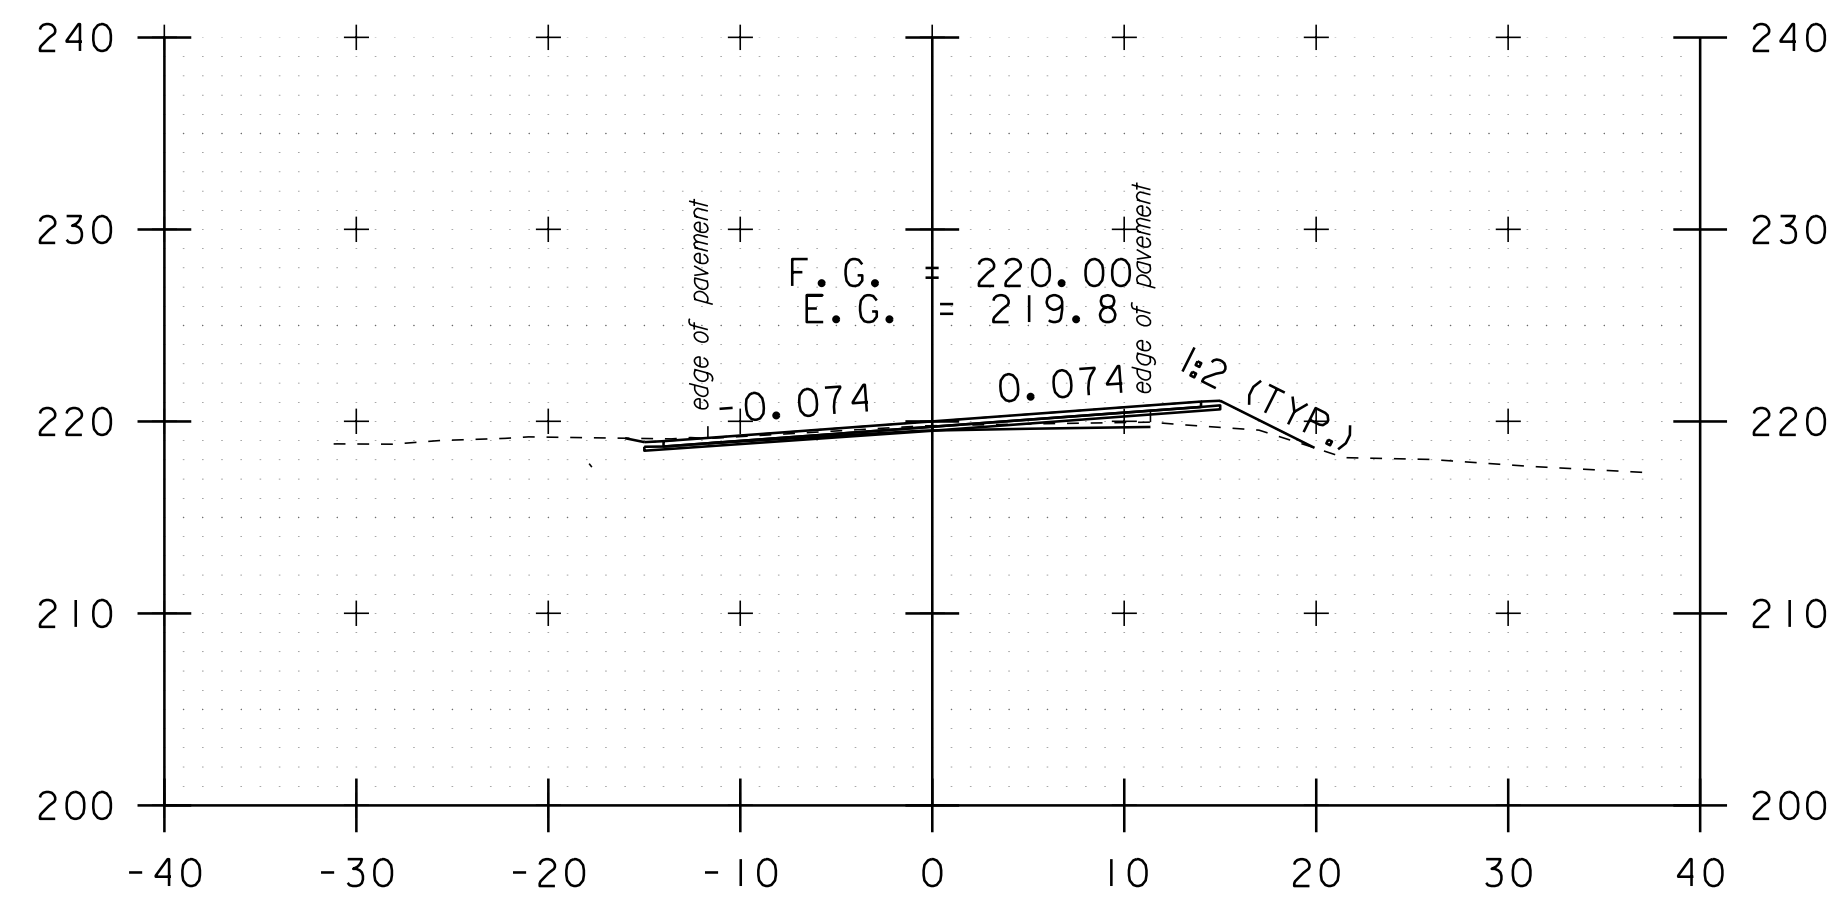


b 78+35
DRIVE LT

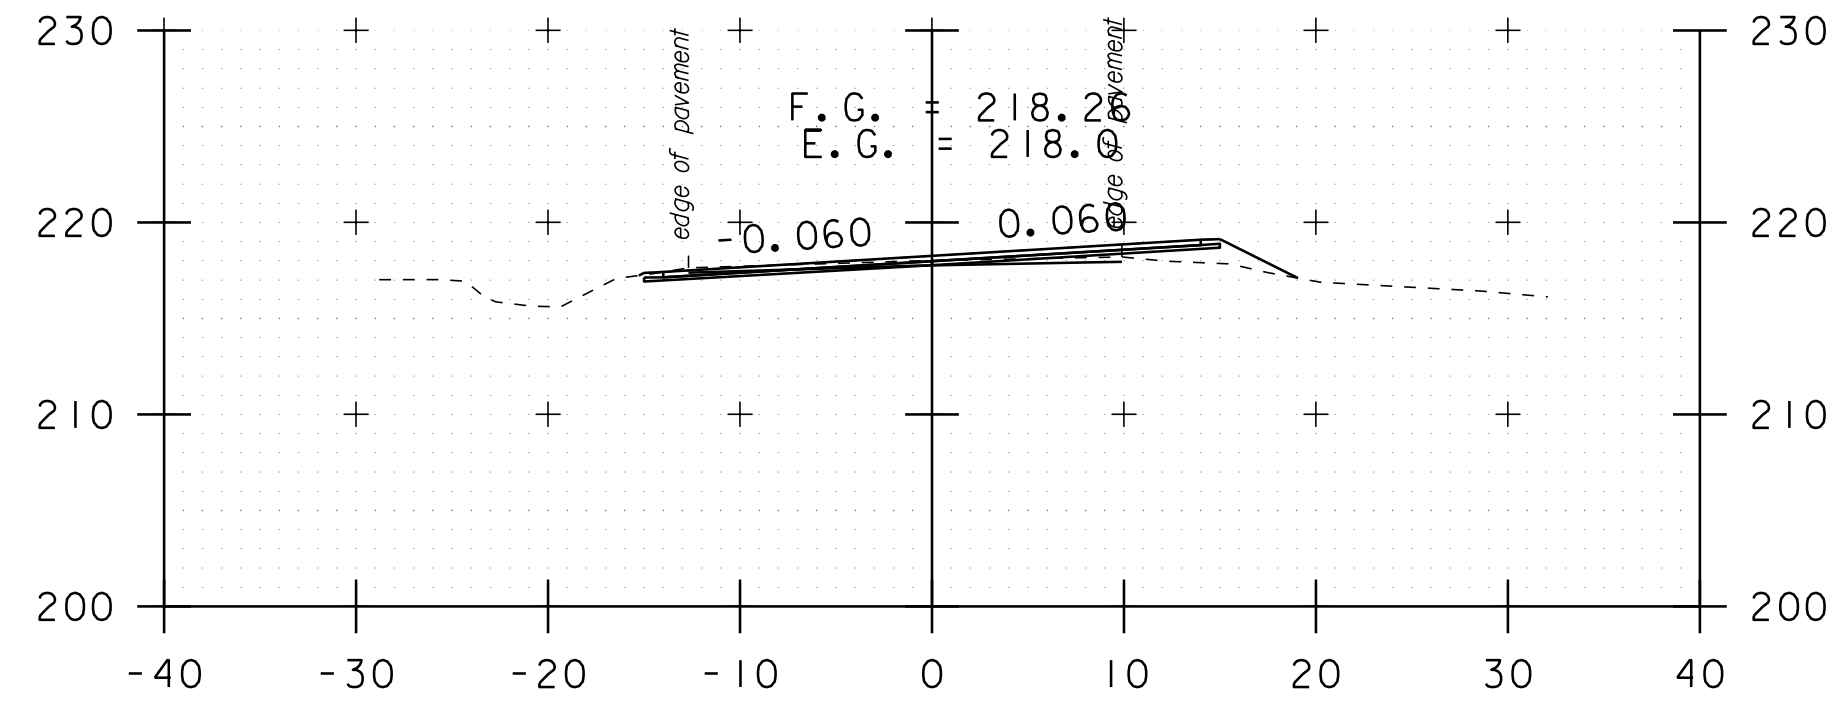


b 79+50

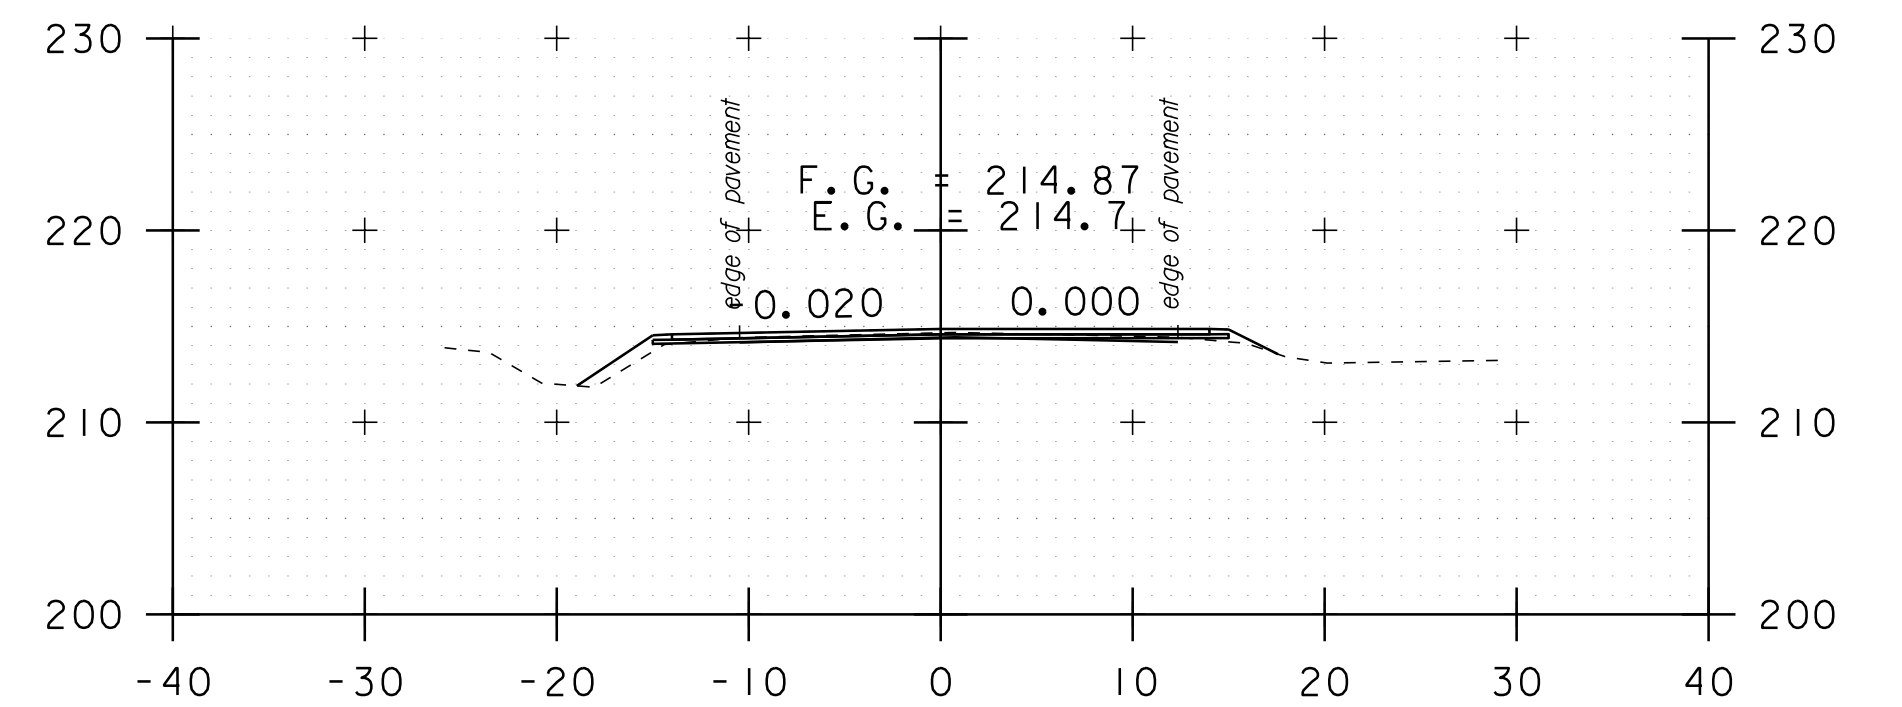


b 80+90

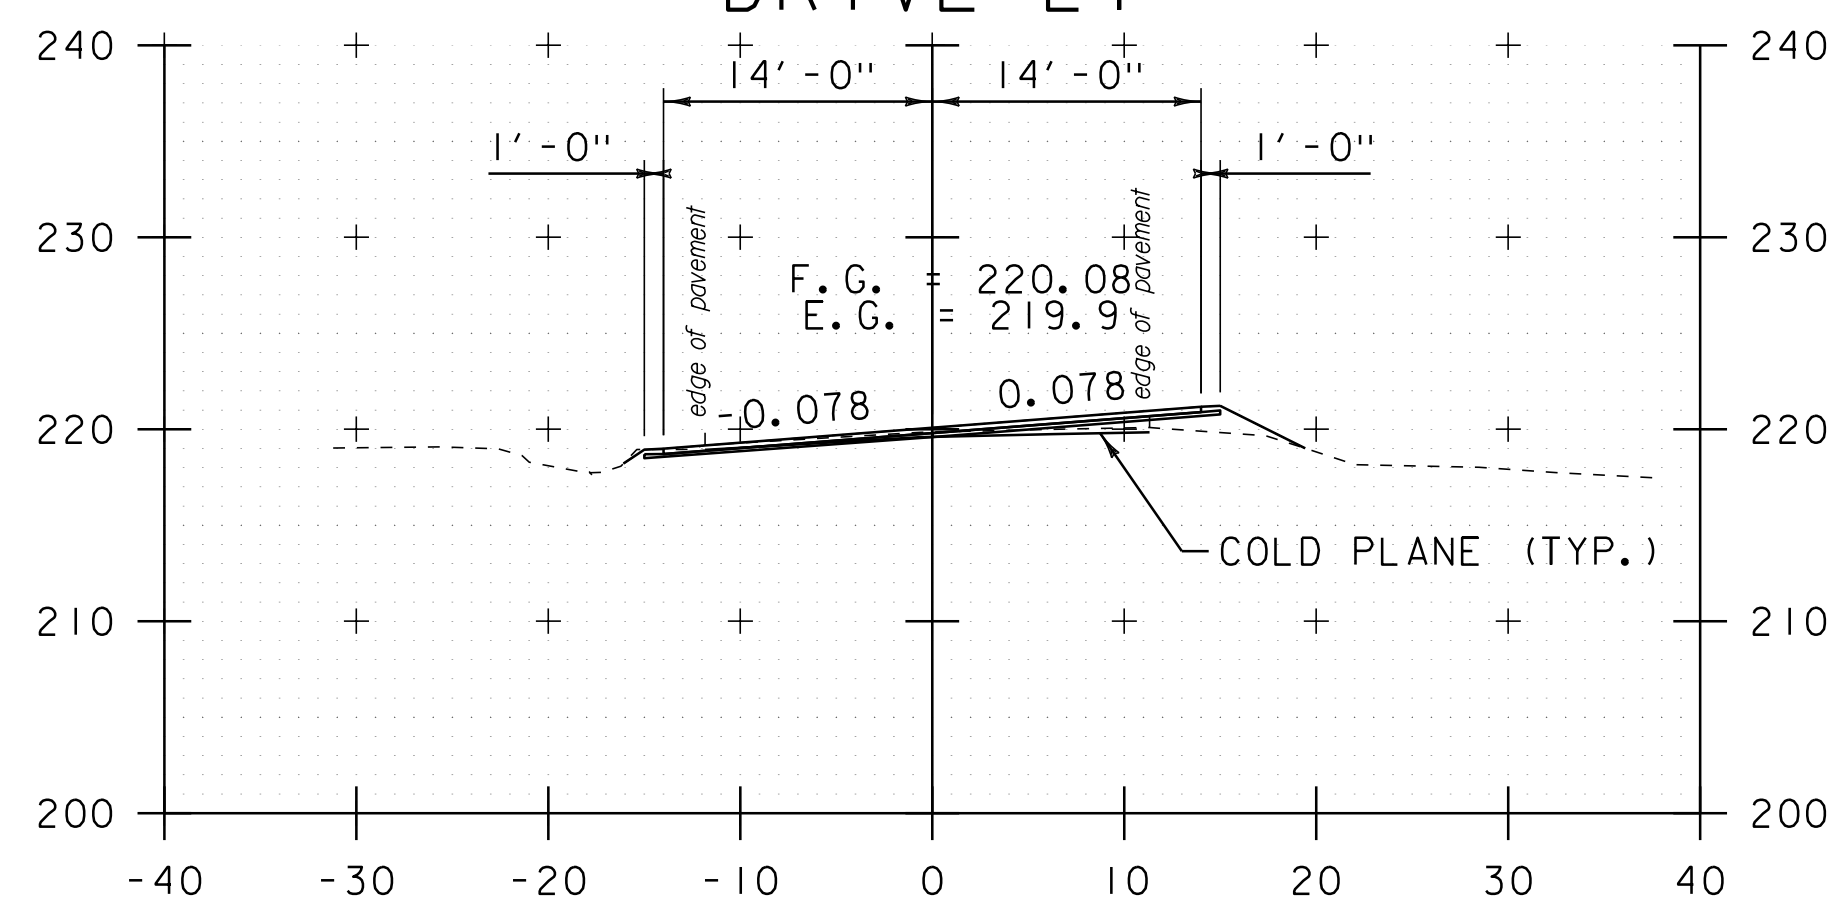

b 78+25

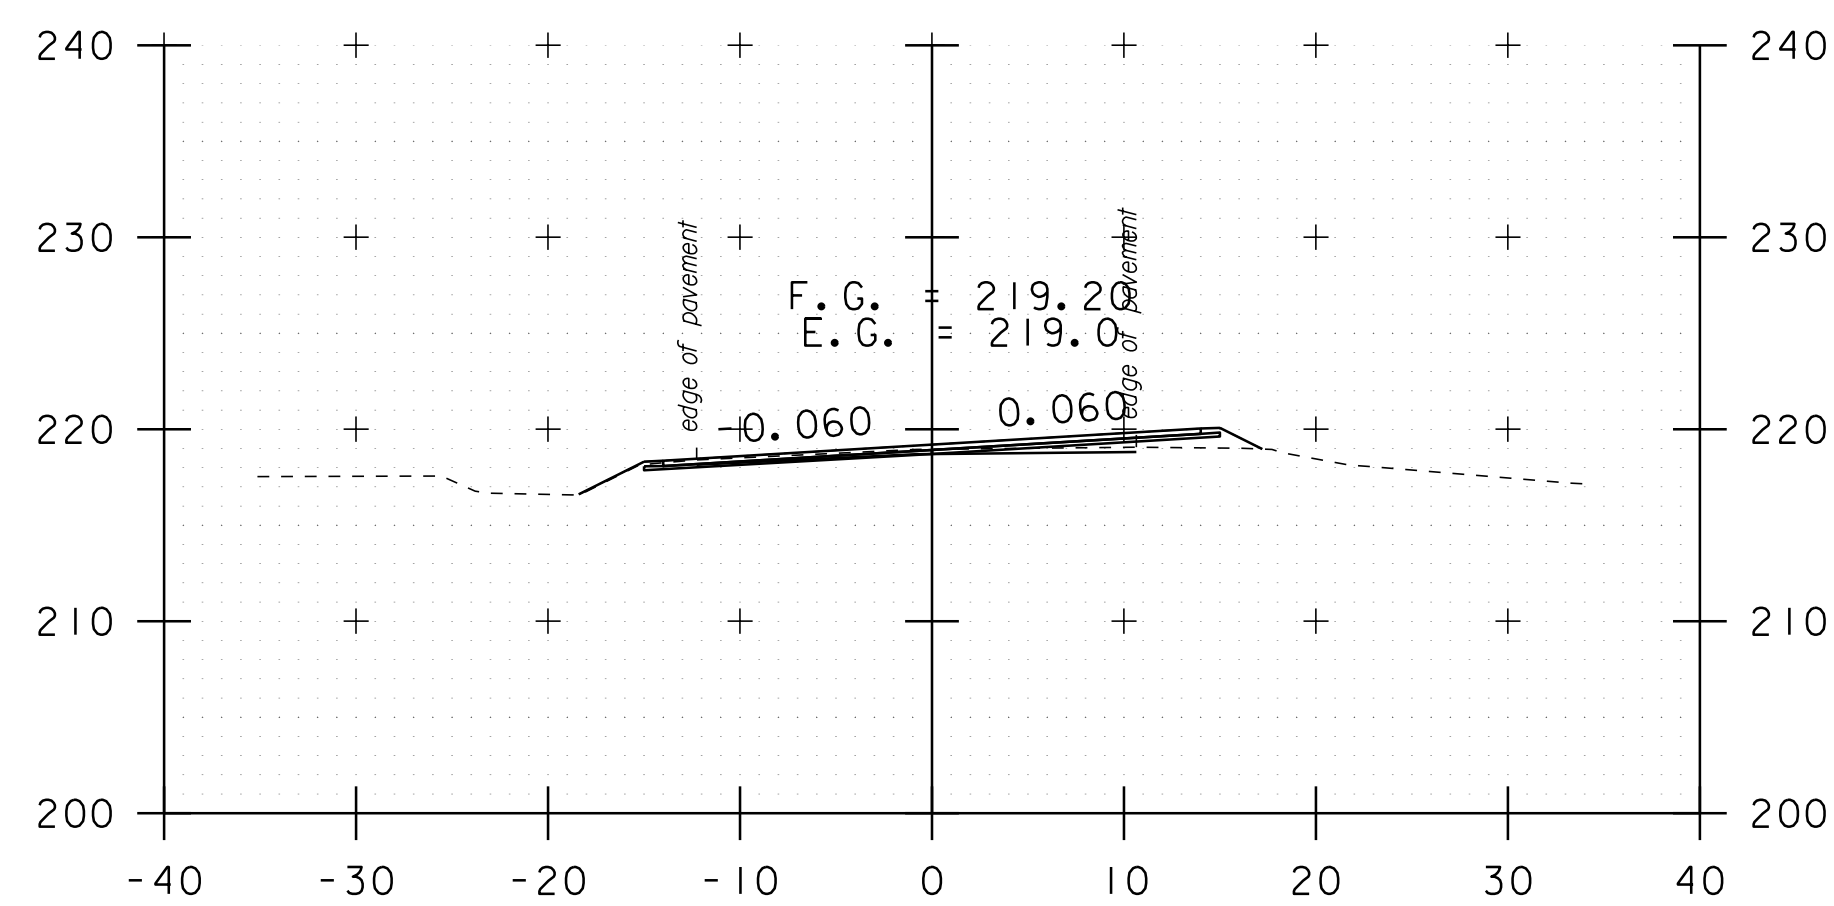


b 79+00

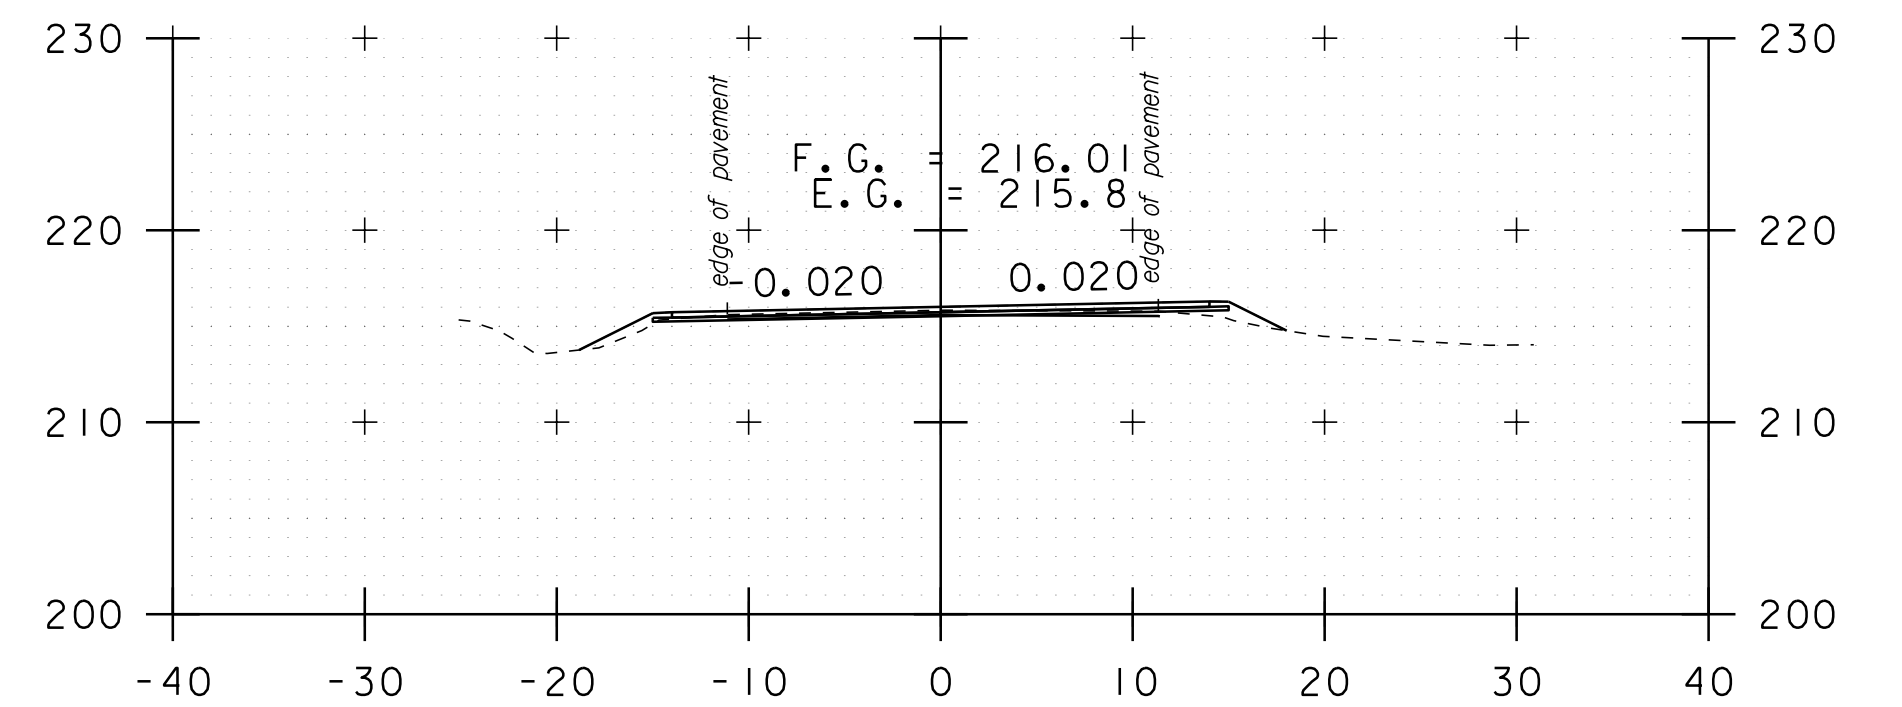

b 80+43

DATUM	NAVD 88
	NAD 83

STA. b 78+25 TO STA. b 81+90

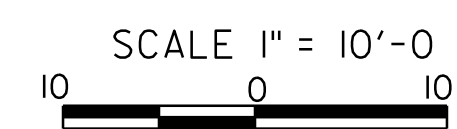

CROSS SECTION SHEET 33

PROJECT NAME:	ADDISON-NEW HAVEN	PLOT DATE:	3/13/2012
PROJECT NUMBER:	STP 9632(1)	DRAWN BY:	SJL
FILE NAME:	p95B076.dgn	CHECKED BY:	EPD
PROJECT LEADER:	CDL	SHEET	138 OF 186
DESIGNED BY:	SJL		
PLOT FILE:	p95B076_I38.1		