




b 83+80

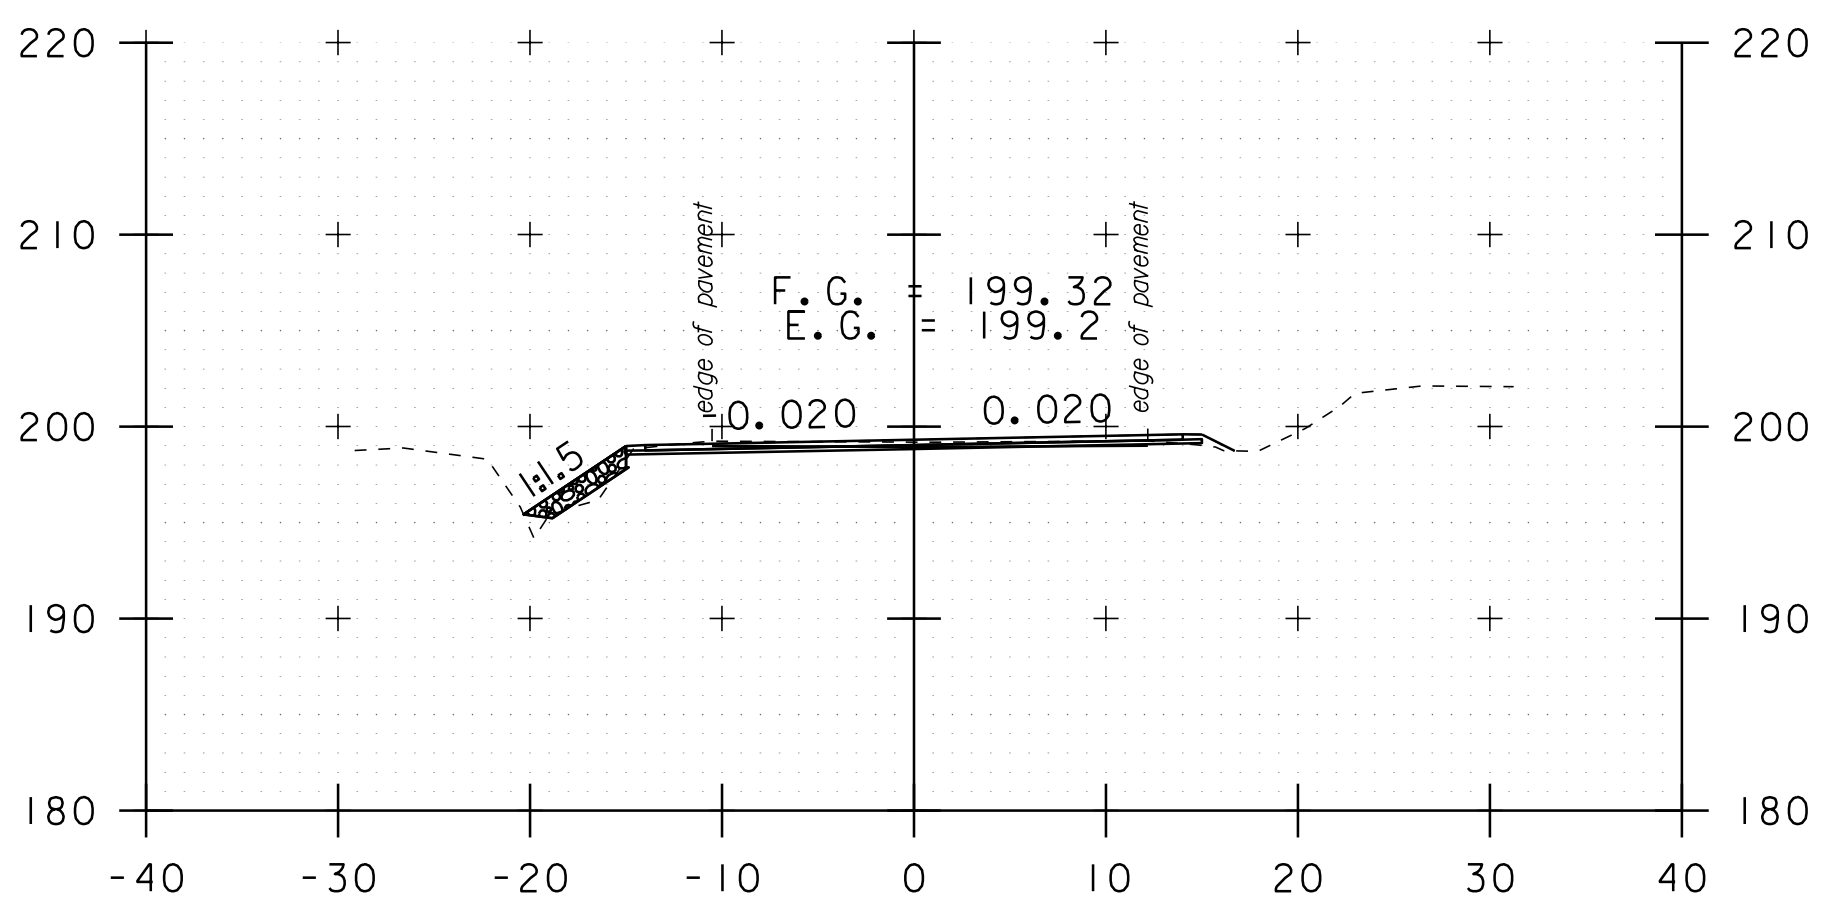


b 86+20

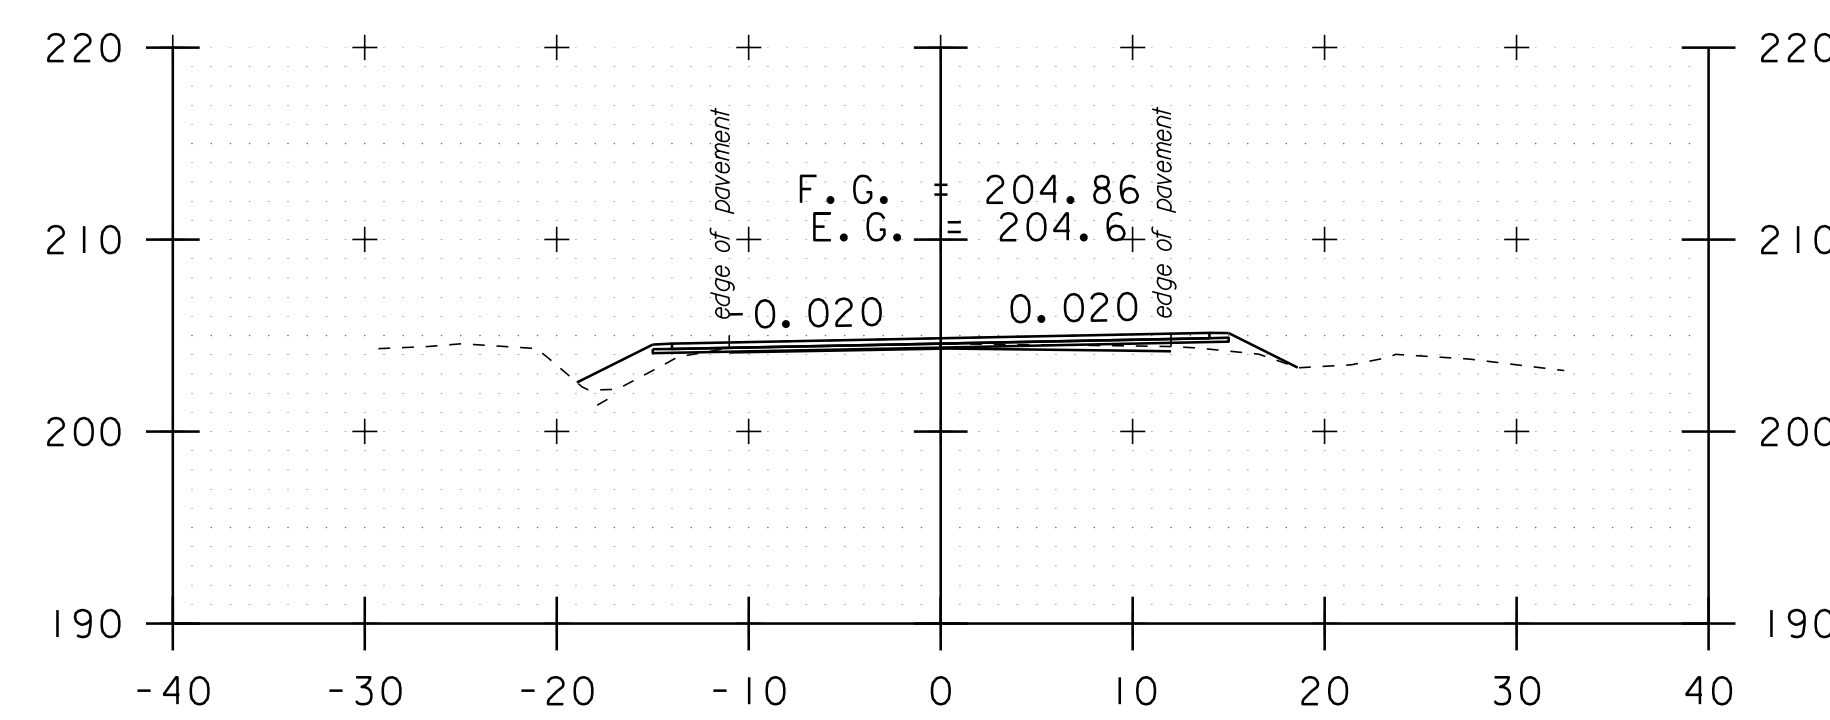


b 87+50

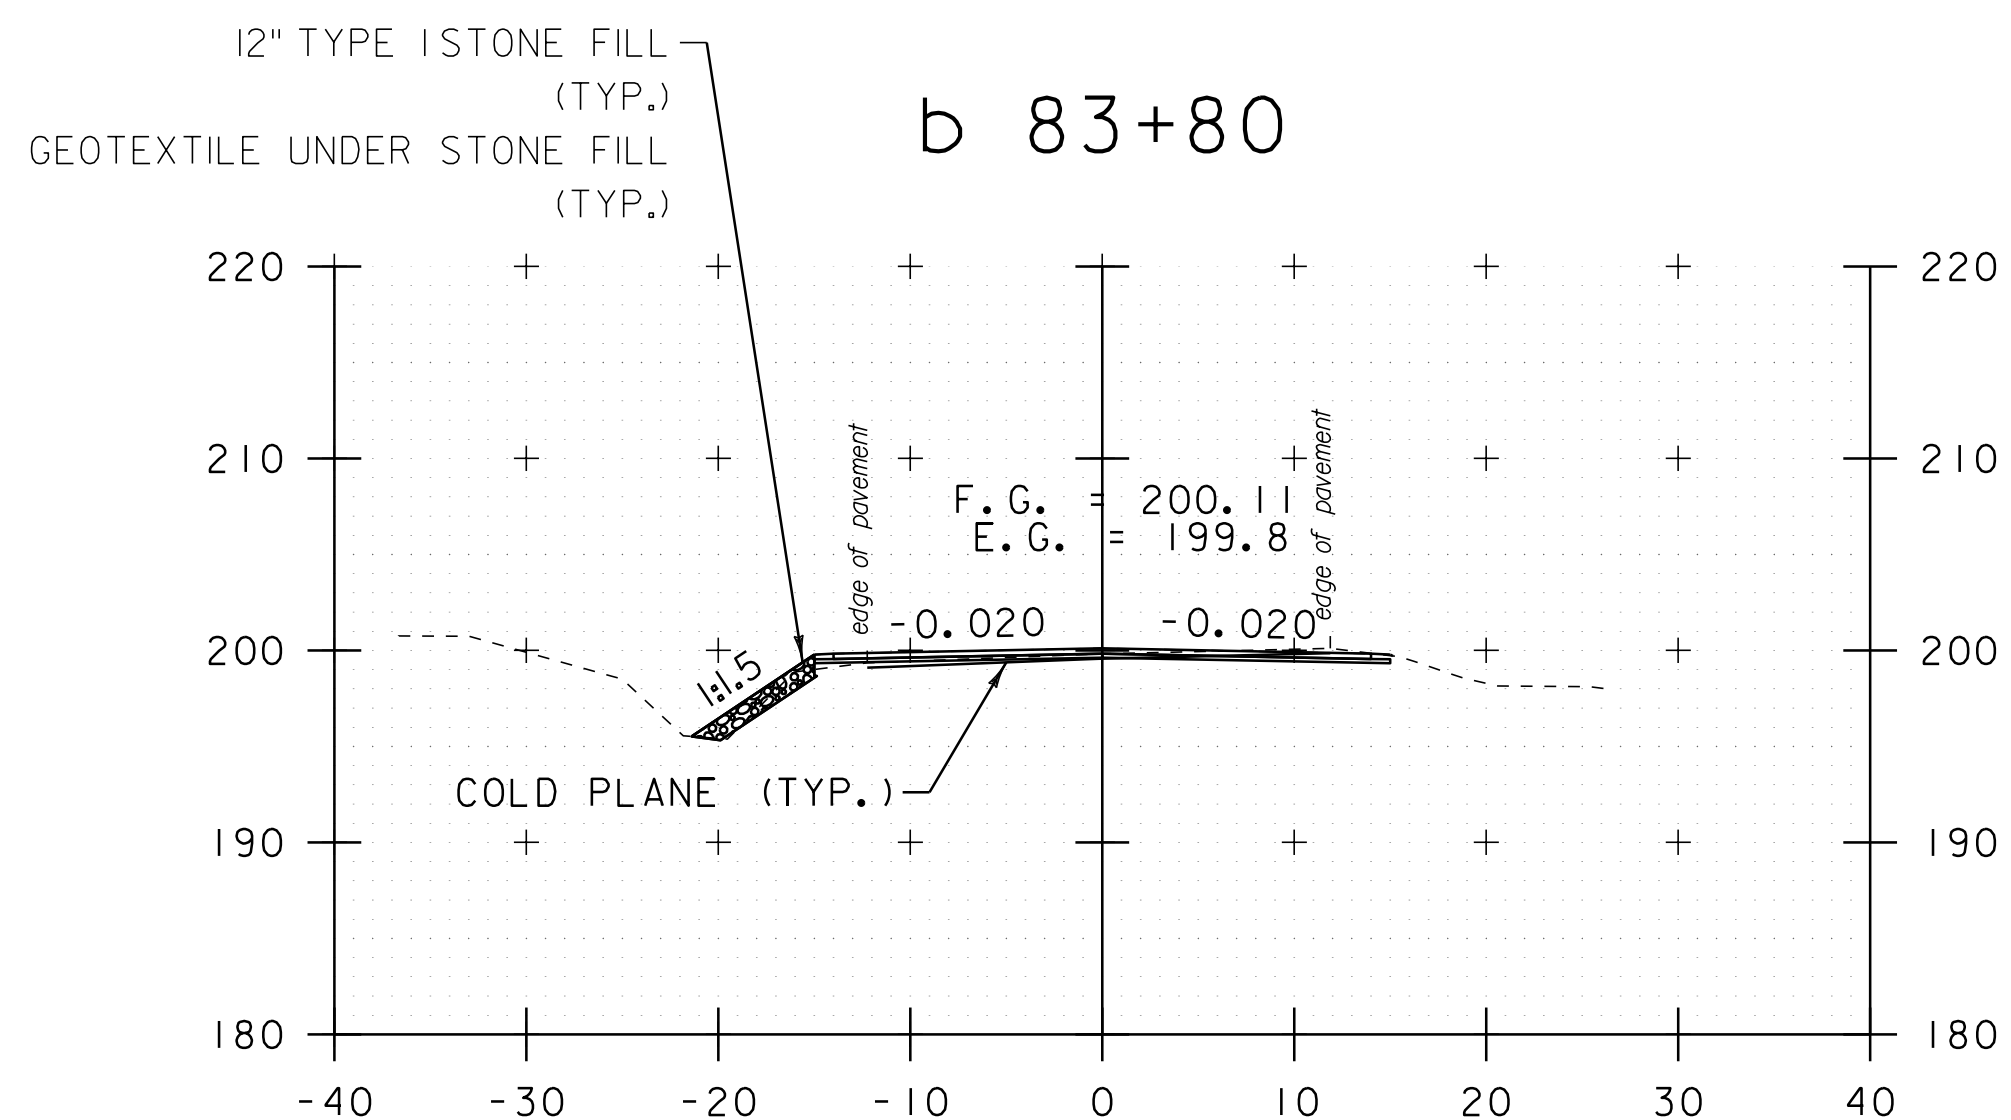


b 83+50

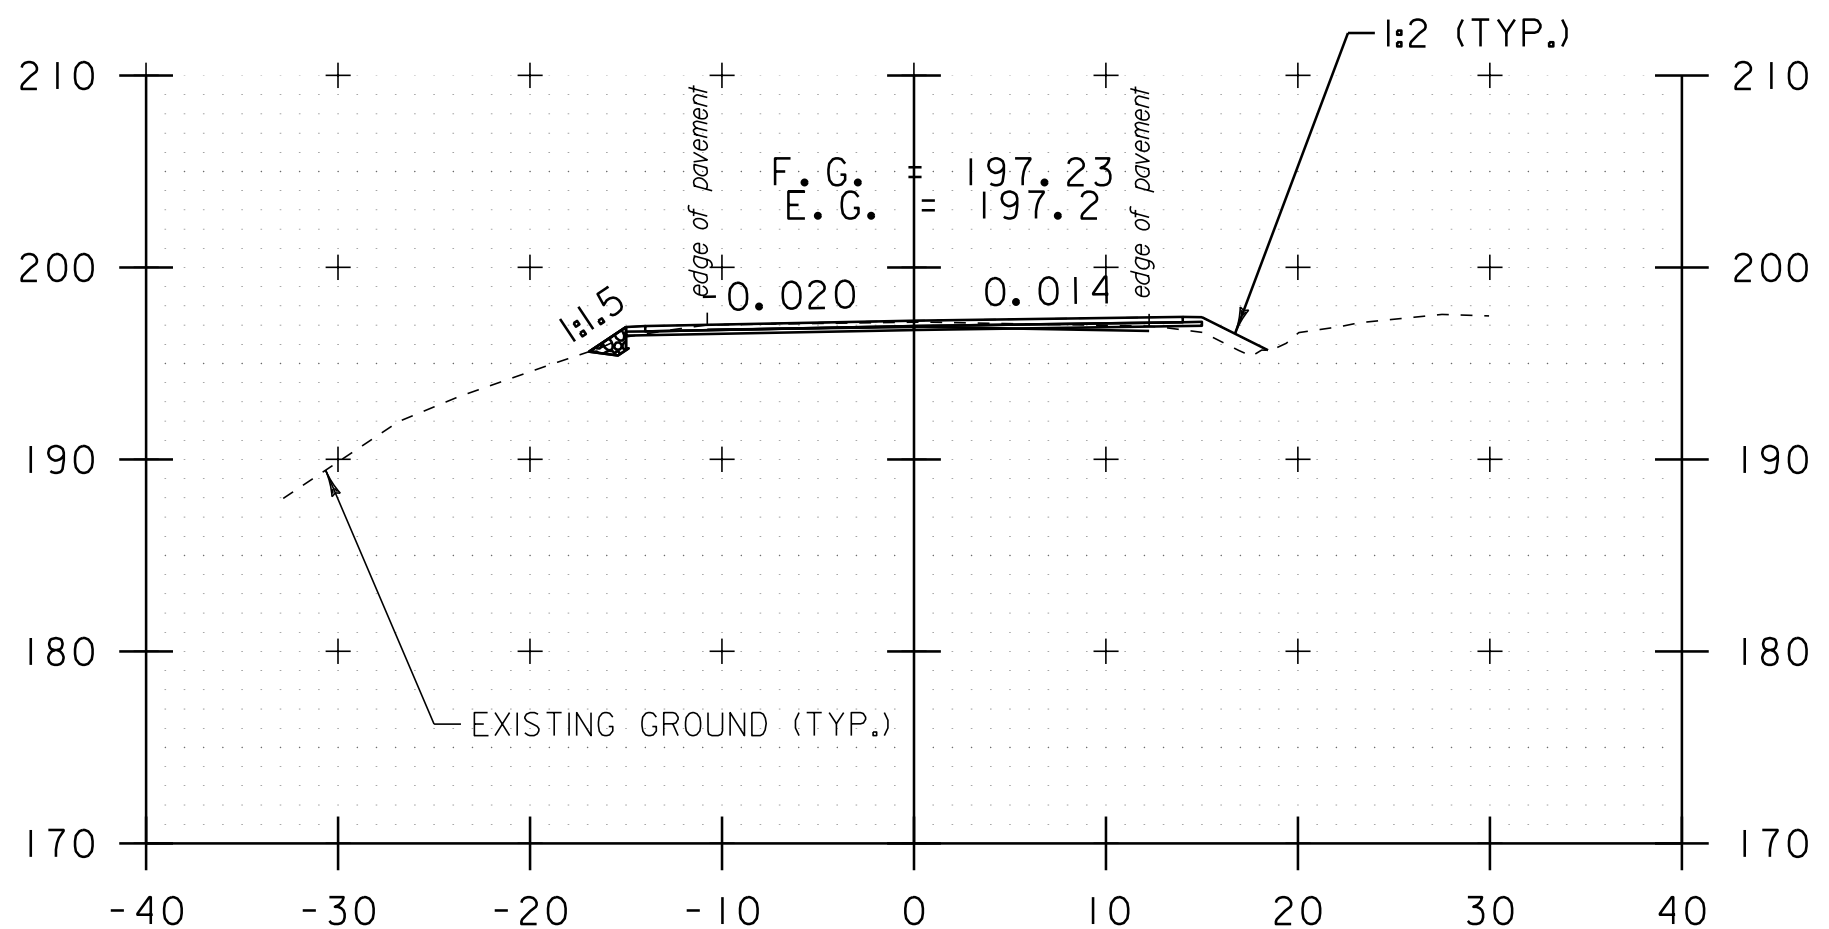


b 85+78

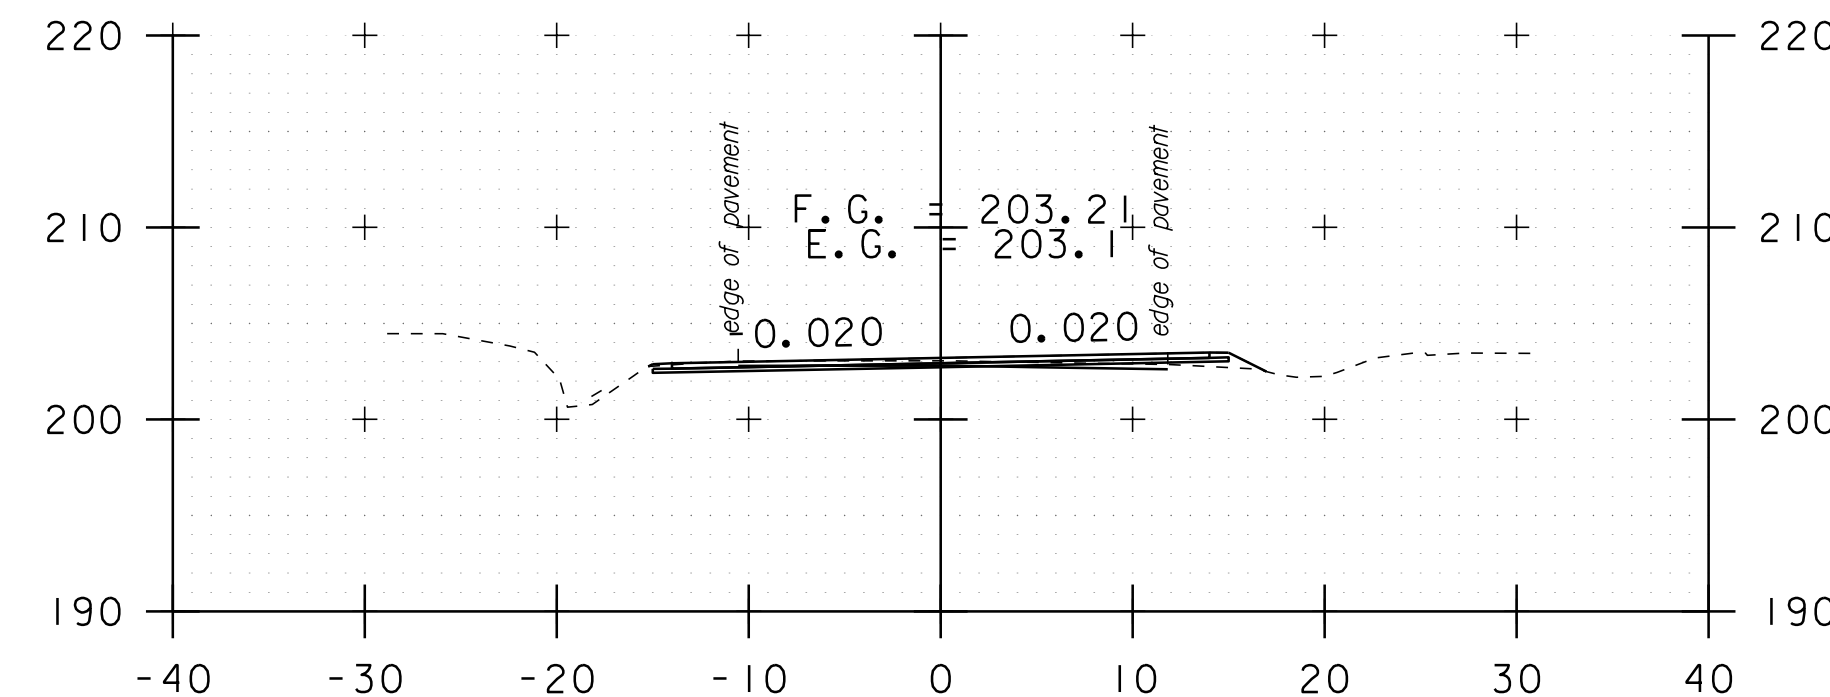


b 87+00

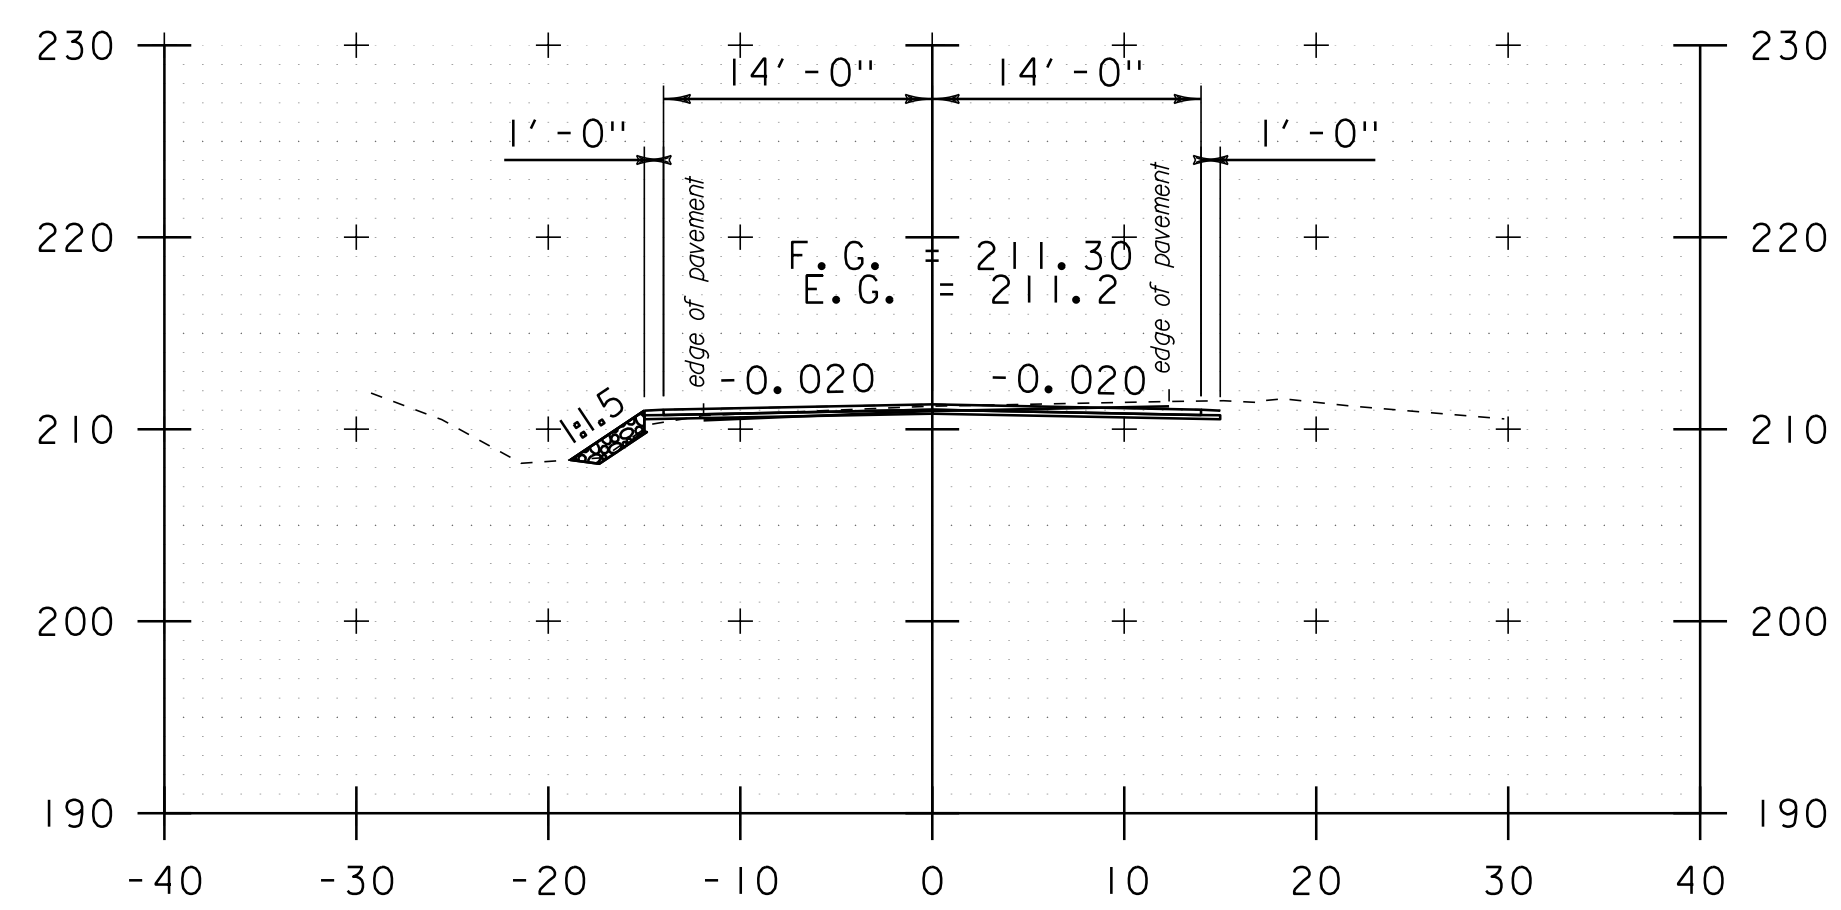

b 82+00

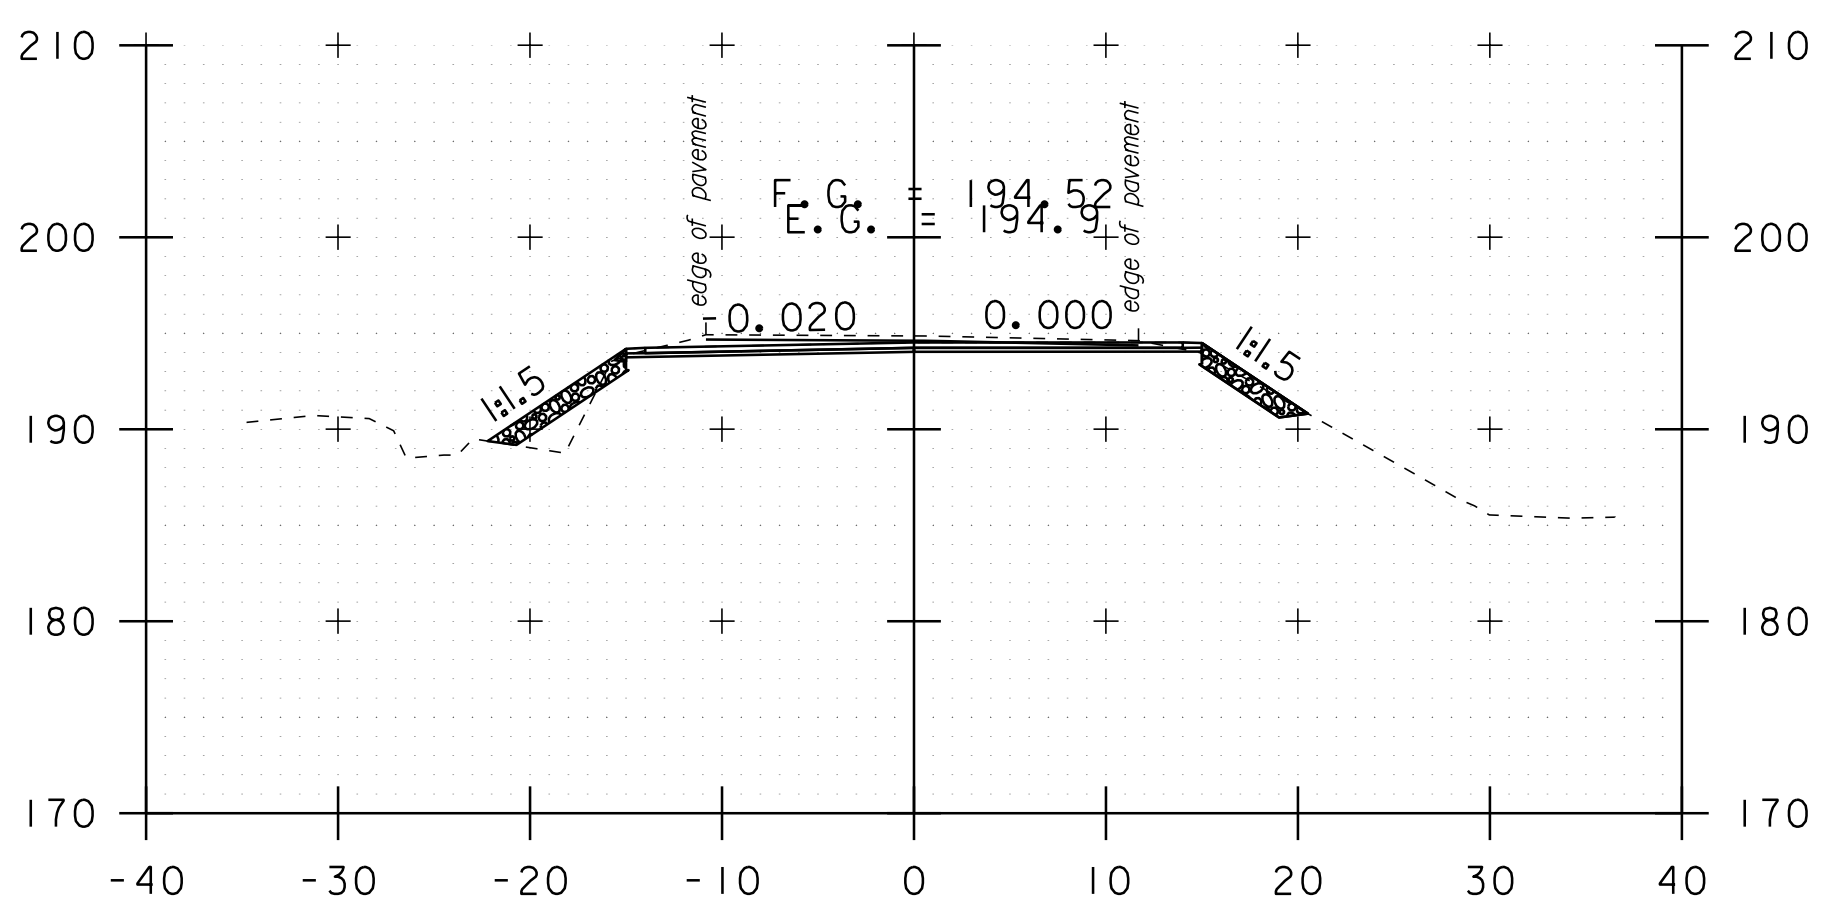


b 84+80

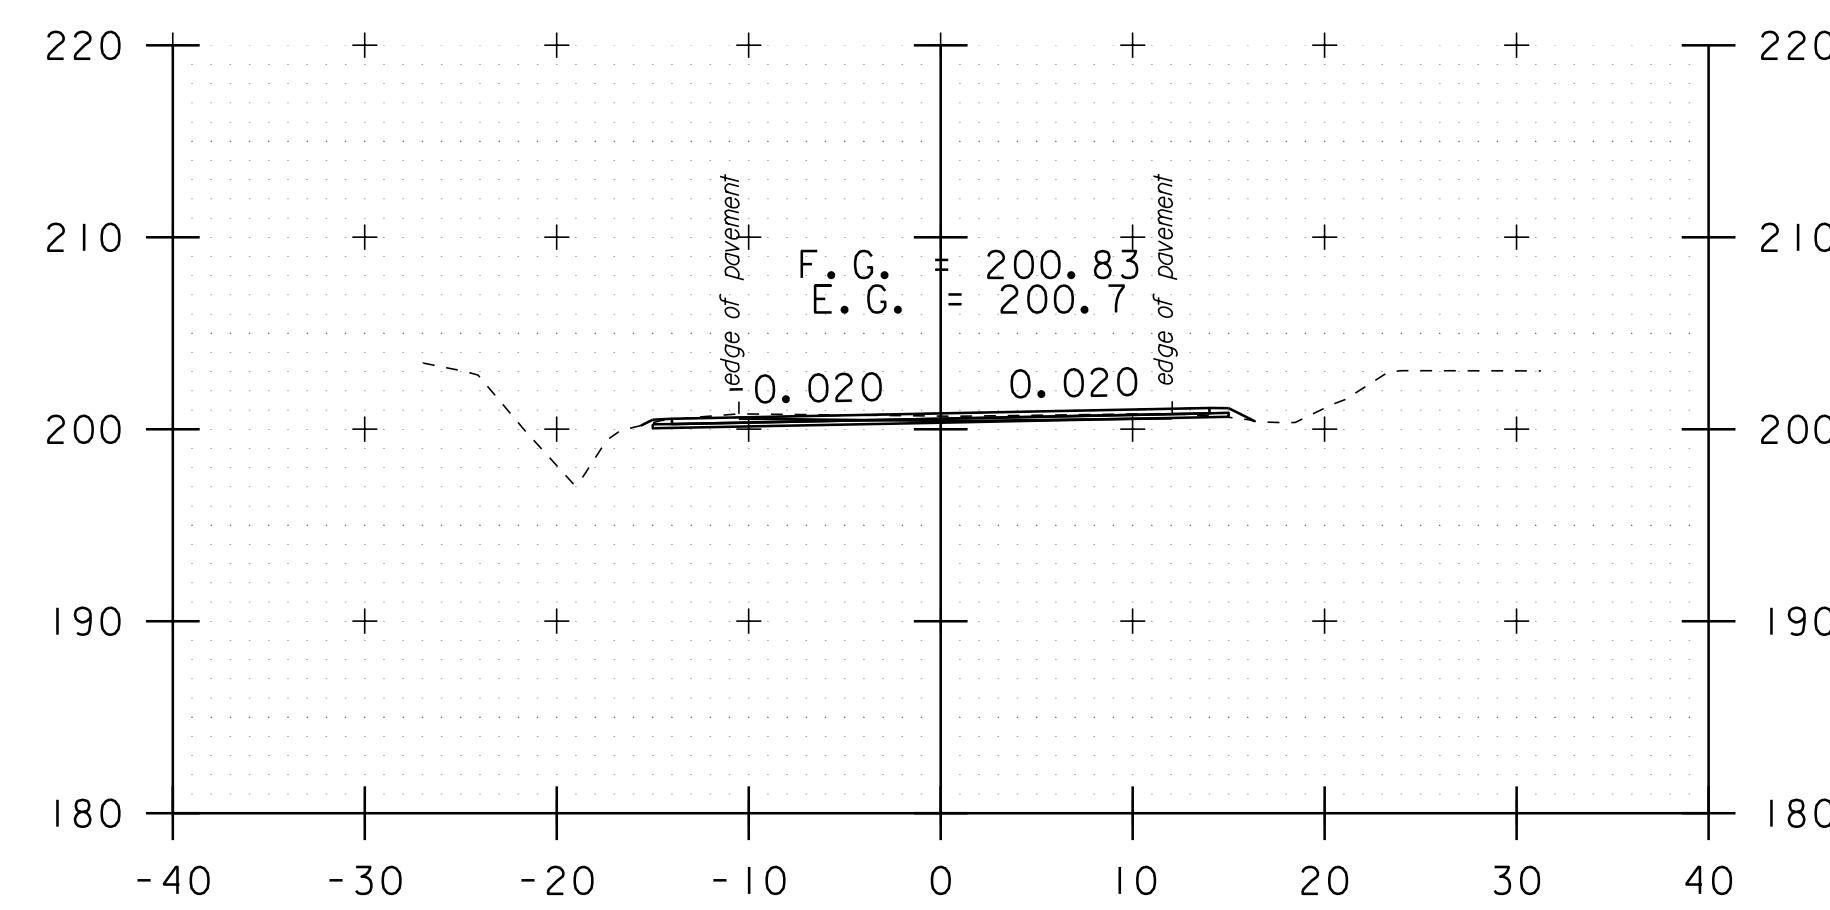

b 86+50

DATUM
 NAVD 88
 NAD 83

STA. b 82+00 TO STA. b 87+50

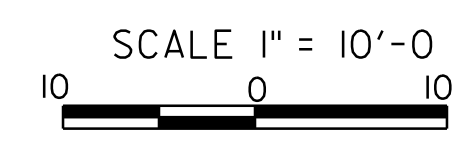

CROSS SECTION SHEET 34

PROJECT NAME: ADDISON-NEW HAVEN
 PROJECT NUMBER: STP 9632(1)
 FILE NAME: p95B076.dgn
 PROJECT LEADER: CDL
 DESIGNED BY: SJL
 PLOT FILE: p95B076_139.1
 PLOT DATE: 3/13/2012
 DRAWN BY: SJL
 CHECKED BY: EPD
 SHEET 139 OF 186