




b 102+50

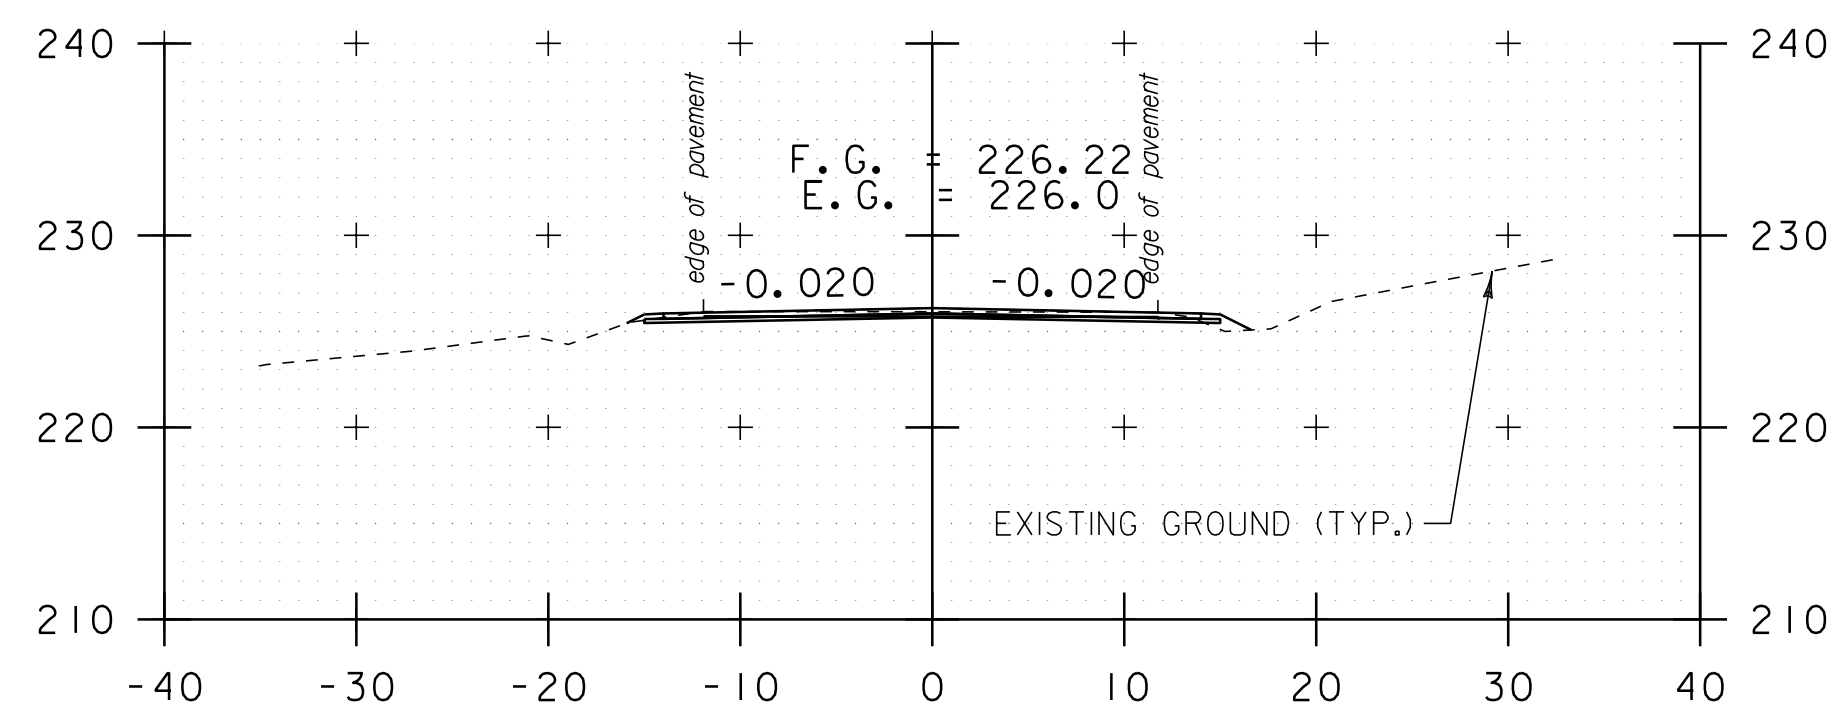


b 102+15

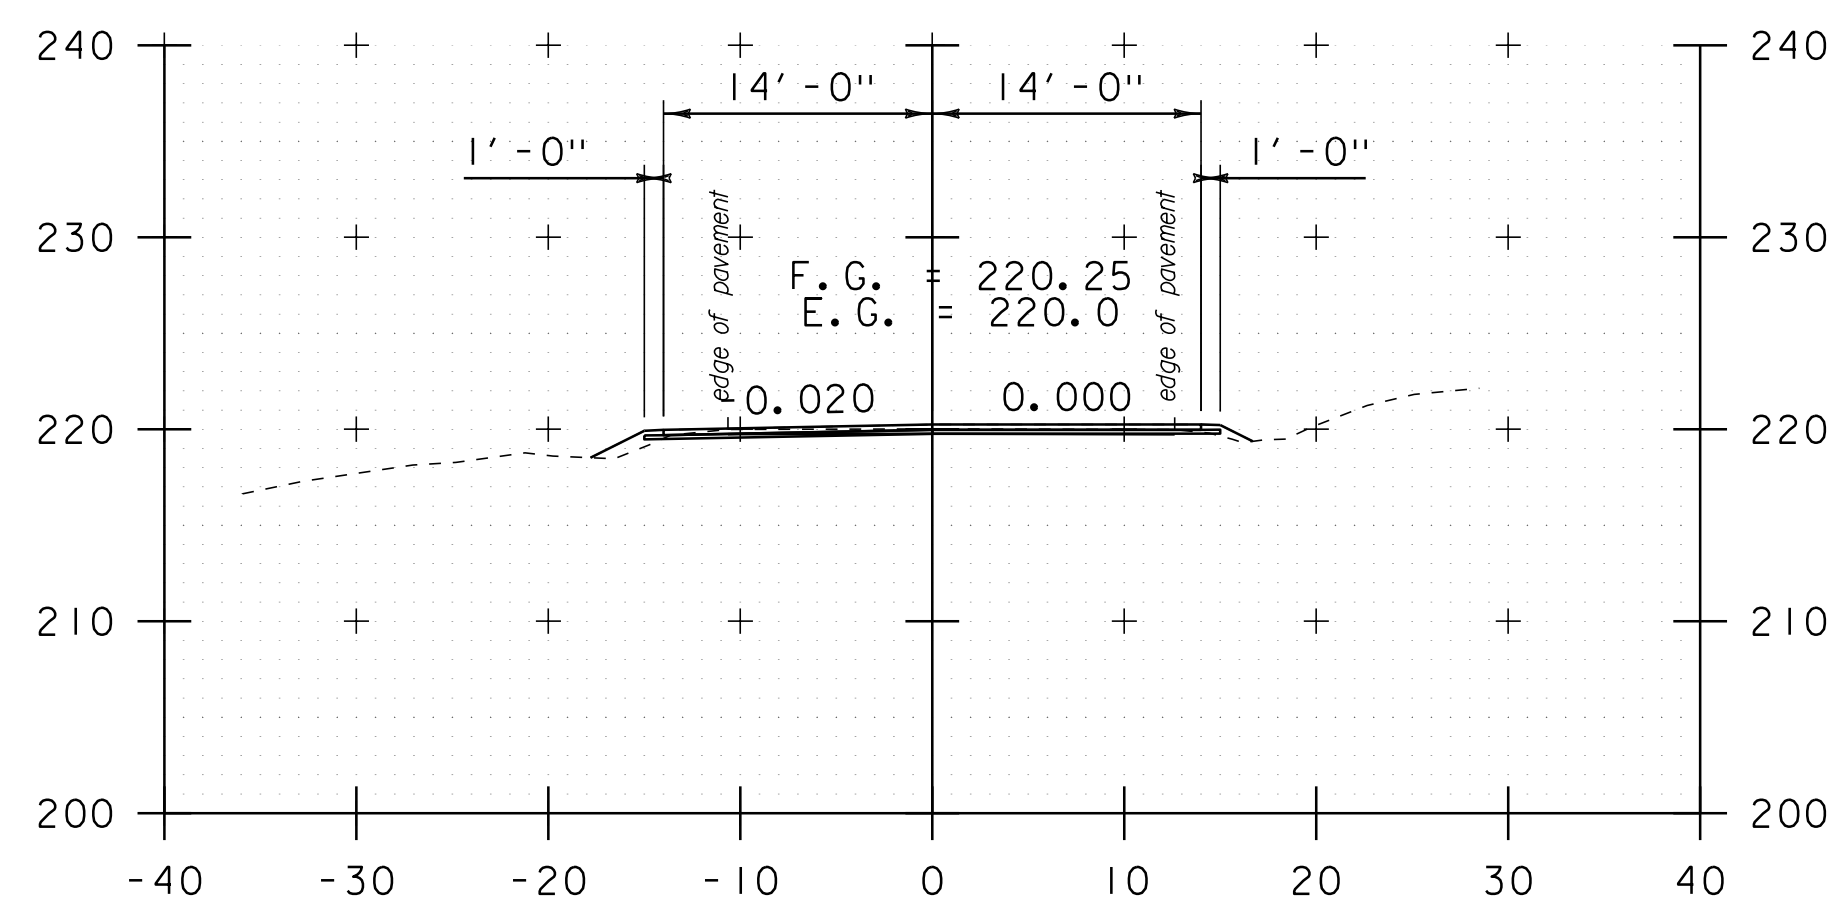


b 101+15

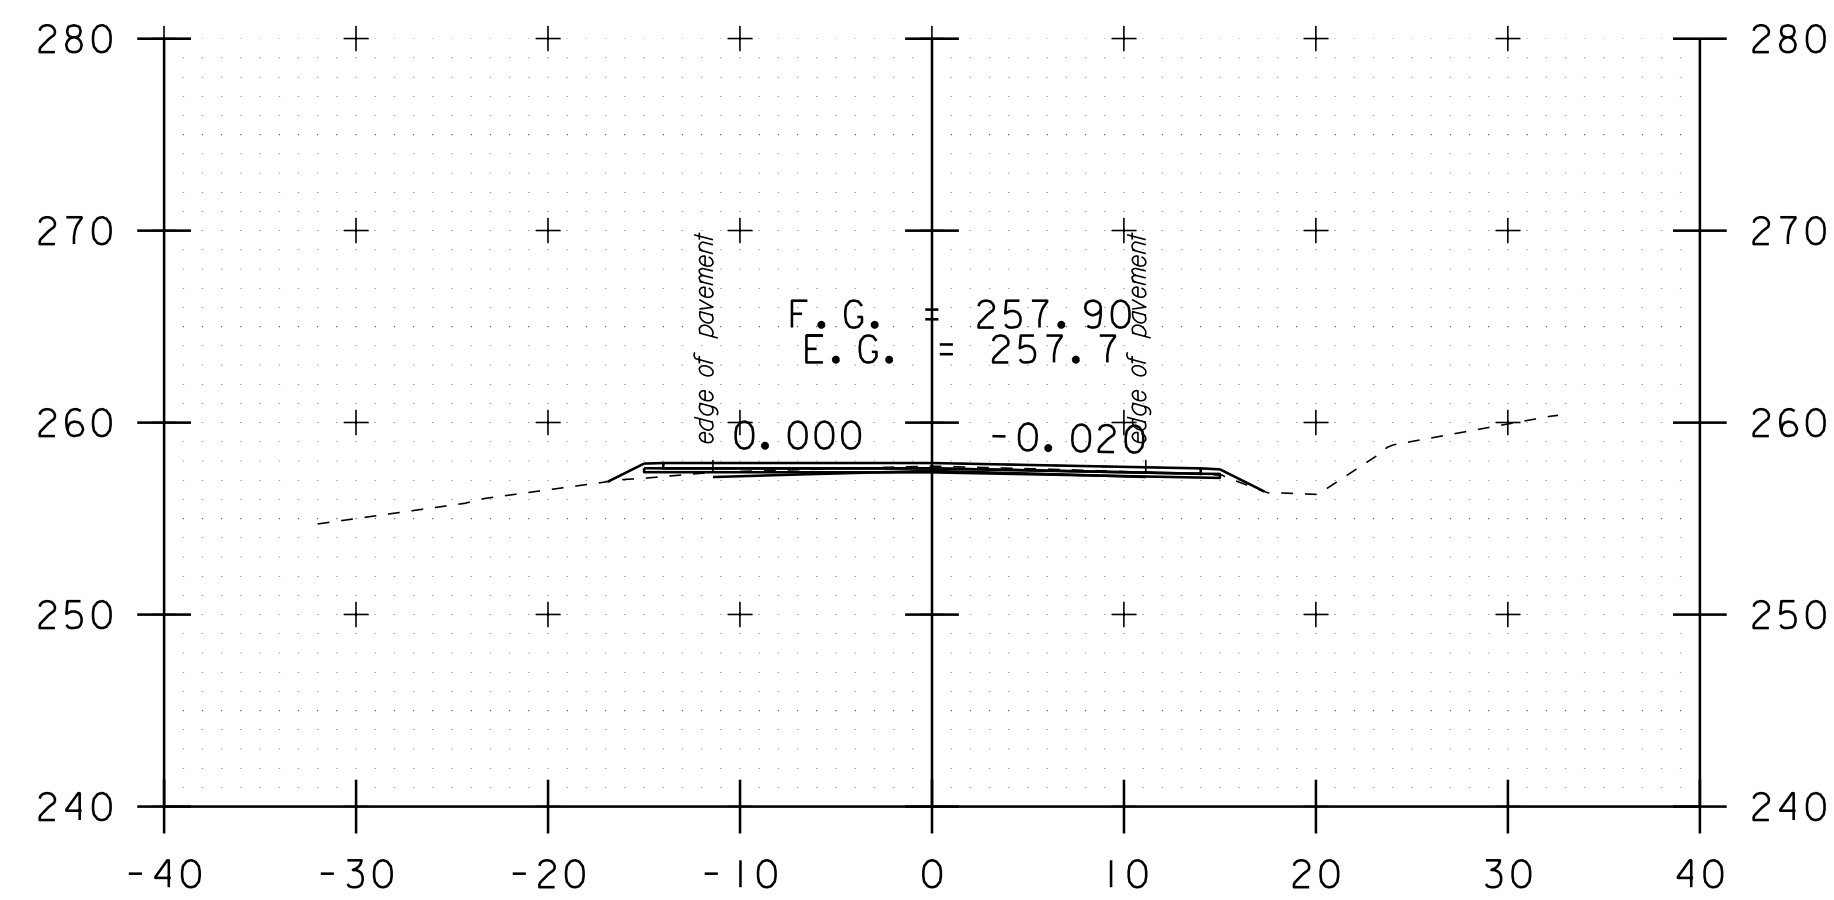


b 106+65

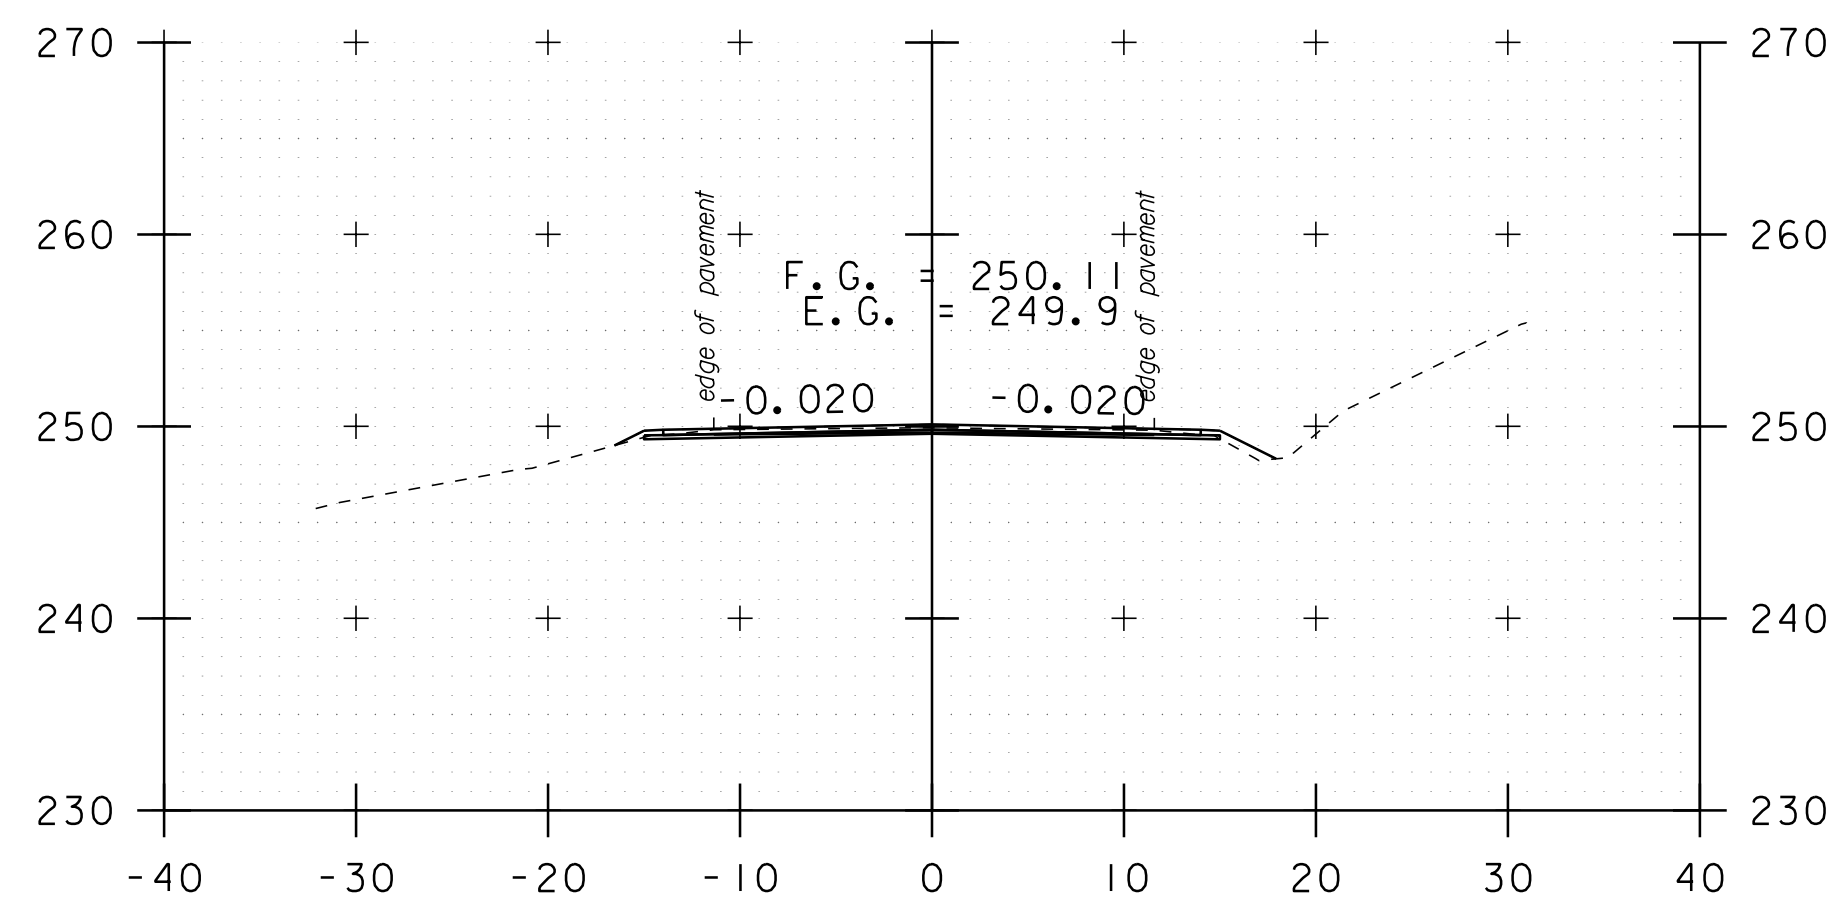


b 105+65

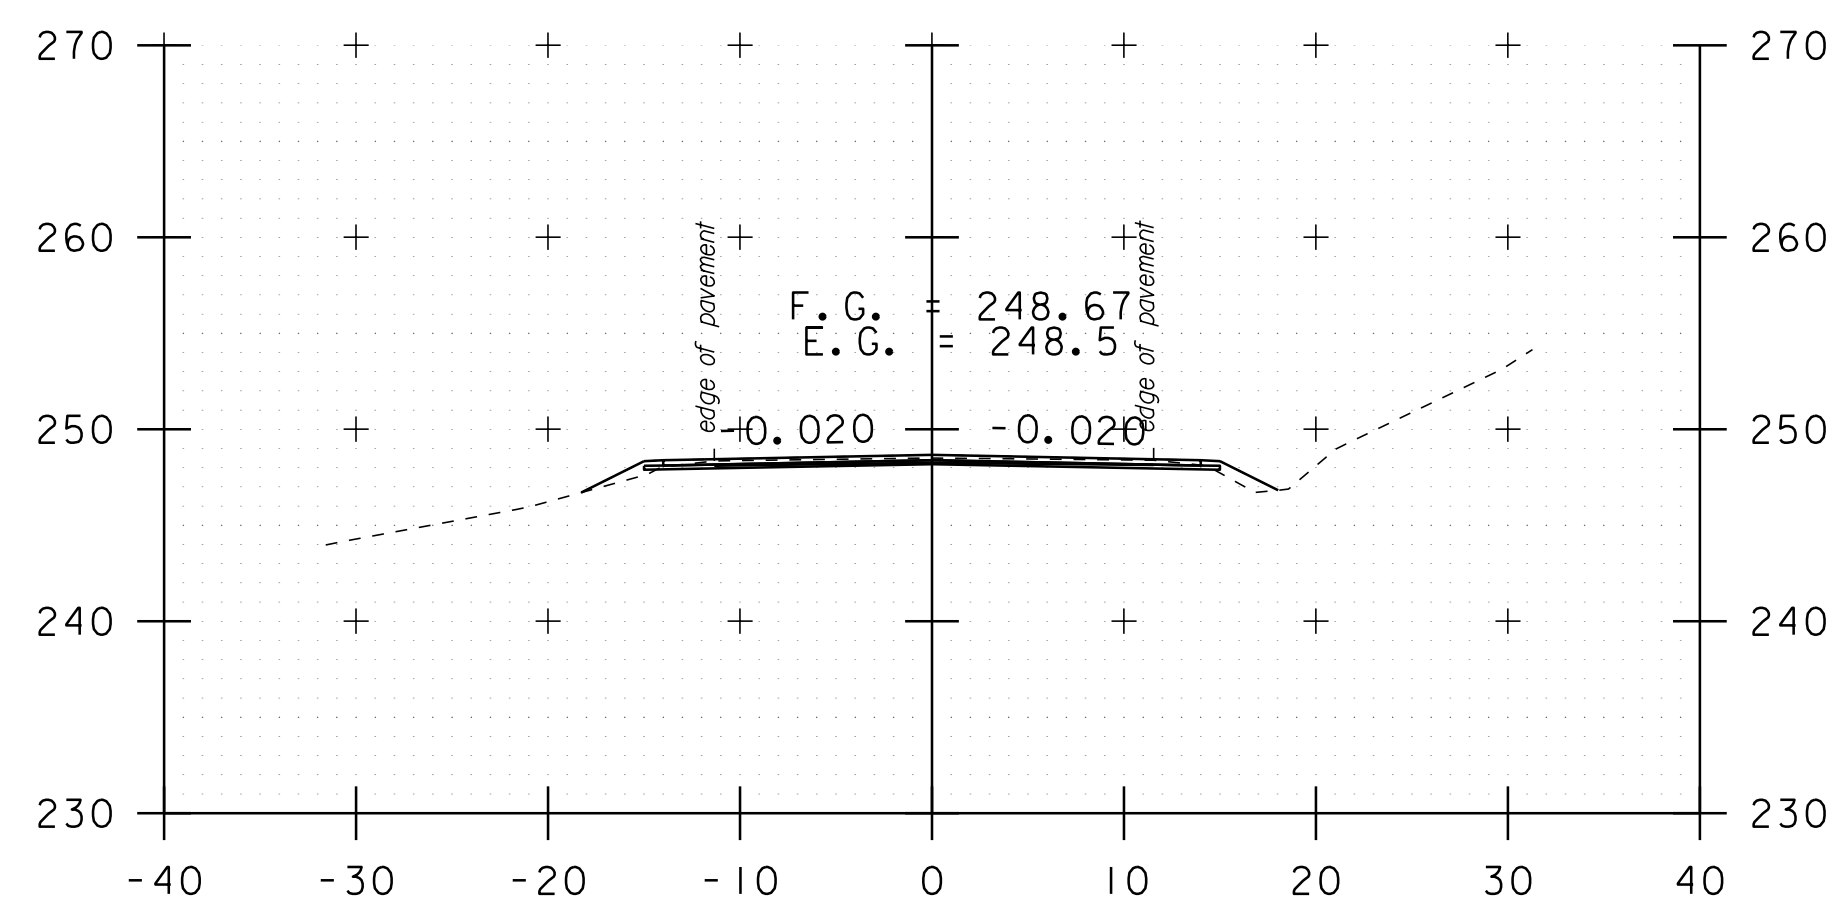


b 105+50

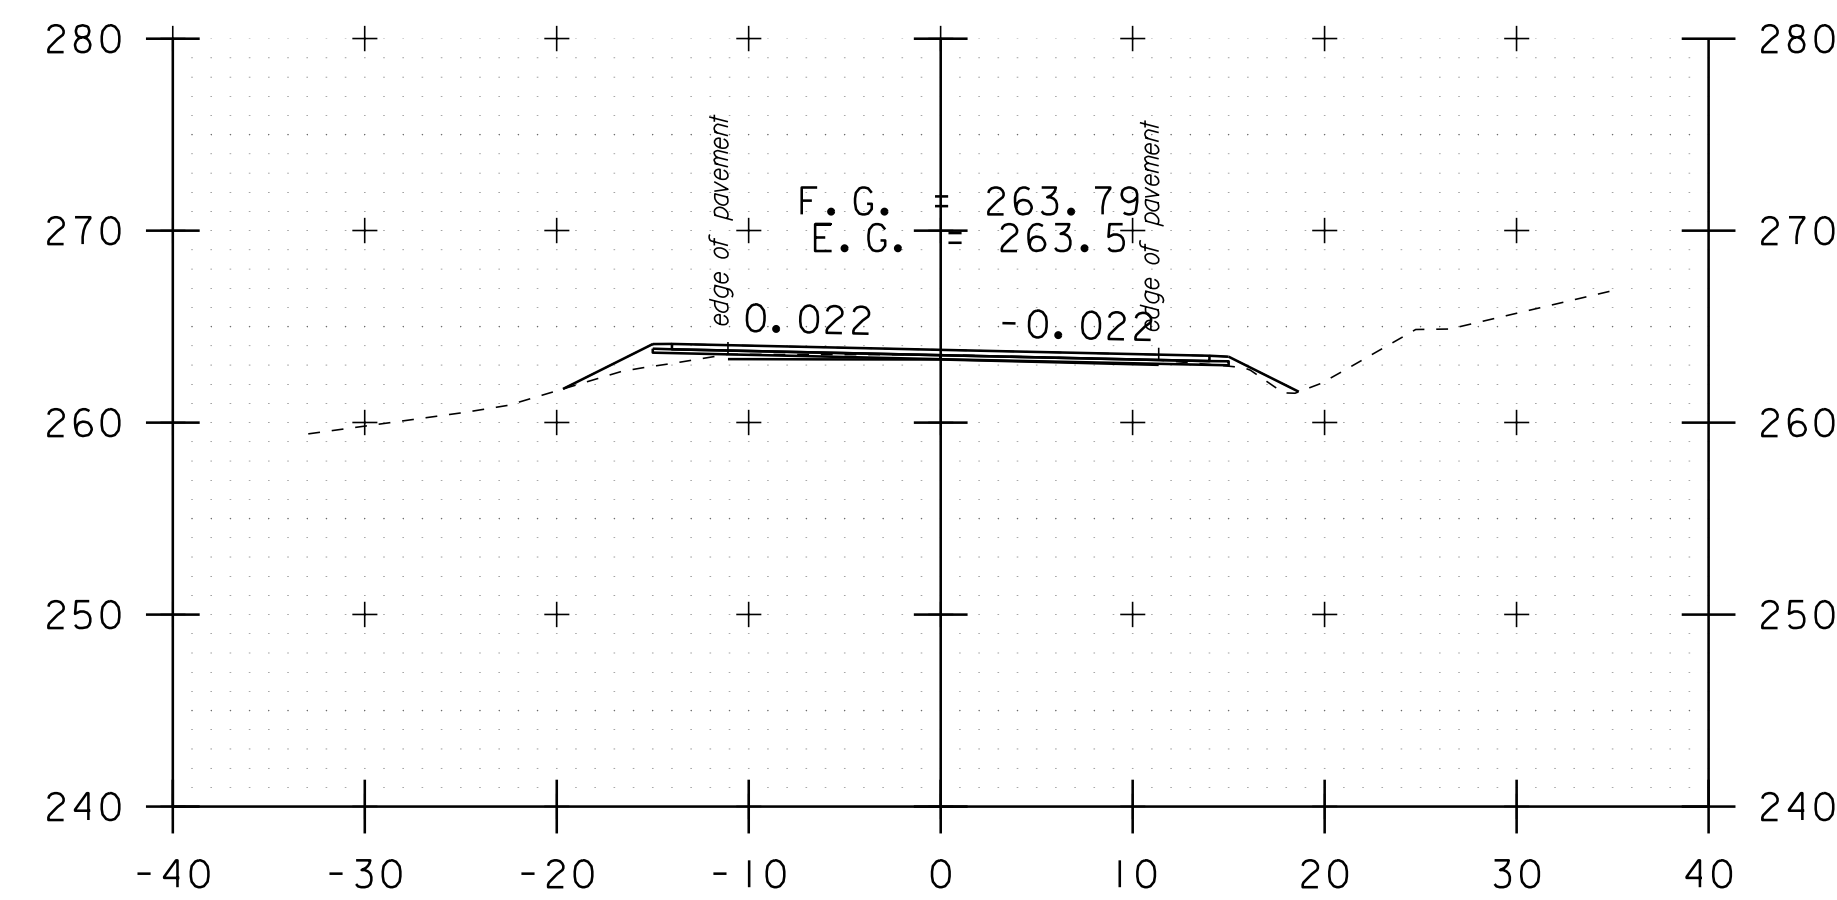

b 108+05

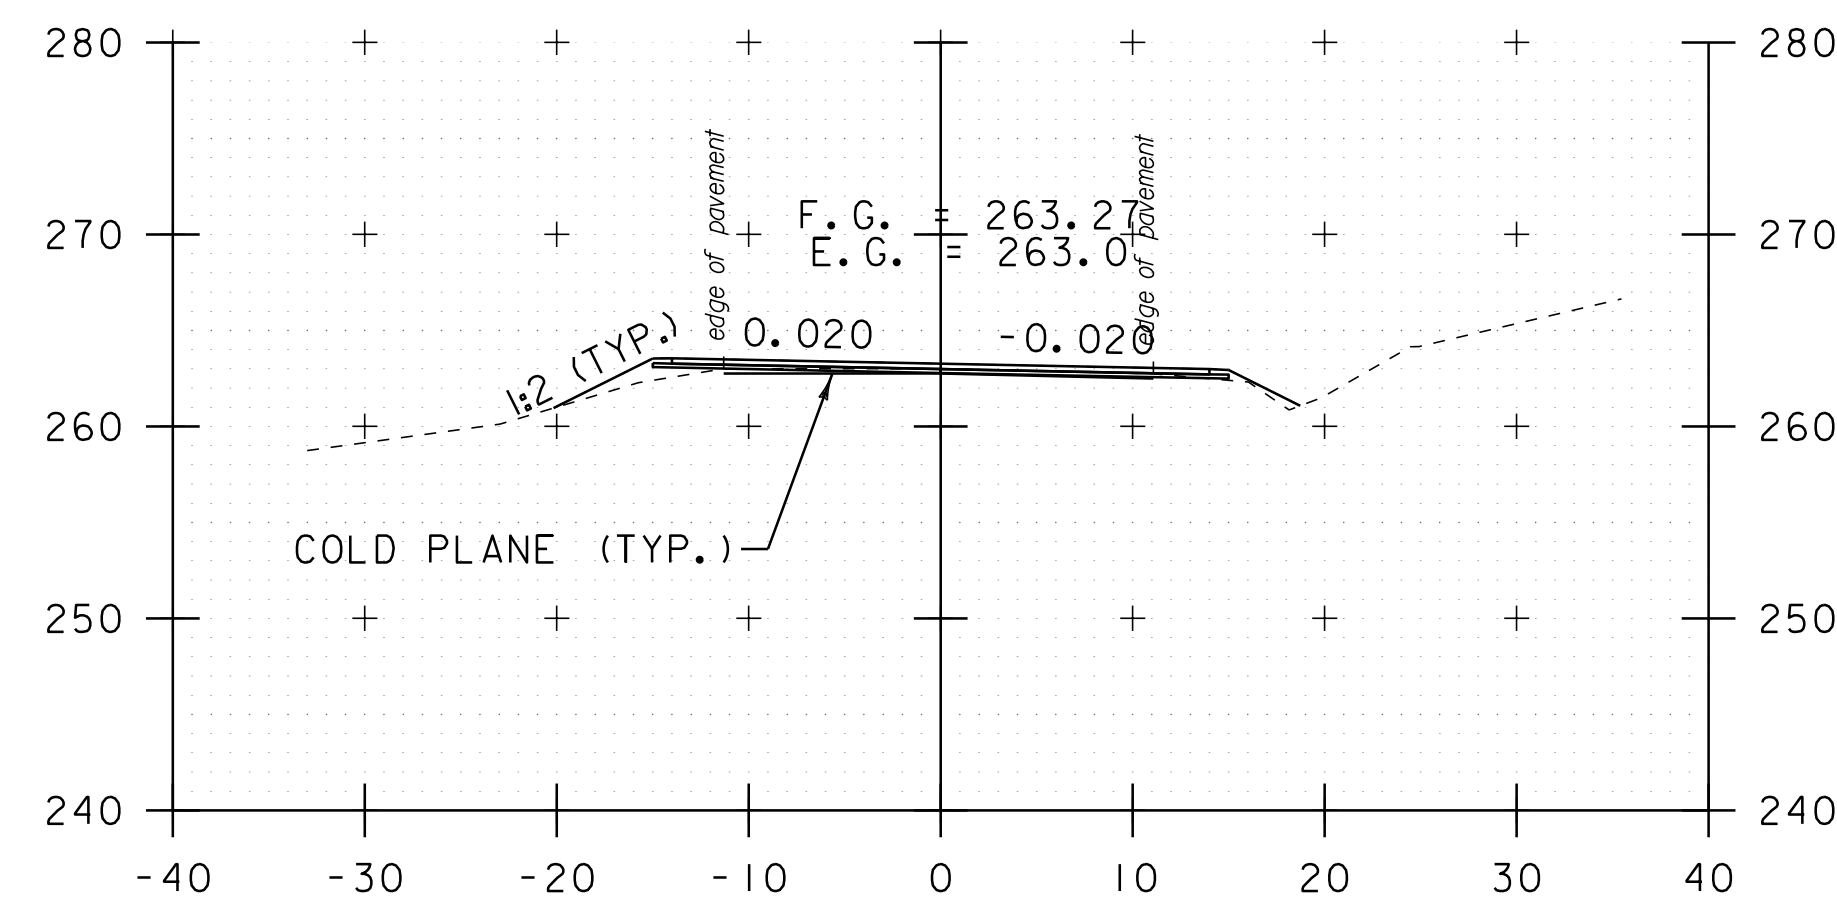


b 107+92

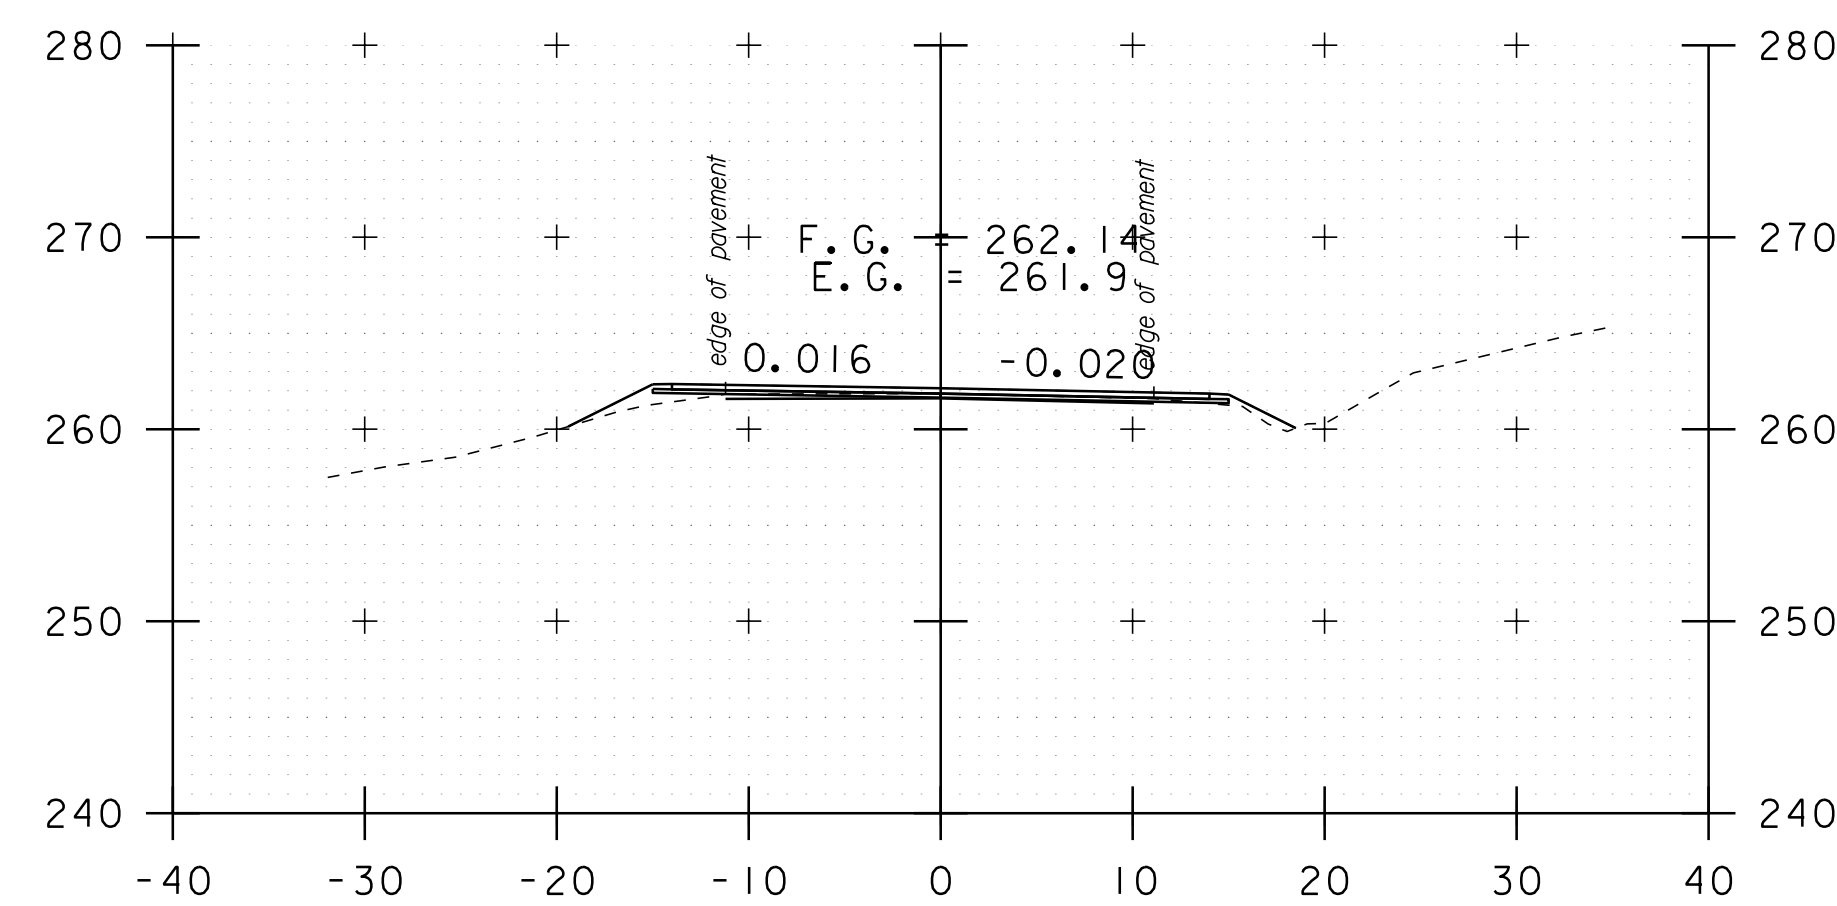

b 107+65

DATUM	NAVD 88
	NAD 83

STA. b 101+15 TO STA. b 108+05

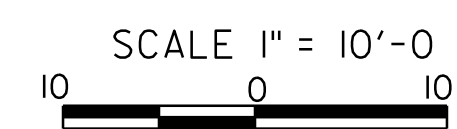

CROSS SECTION SHEET 38

PROJECT NAME:	ADDISON-NEW HAVEN	PLOT DATE:	3/13/2012
PROJECT NUMBER:	STP 9632(1)	DRAWN BY:	SJL
FILE NAME:	p95B076.dgn	CHECKED BY:	EPD
PROJECT LEADER:	CDL	SHEET	143 OF 186
DESIGNED BY:	SJL		
PLOT FILE:	p95B076_143.1		