




c 3+50

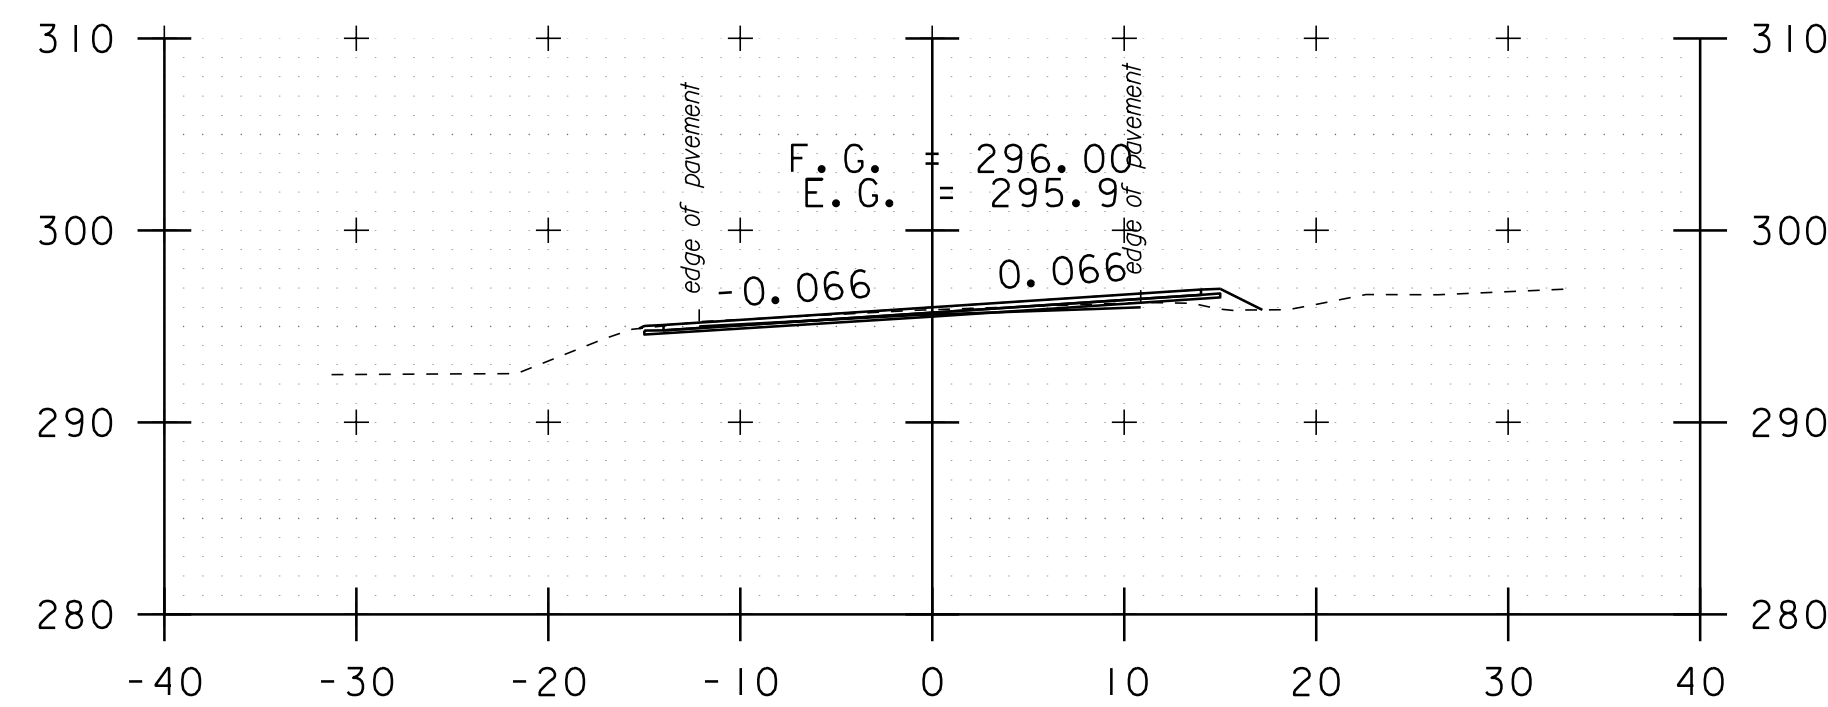


c 3+25

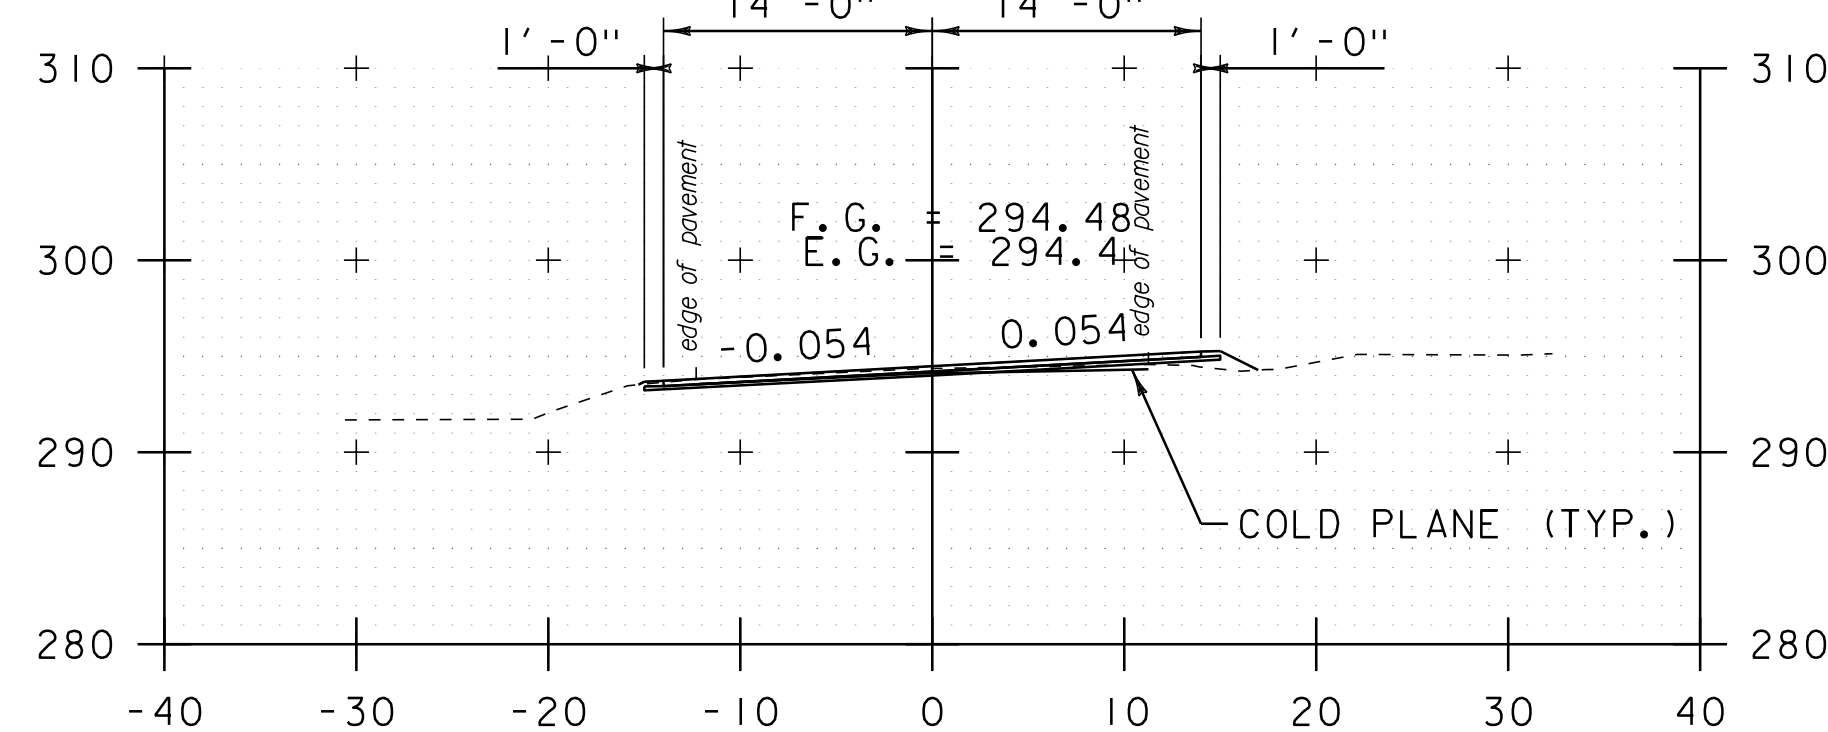


c 2+96

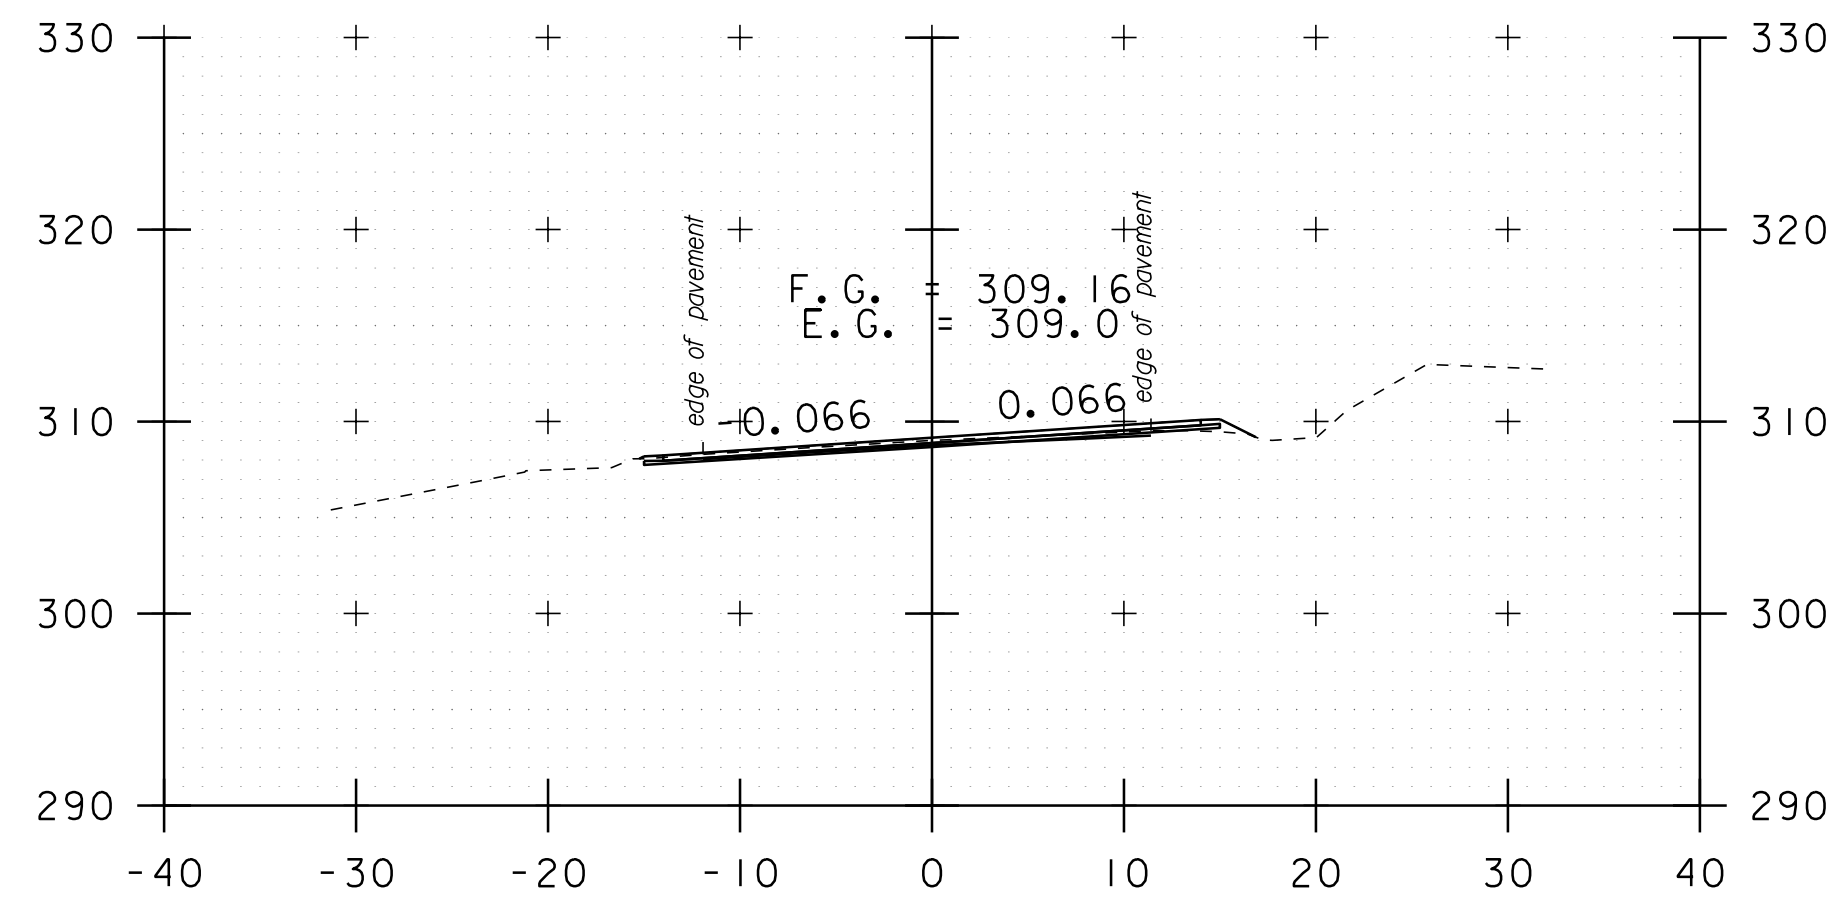


c 5+00

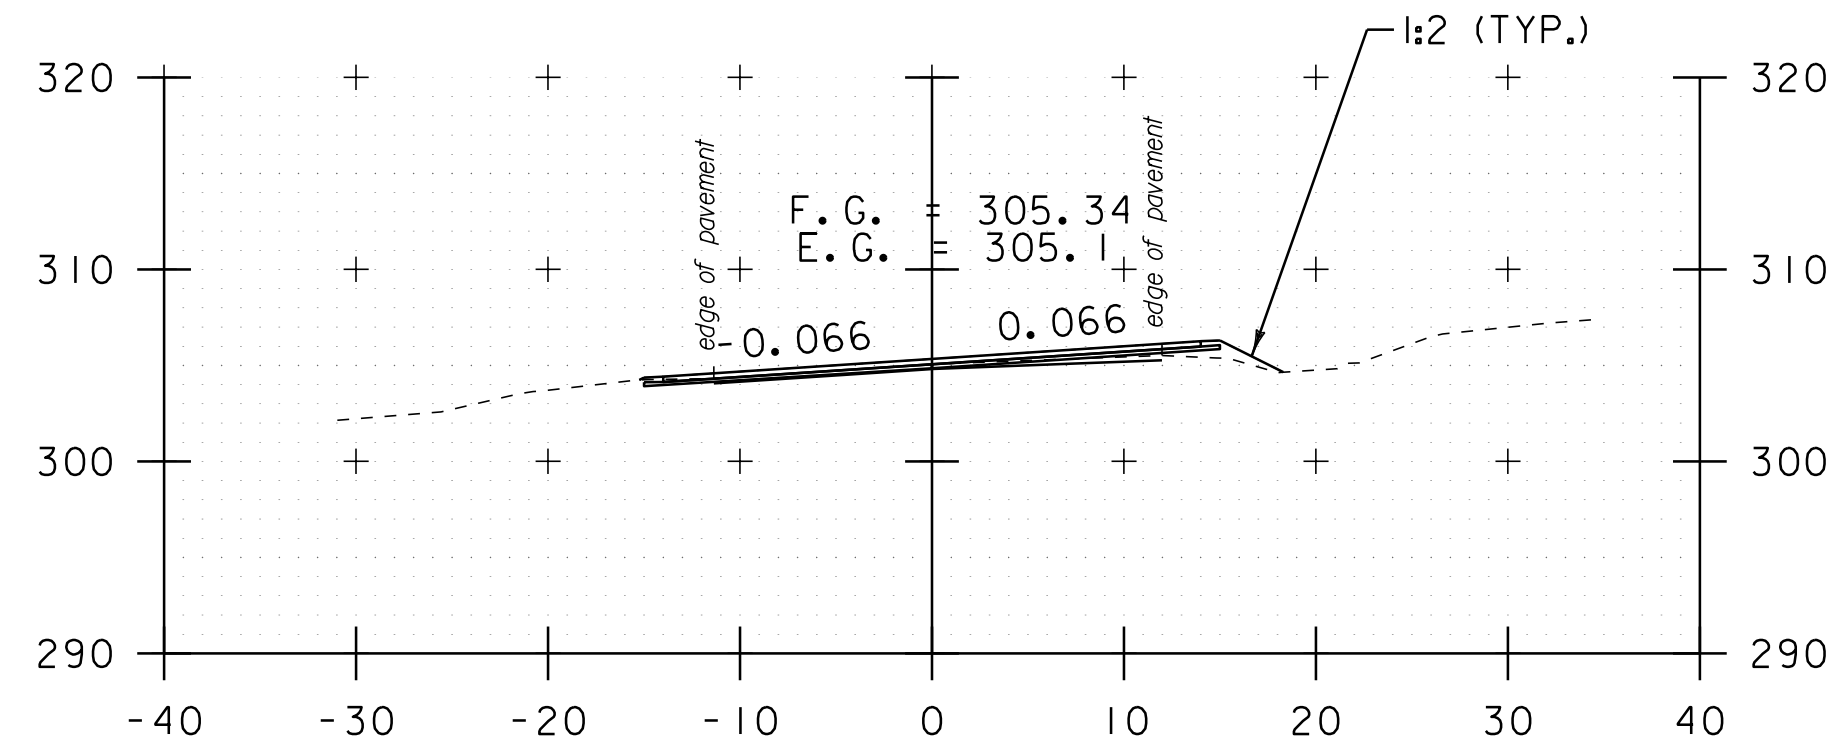


c 4+50

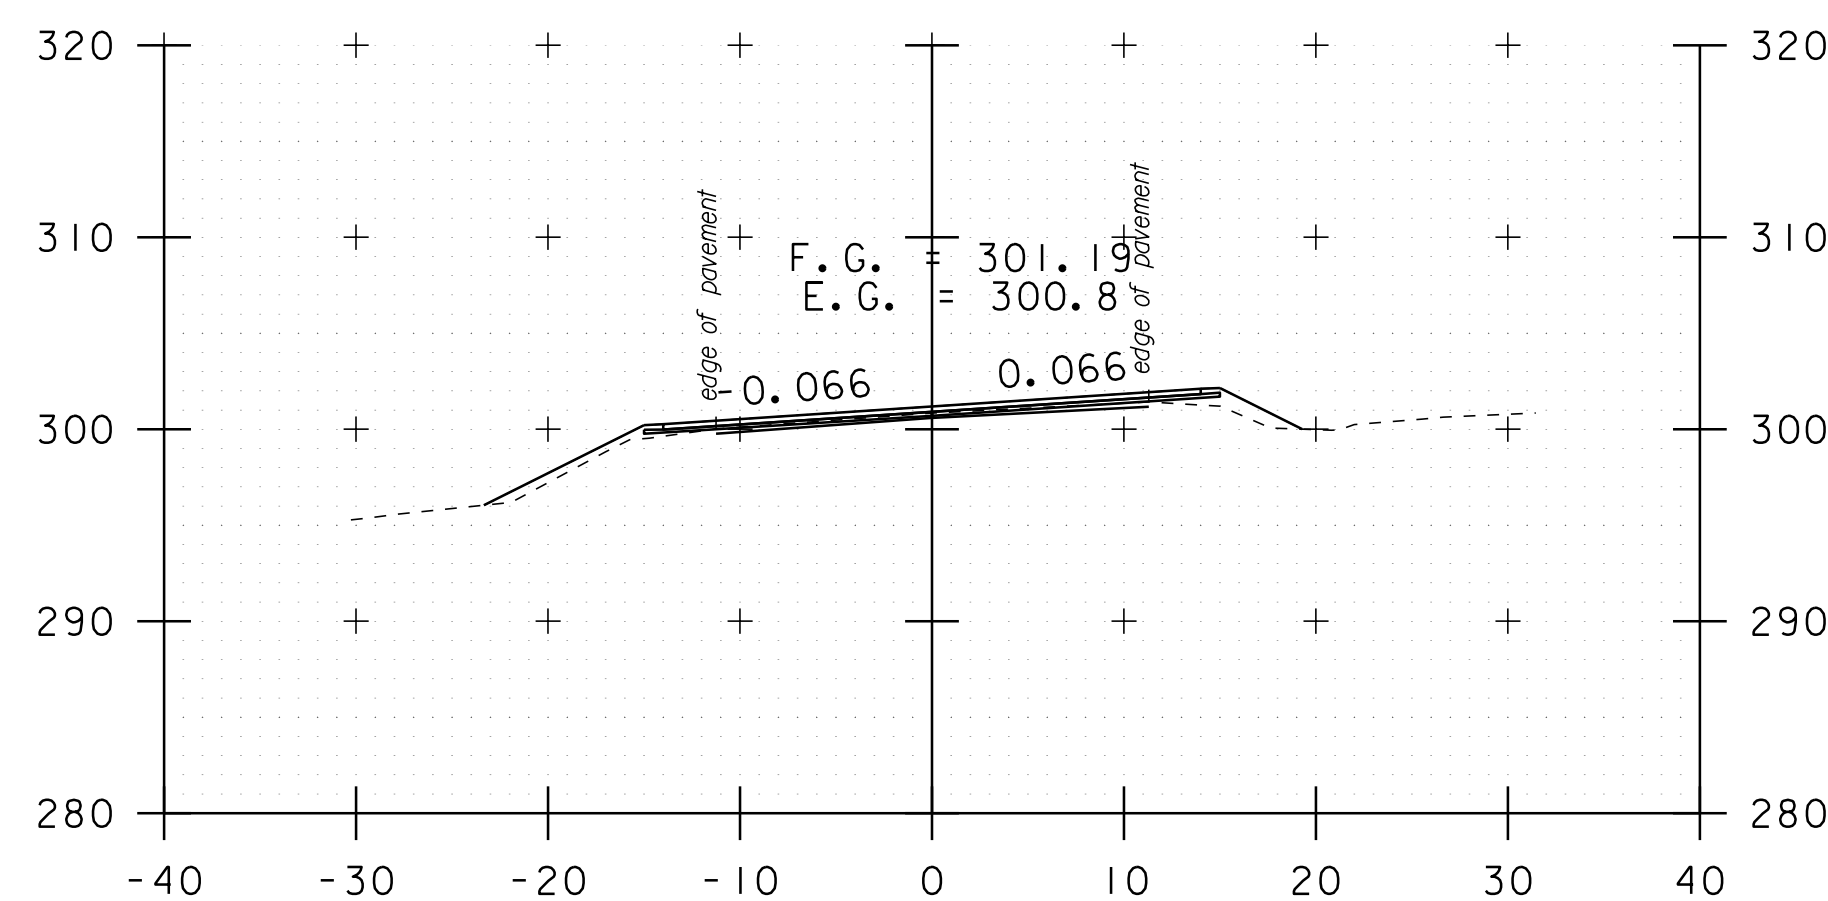


c 4+00

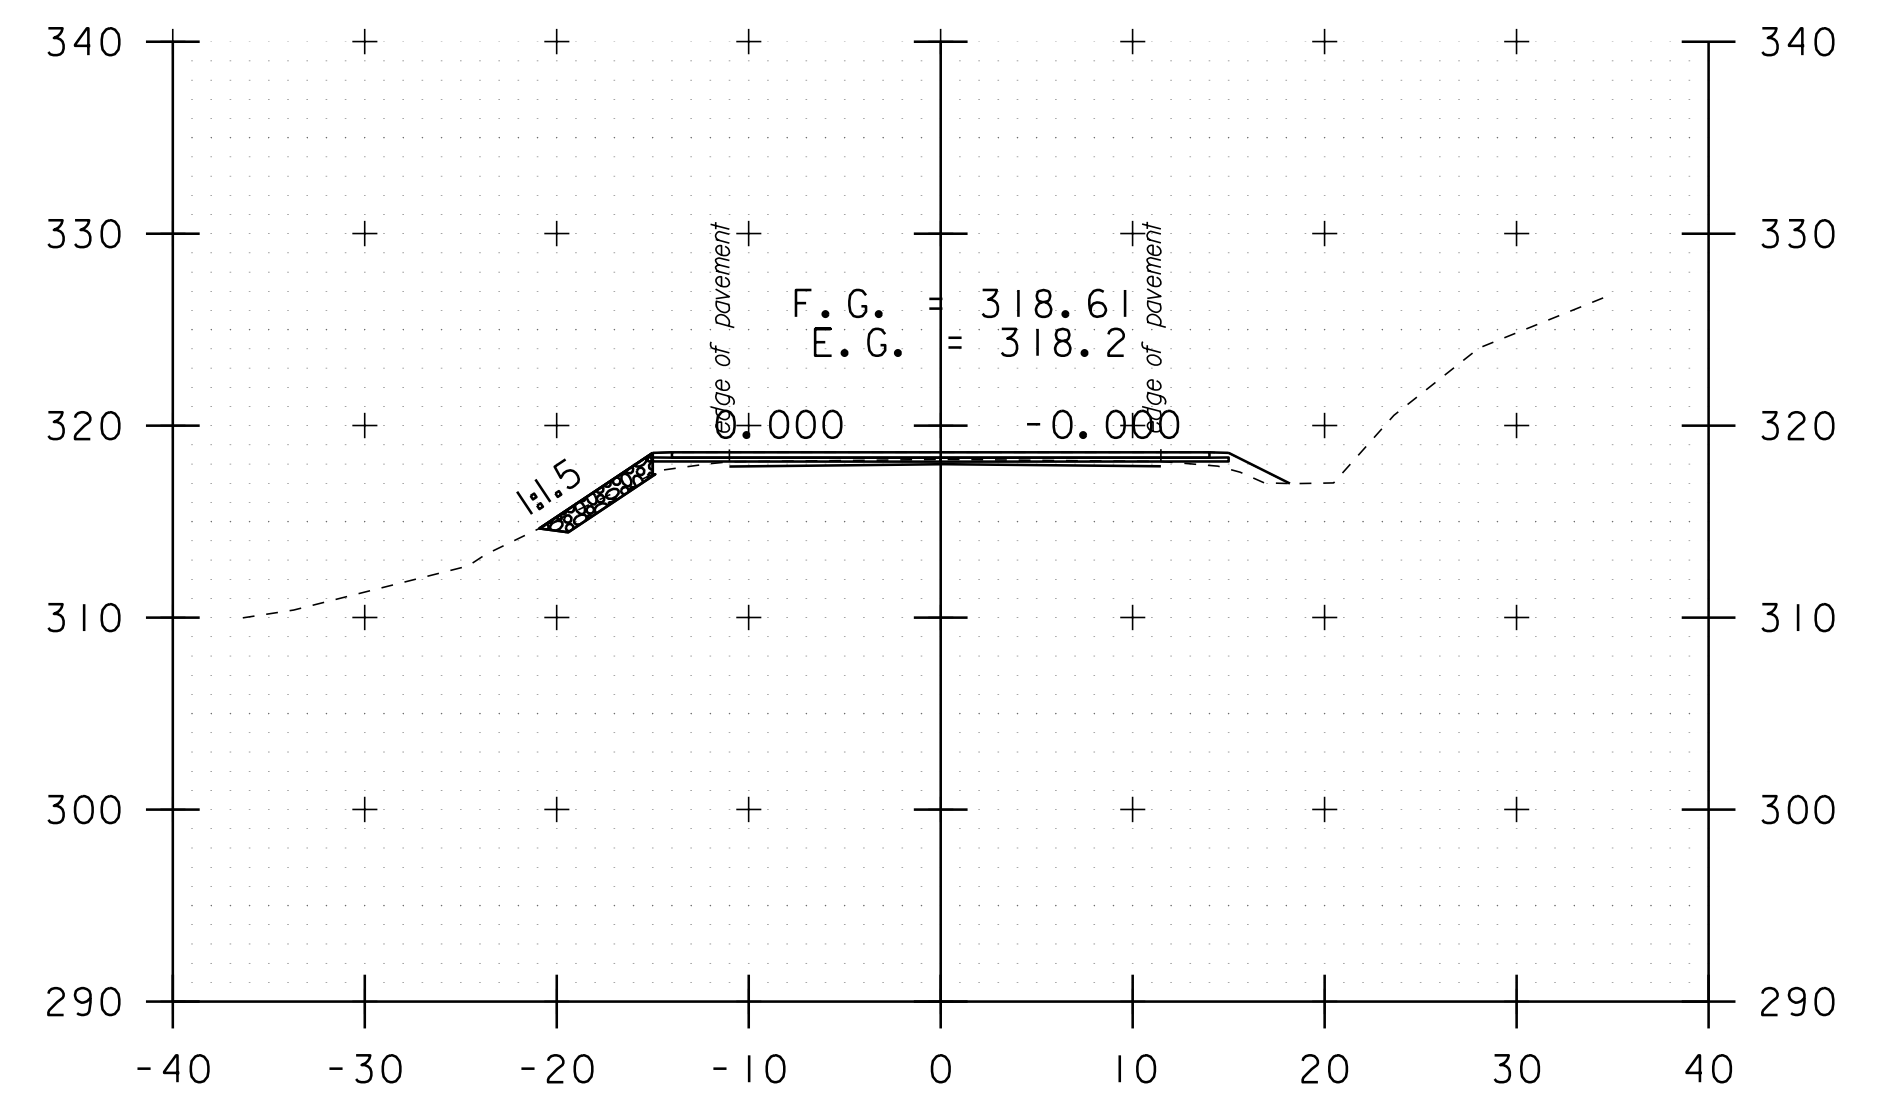

c 7+85

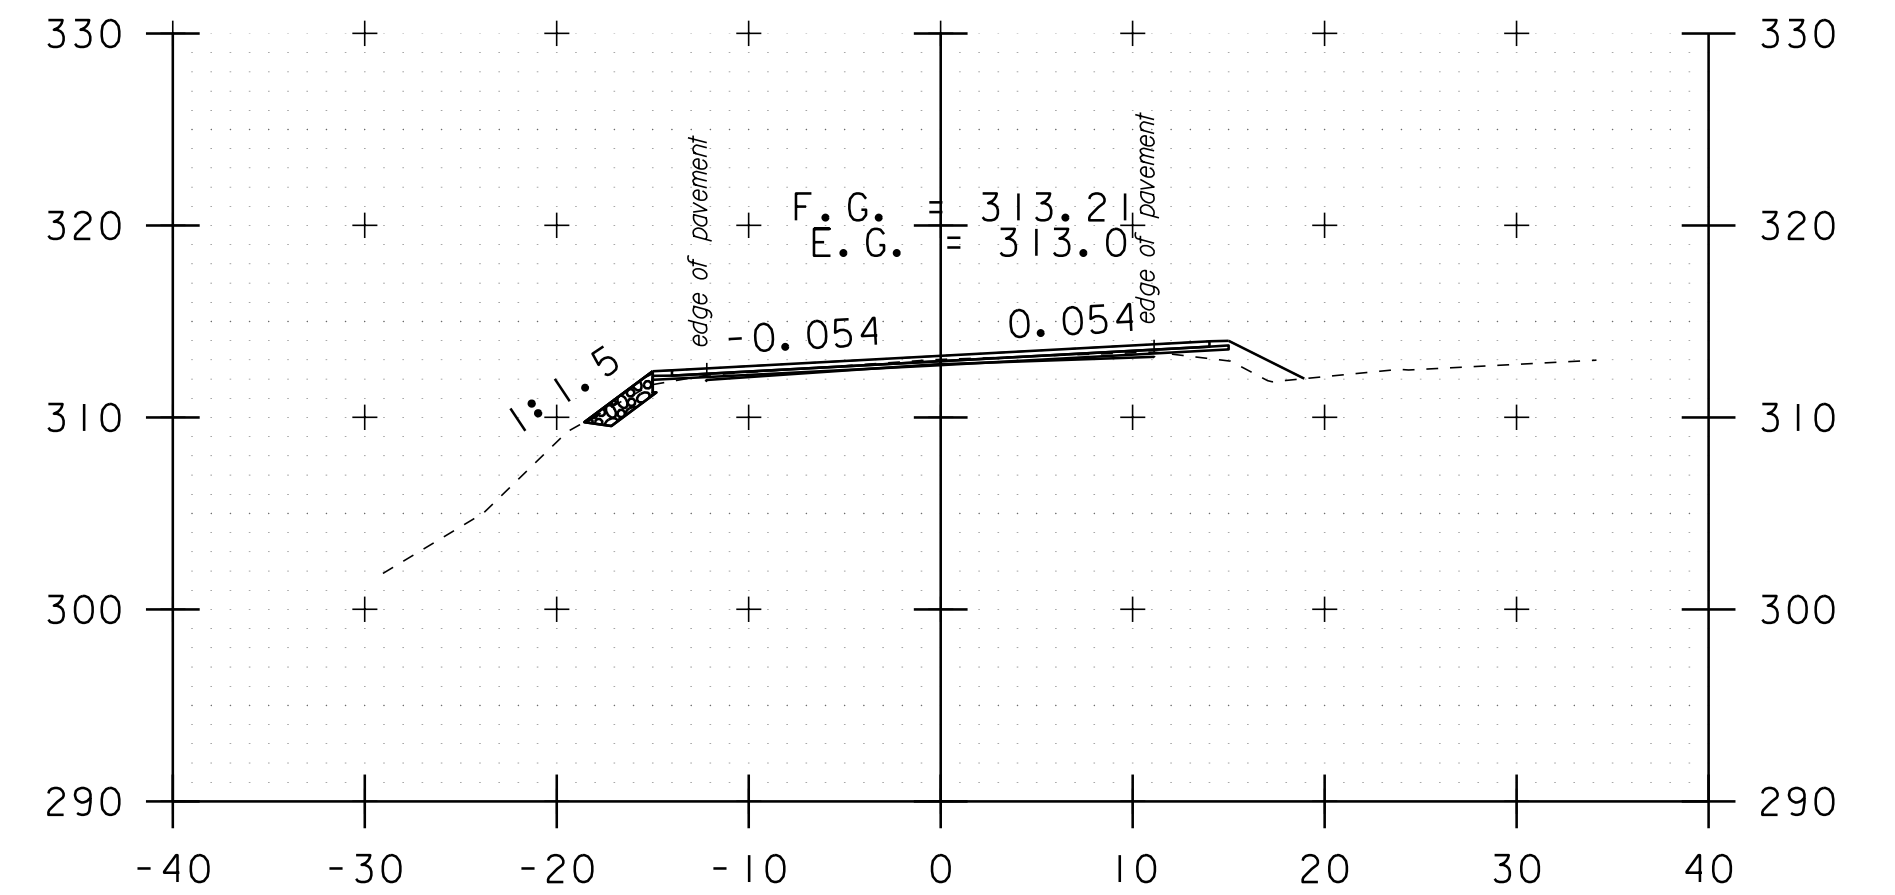

c 5+93

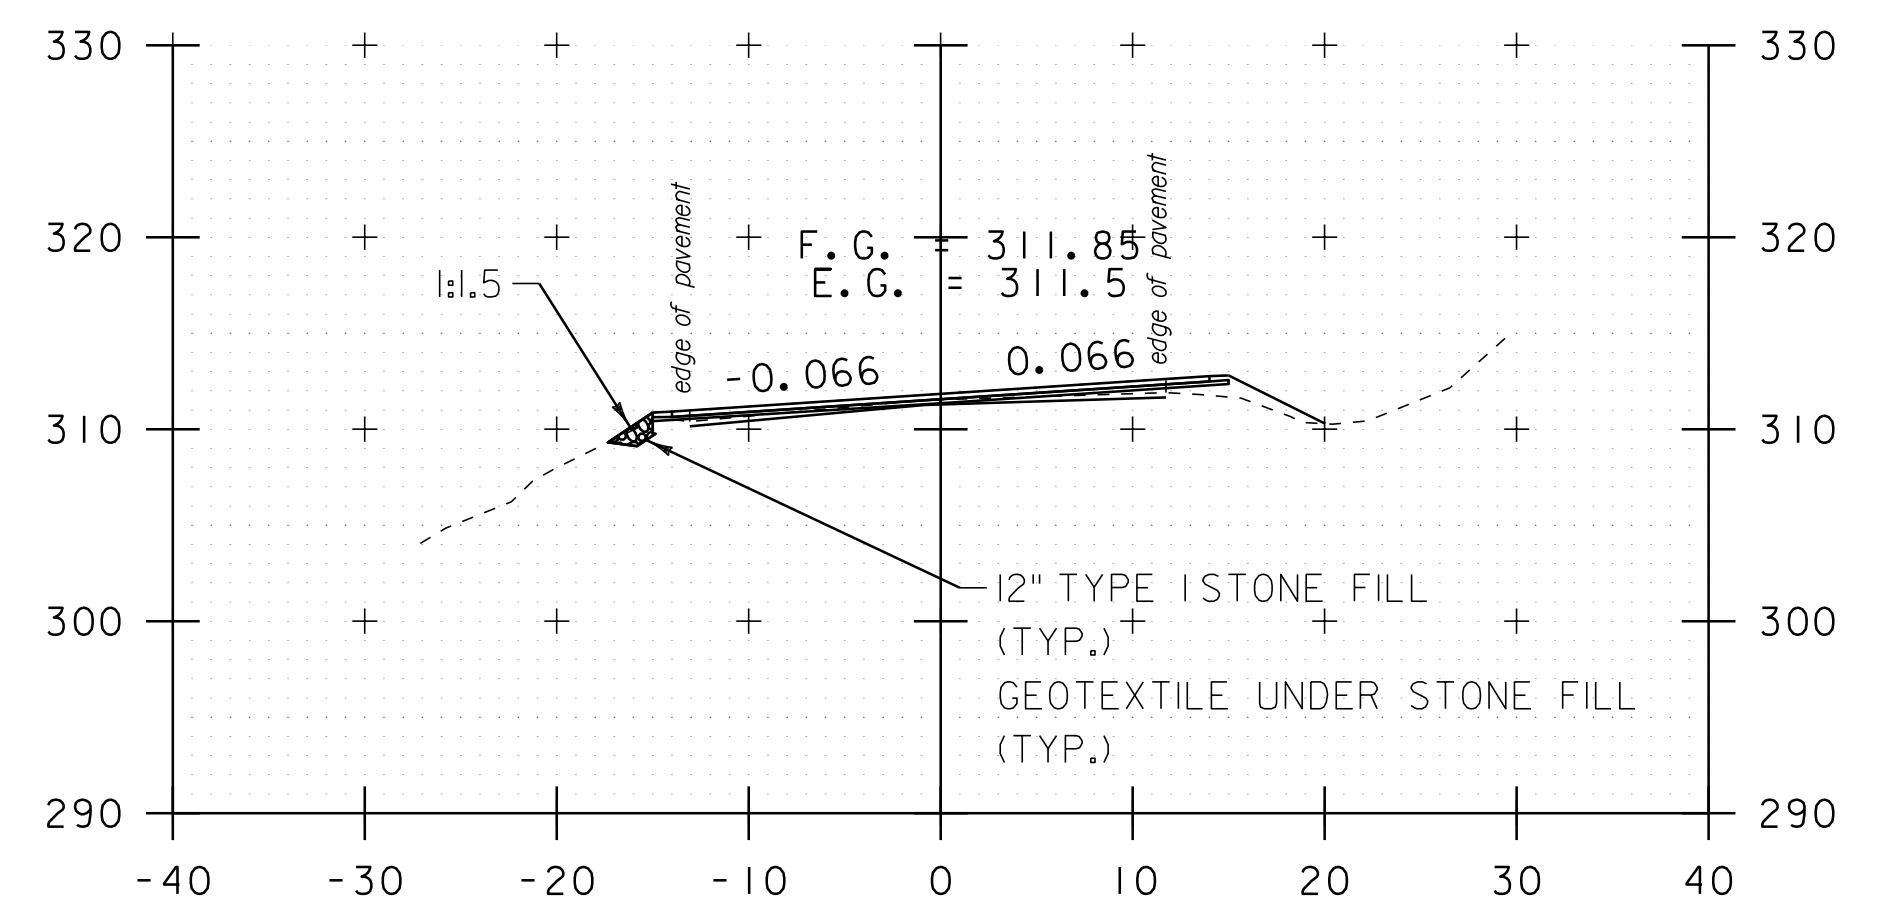

c 5+50

DATUM  
 NAVD 88  
 NAD 83

STA. c 2+96 TO STA. c 7+85

SCALE 1" = 10'-0"  
 10 0 10

**CROSS SECTION SHEET 42**

PROJECT NAME: ADDISON-NEW HAVEN  
 PROJECT NUMBER: STP 9632(1)  
 FILE NAME: p95B076.dgn  
 PROJECT LEADER: CDL  
 DESIGNED BY: SJL  
 PLOT FILE: p95B076\_147.1  
 PLOT DATE: 3/13/2012  
 DRAWN BY: SJL  
 CHECKED BY: EPD  
 SHEET 147 OF 186