




c 12+00

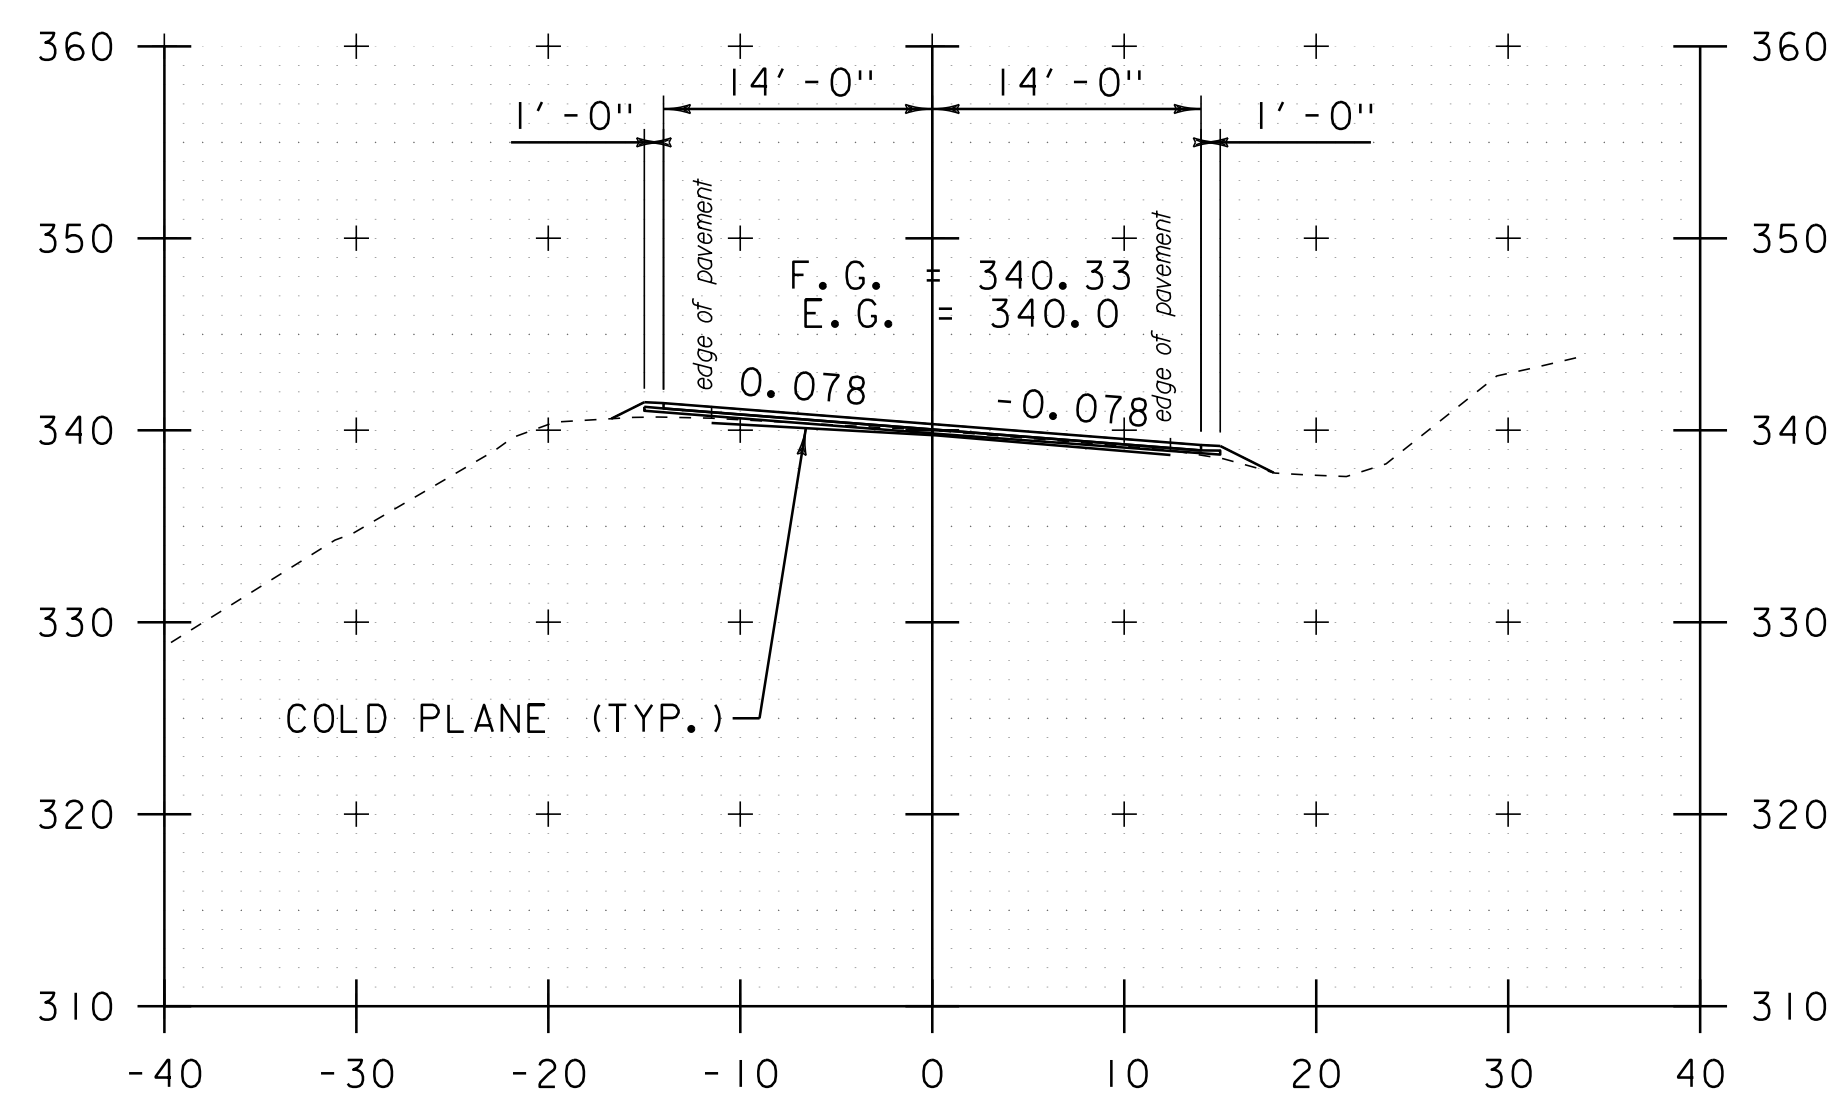

c 11+50

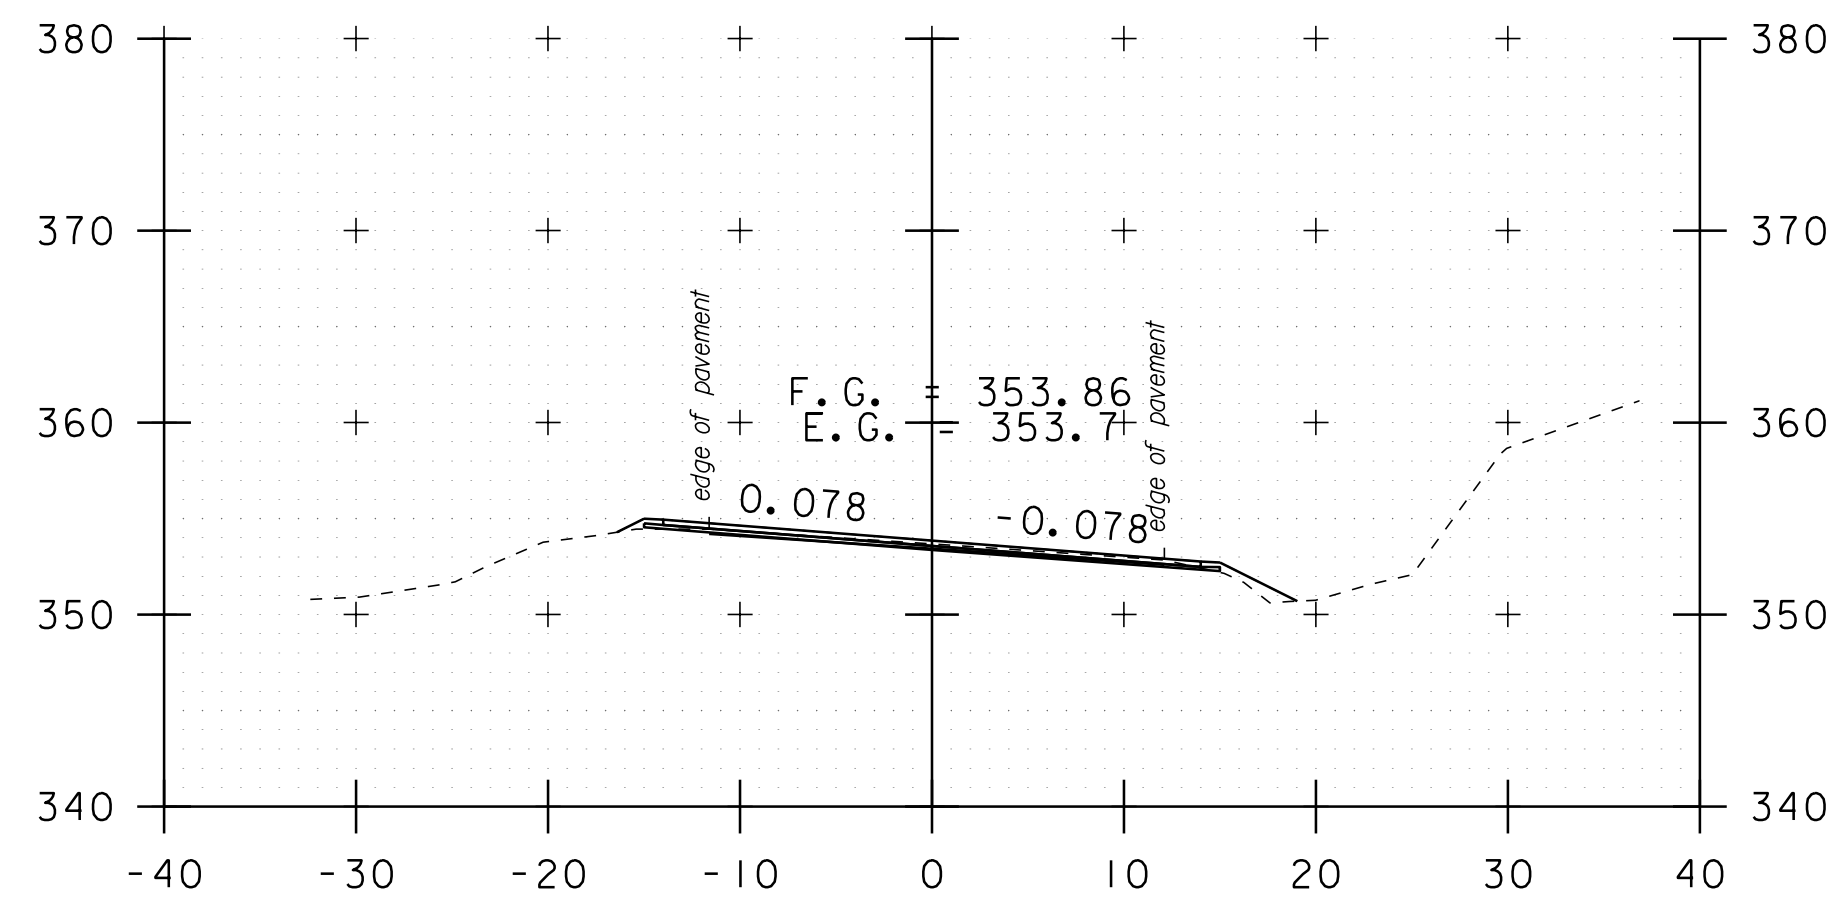


c 13+50

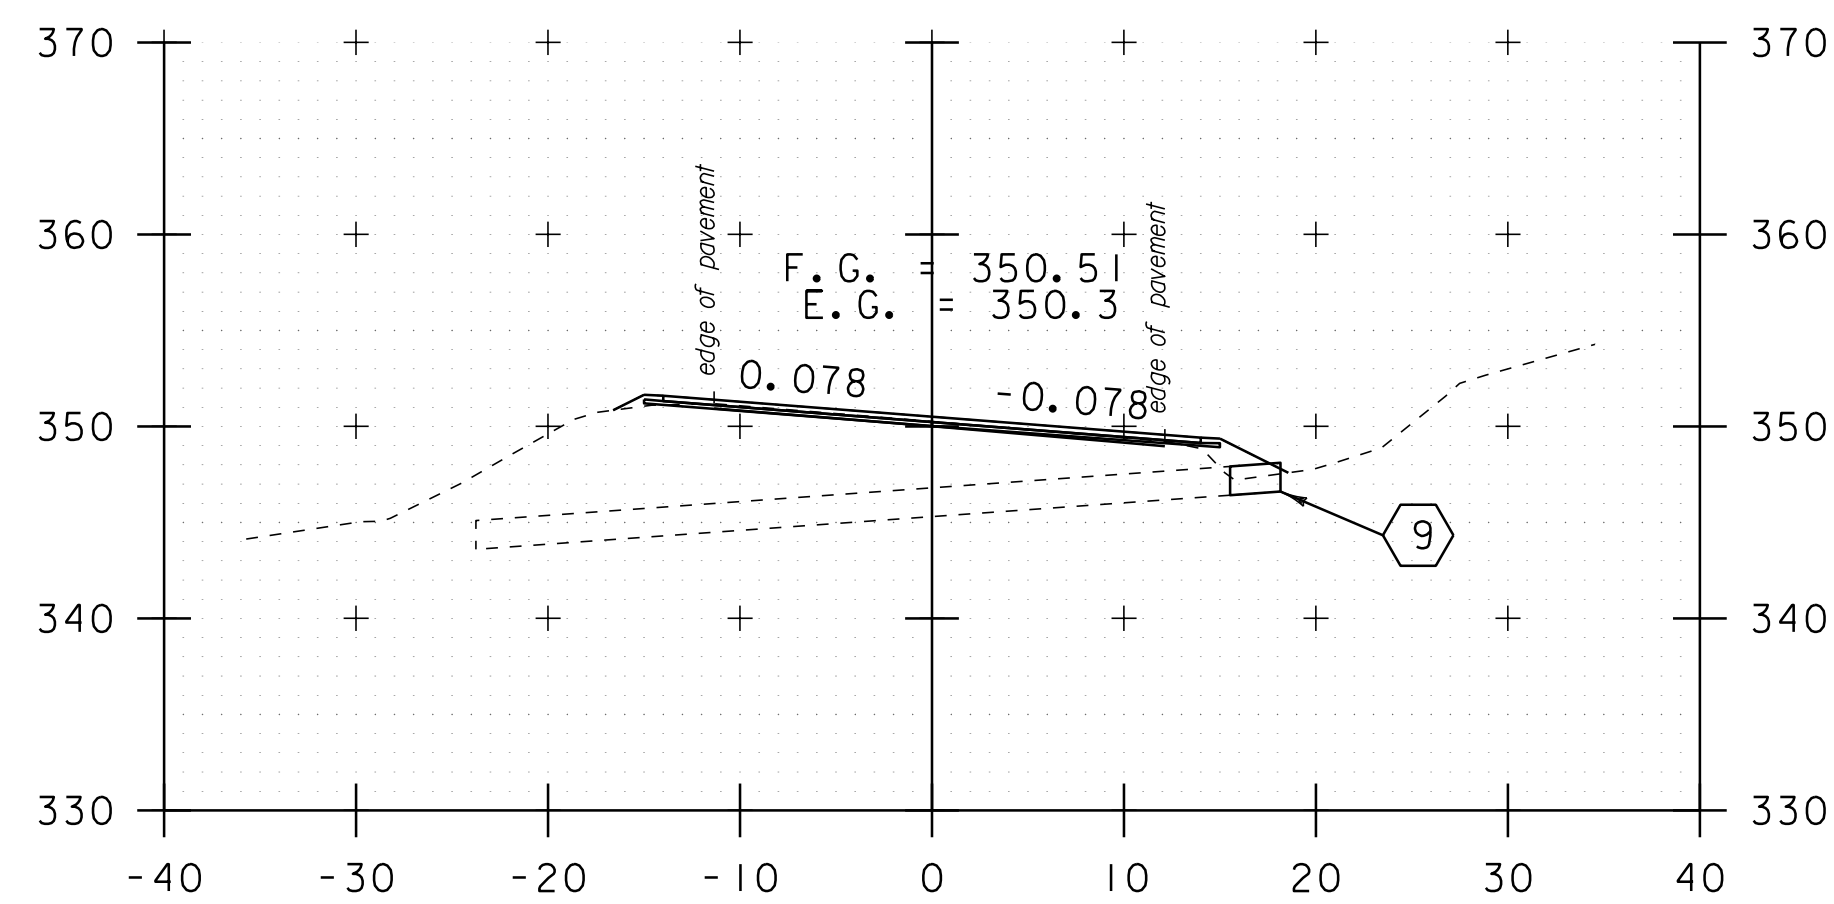


c 13+00


9  
 STA. c 12+93.40 RT 15.53'  
 STA. c 12+94.90 RT 18.15'  
 EXTEND 18" CMP (3'-0")  
 PROPOSED INV. IN = 346.61'  
 EXISTING INV. IN = 346.42'  
 ADD STONE FILL, TYPE I  
 AROUND INLET

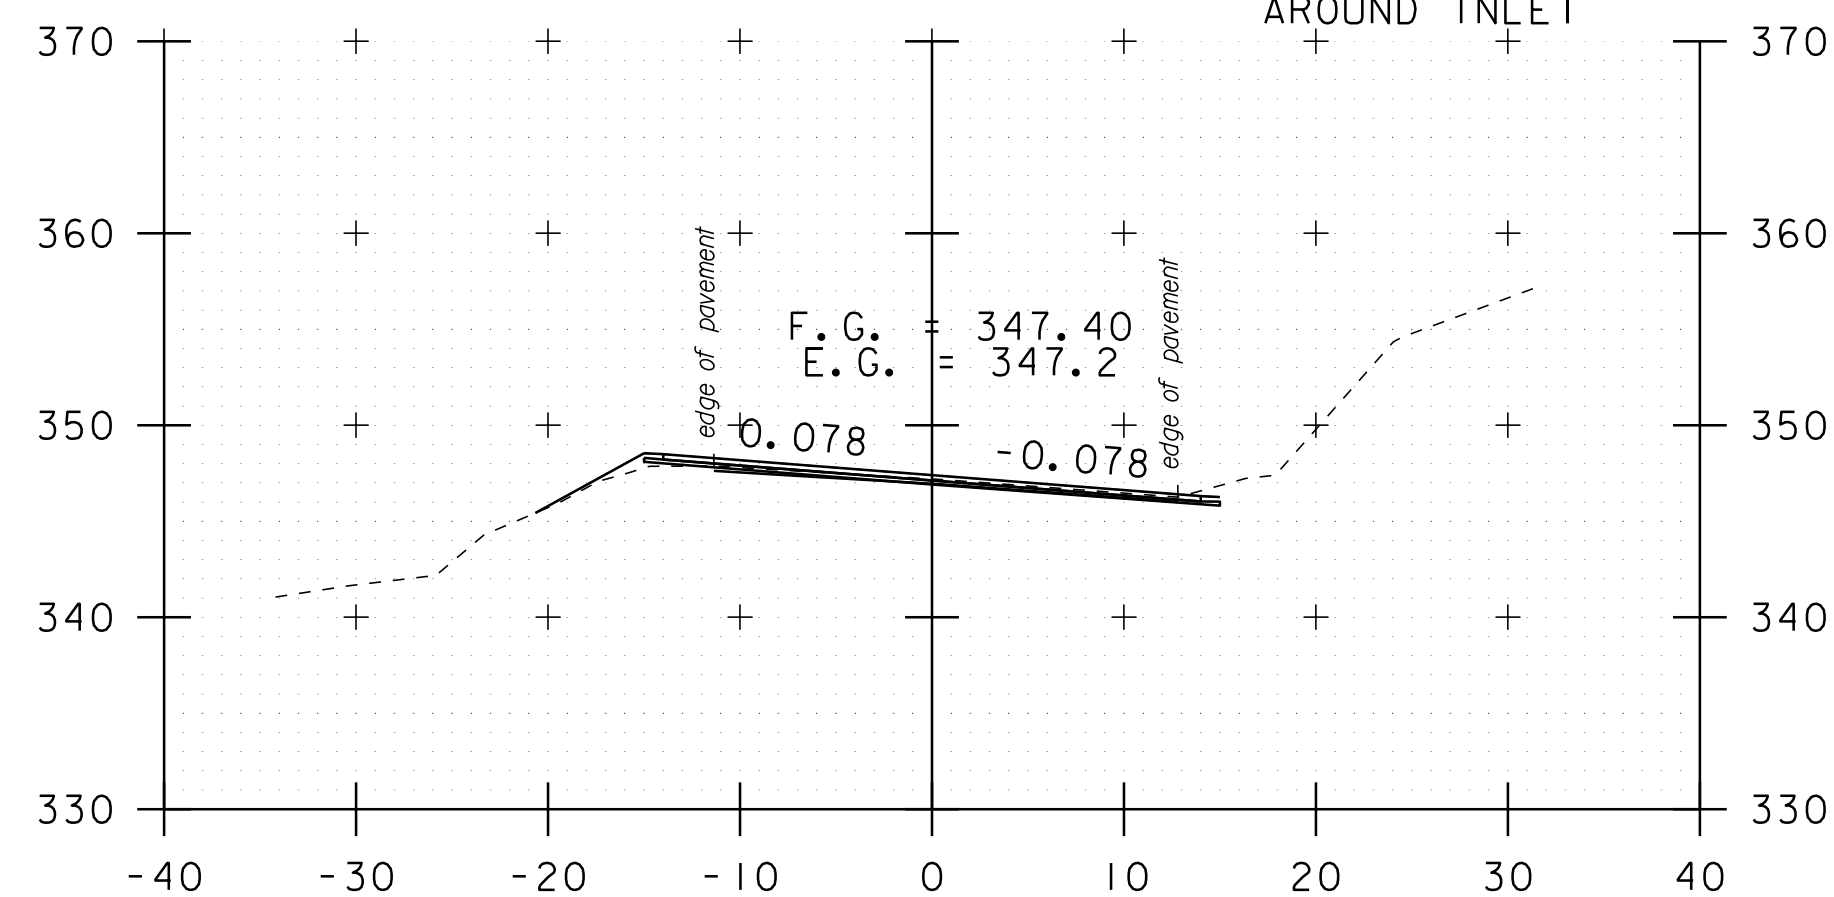


c 12+50

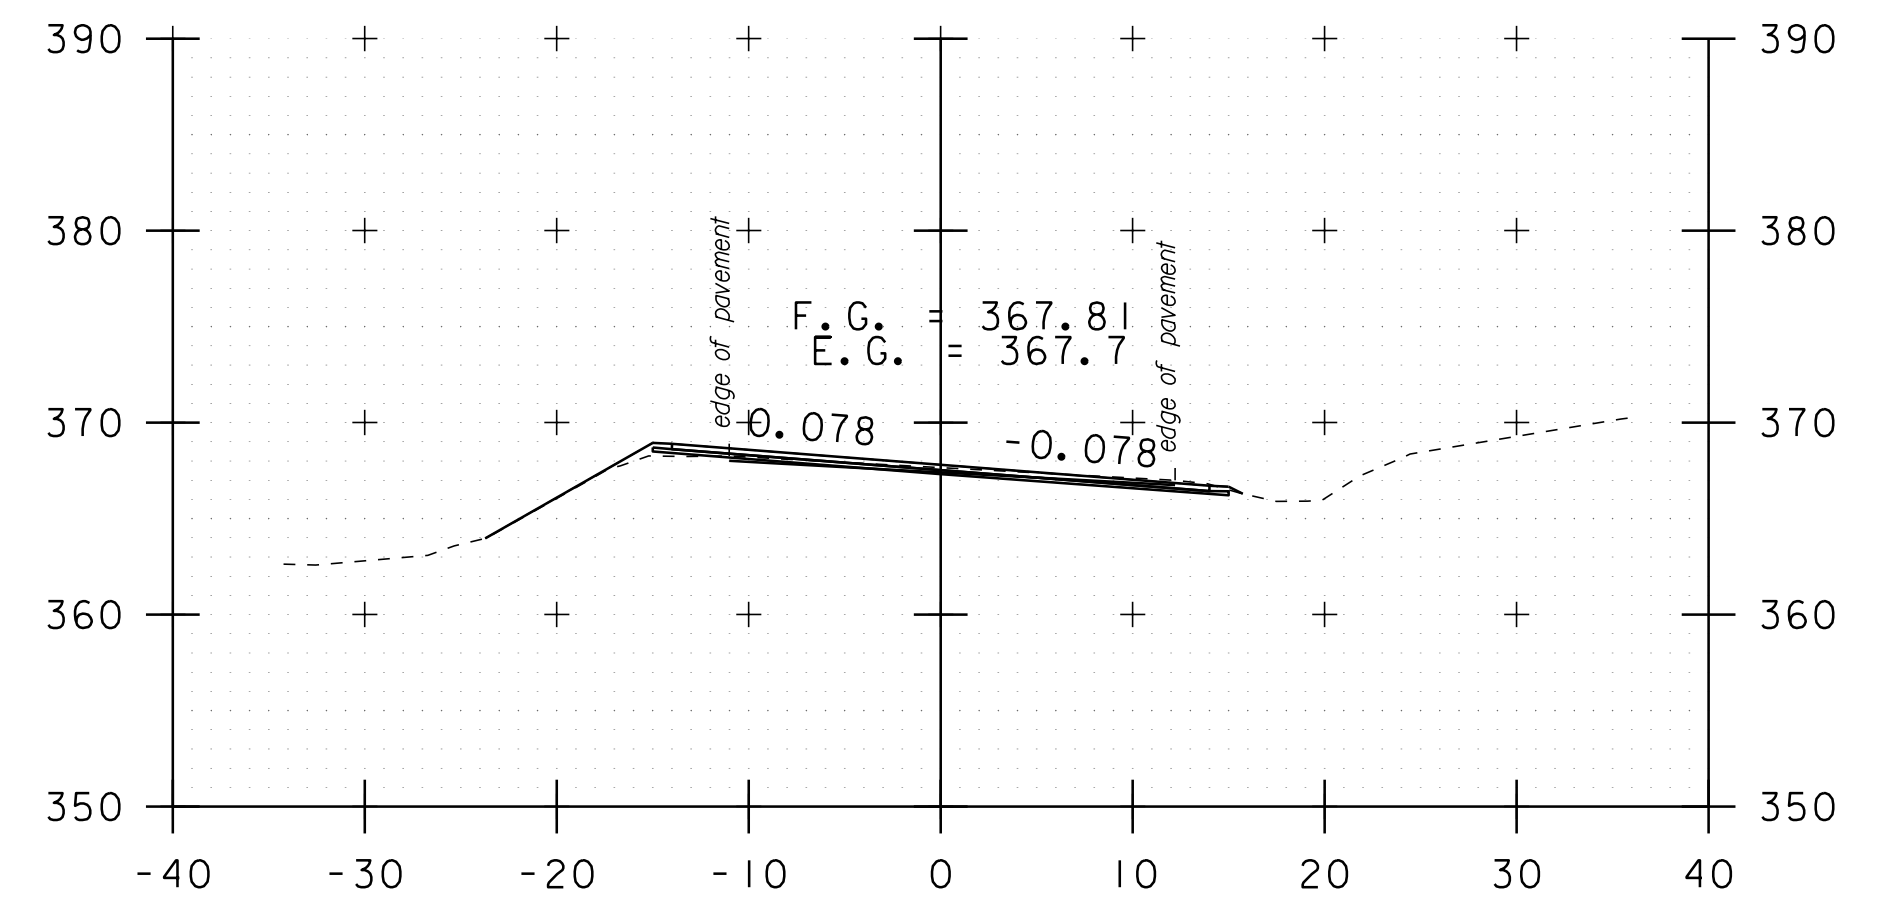

c 15+00

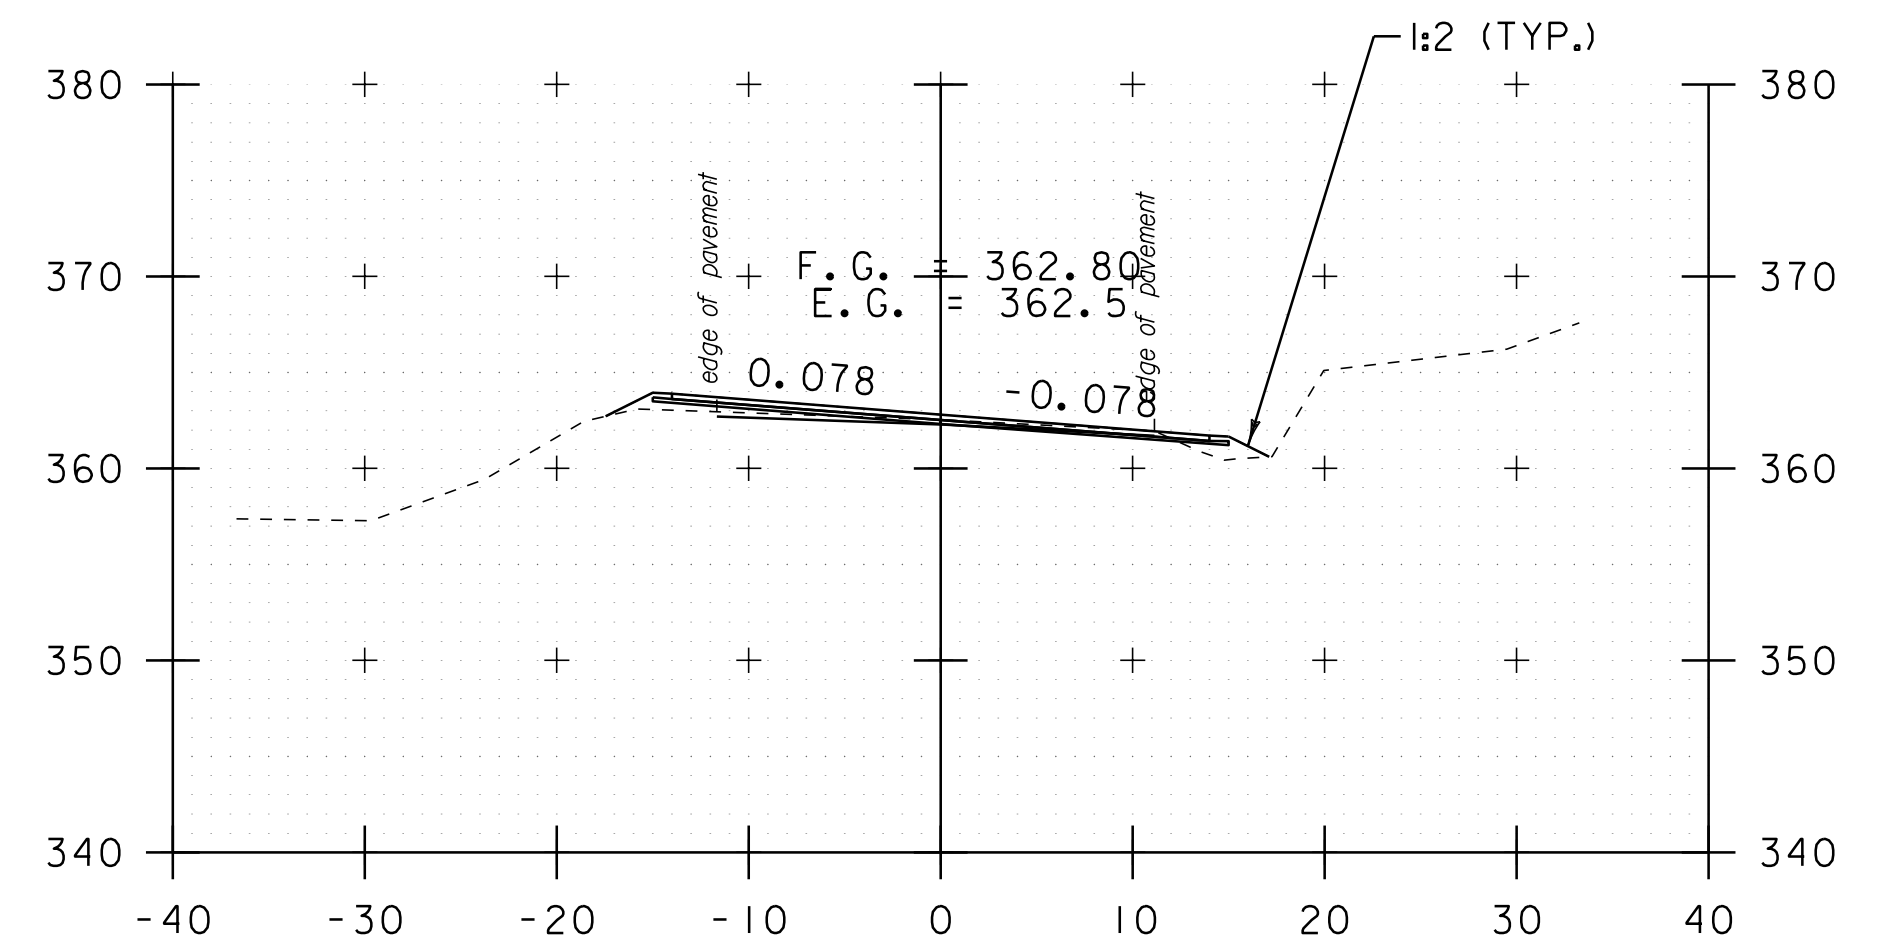


c 14+50

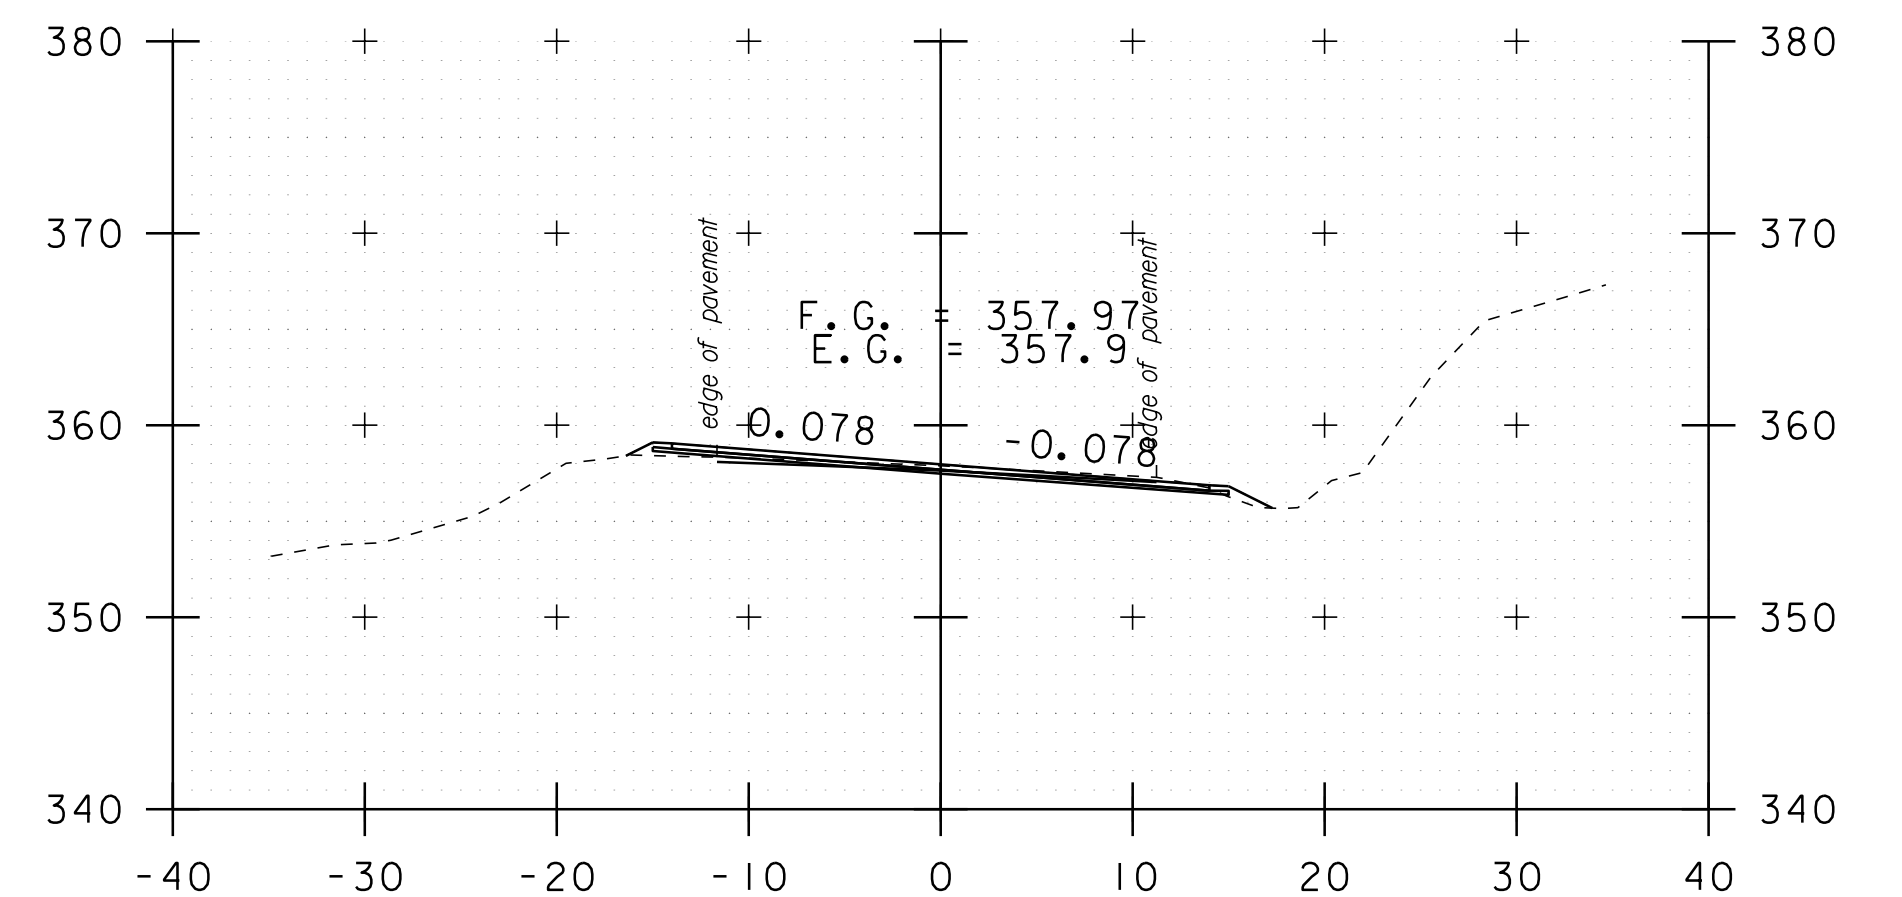

c 14+00

DATUM	NAVD 88
	NAD 83

STA. c 11+50 TO STA. c 15+00

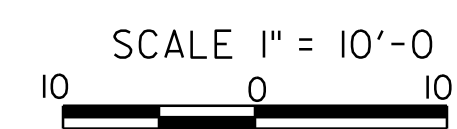

**CROSS SECTION SHEET 44**

PROJECT NAME: ADDISON-NEW HAVEN  
 PROJECT NUMBER: STP 9632(1)

FILE NAME: p95B076.dgn	PLOT DATE: 3/13/2012
PROJECT LEADER: CDL	DRAWN BY: SJL
DESIGNED BY: SJL	CHECKED BY: EPD
PLOT FILE: p95B076_149.1	SHEET 149 OF 186