




c 16+00

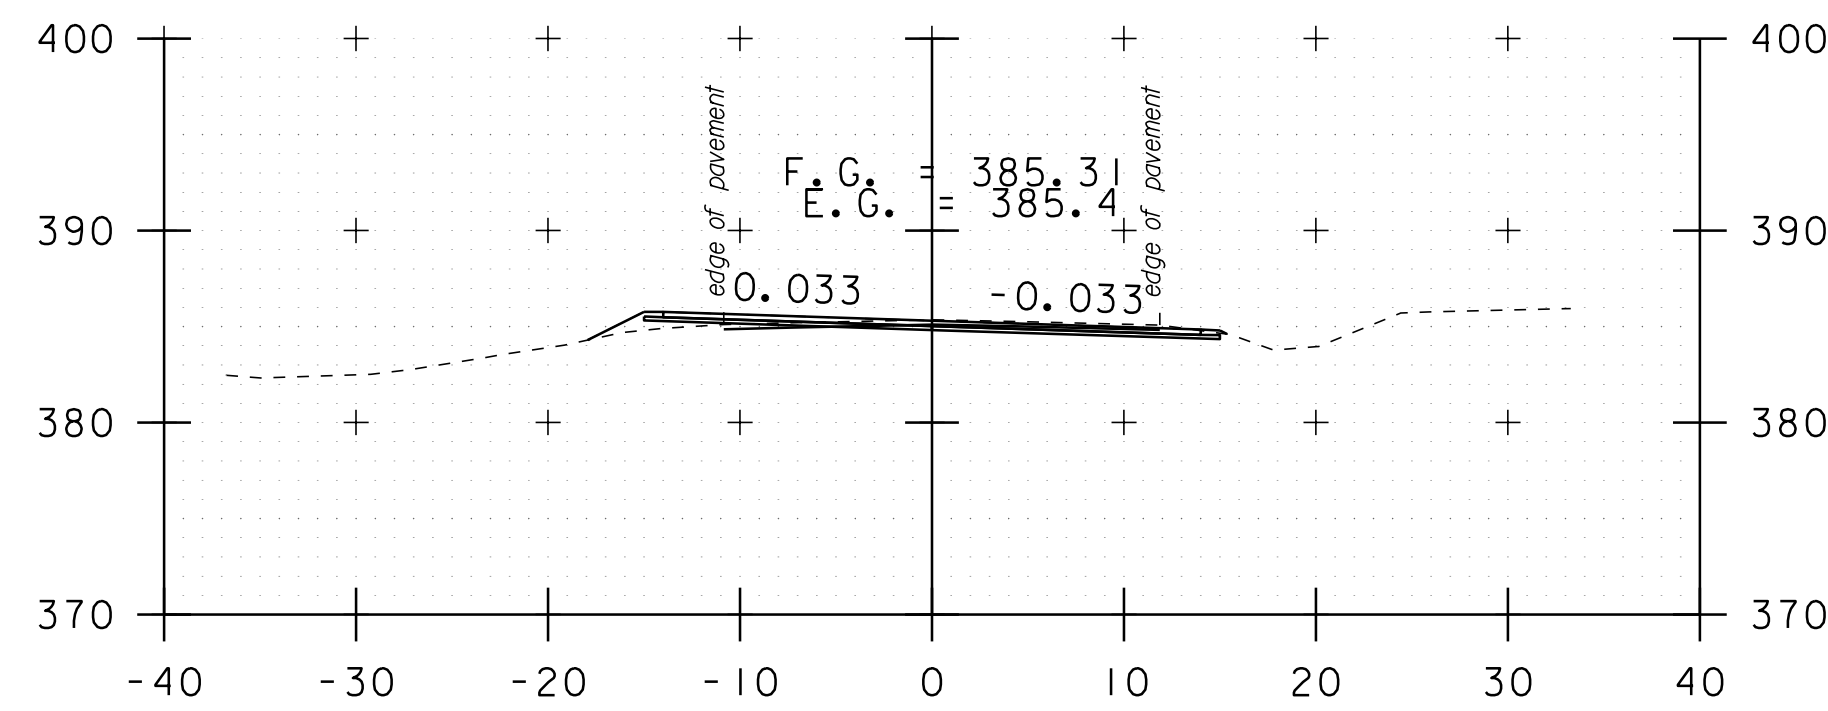


c 16+97

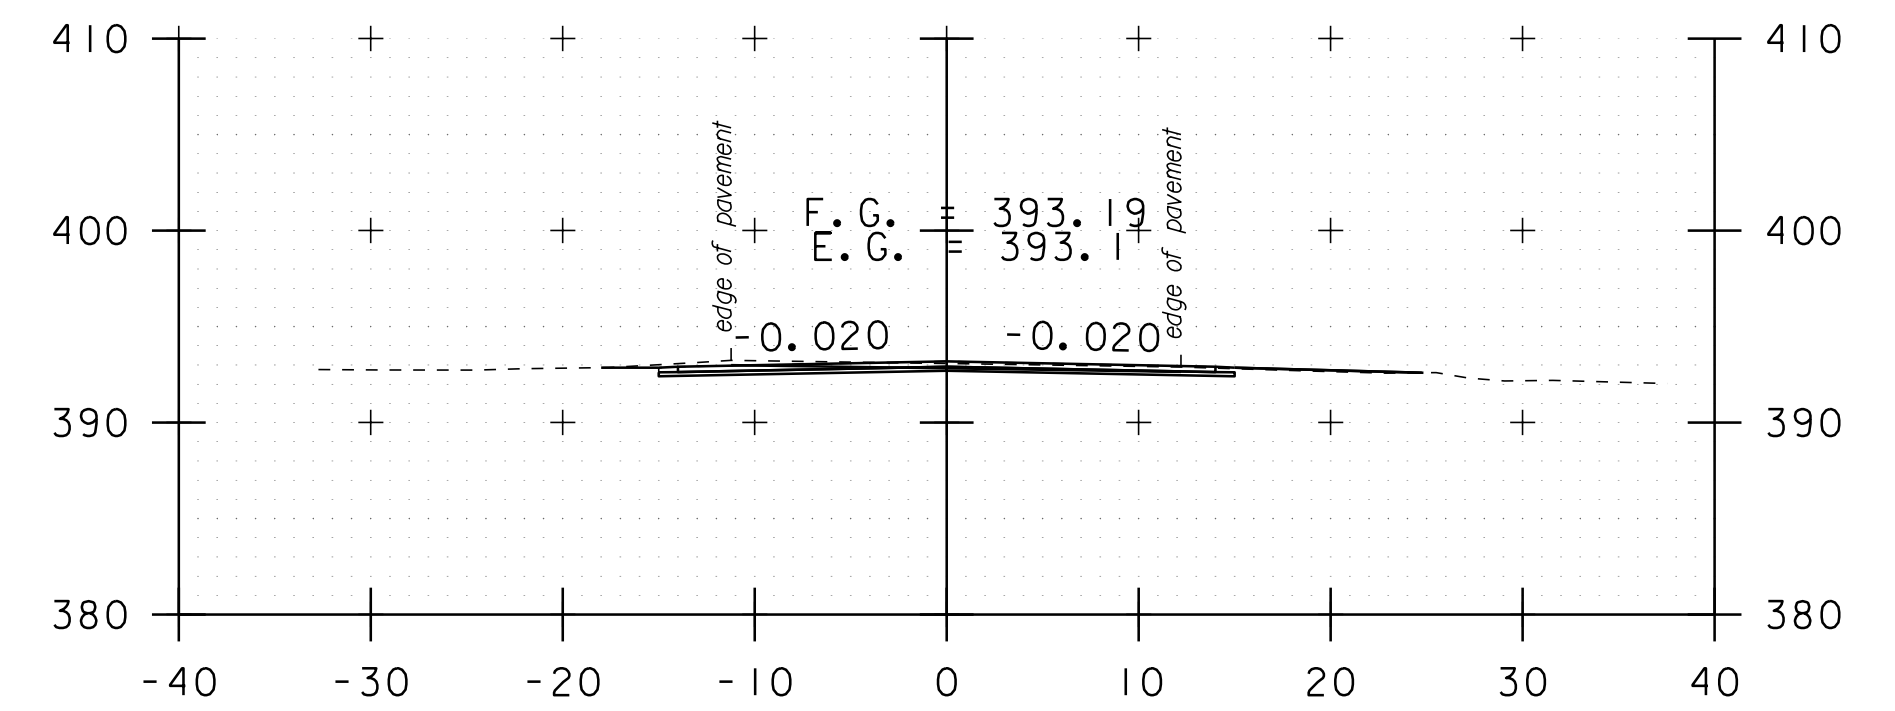


c 19+00
DRIVE LT & RT

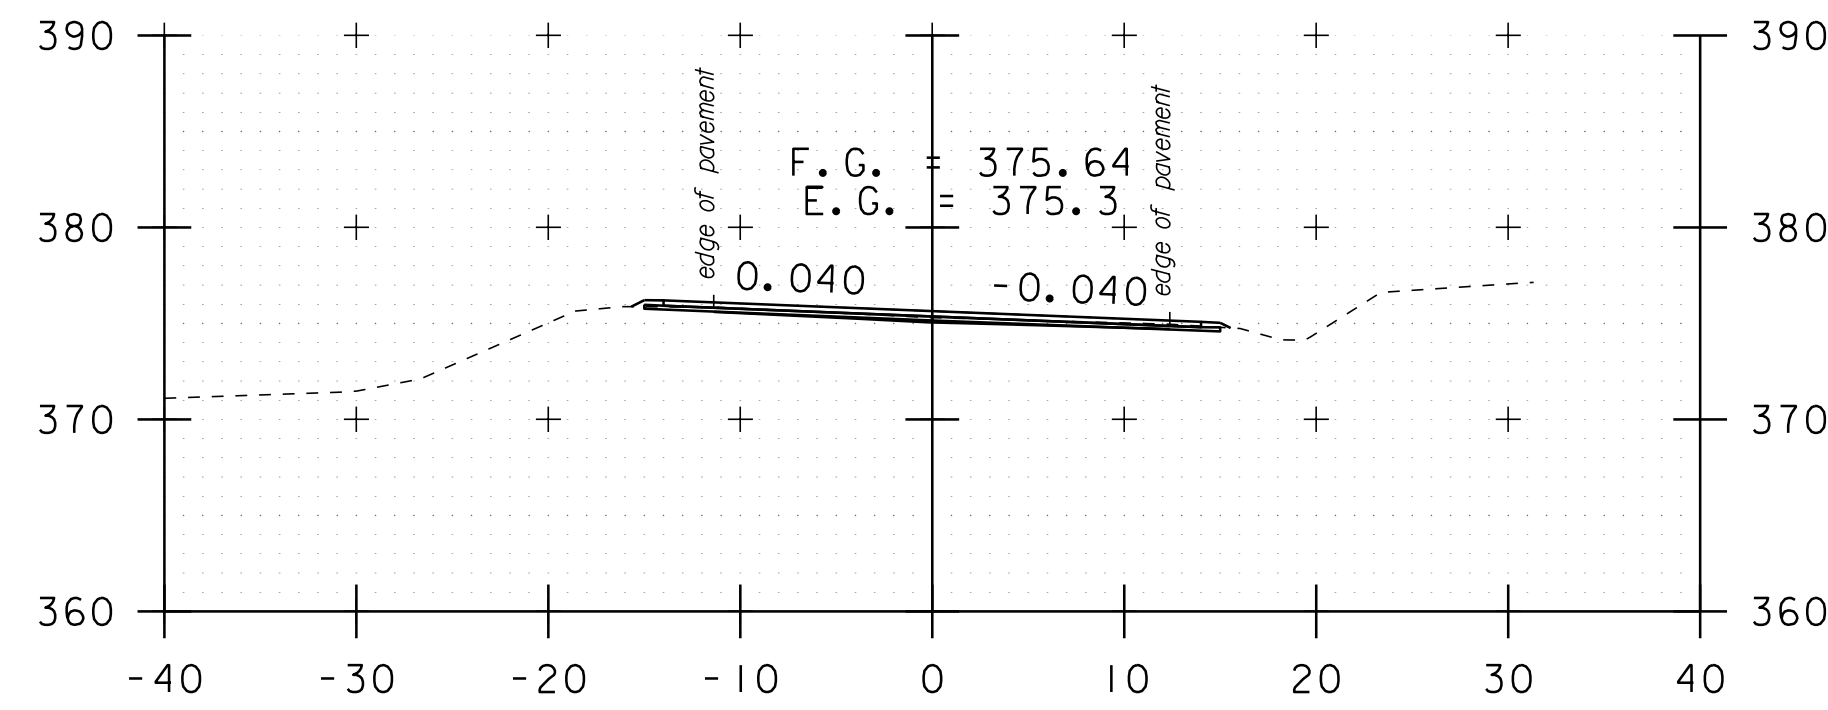


c 15+80

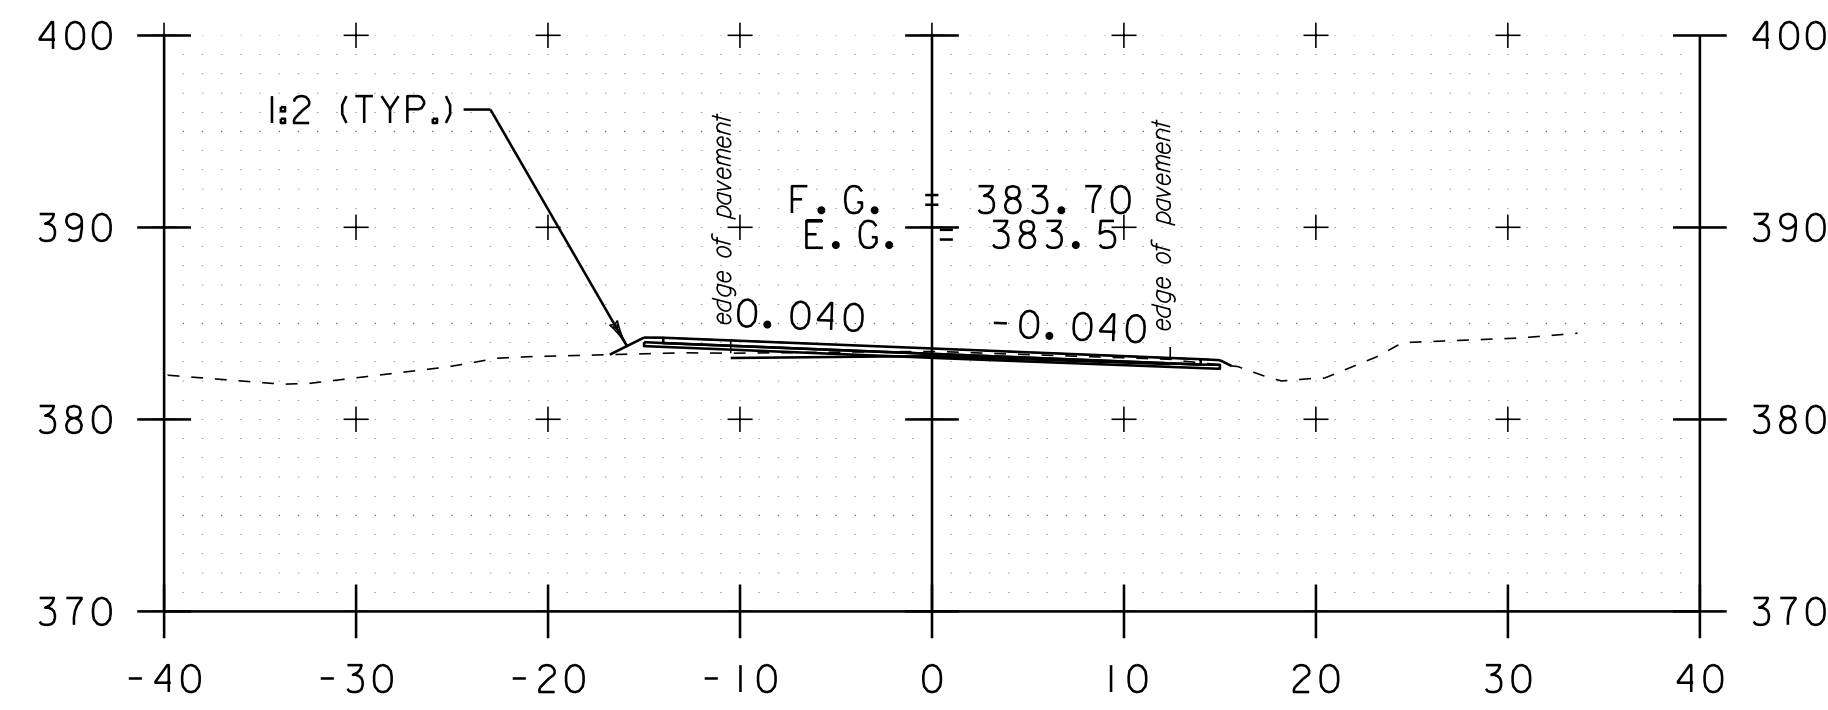


c 16+75

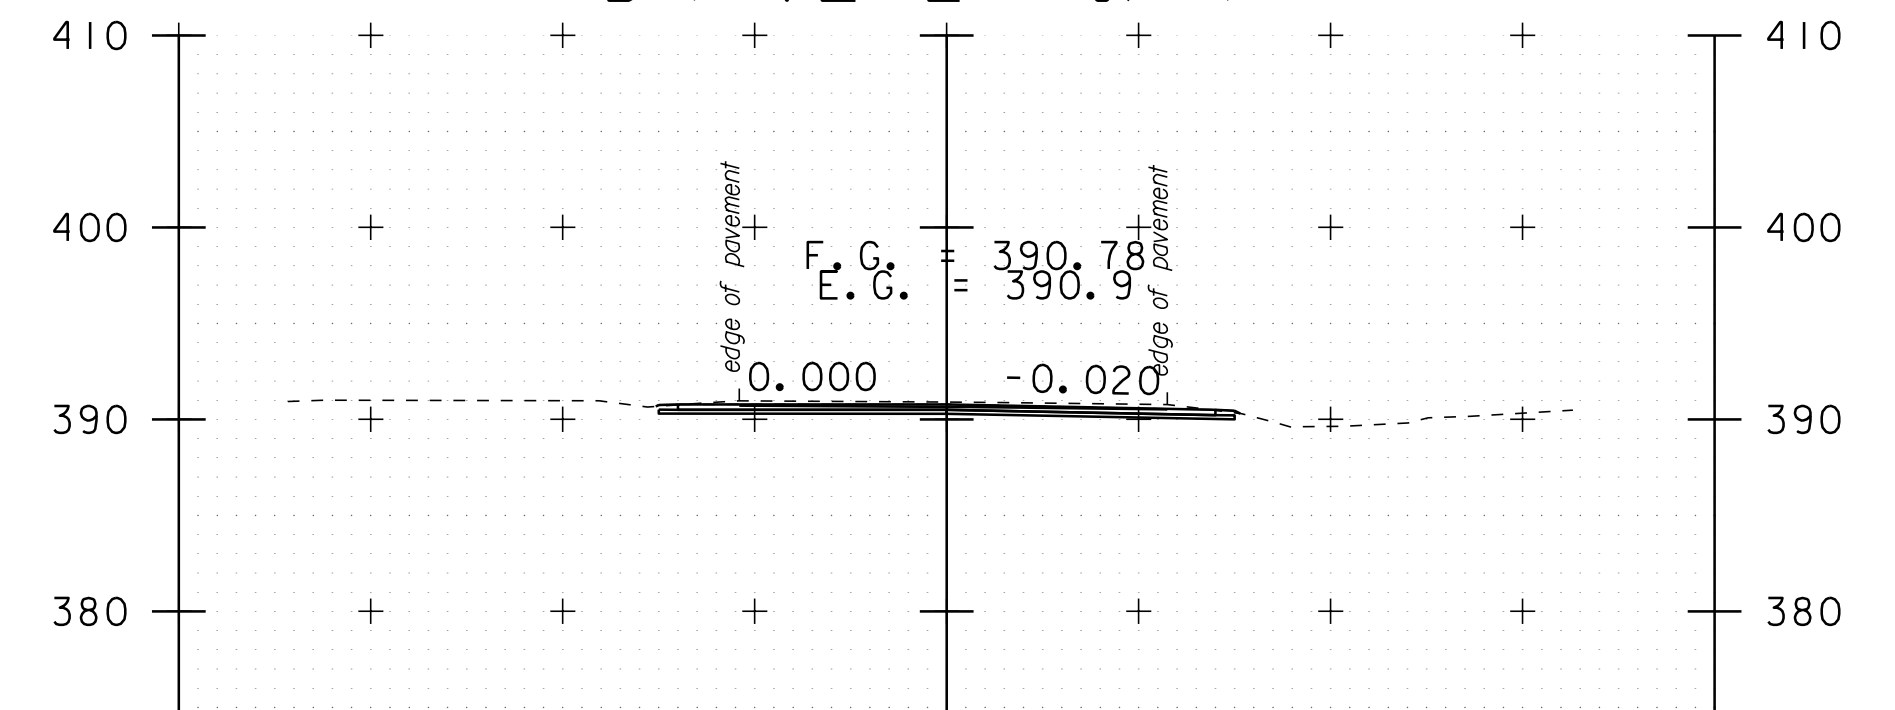


c 18+00

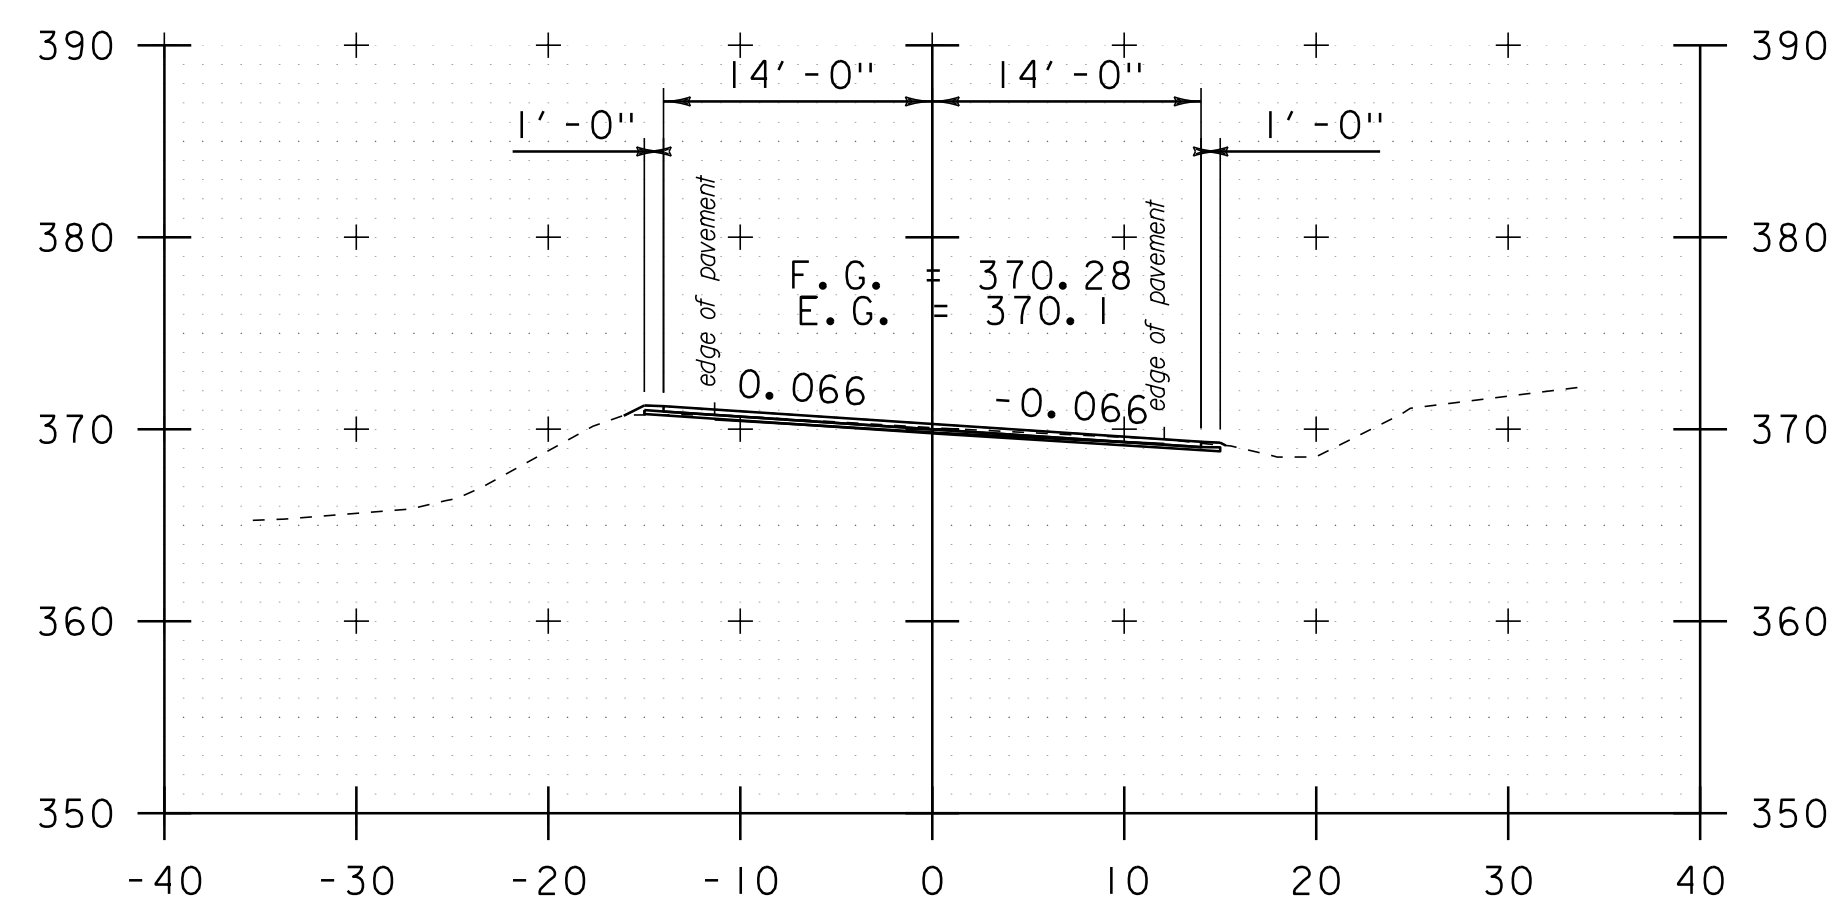

c 15+25

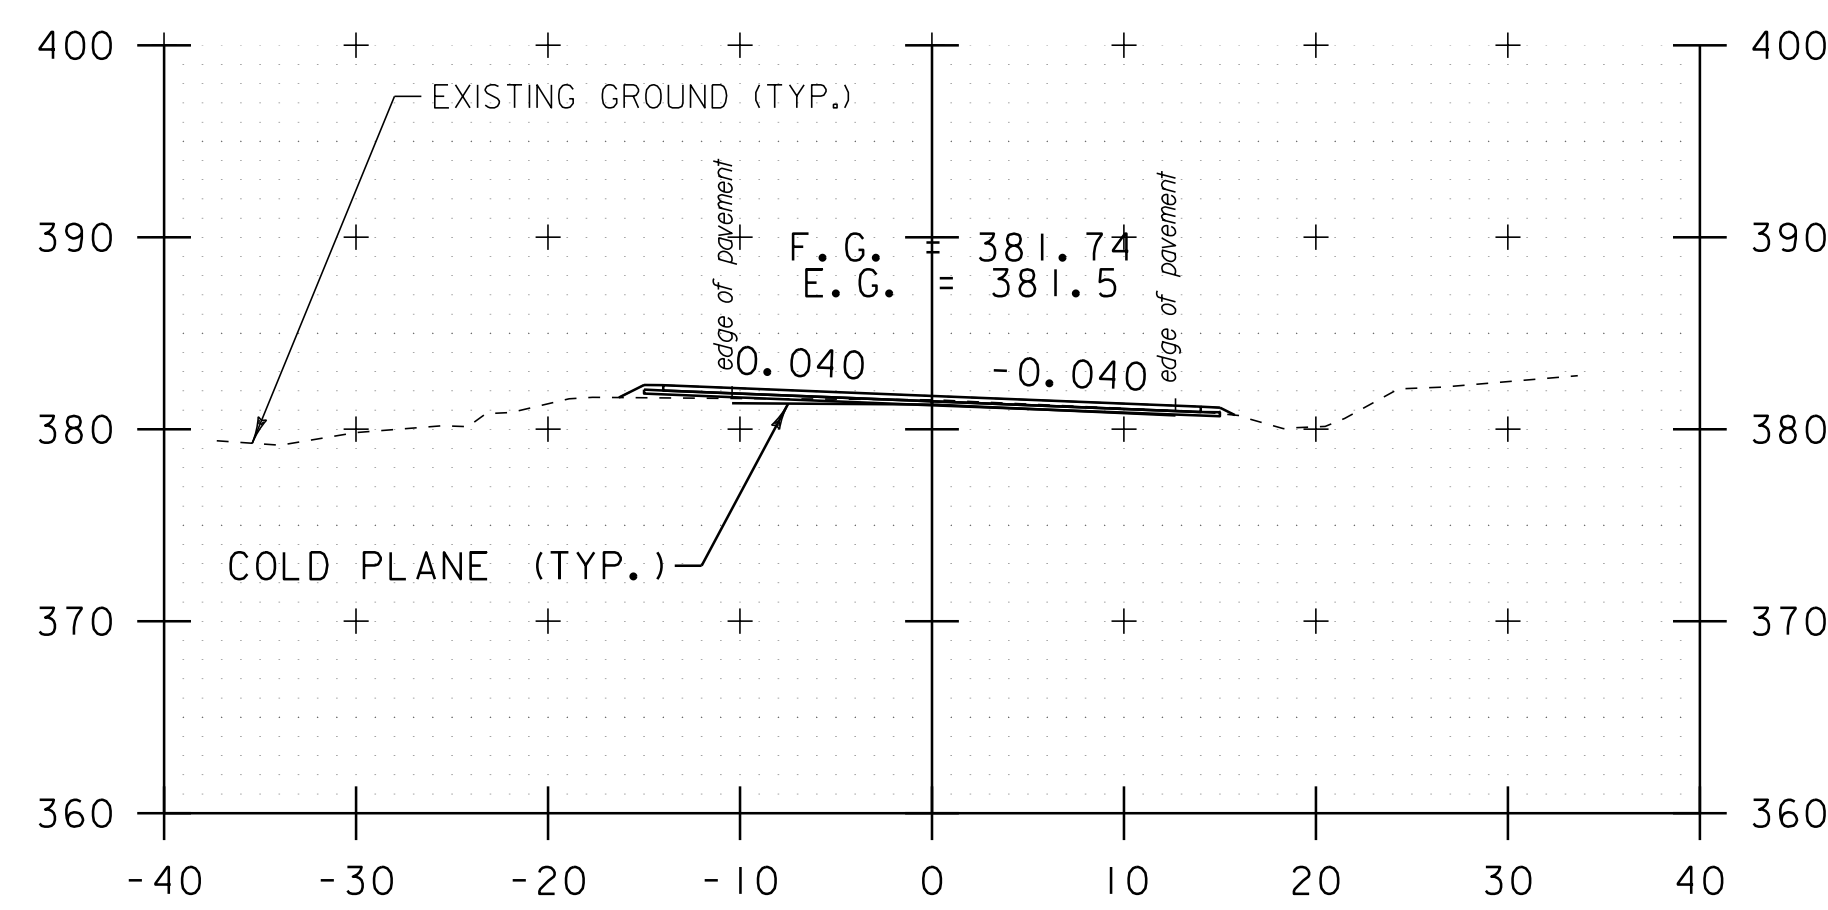


c 16+50

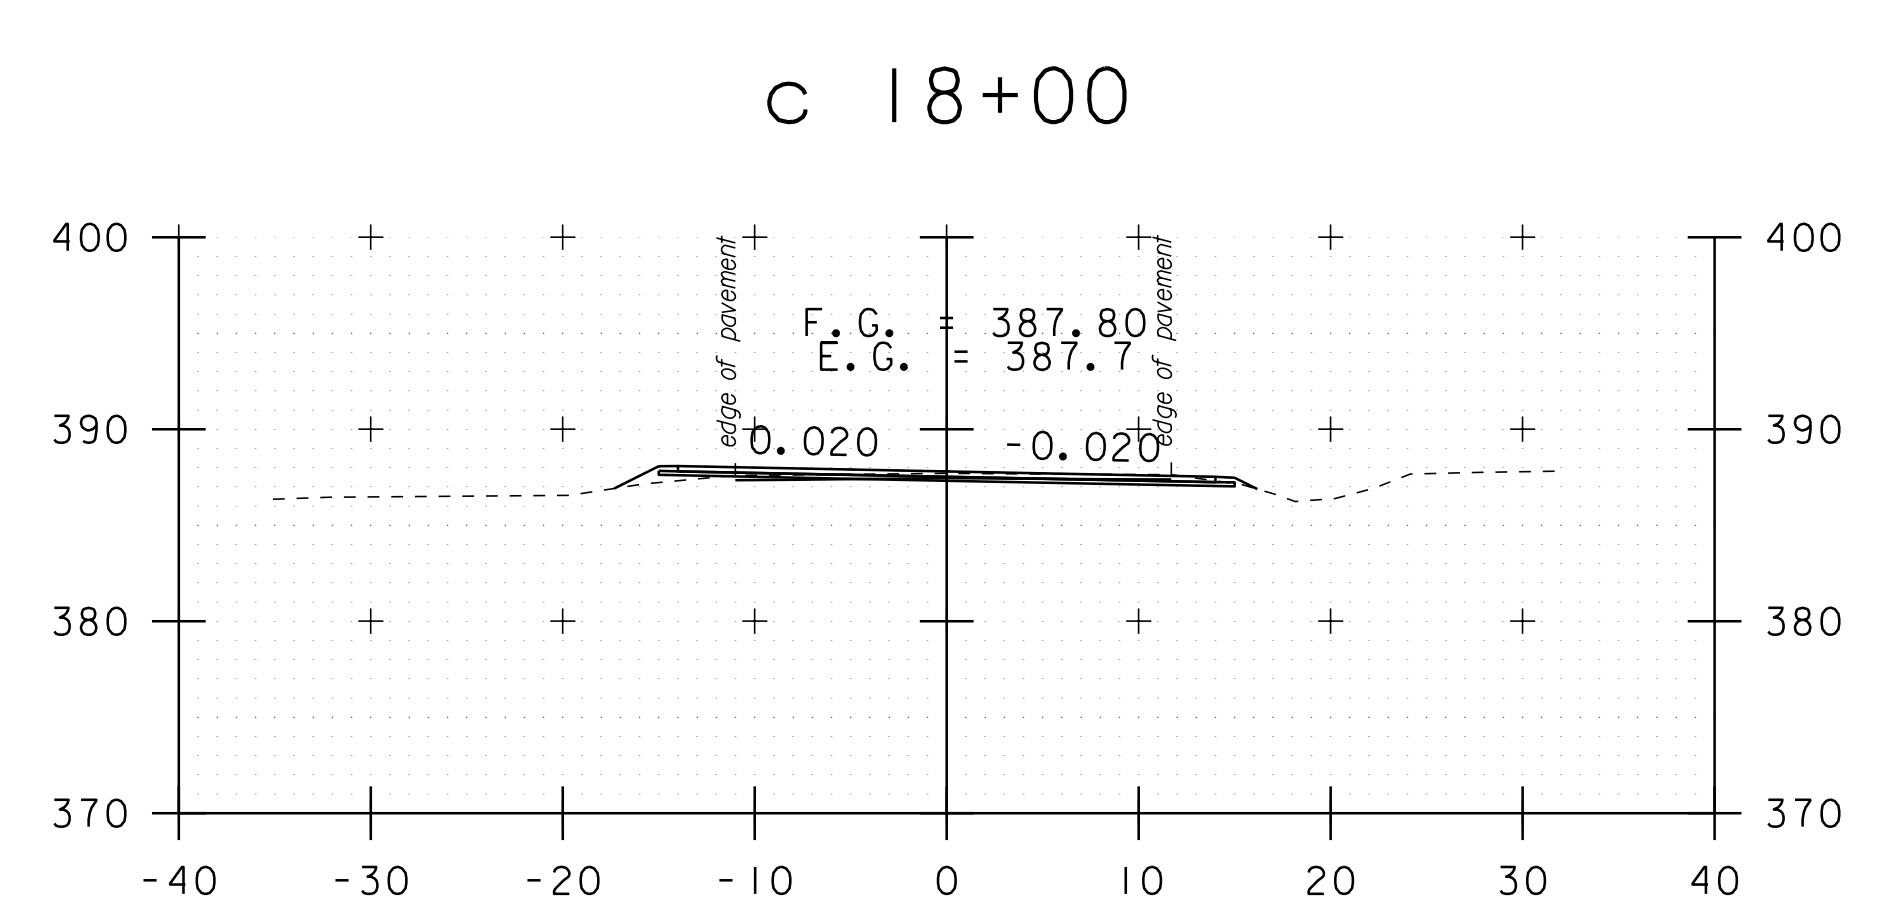

c 17+38

DATUM	NAVD 88
	NAD 83

STA. c 15+25 TO STA. c 19+00

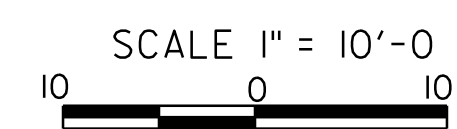

CROSS SECTION SHEET 45

PROJECT NAME:	ADDISON-NEW HAVEN	PLOT DATE:	3/13/2012
PROJECT NUMBER:	STP 9632(1)	DRAWN BY:	SJL
FILE NAME:	p95B076.dgn	CHECKED BY:	EPD
PROJECT LEADER:	CDL	SHEET	150 OF 186
DESIGNED BY:	SJL		
PLOT FILE:	p95B076_150.1		