




c 24+95

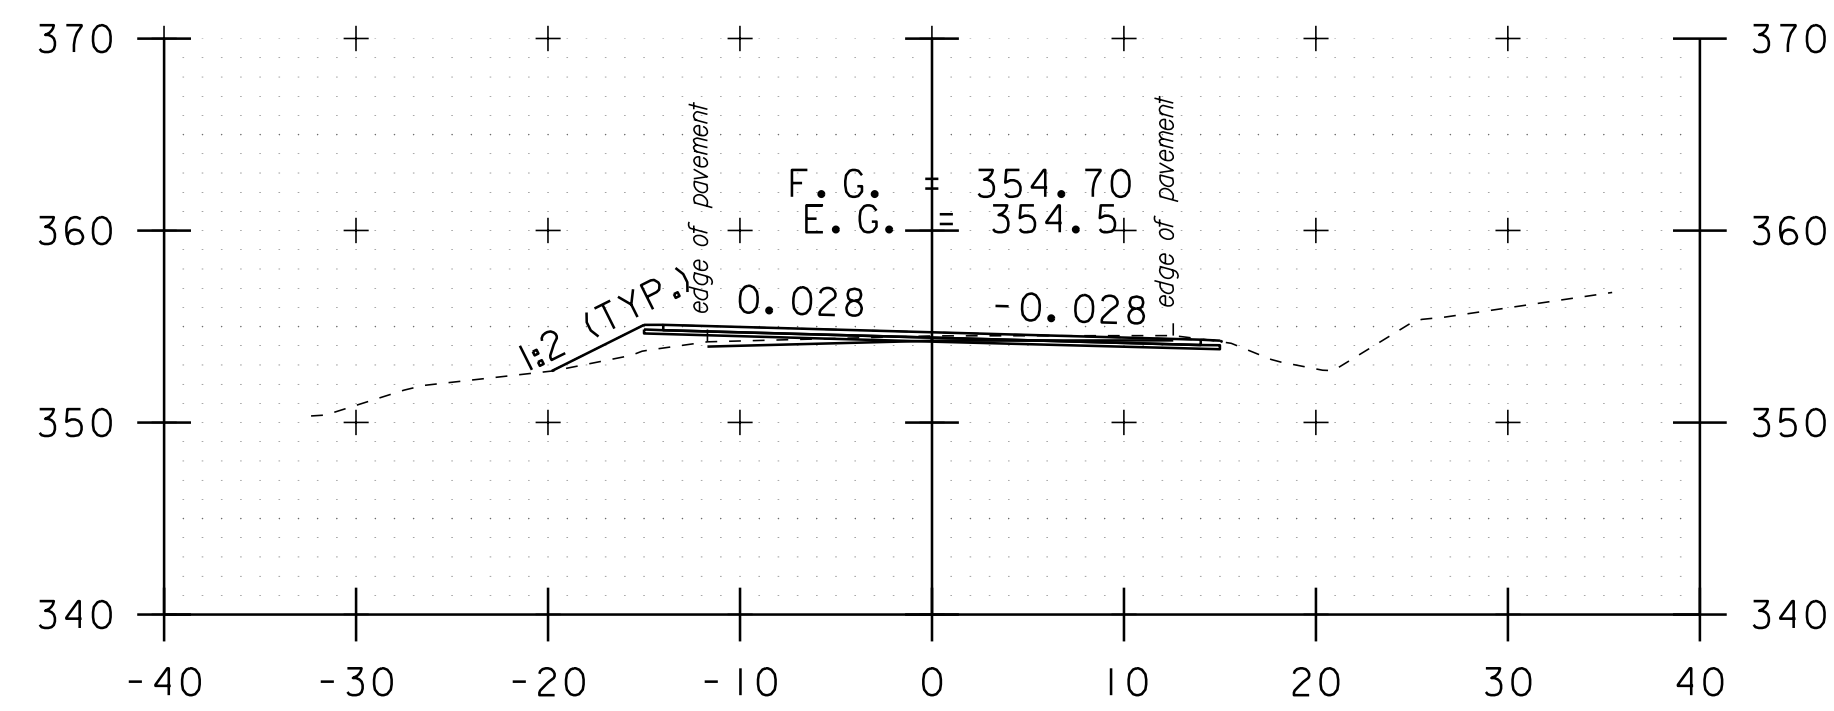


c 27+20

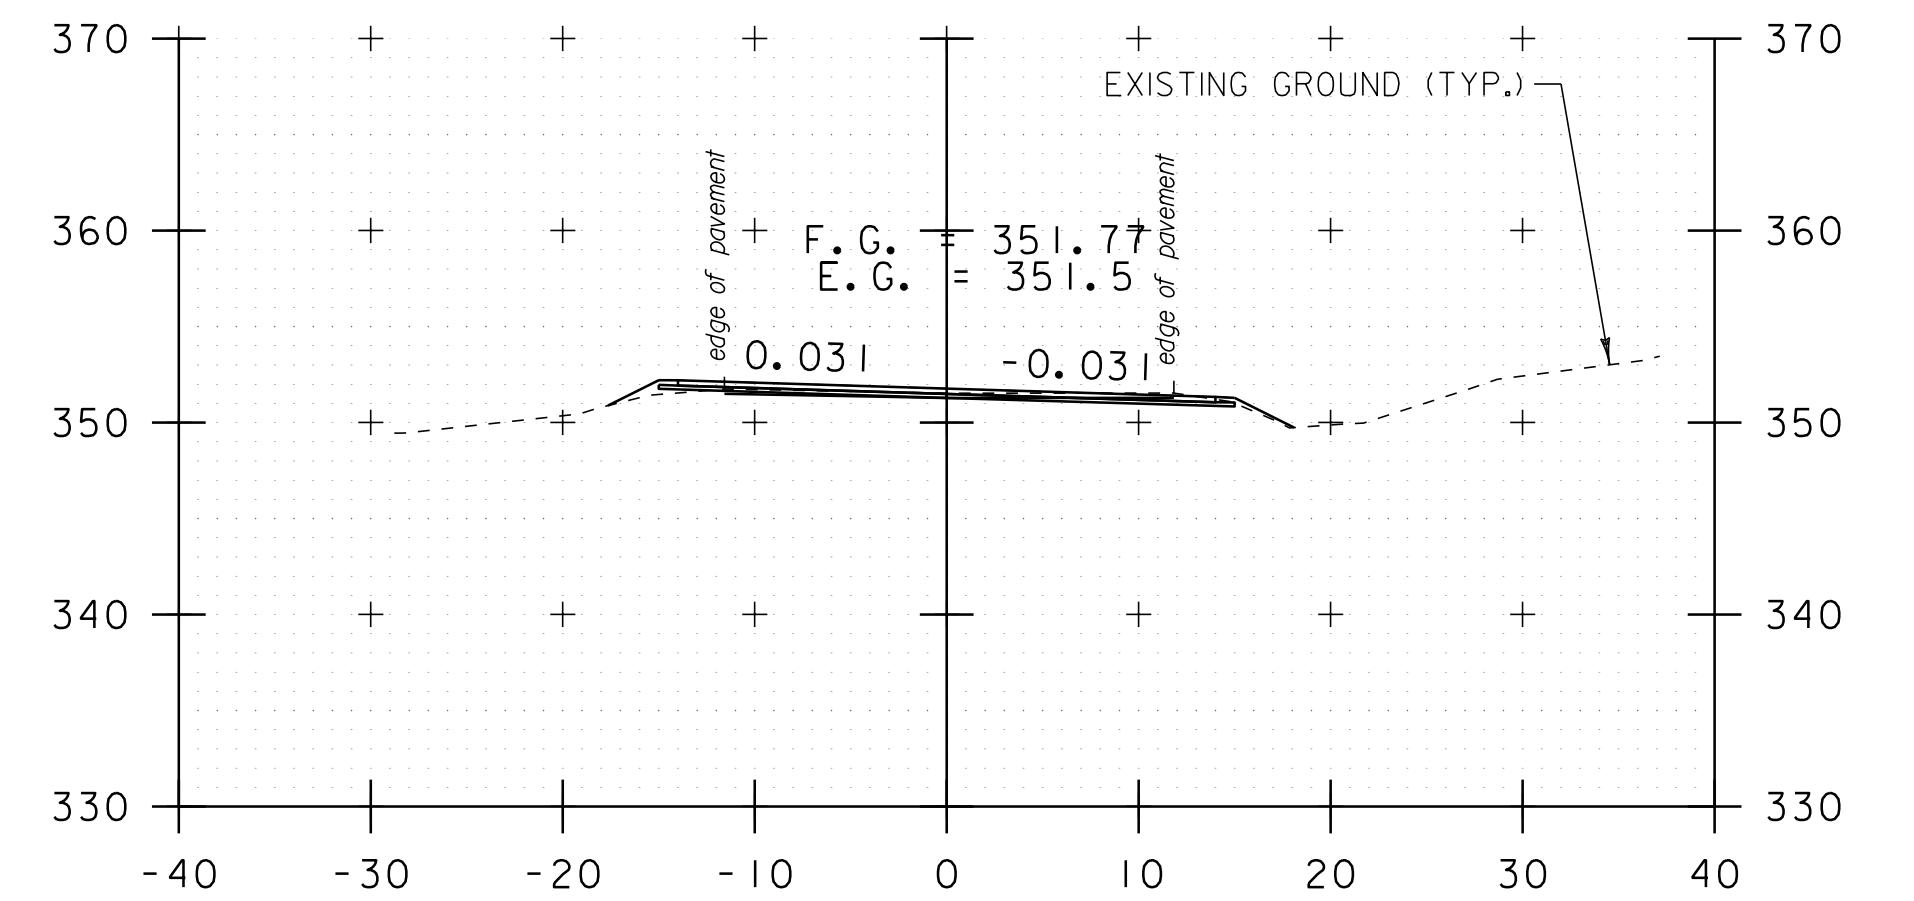


c 28+00

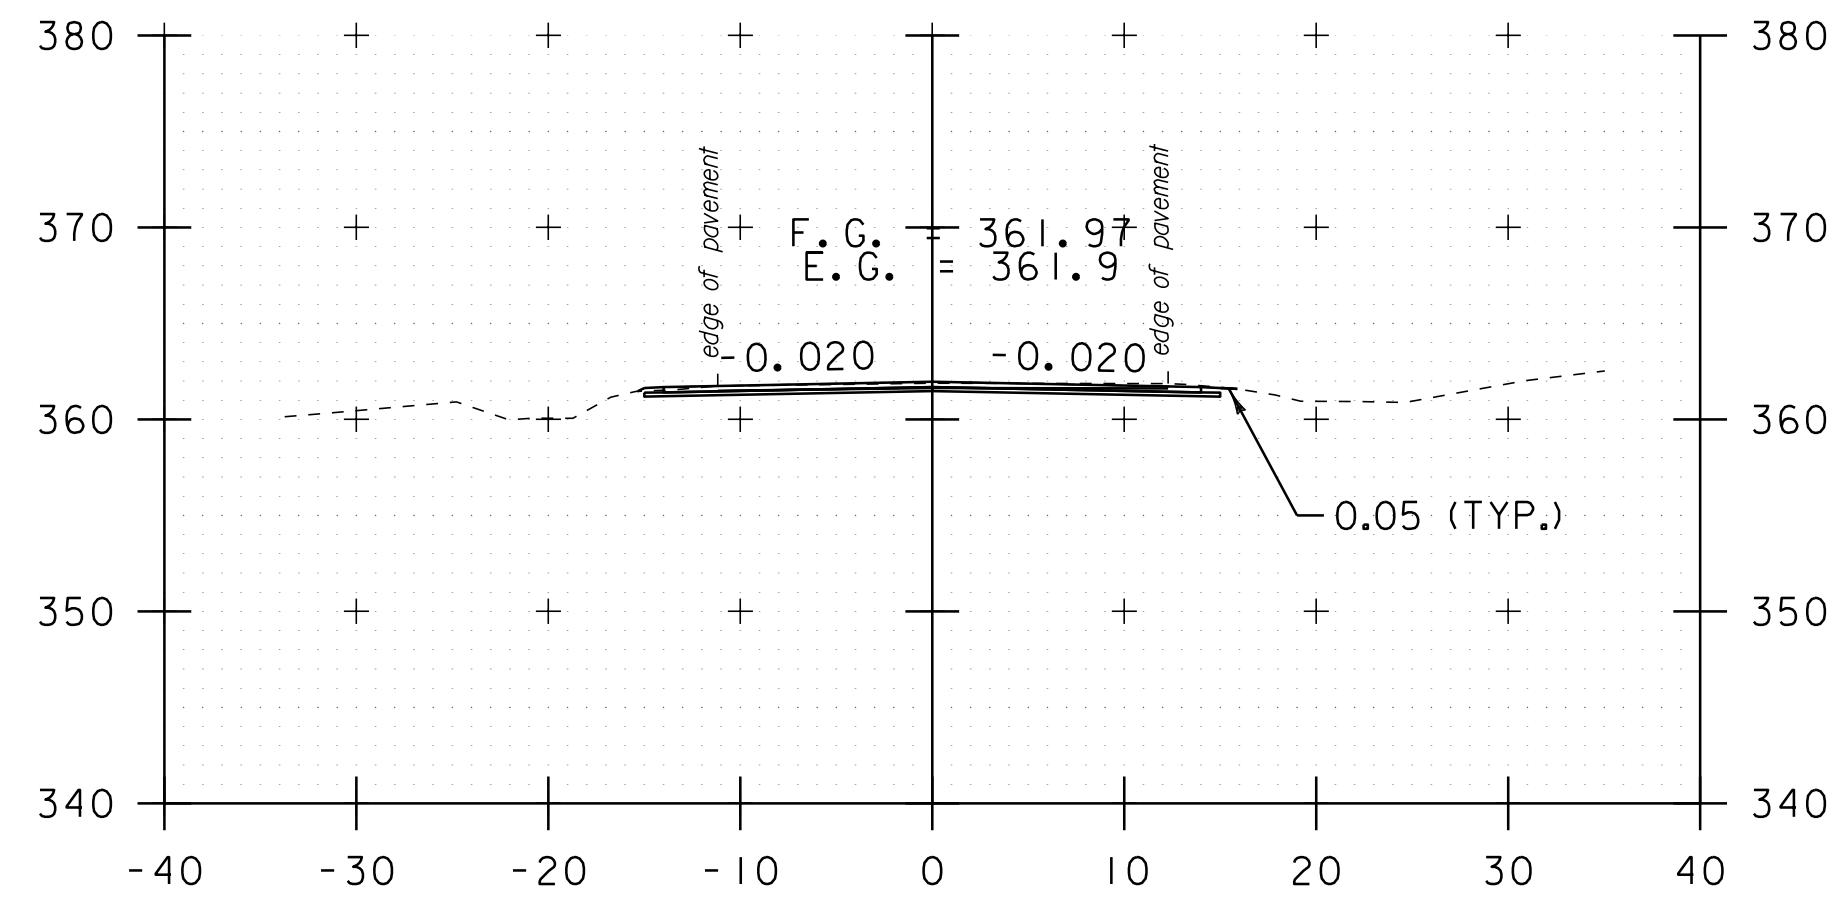


c 24+50

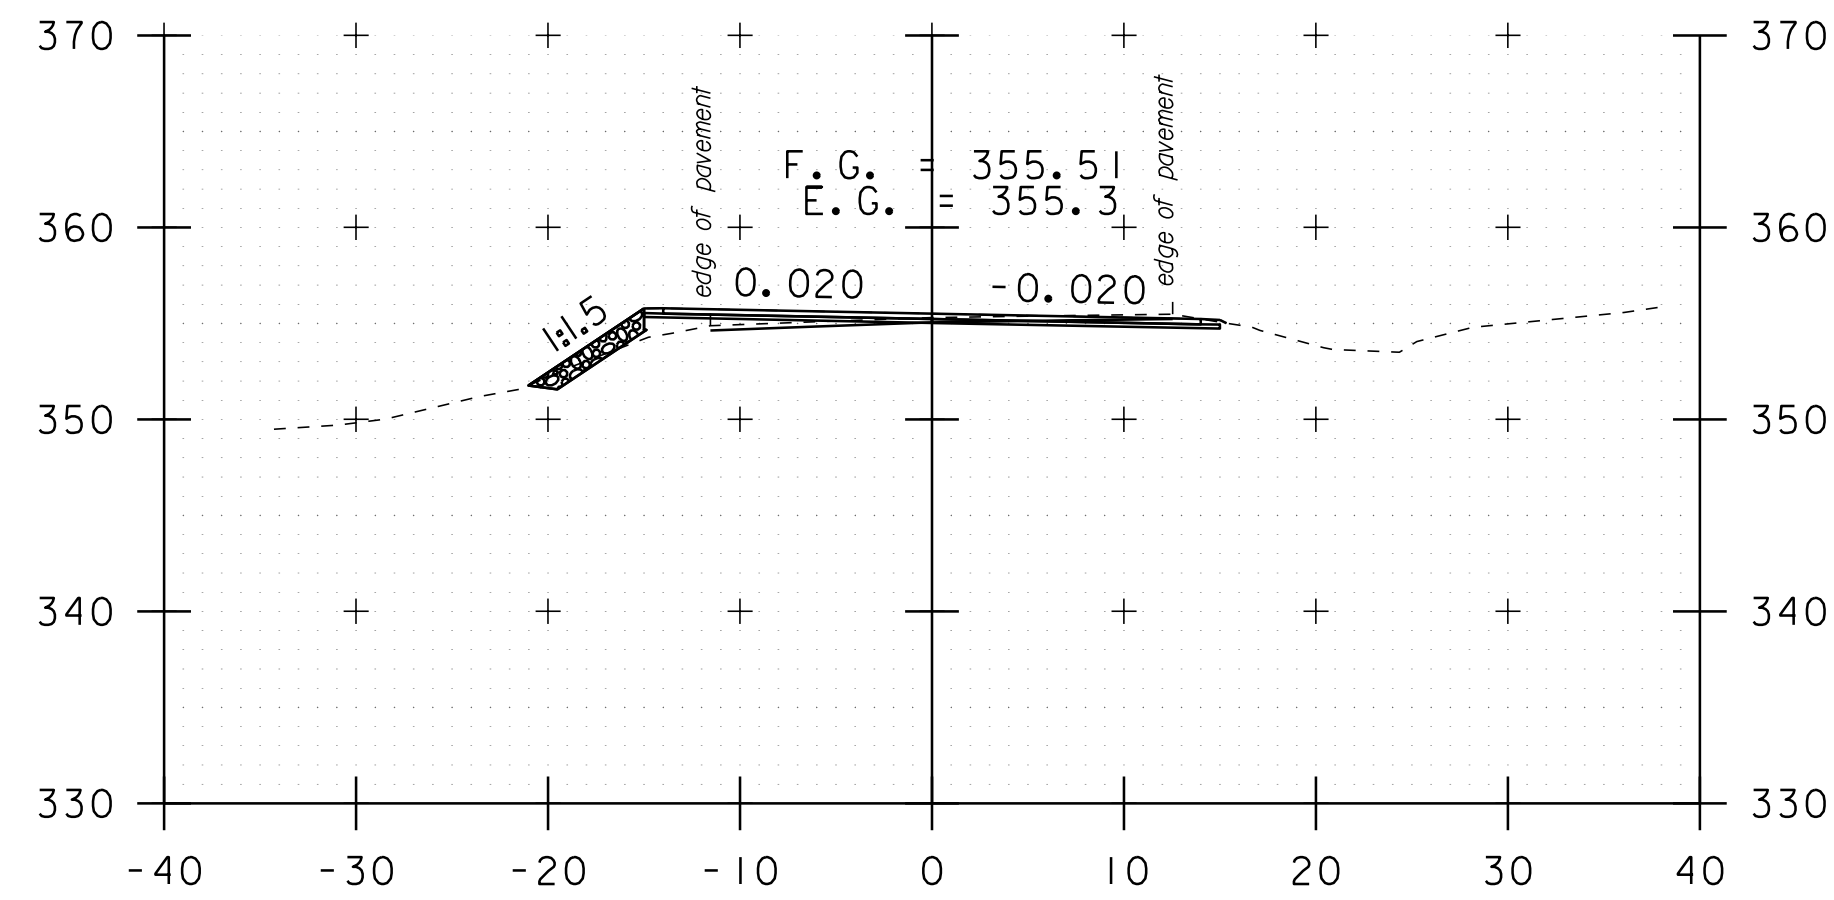

c 26+85

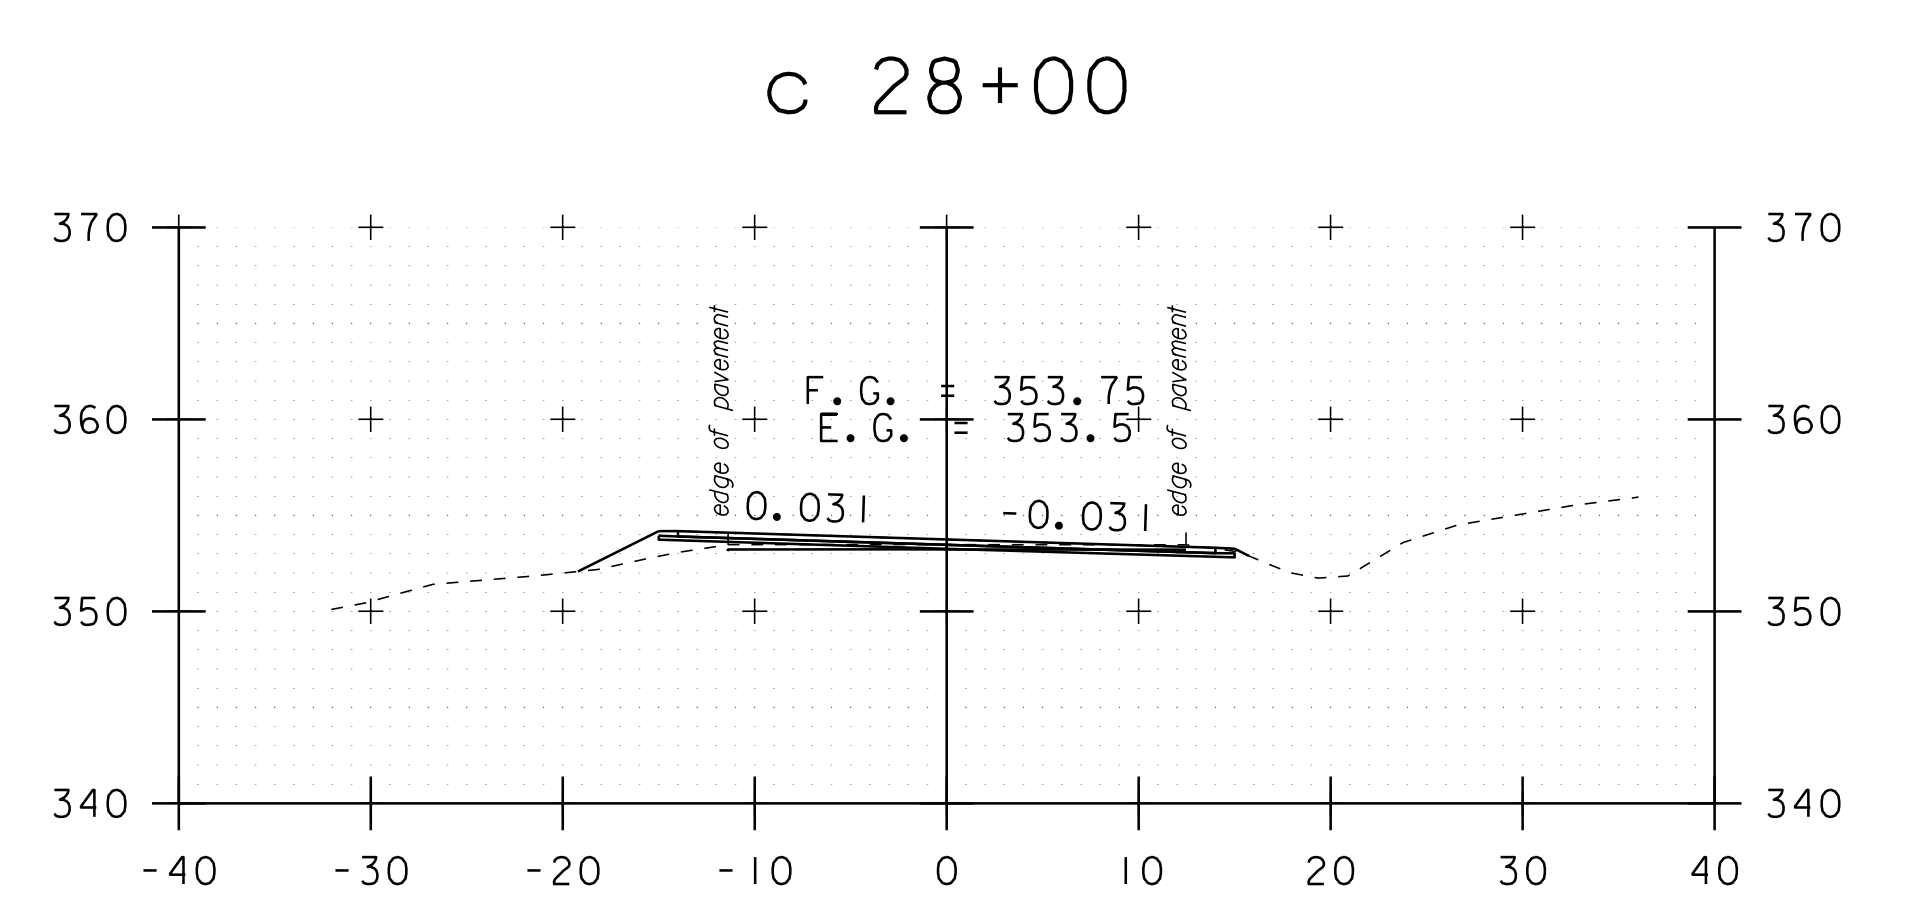


c 27+50

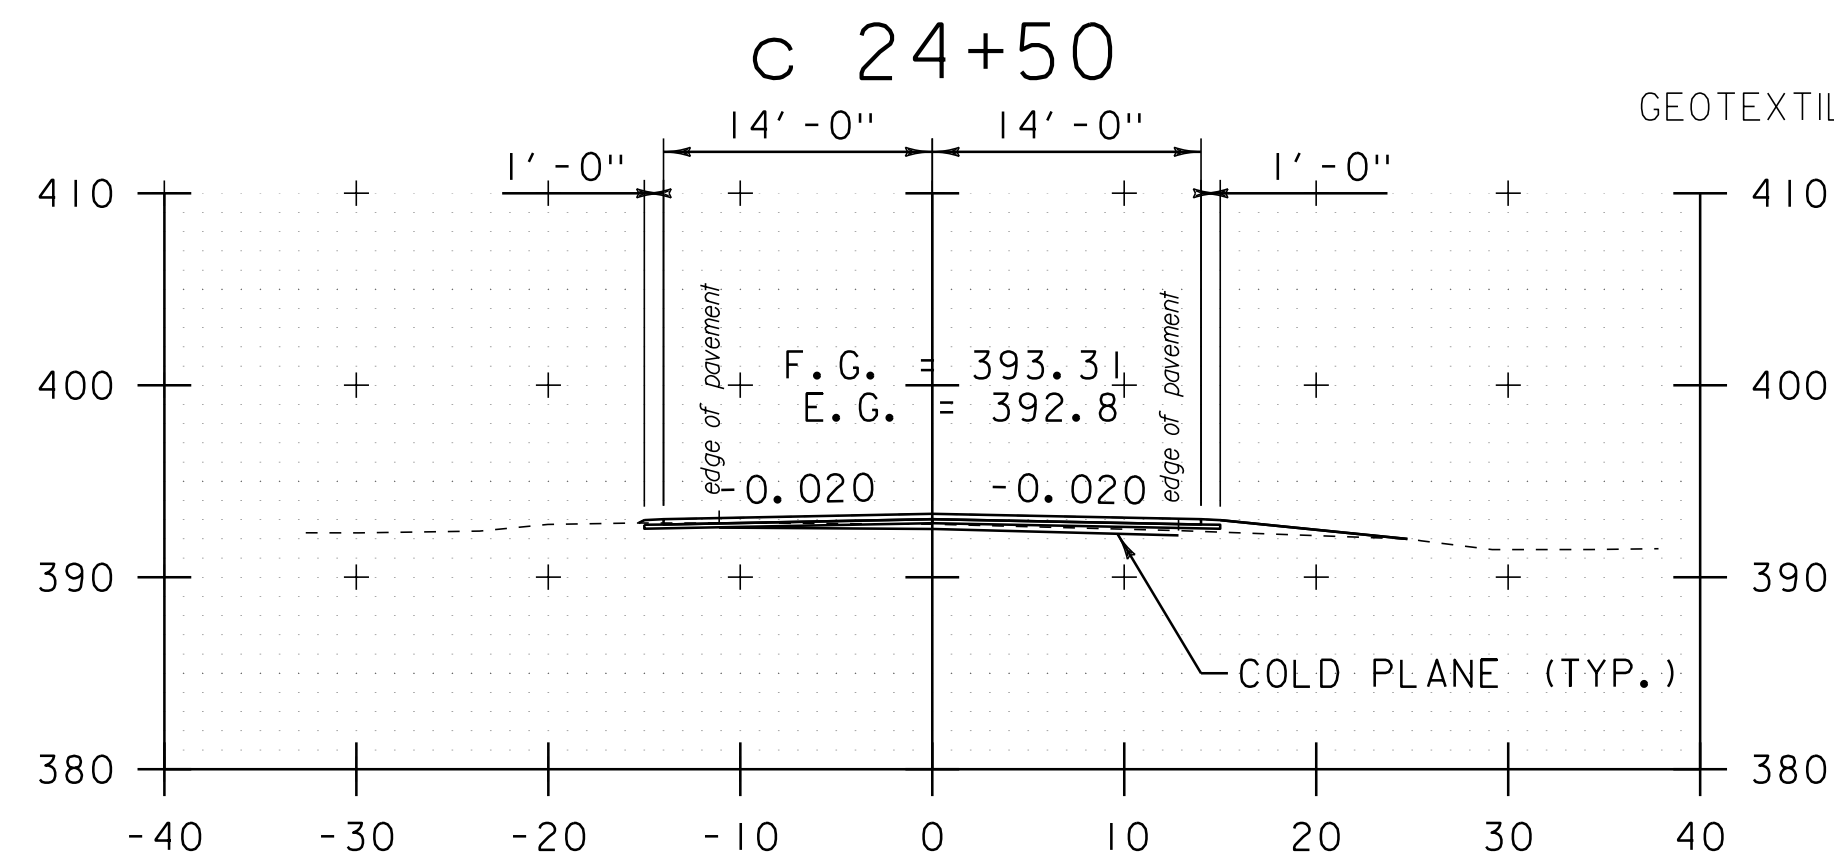


c 19+50
DRIVE RT

12" TYPE 1 STONE FILL (TYP.)
GEOTEXTILE UNDER STONE FILL (TYP.)

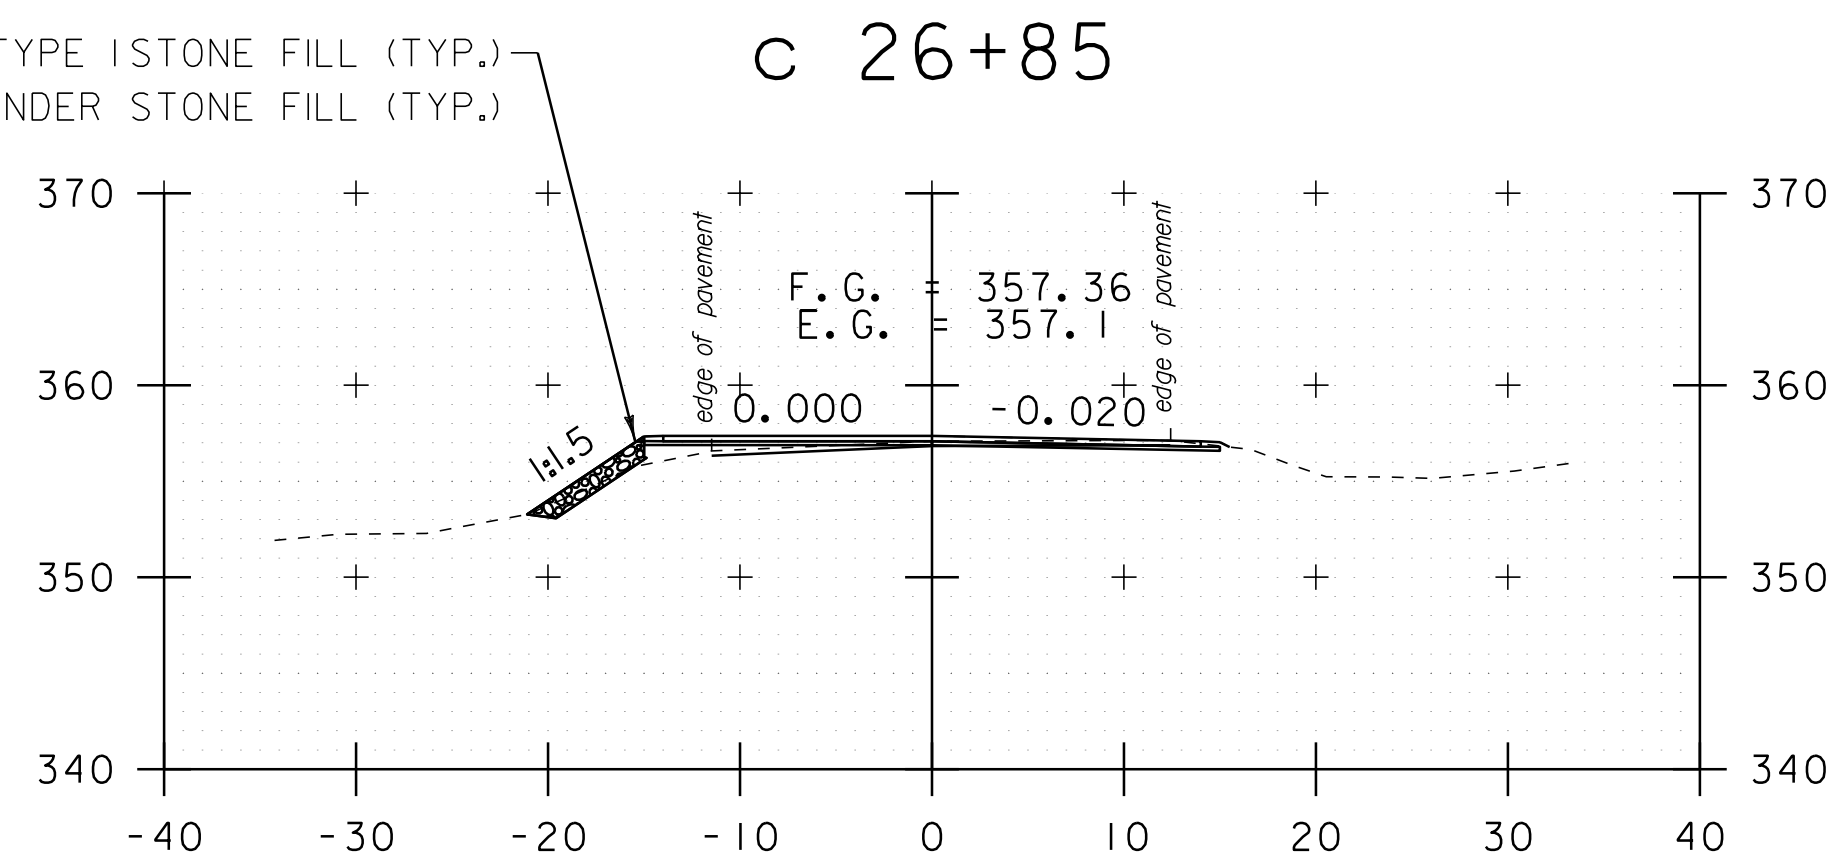


c 25+95

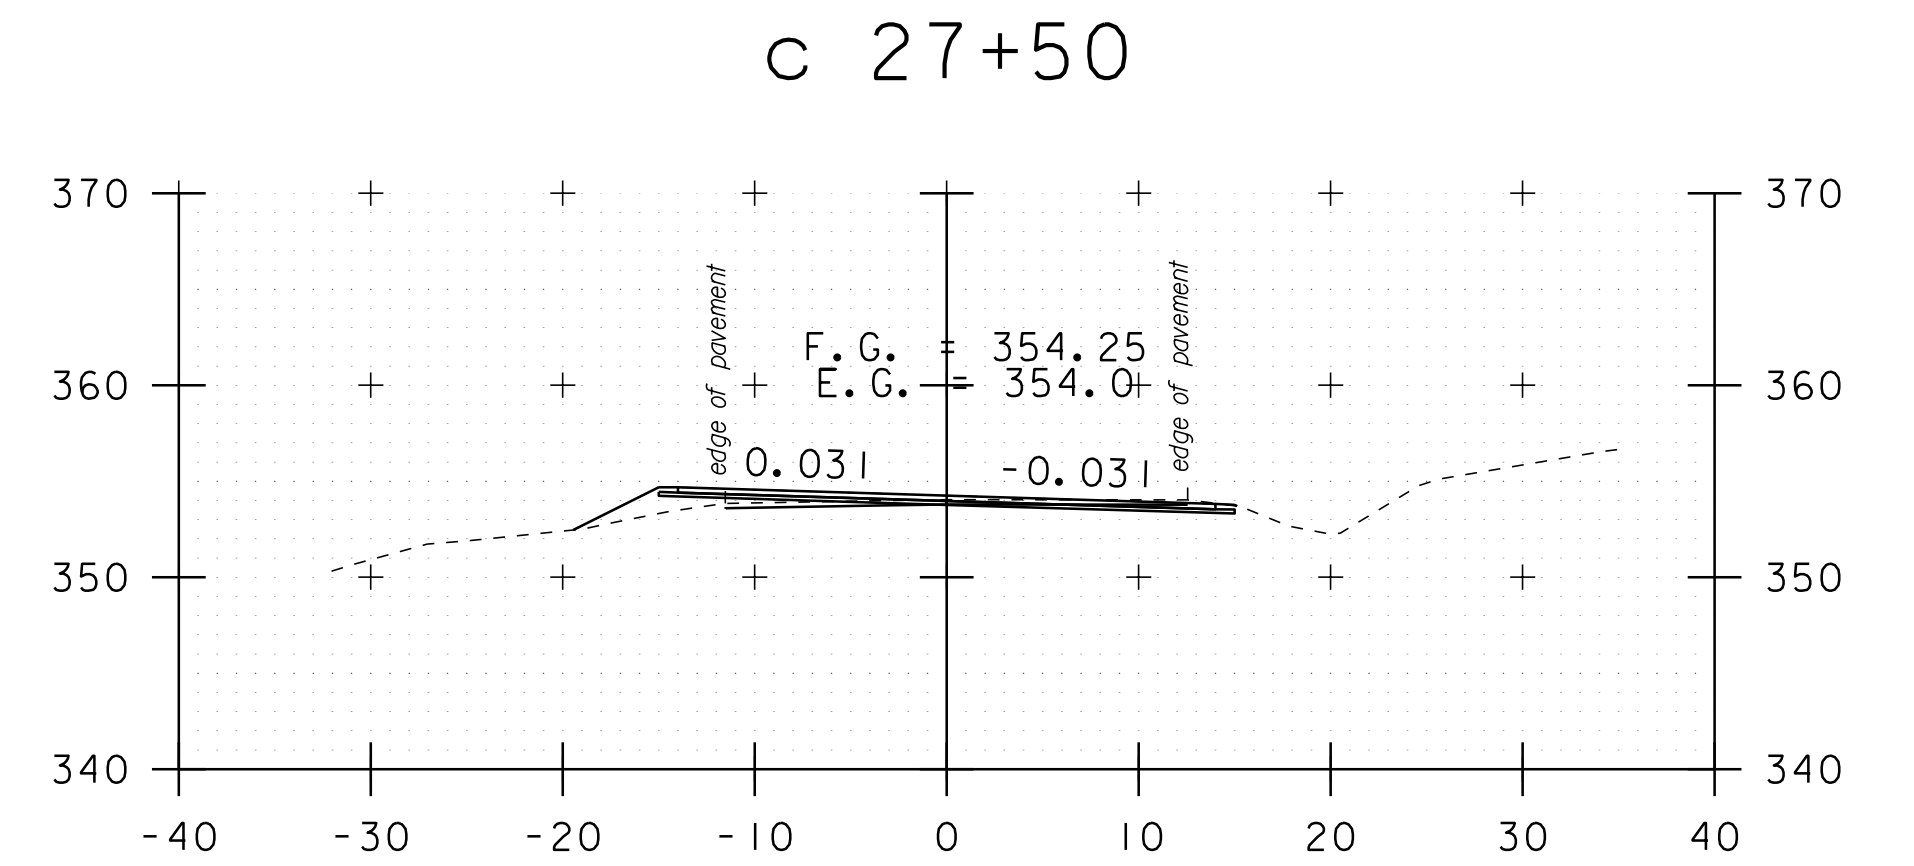

c 27+35

DATUM	NAVD 88
	NAD 83

STA. c 19+50 TO STA. c 28+00

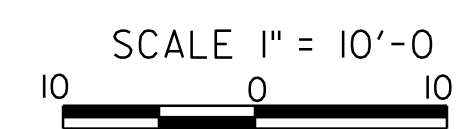

CROSS SECTION SHEET 46

PROJECT NAME:	ADDISON-NEW HAVEN
PROJECT NUMBER:	STP 9632(1)
FILE NAME:	p95B076.dgn
PROJECT LEADER:	CDL
DESIGNED BY:	SJL
PLOT FILE:	p95B076_151.1
PLOT DATE:	3/13/2012
DRAWN BY:	SJL
CHECKED BY:	EPD
SHEET	151 OF 186