


STA. c 28+30 TO STA. c 31+80

DATUM	NAVD 88
	NAD 83

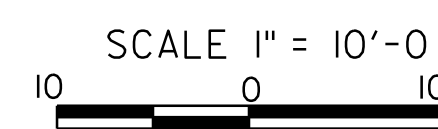

CROSS SECTION SHEET 47

PROJECT NAME: ADDISON-NEW HAVEN
PROJECT NUMBER: STP 9632(1)

FILE NAME: p95B076.dgn
PROJECT LEADER: CDL
DESIGNED BY: SJL
PLOT FILE: p95B076_I52.1

PLOT DATE: 3/13/2012
DRAWN BY: SJL
CHECKED BY: EPD
SHEET 152 OF 186