




c 33+50

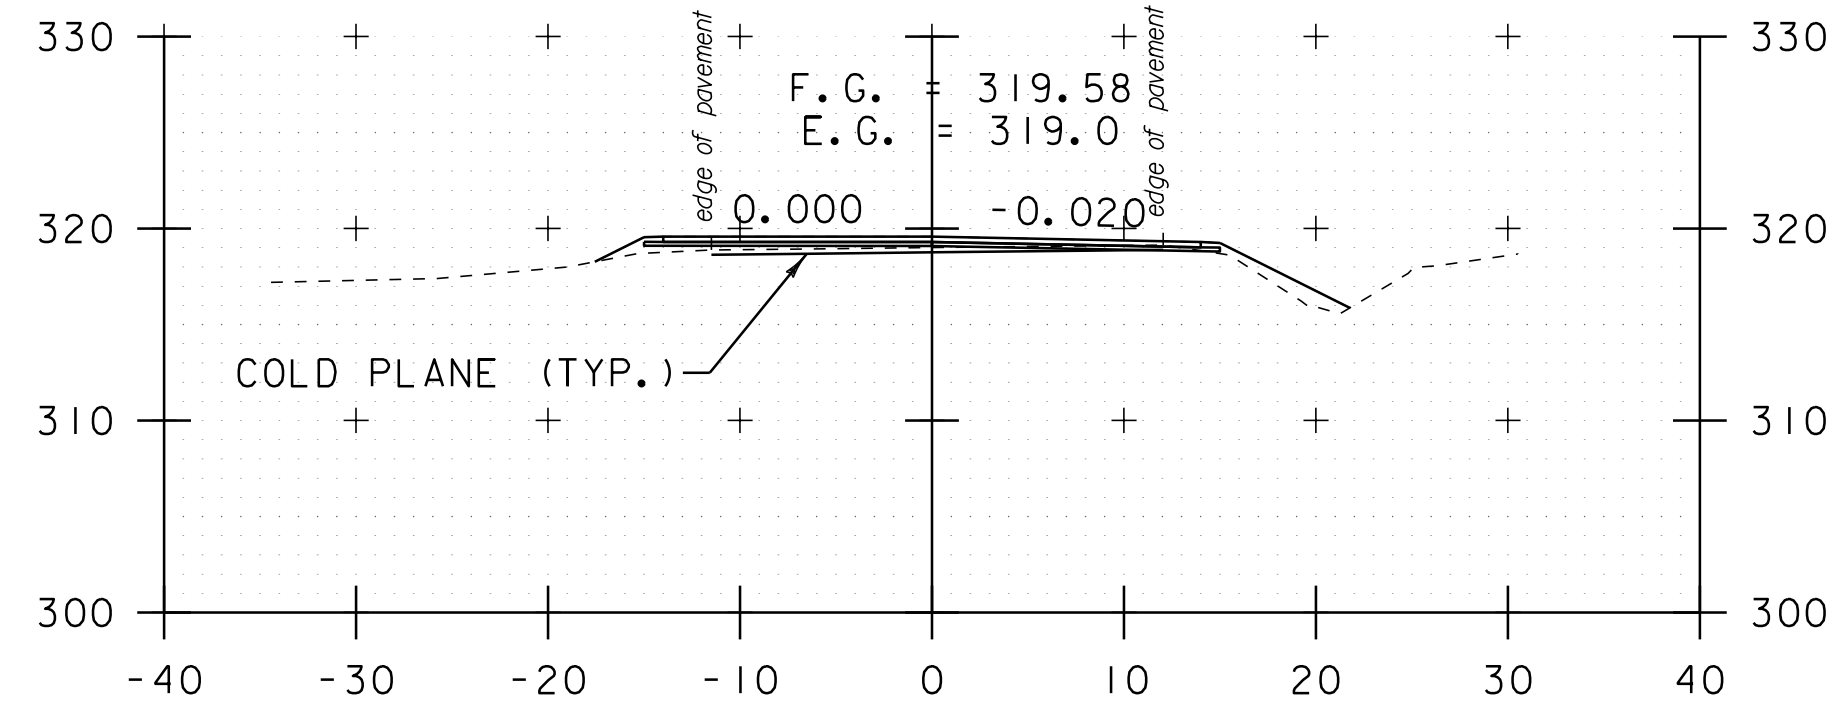


d 128+20

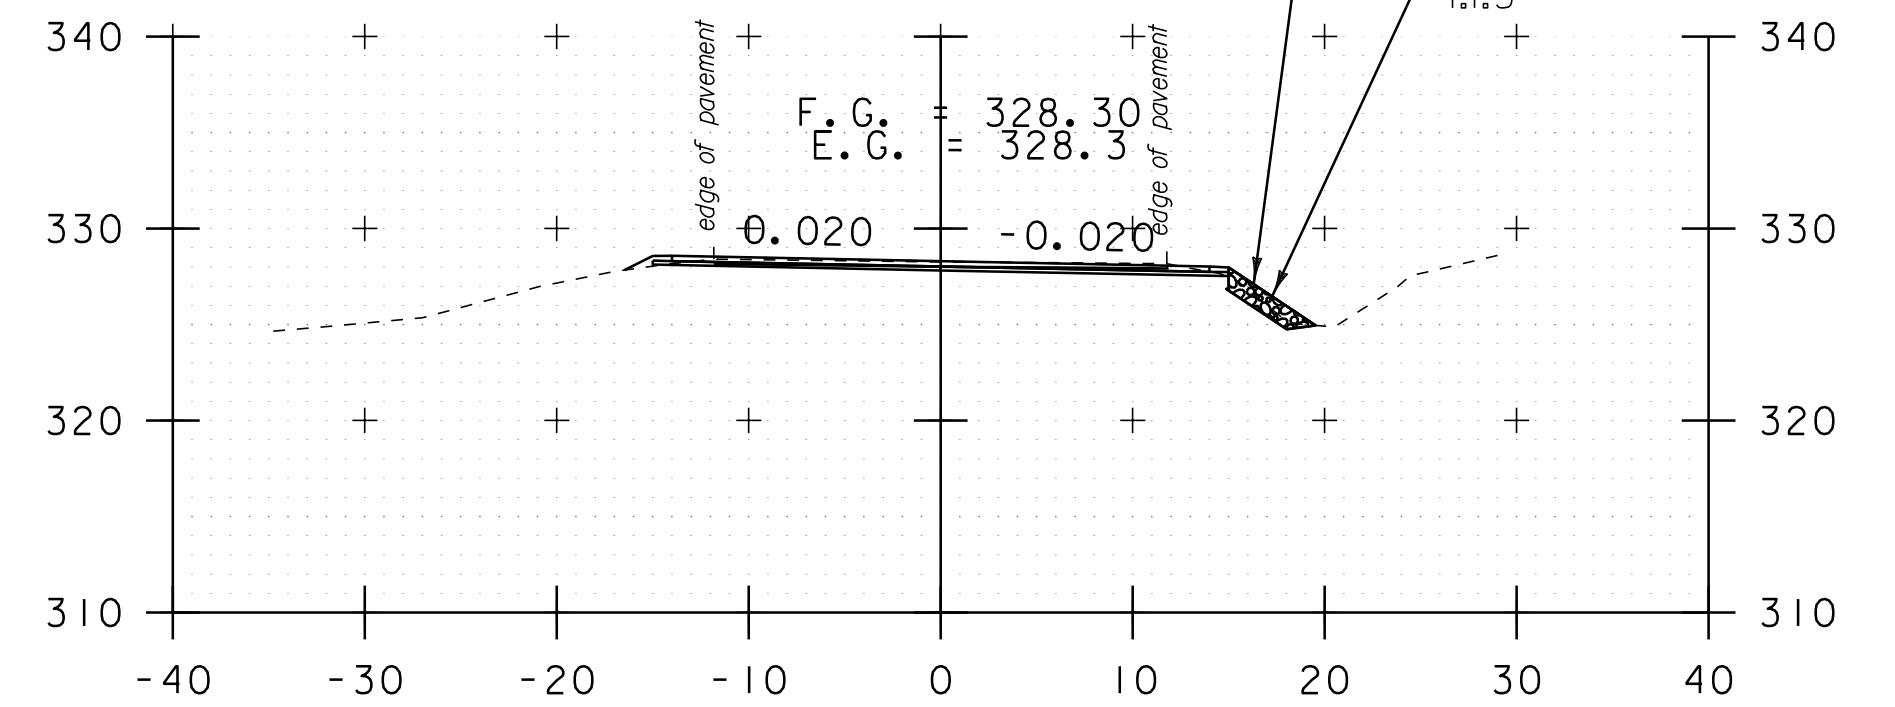


d 130+00

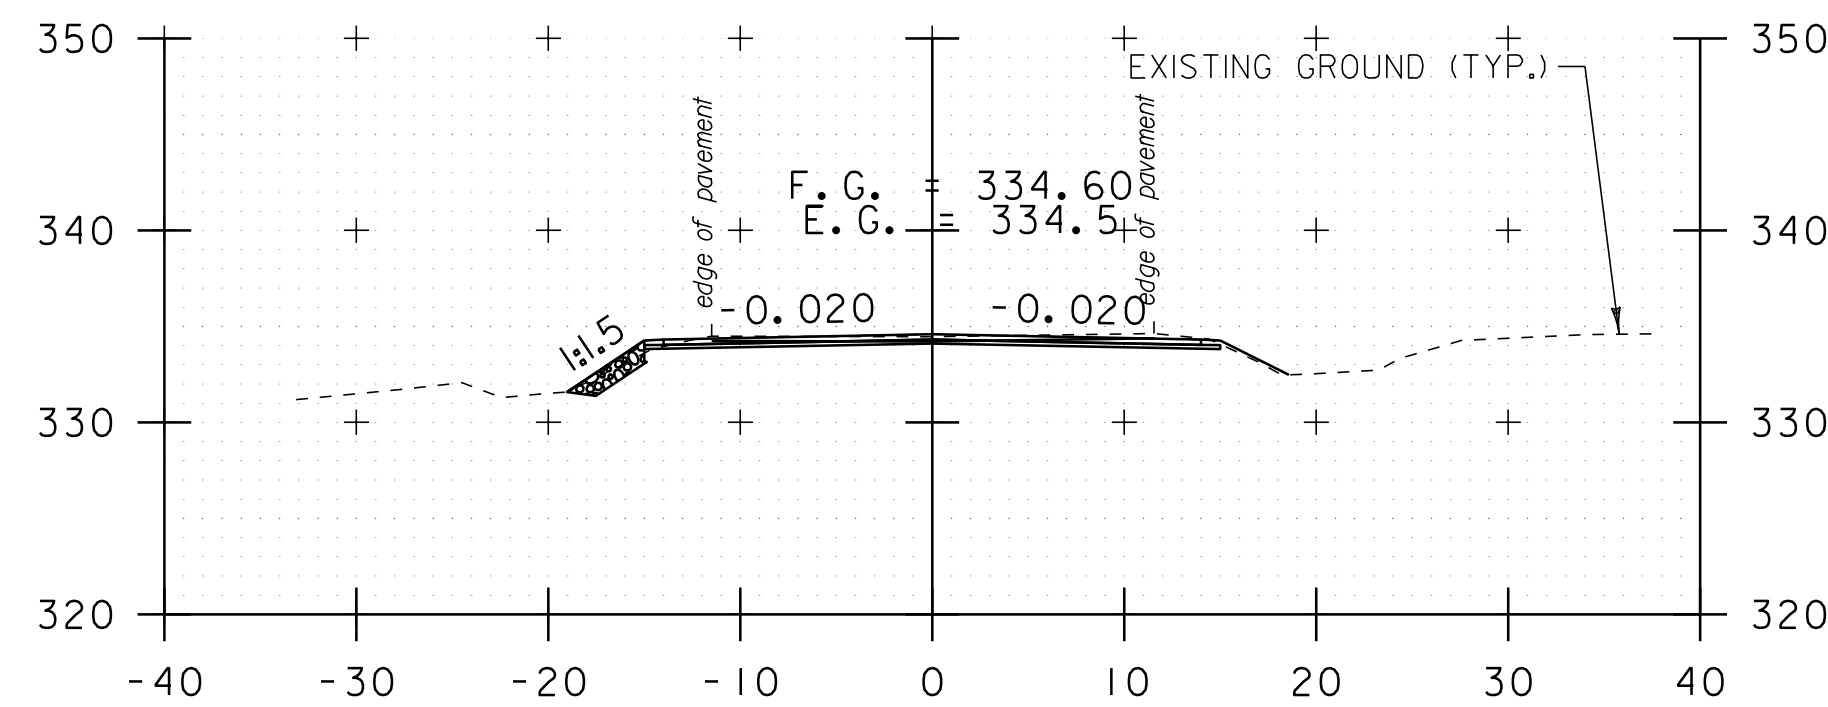


c 33+25

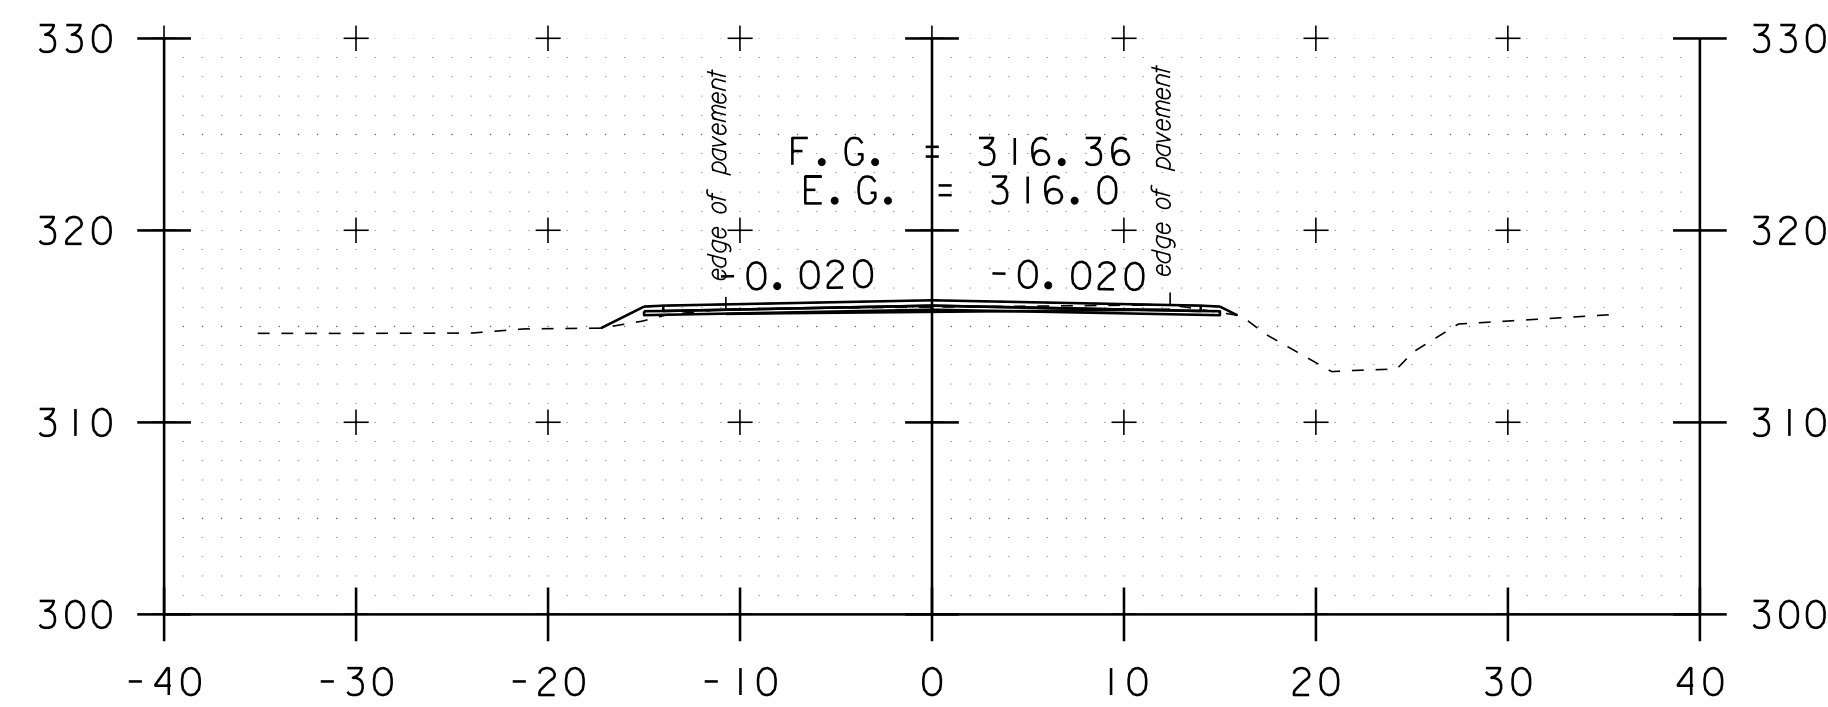


d 127+20

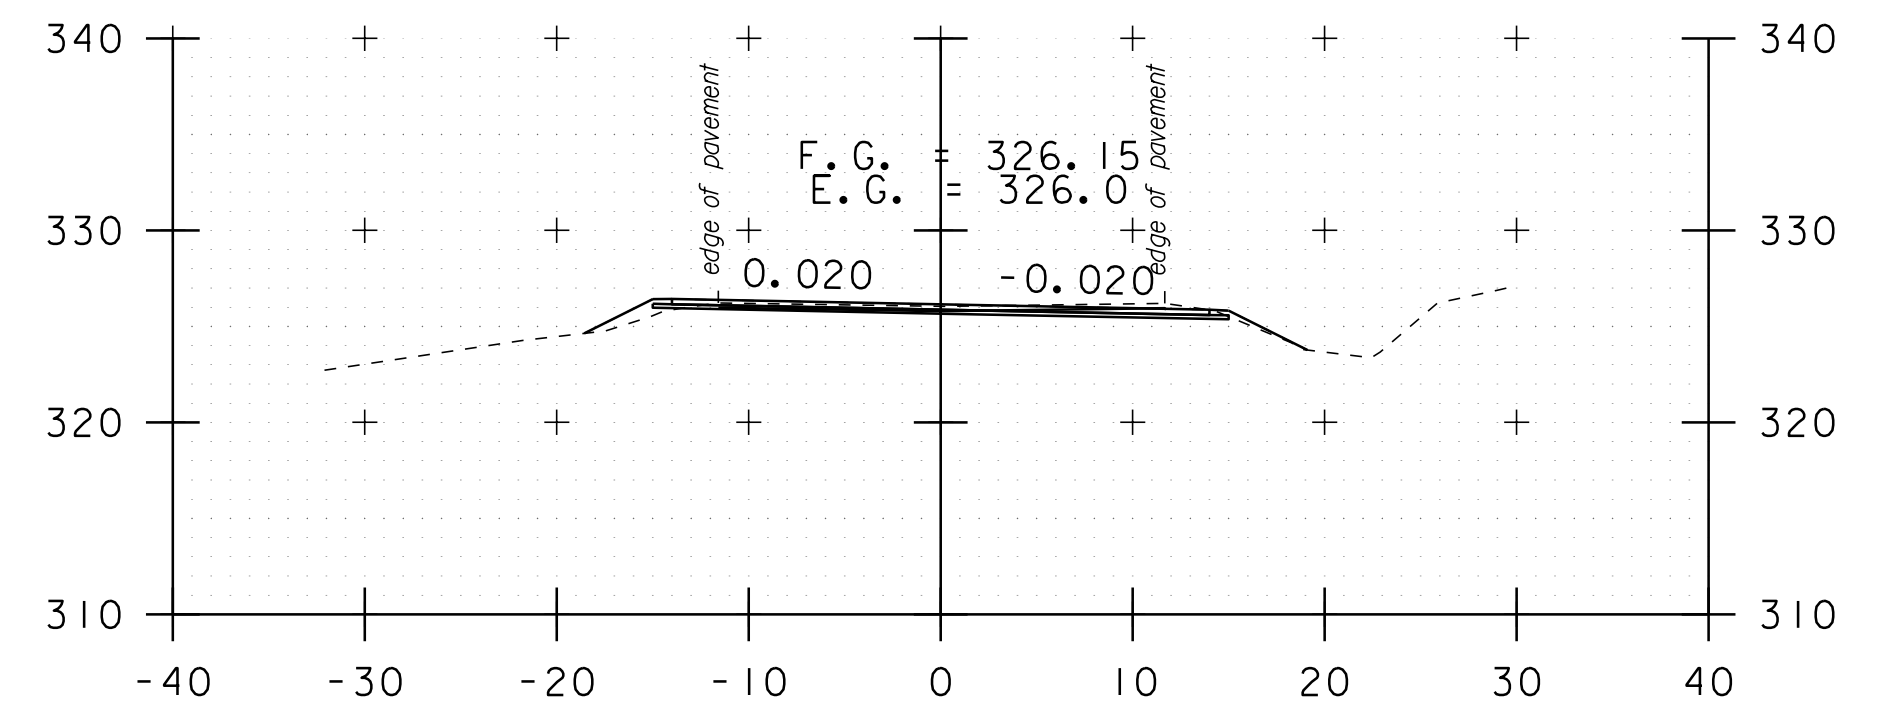


d 129+60

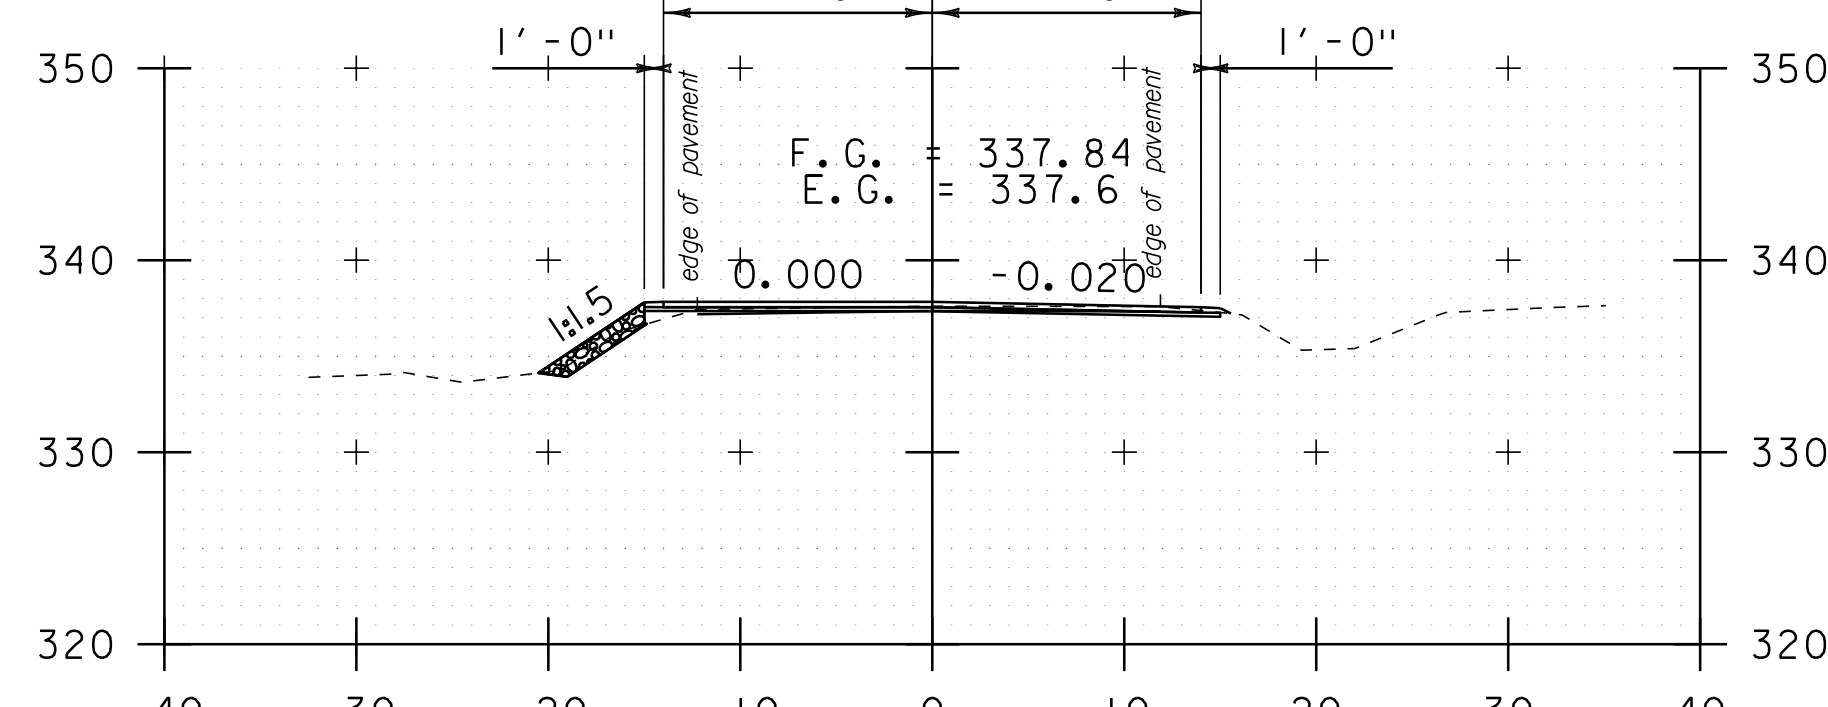

c 32+25

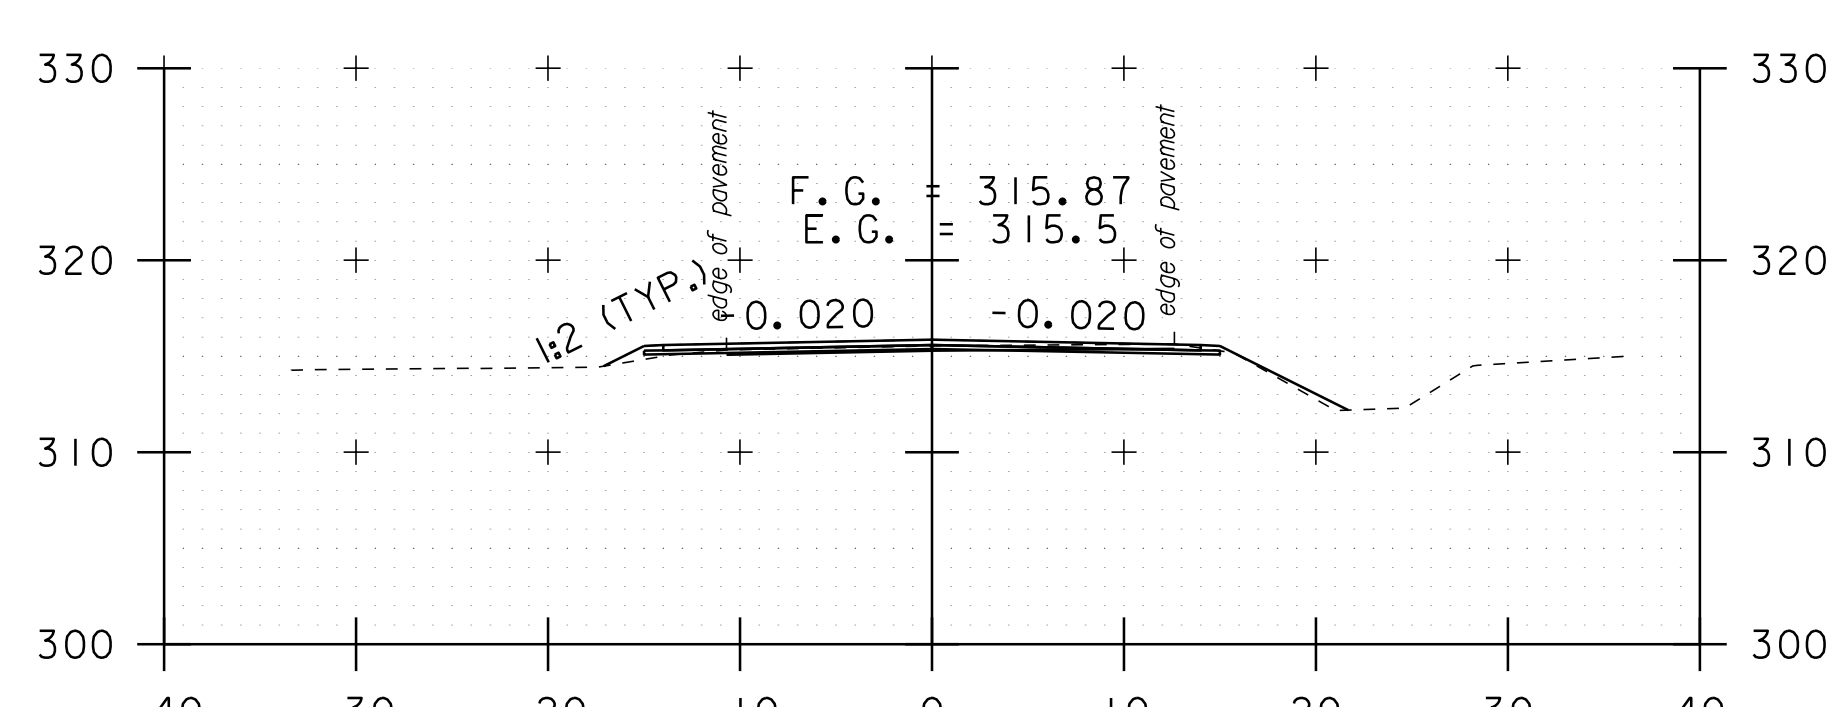


d 127+00

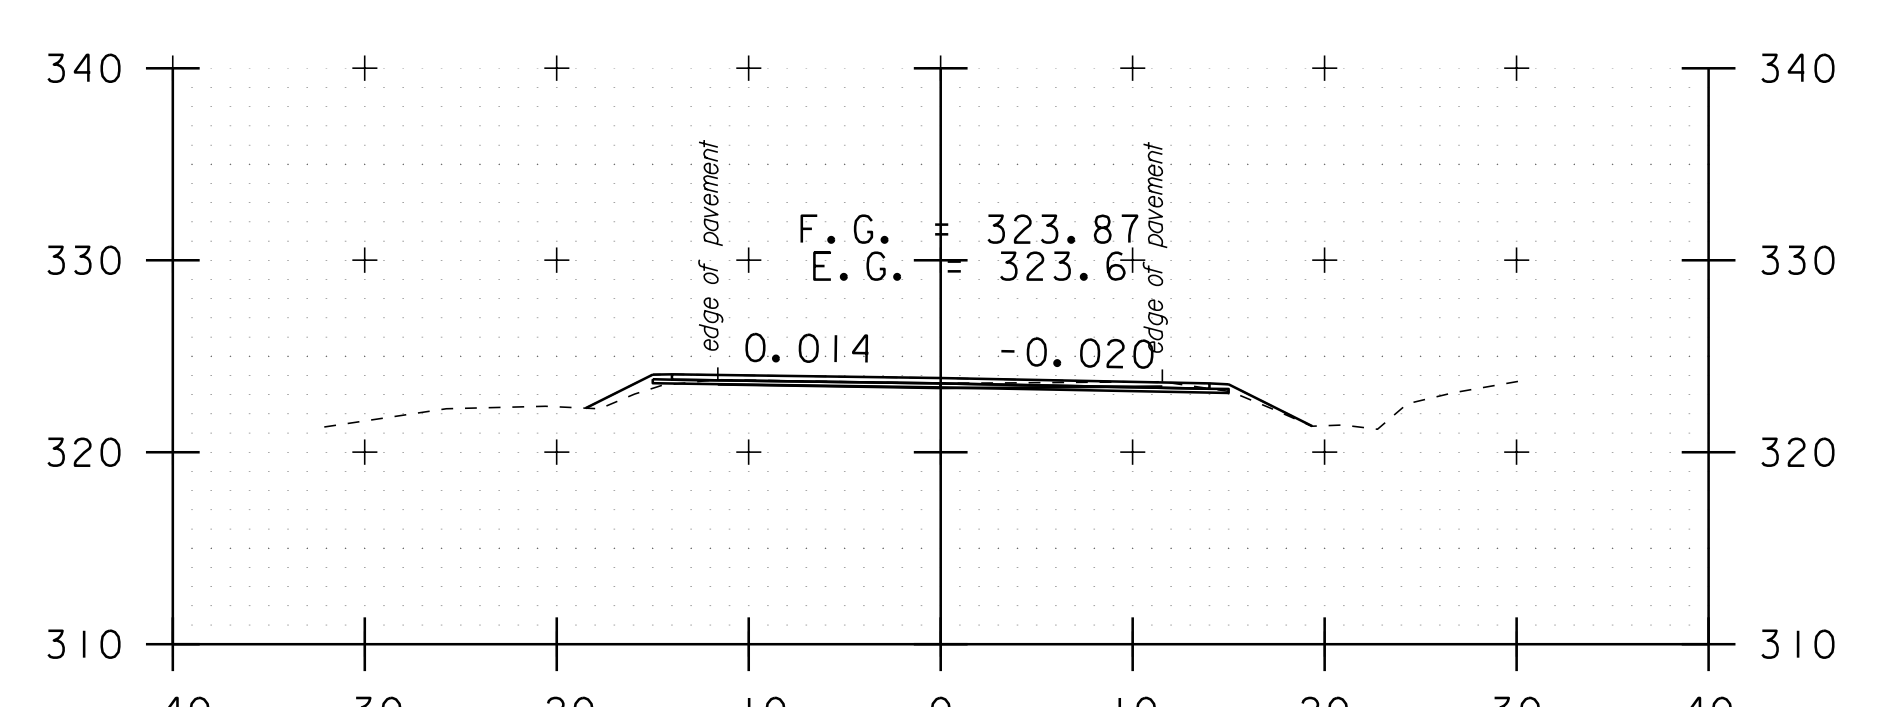

d 129+17

DATUM	NAVD 88
	NAD 83

STA. c 32+25 TO STA. d 130+00

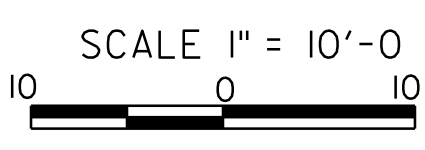

CROSS SECTION SHEET 48

PROJECT NAME:	ADDISON-NEW HAVEN
PROJECT NUMBER:	STP 9632(1)
FILE NAME:	p95B076.dgn
PROJECT LEADER:	CDL
DESIGNED BY:	SJL
PLOT FILE:	p95B076_153.1
PLOT DATE:	3/13/2012
DRAWN BY:	SJL
CHECKED BY:	EPD
SHEET	153 OF 186