




d 131+50

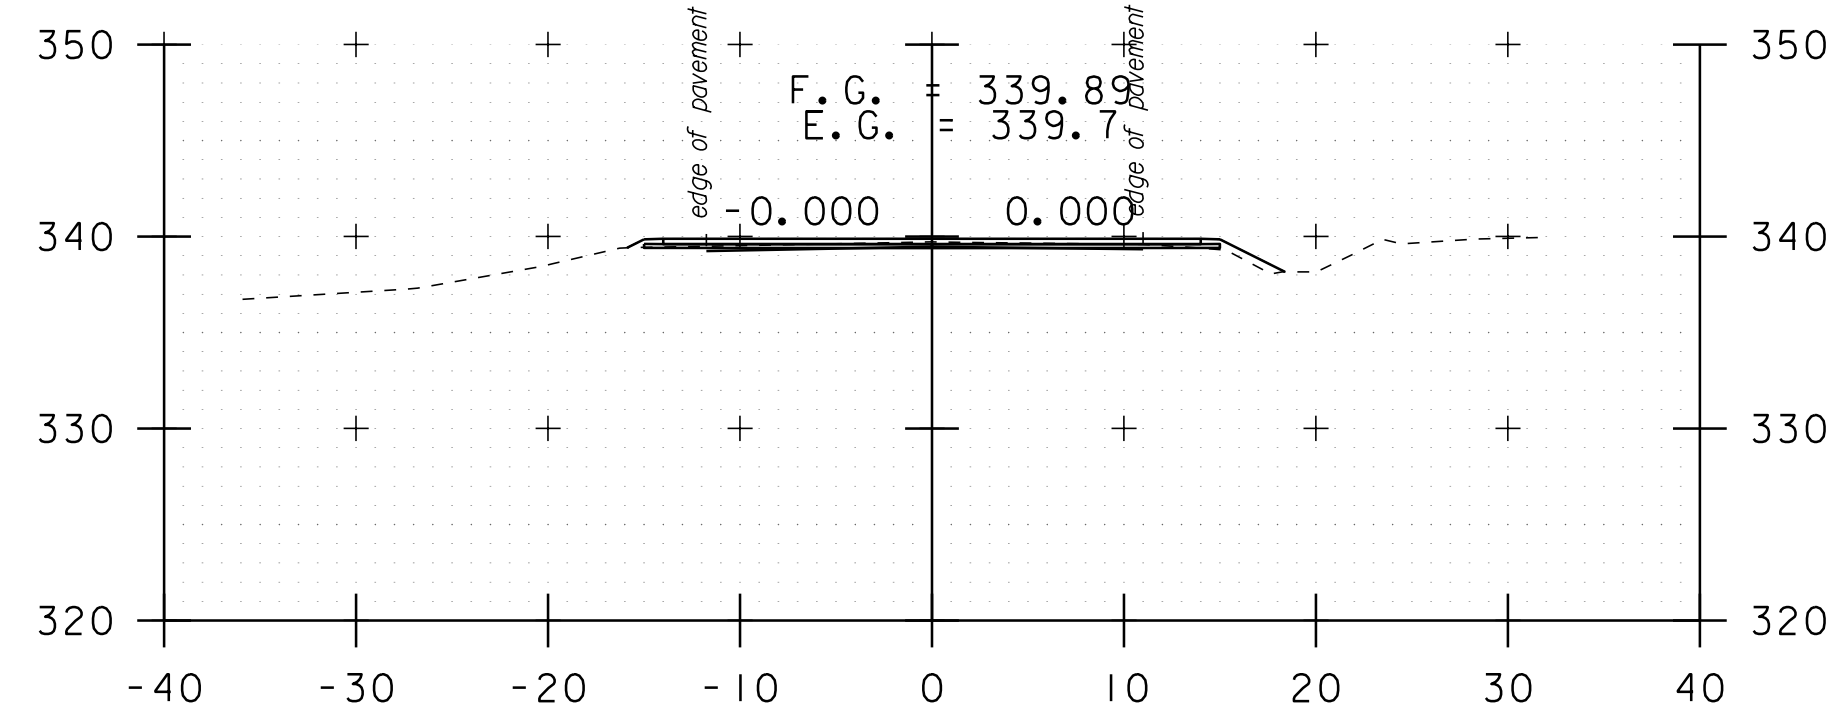


d 132+45

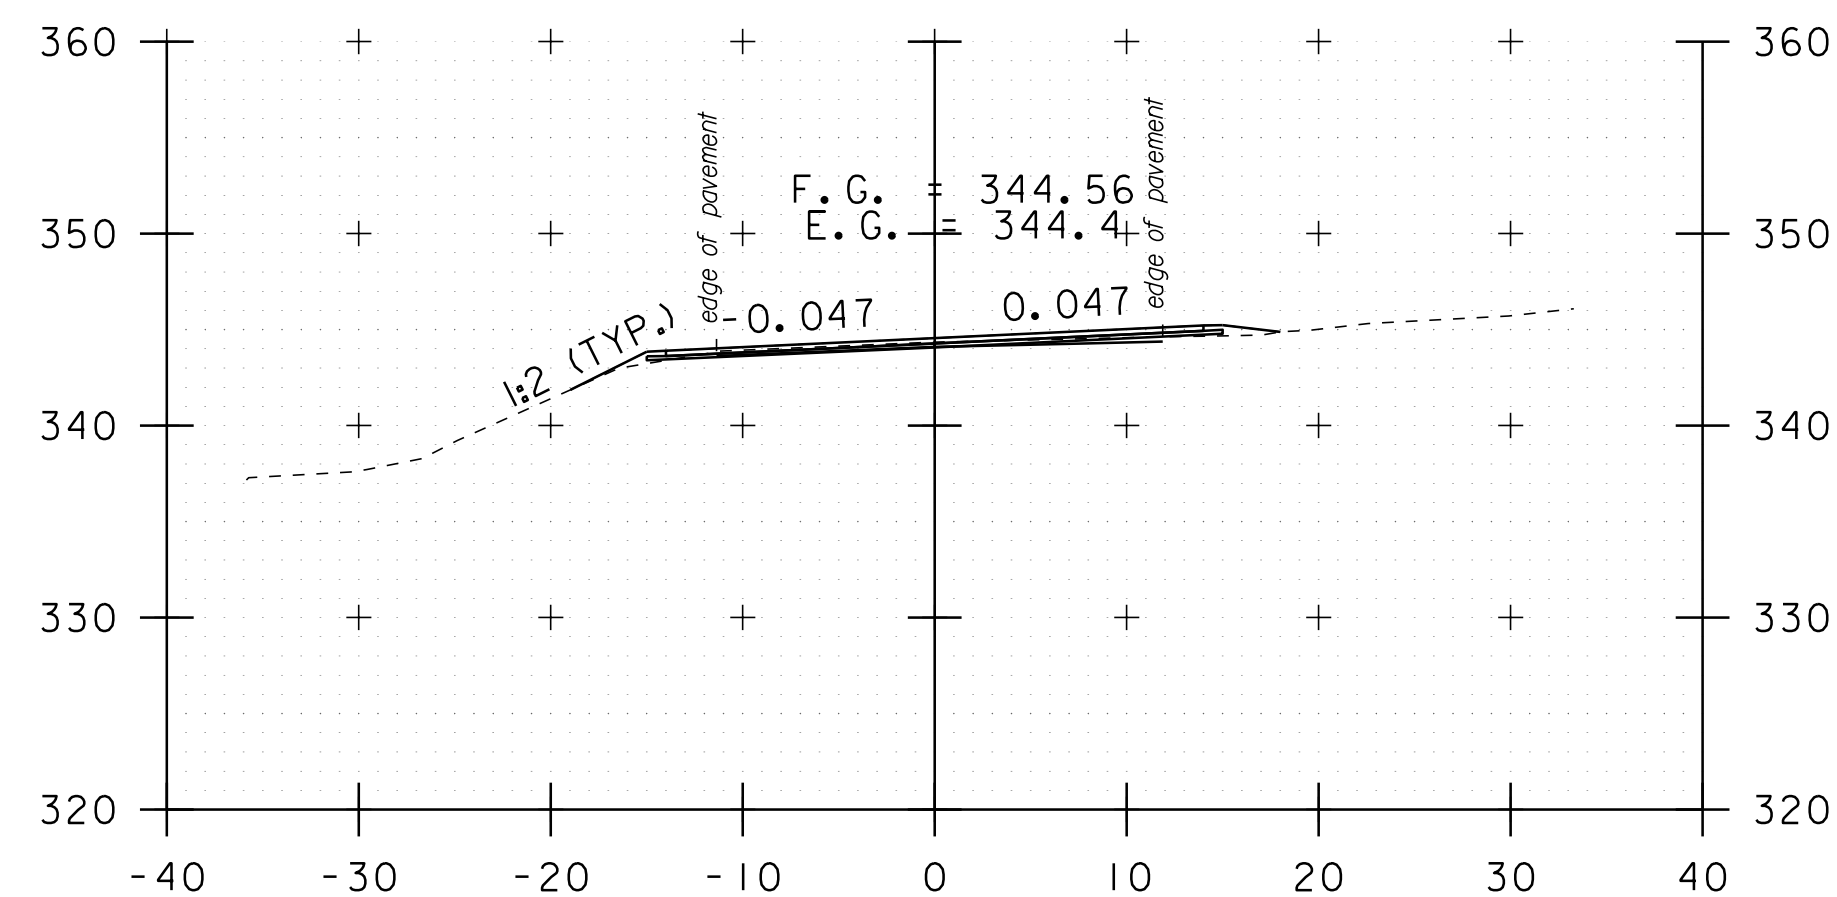


d 134+50
DRIVE RT

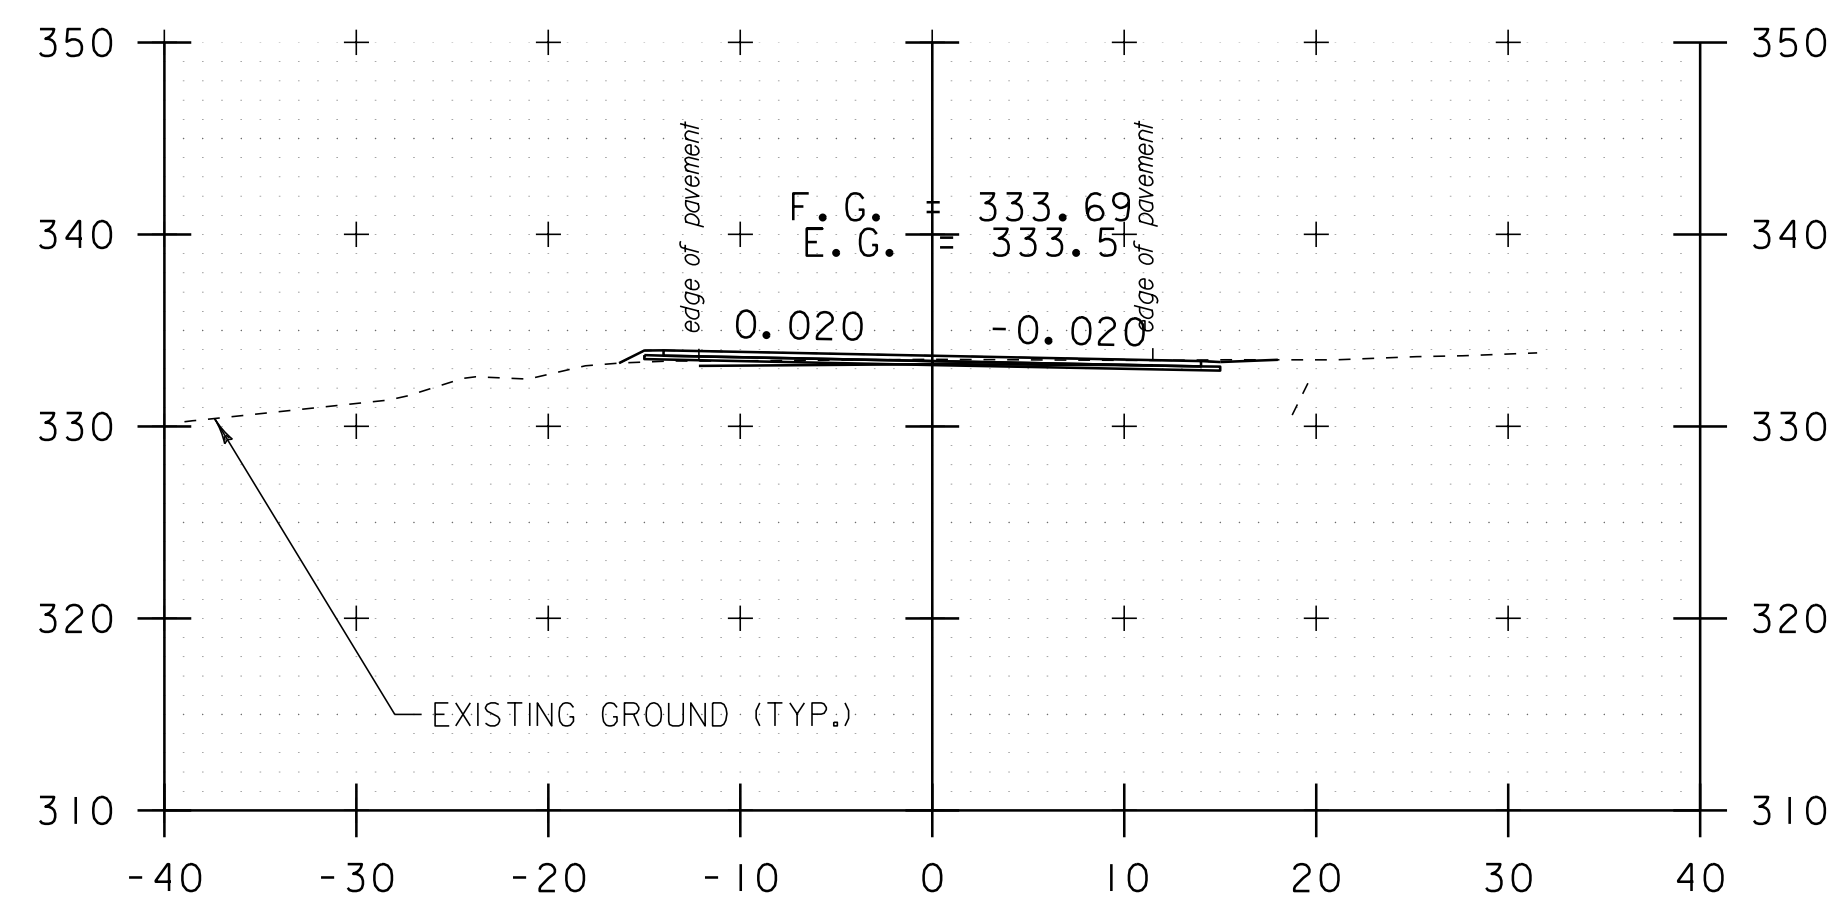


d 131+00
DRIVE RT

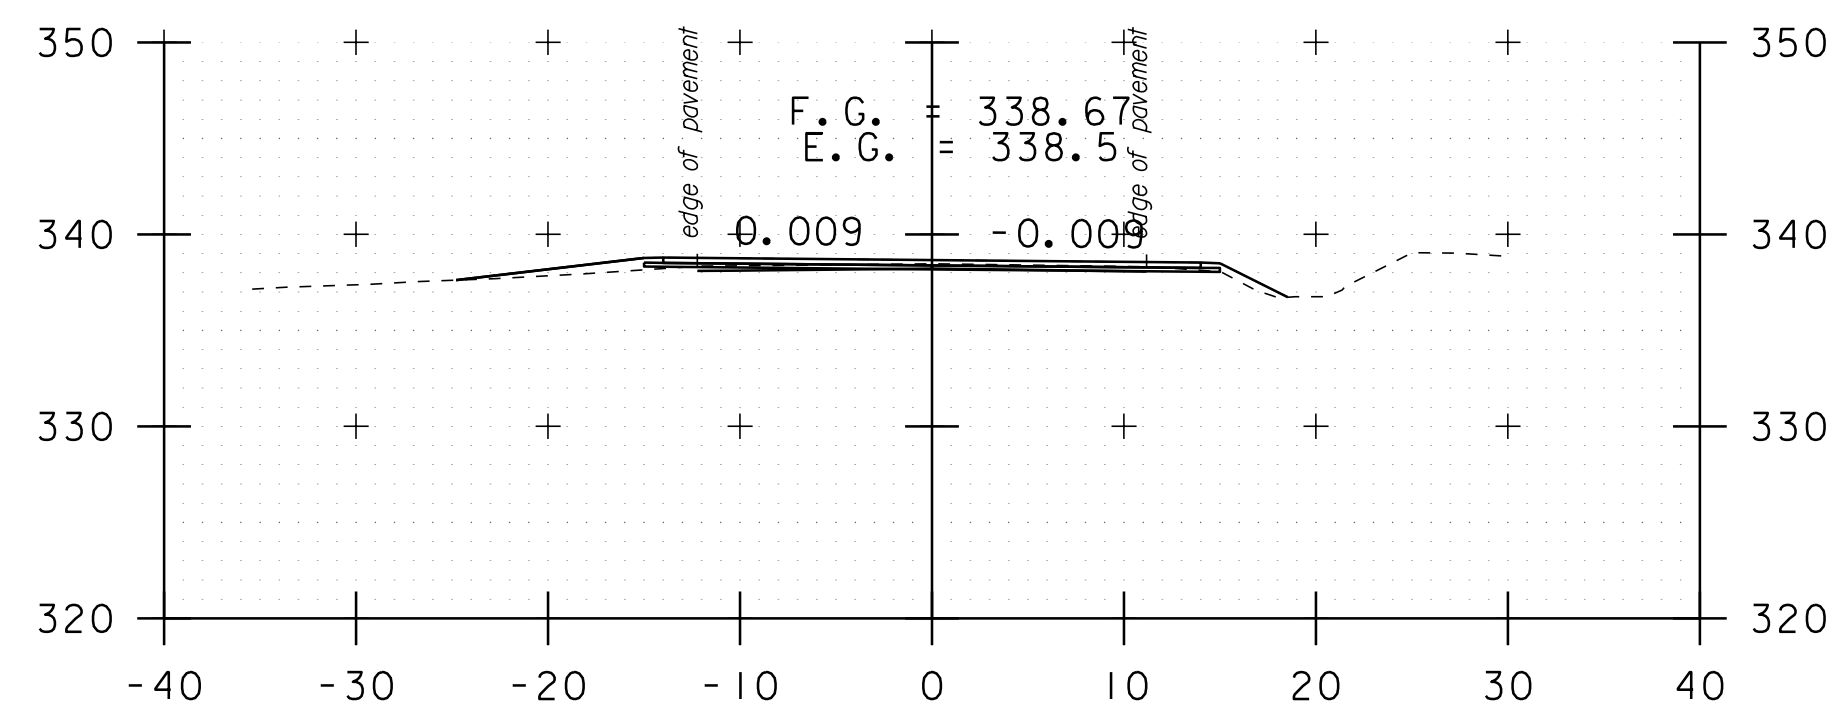


d 132+10
DRIVE LT

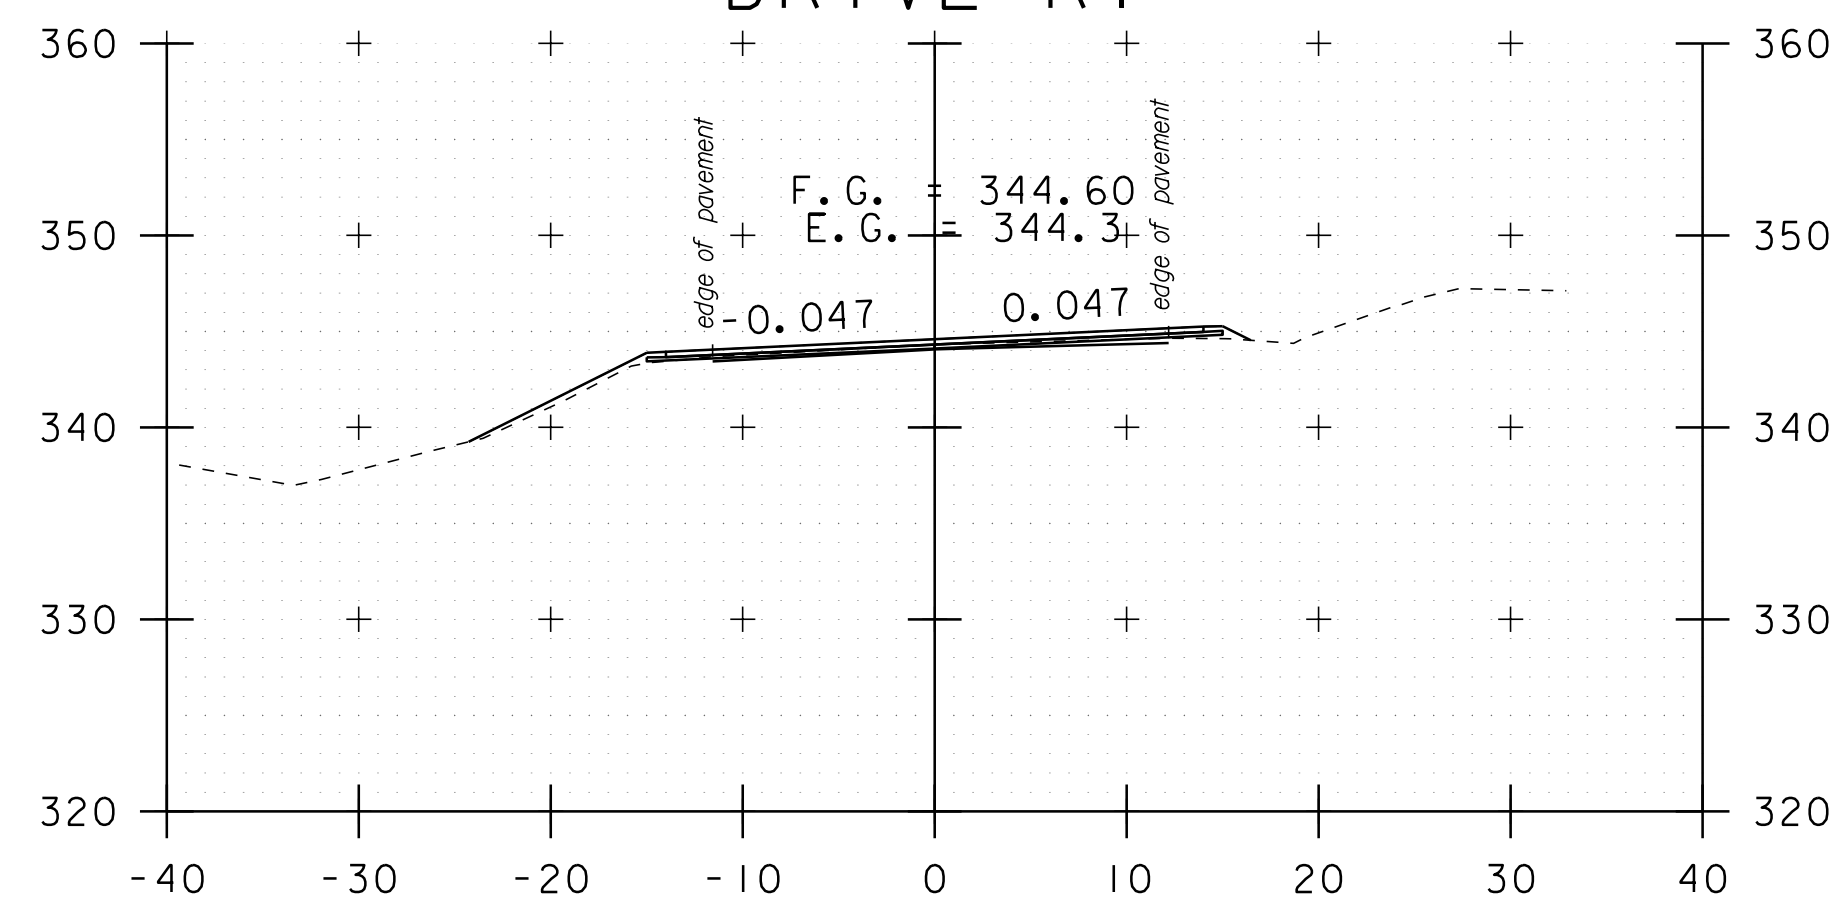


d 134+20

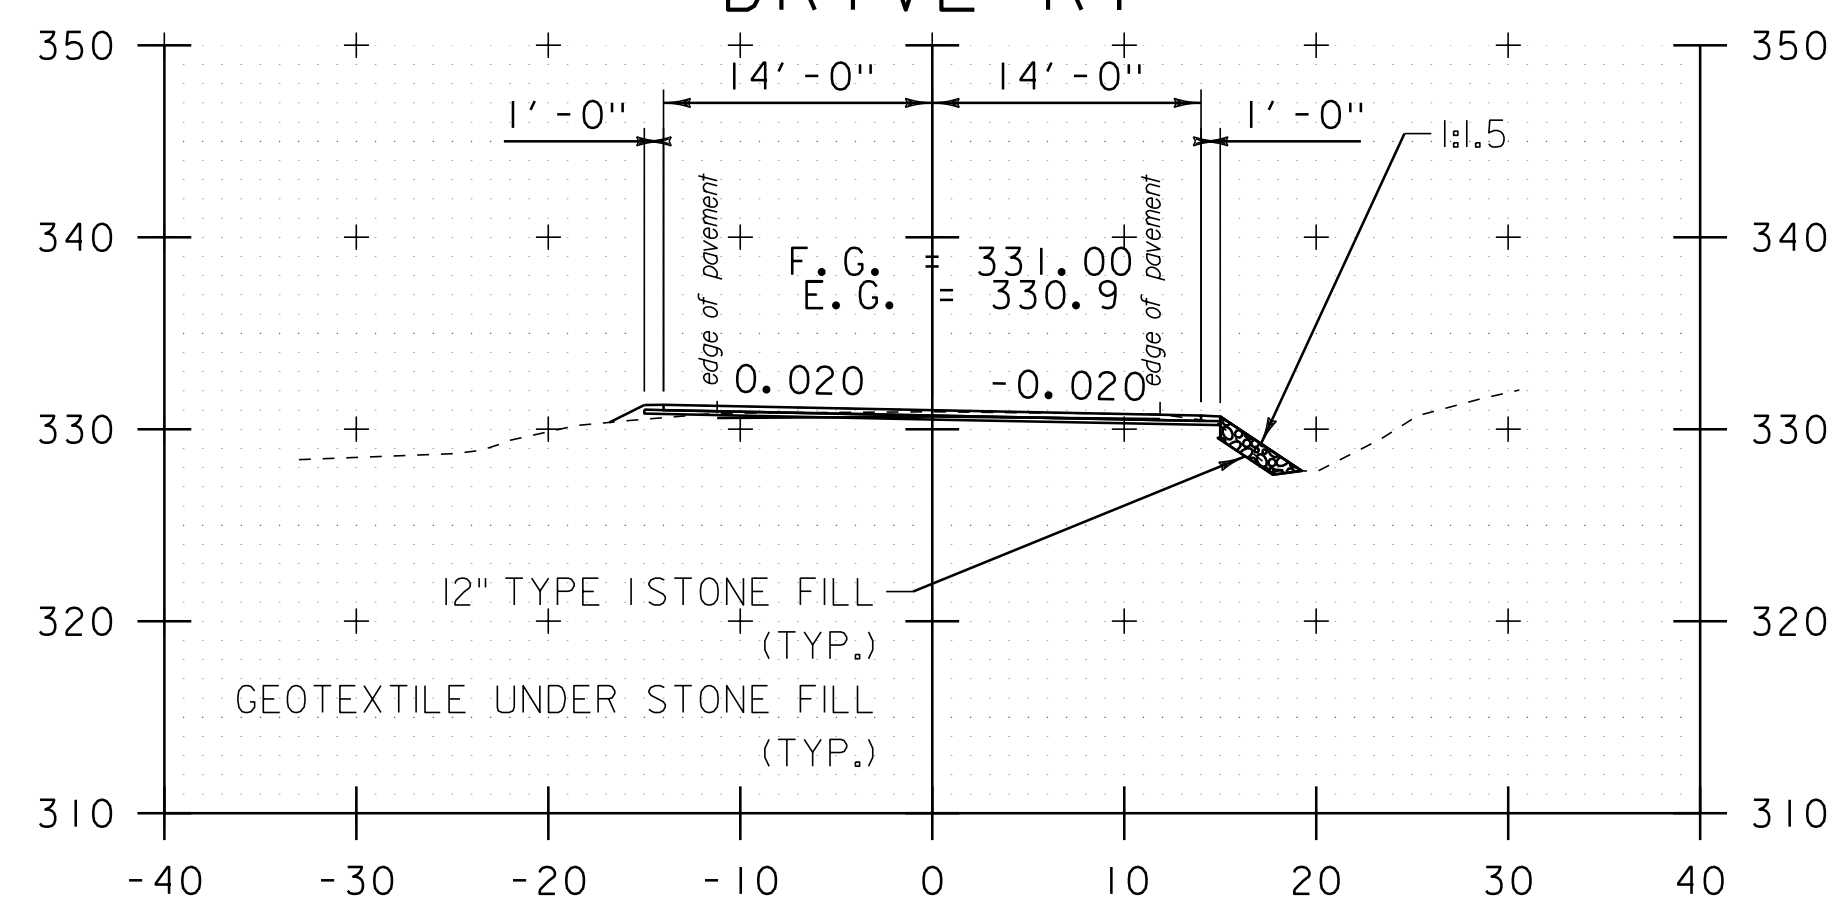

d 130+50

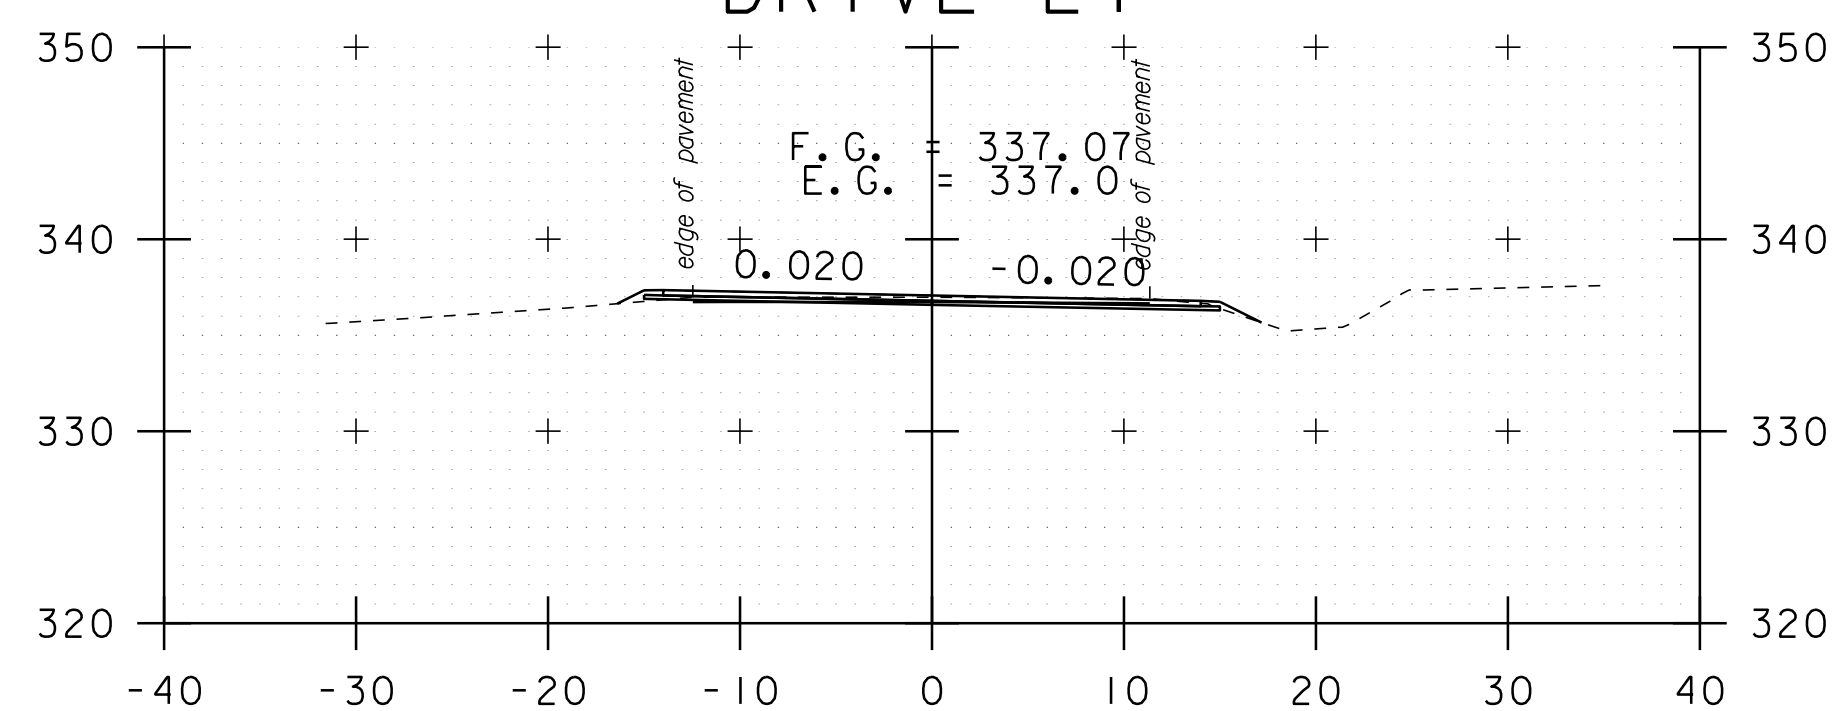


d 131+70

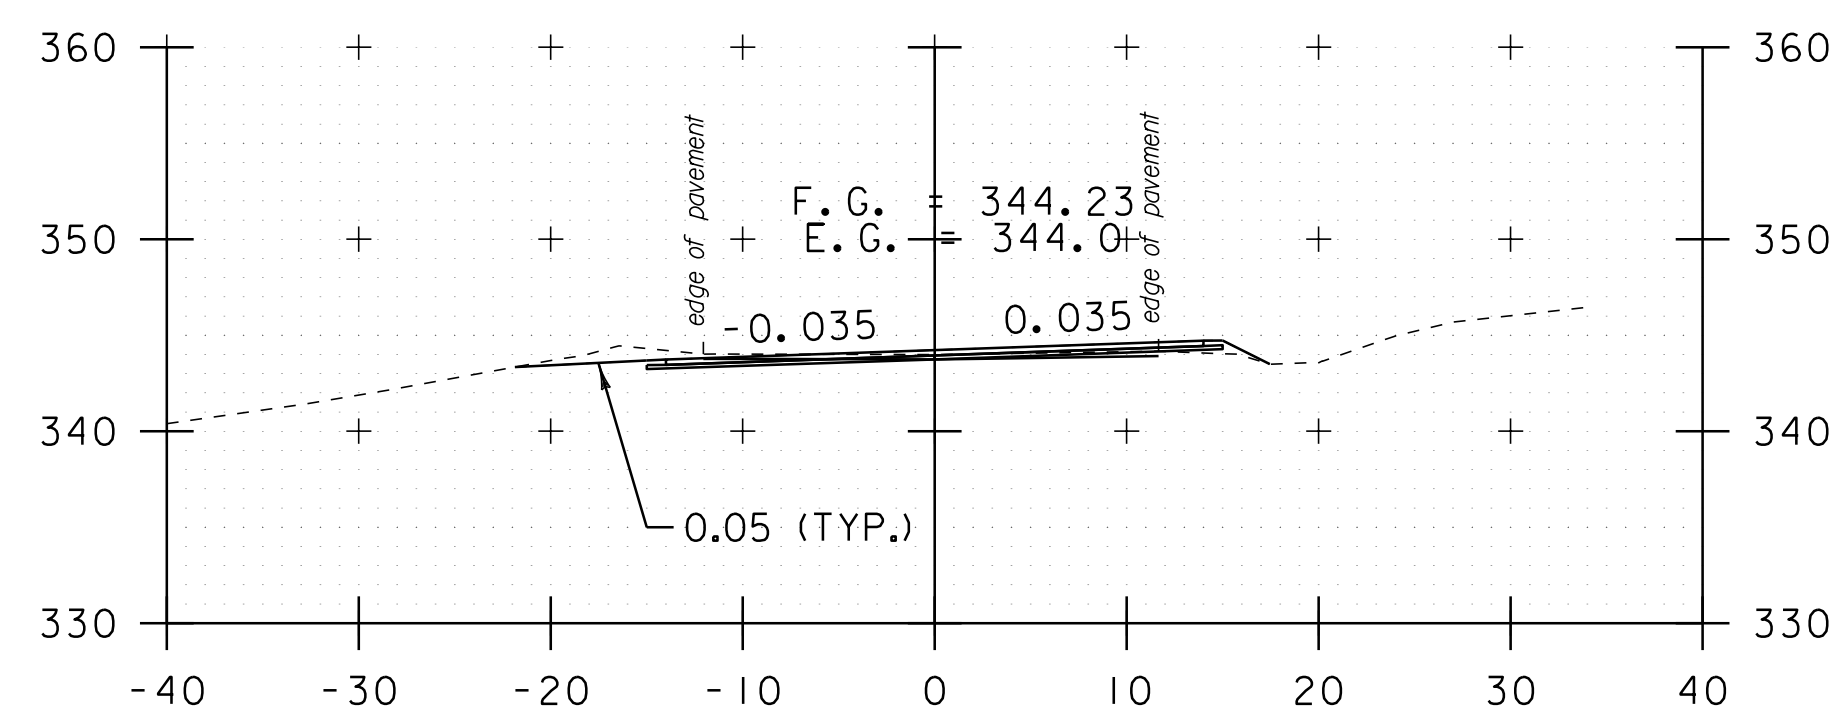

d 133+76

DATUM	NAVD 88
	NAD 83

STA. d 130+50 TO STA. d 134+50

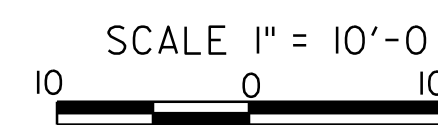

CROSS SECTION SHEET 49

PROJECT NAME: ADDISON-NEW HAVEN
PROJECT NUMBER: STP 9632(1)

FILE NAME: p95B076.dgn
PROJECT LEADER: CDL
DESIGNED BY: SJL
PLOT FILE: p95B076_I54.1

PLOT DATE: 3/13/2012
DRAWN BY: SJL
CHECKED BY: EPD
SHEET 154 OF 186