




d 135+69

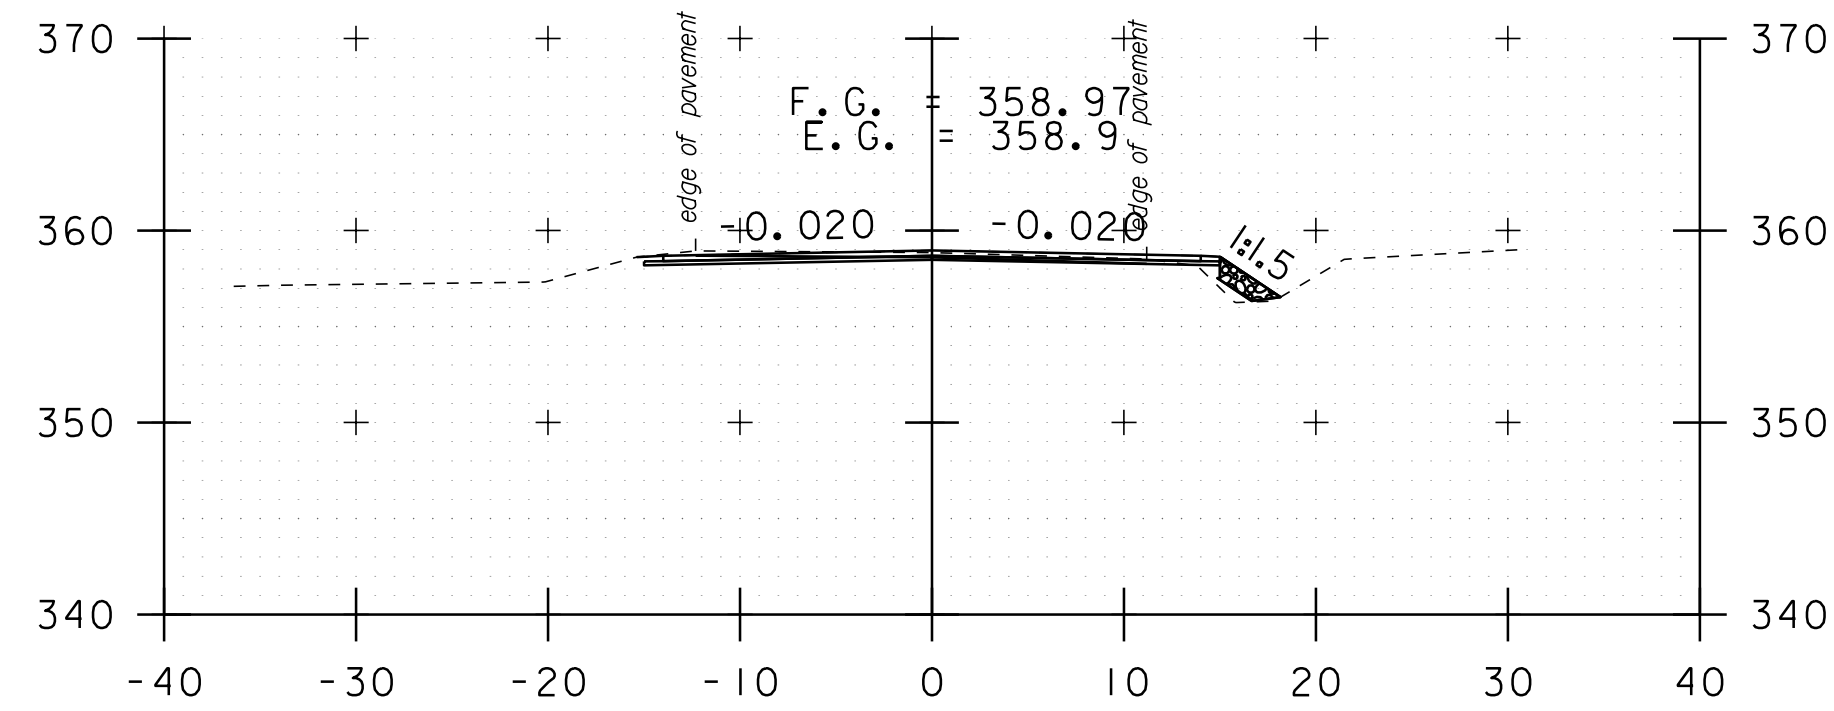


d 137+70

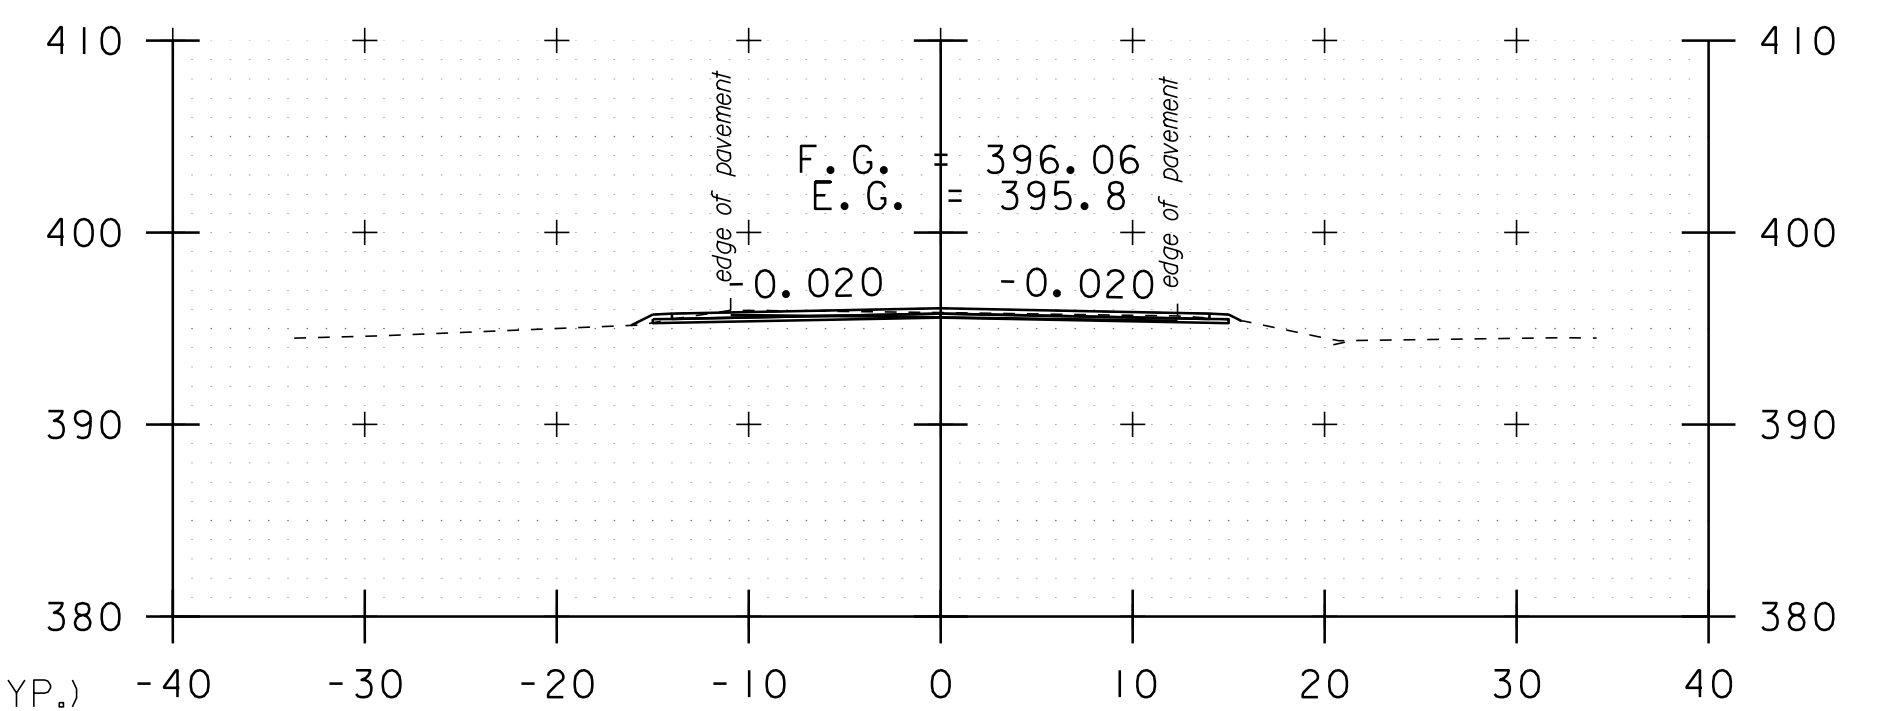


d 158+30

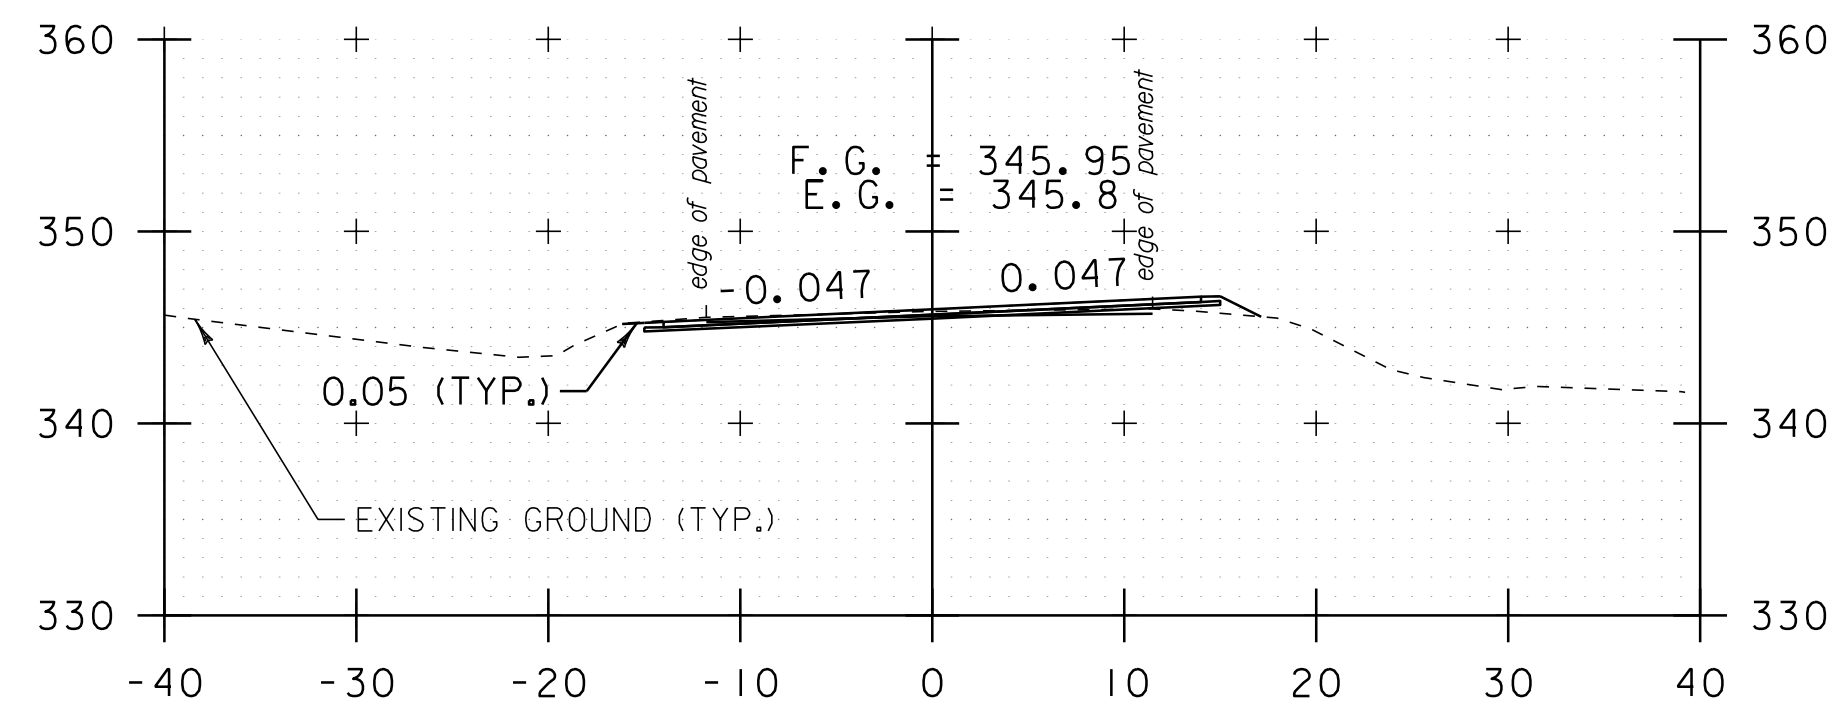


d 135+30

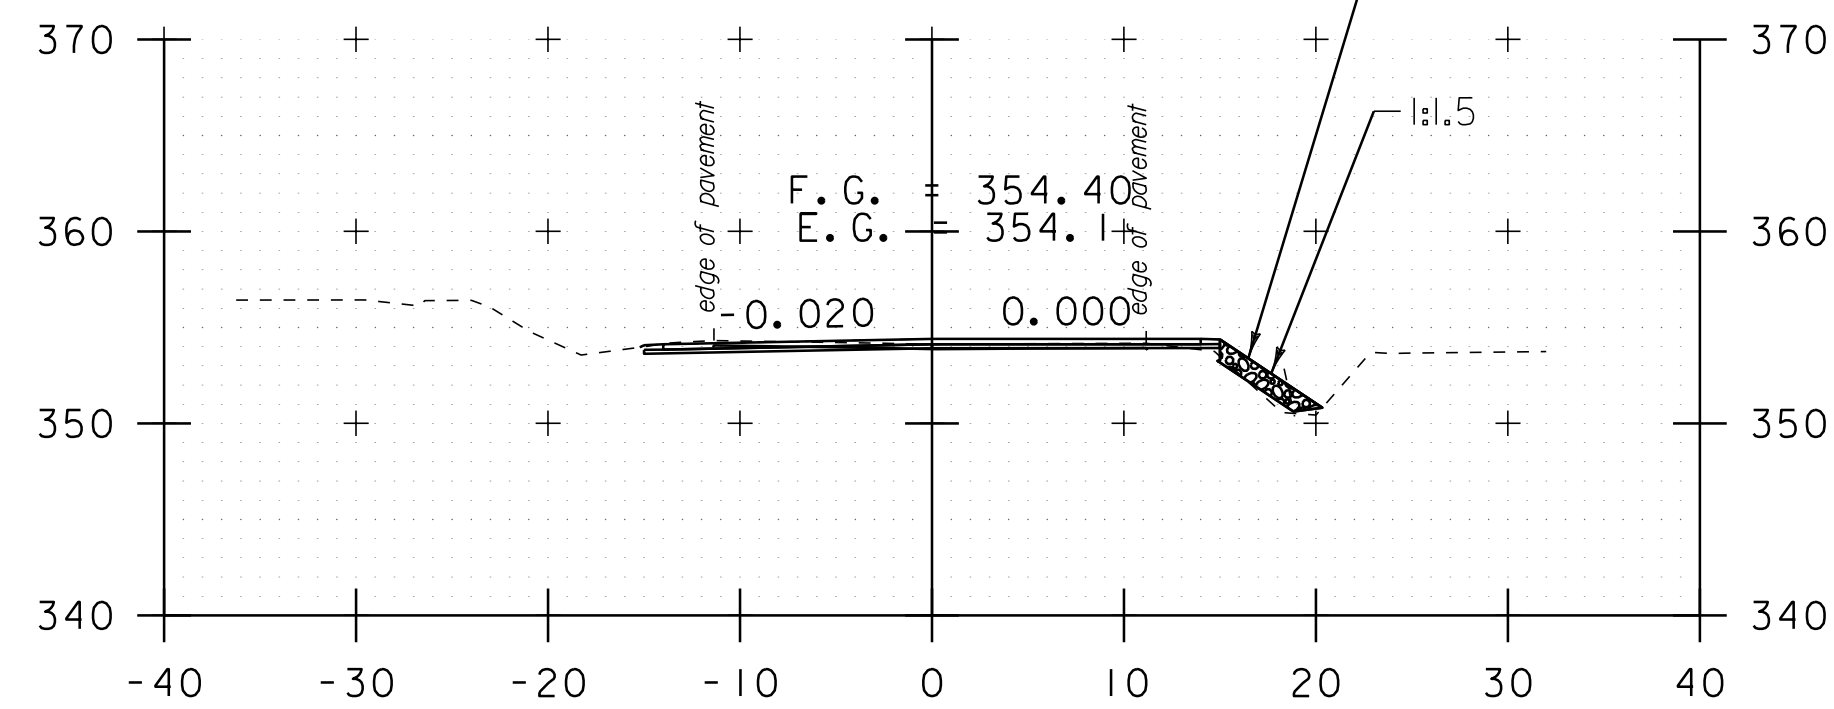


d 136+70

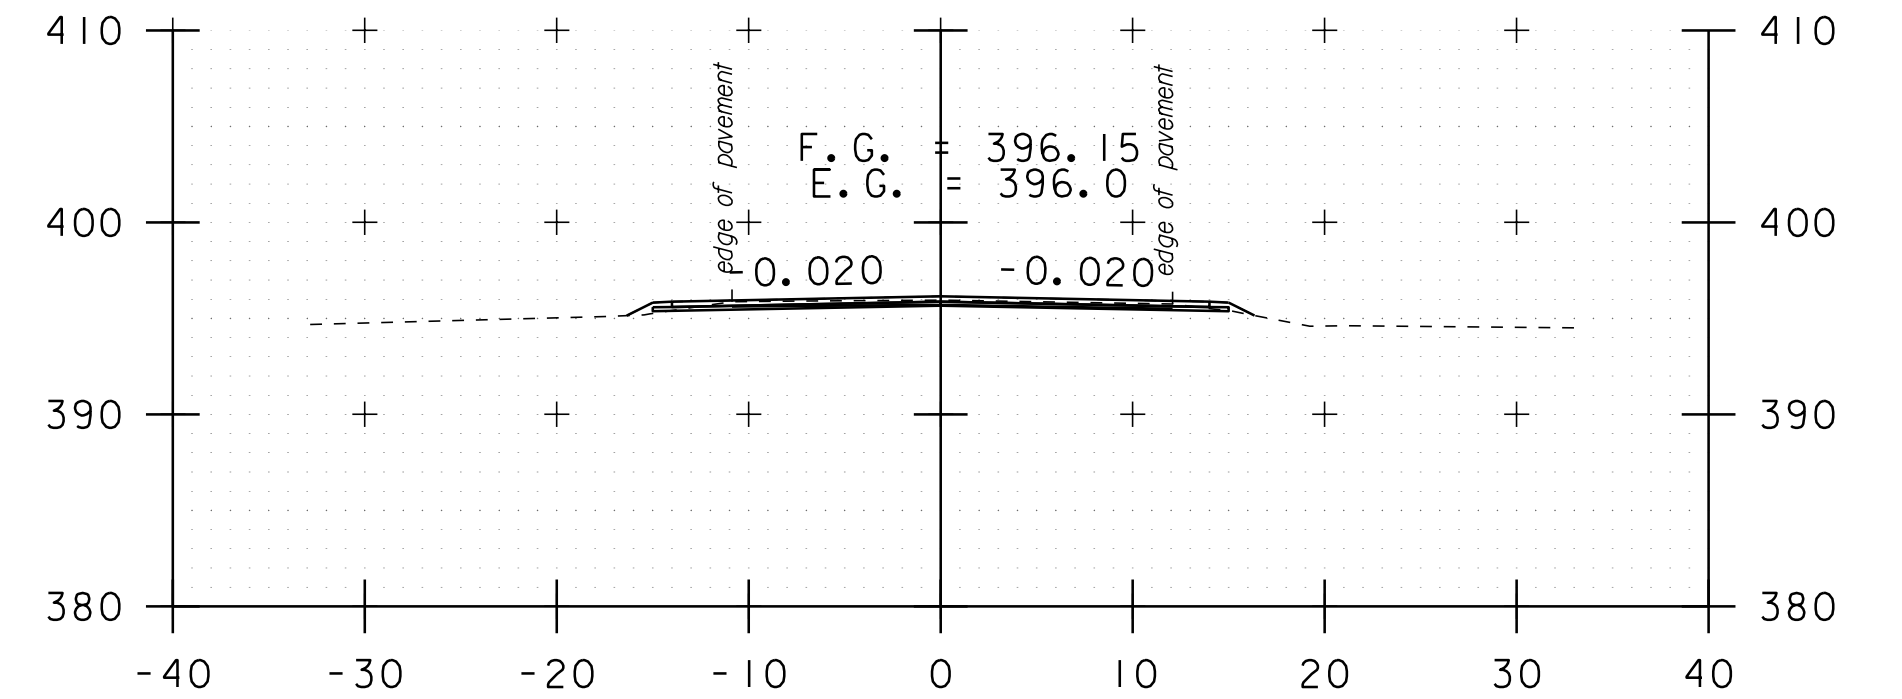


d 158+00

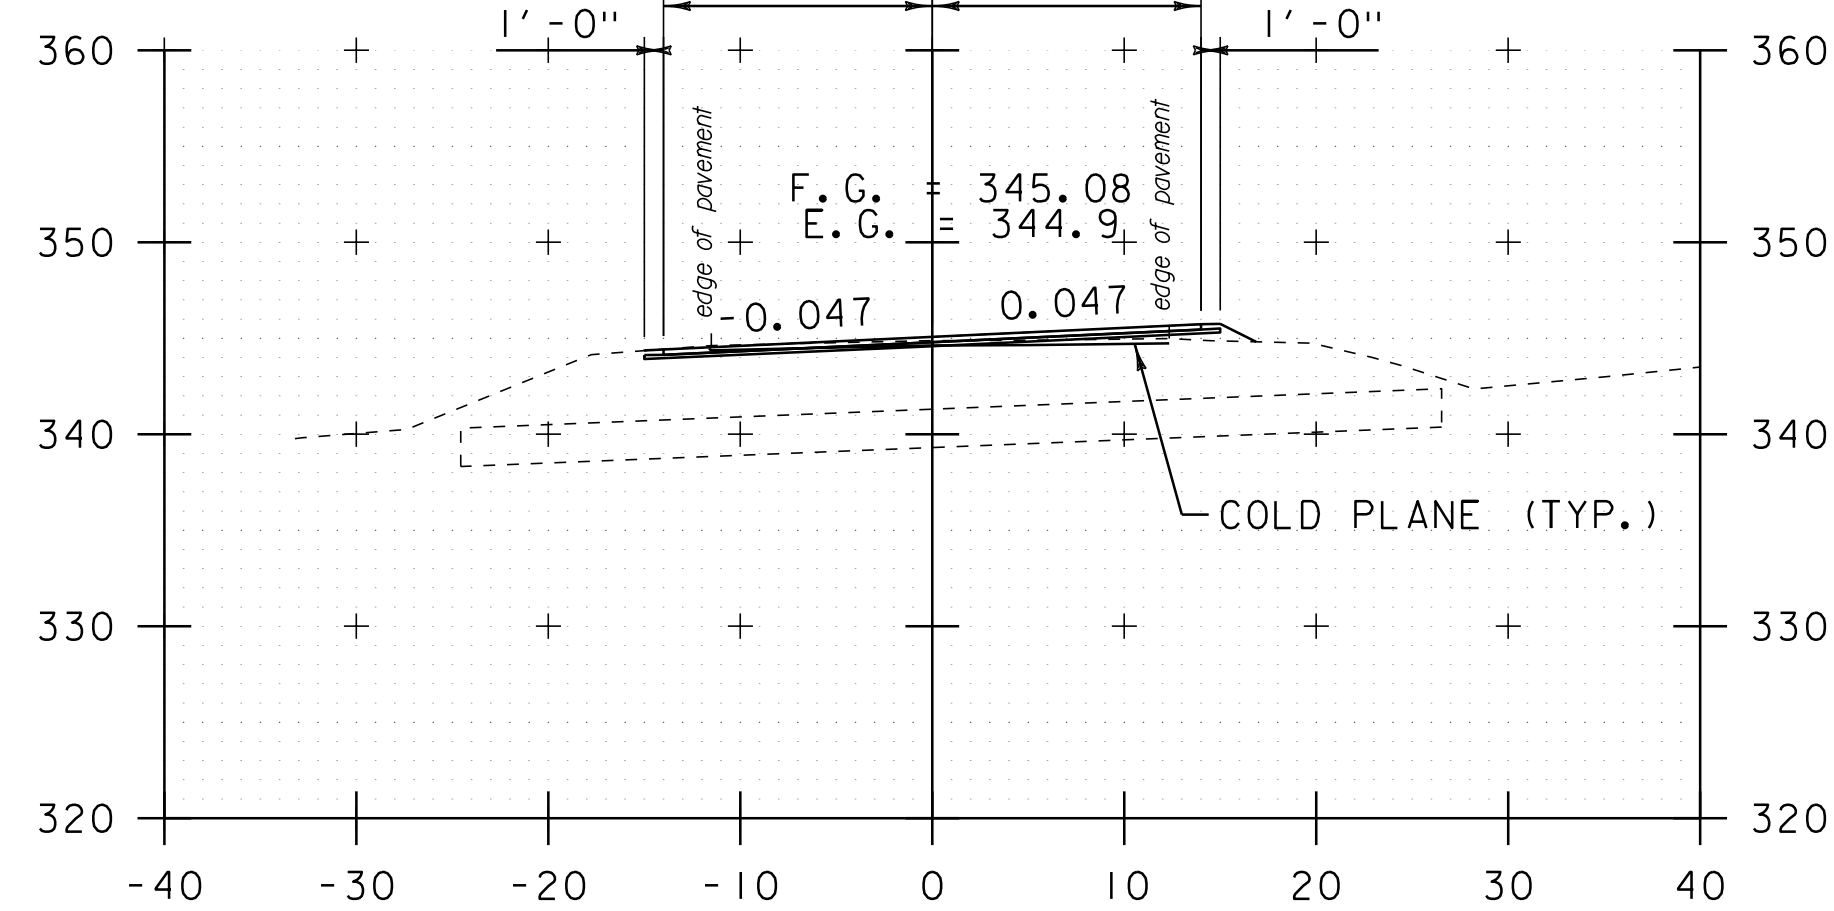

d 135+00

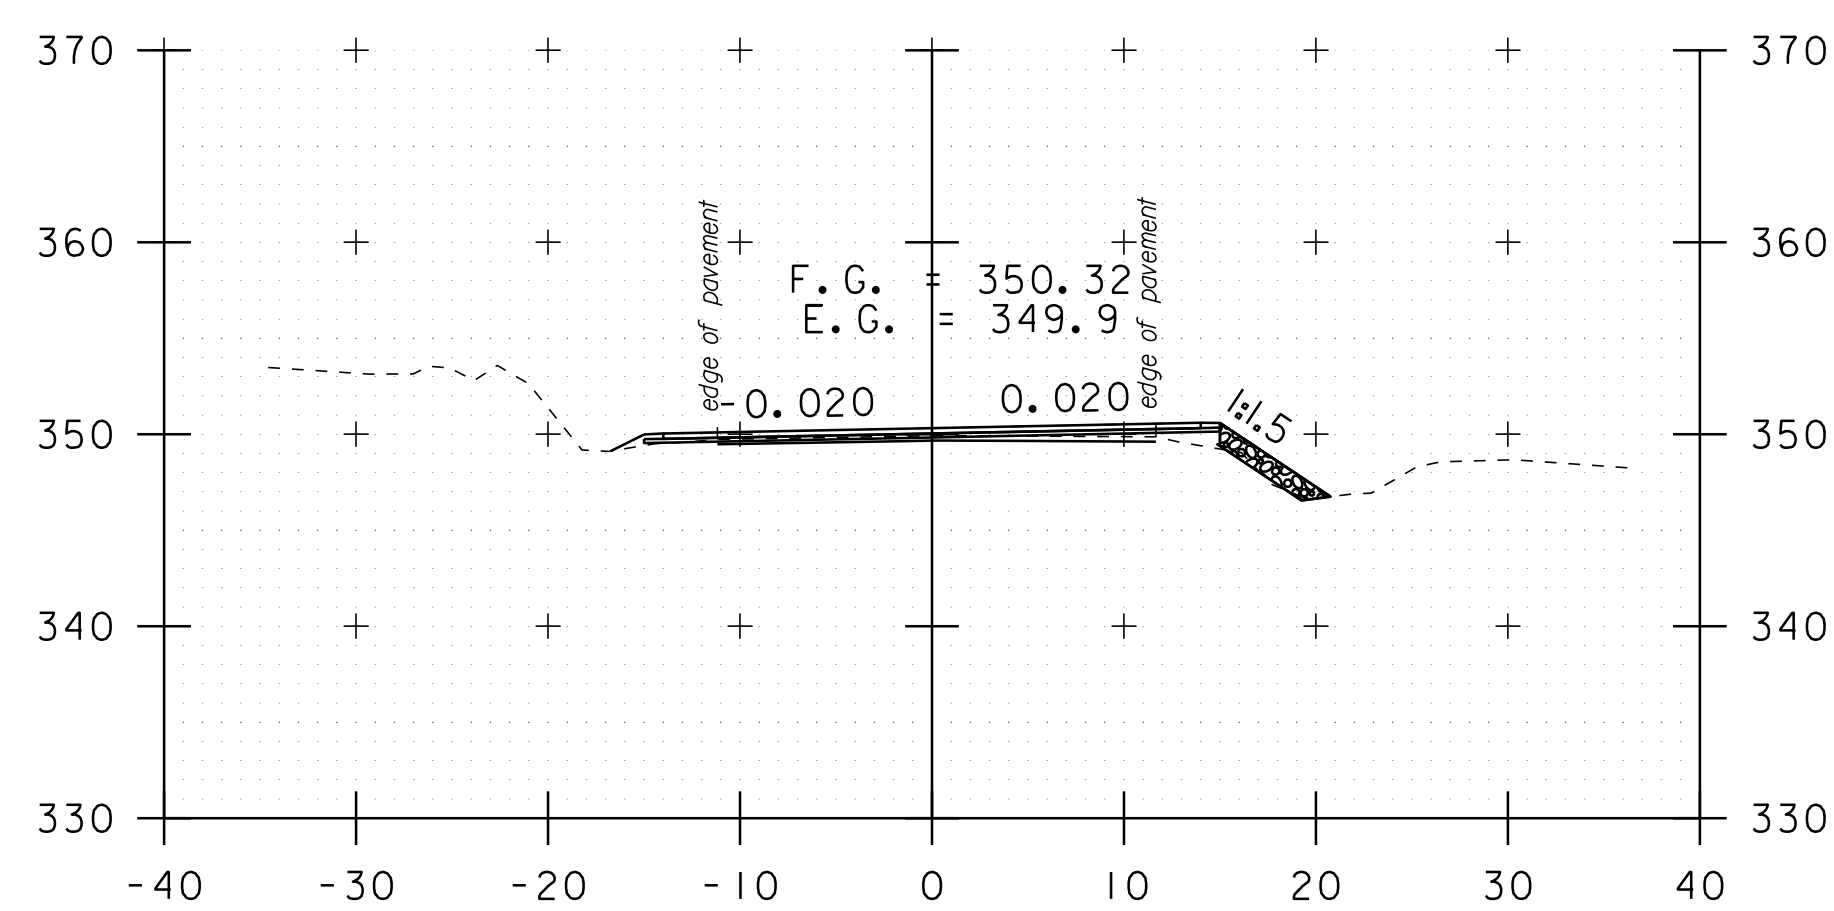


d 136+10

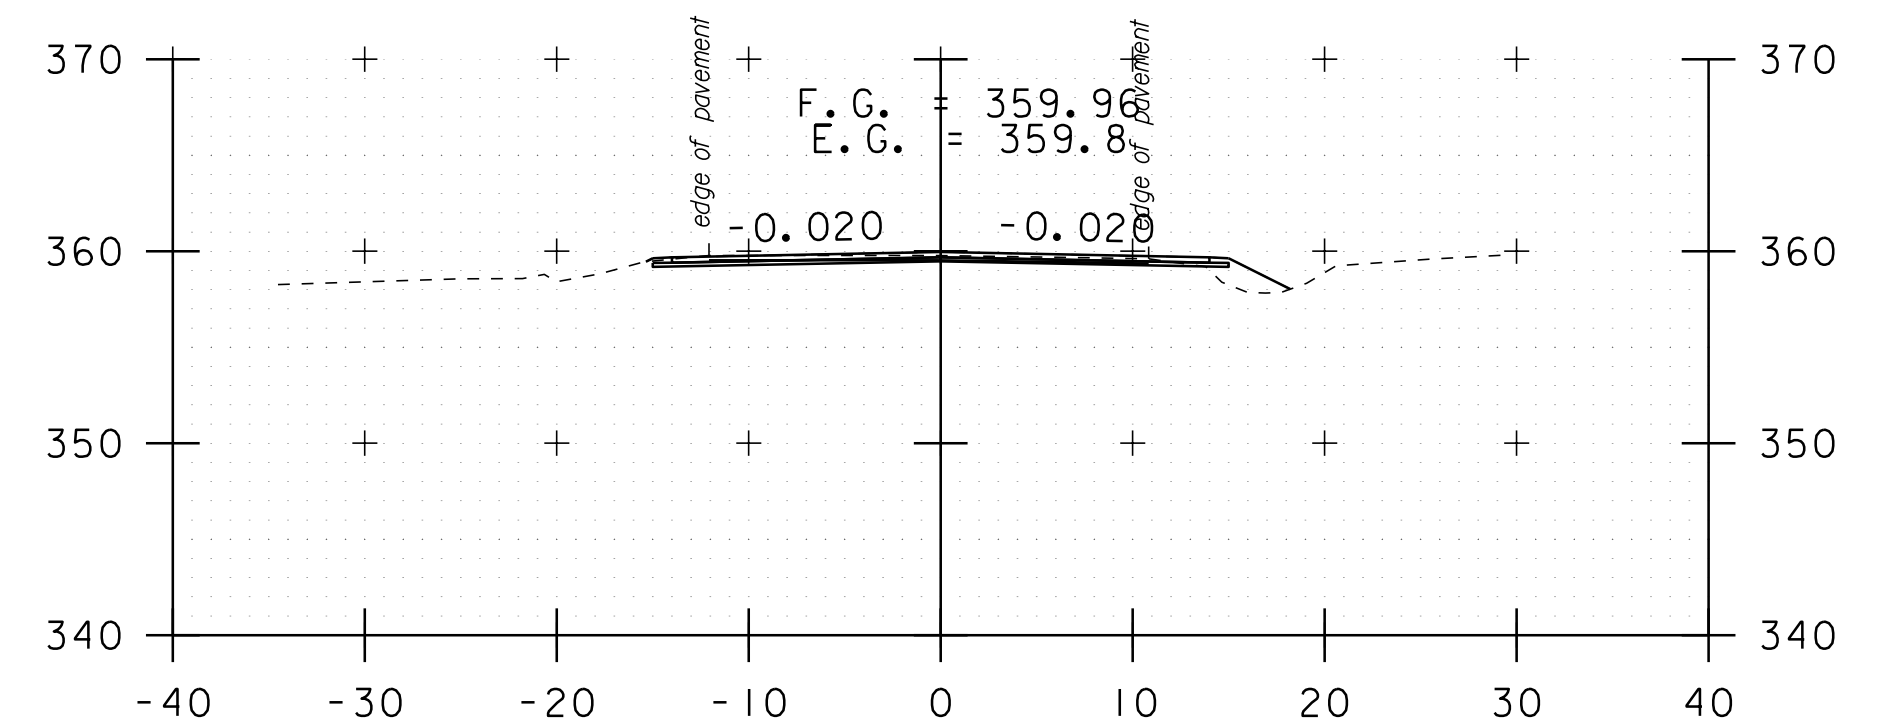

d 138+00

DATUM	NAVD 88
	NAD 83

STA. d 135+00 TO STA. d 158+30

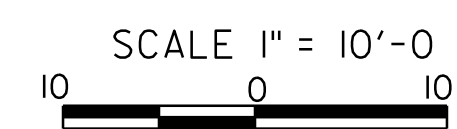

CROSS SECTION SHEET 50

PROJECT NAME:	ADDISON-NEW HAVEN	PLOT DATE:	3/13/2012
PROJECT NUMBER:	STP 9632(1)	DRAWN BY:	SJL
FILE NAME:	p95B076.dgn	CHECKED BY:	EPD
PROJECT LEADER:	CDL	SHEET	155 OF 186
DESIGNED BY:	SJL		
PLOT FILE:	p95B076_155.1		