




d 160+56

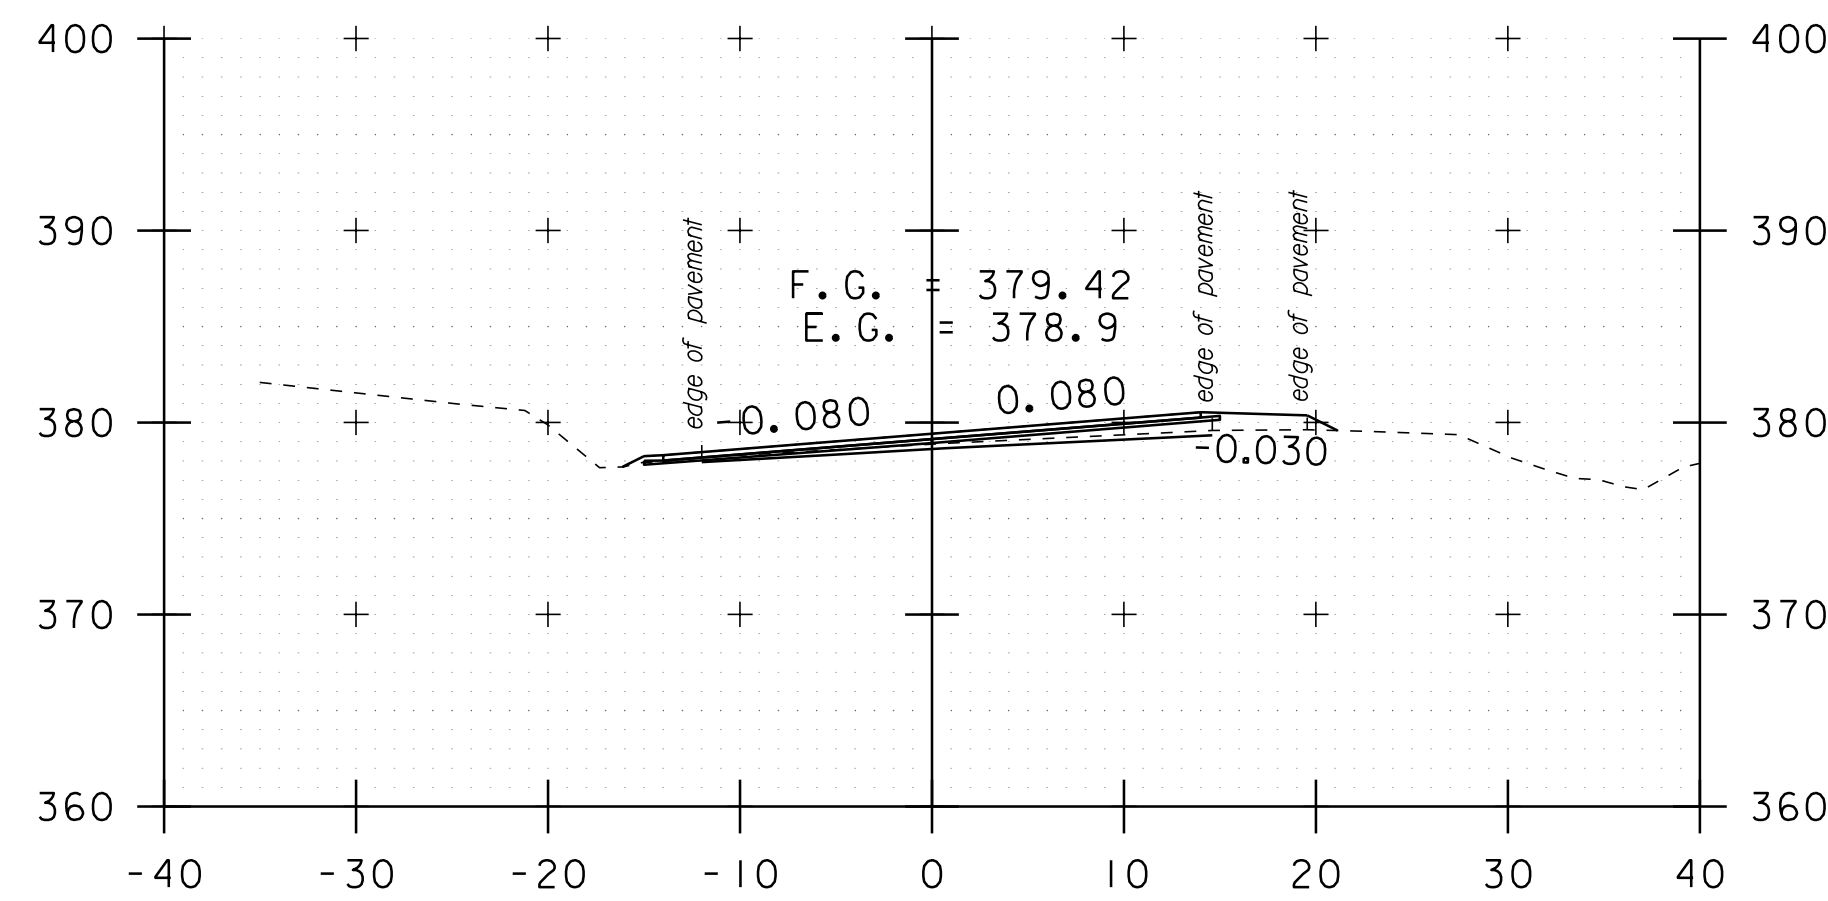


d 162+00
TH#21 RT

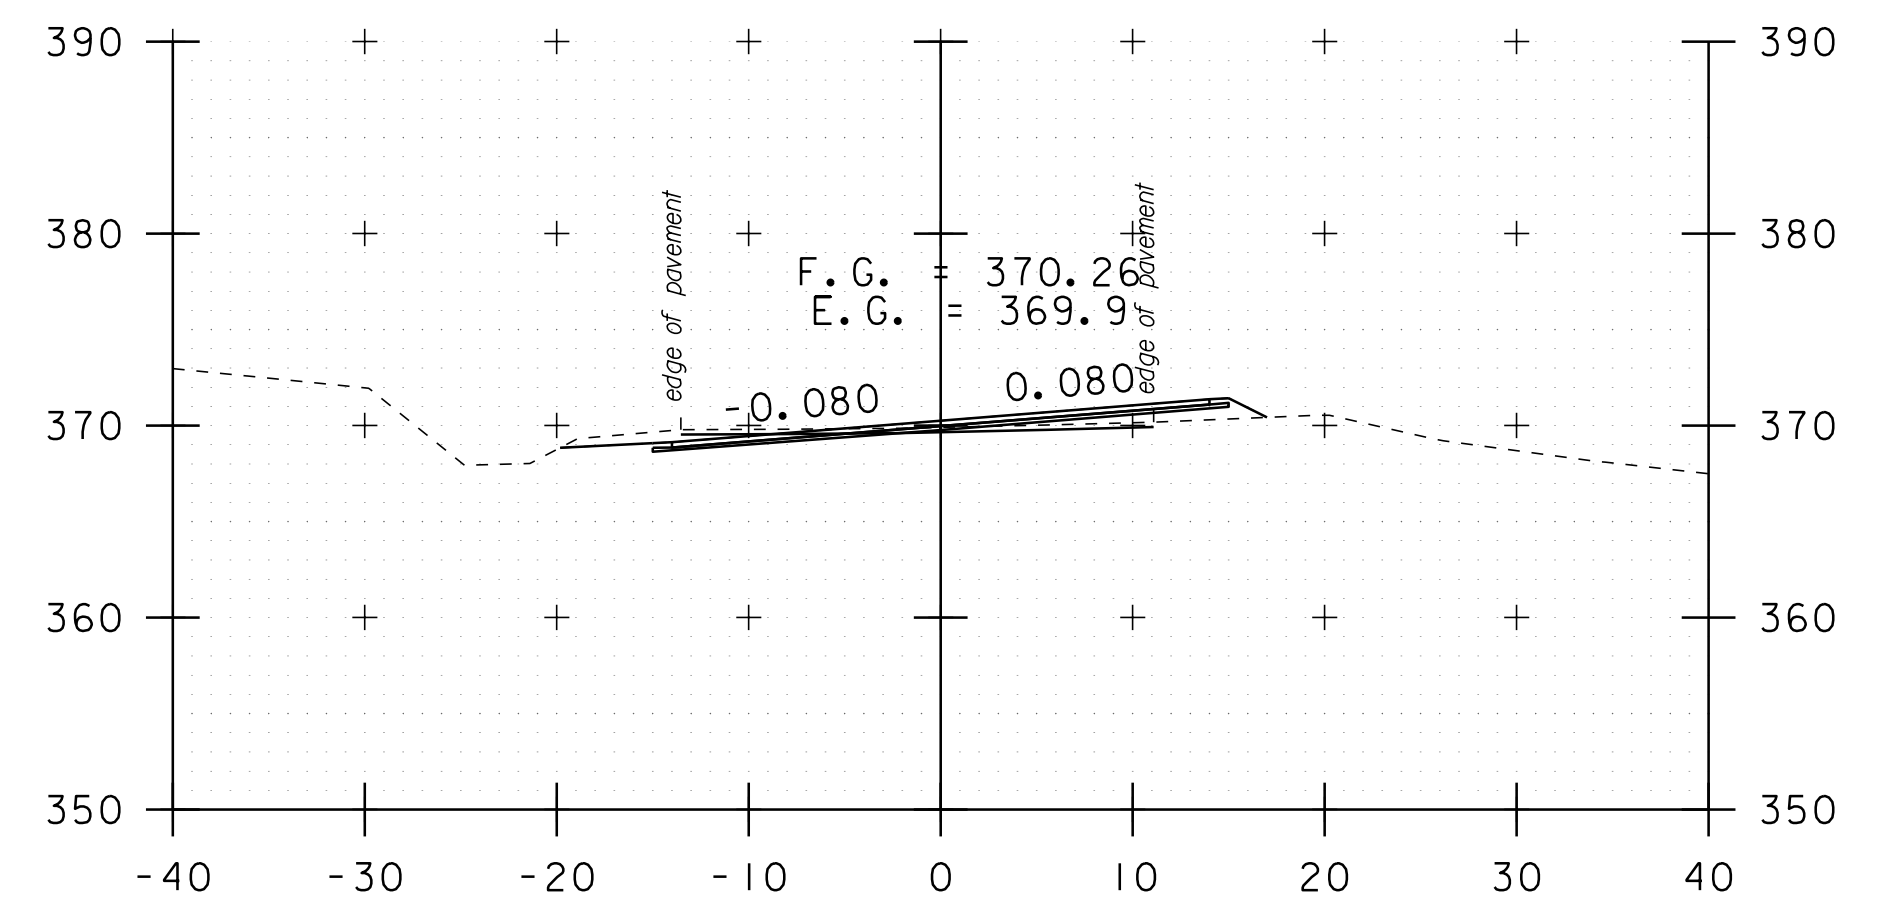


d 163+20

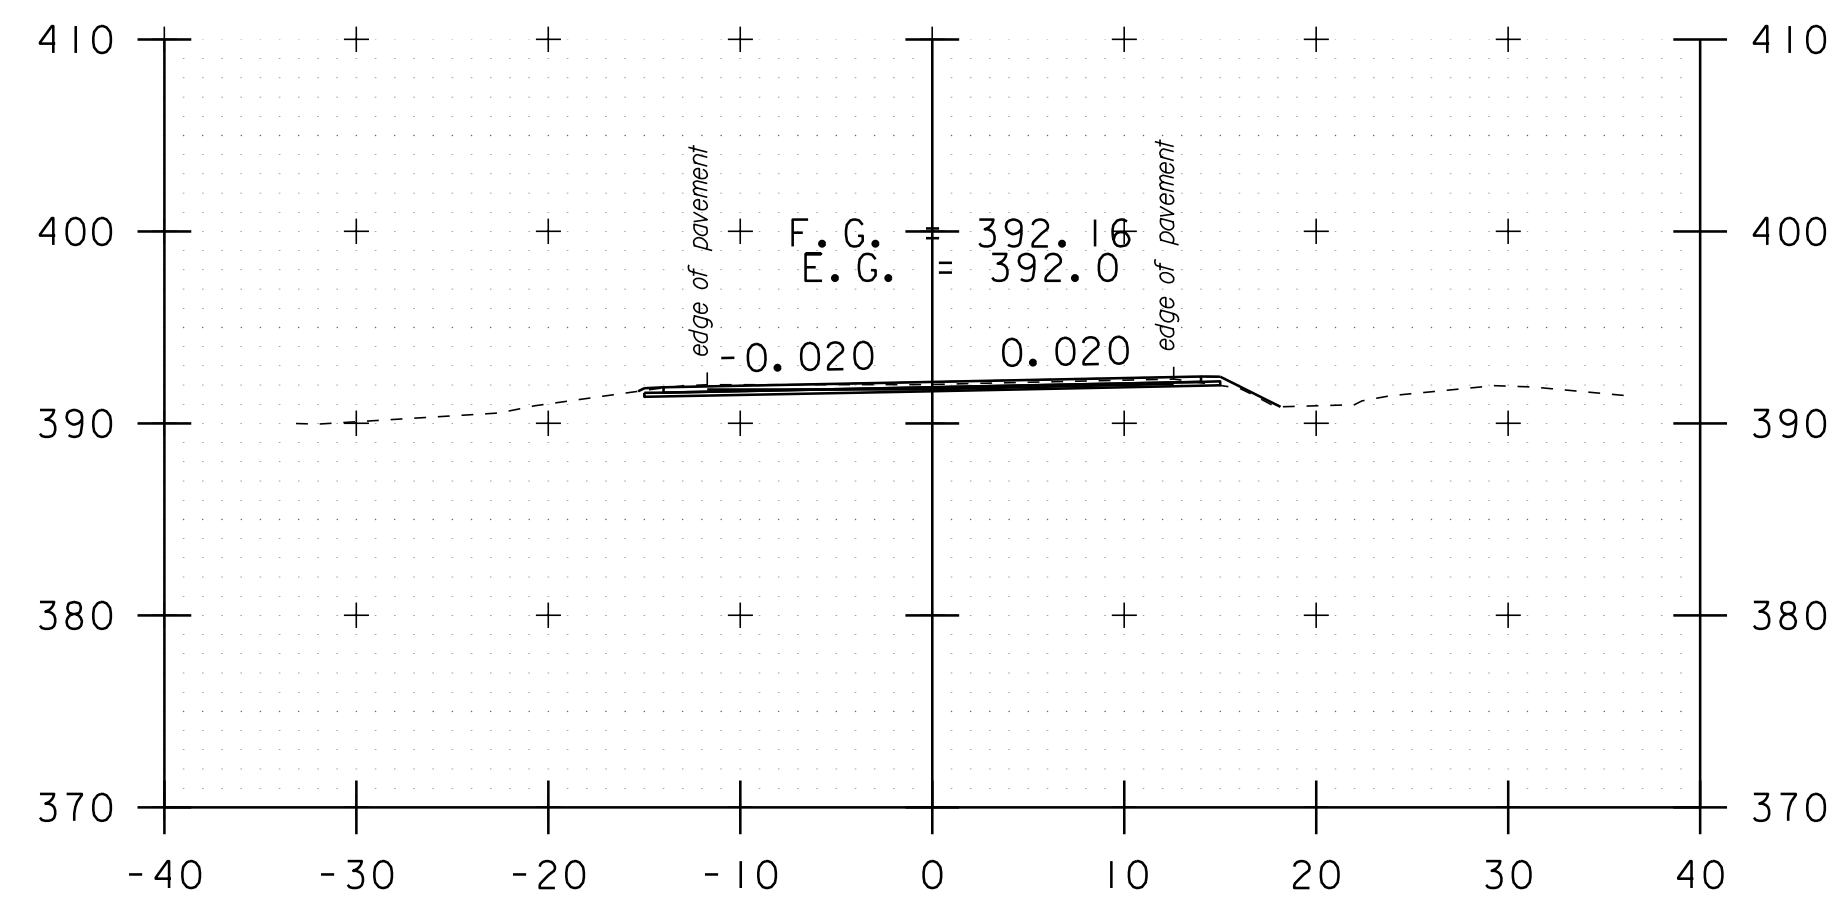


d 159+75

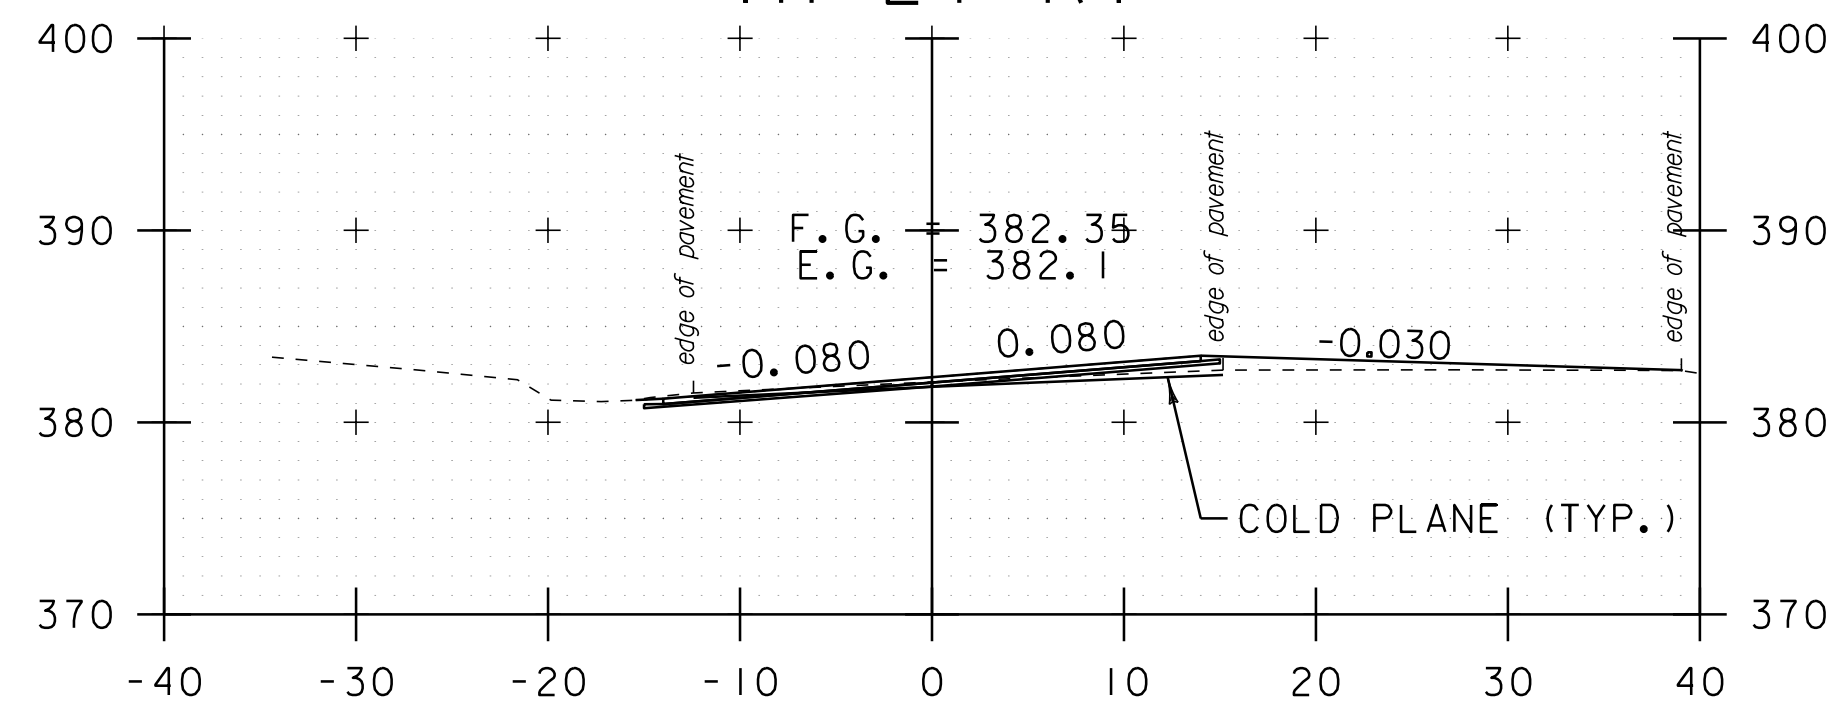


d 161+50
TH#21 RT

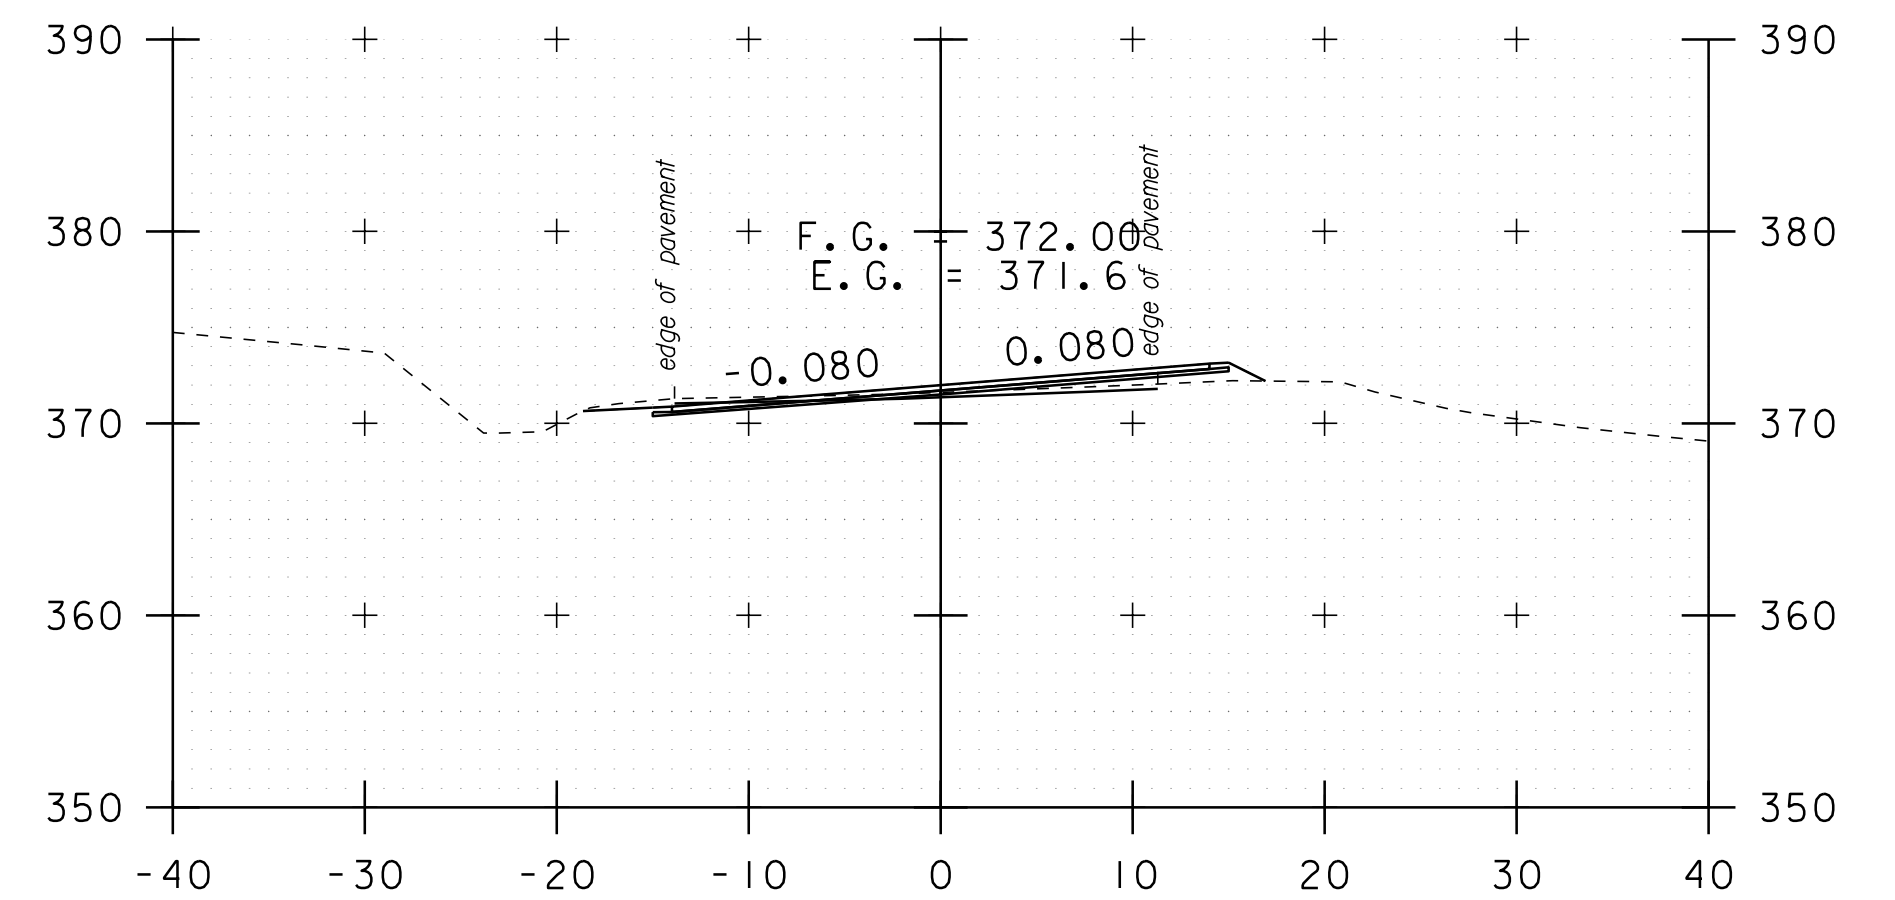


d 163+00

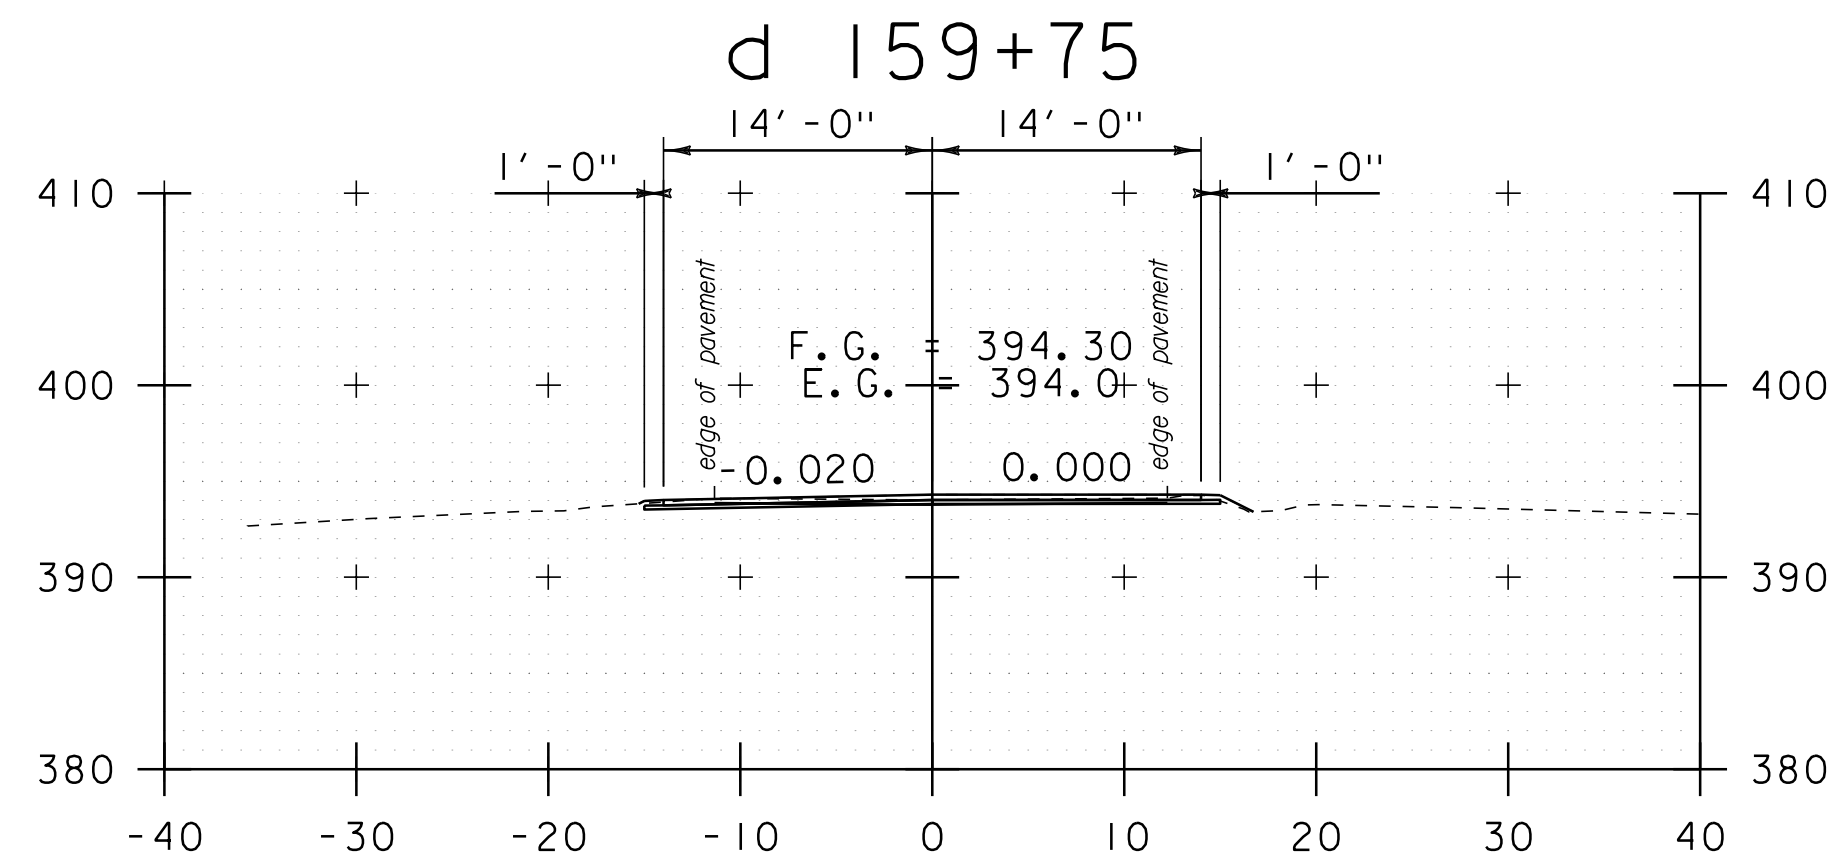

d 159+30

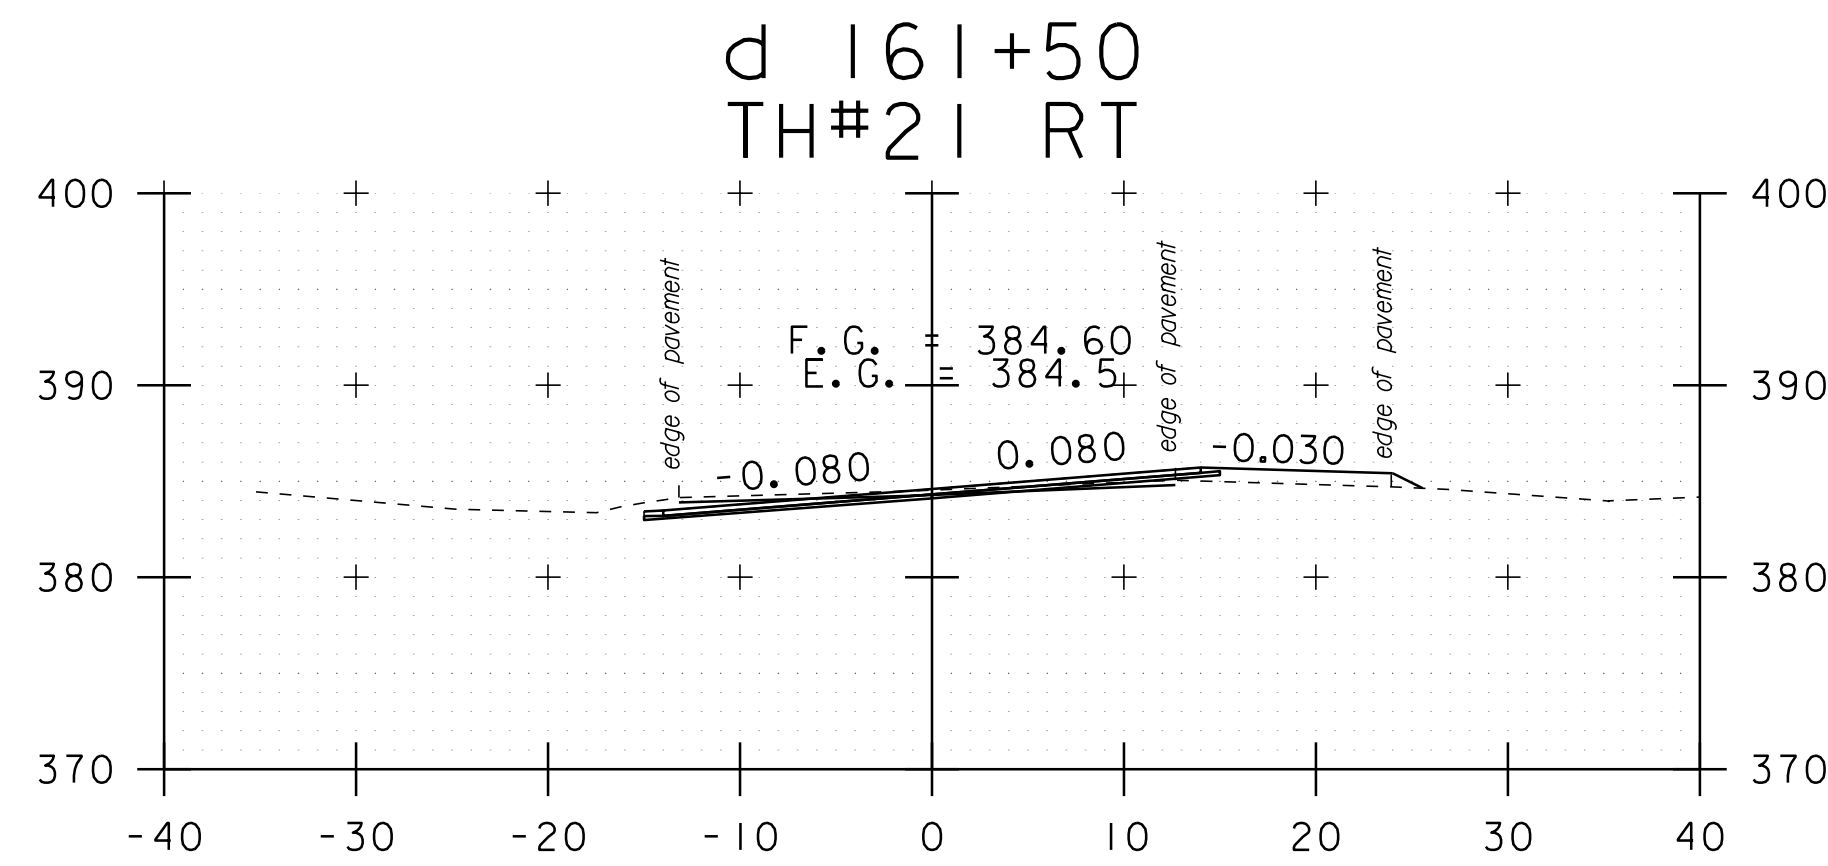

d 161+10
TH#21 RT

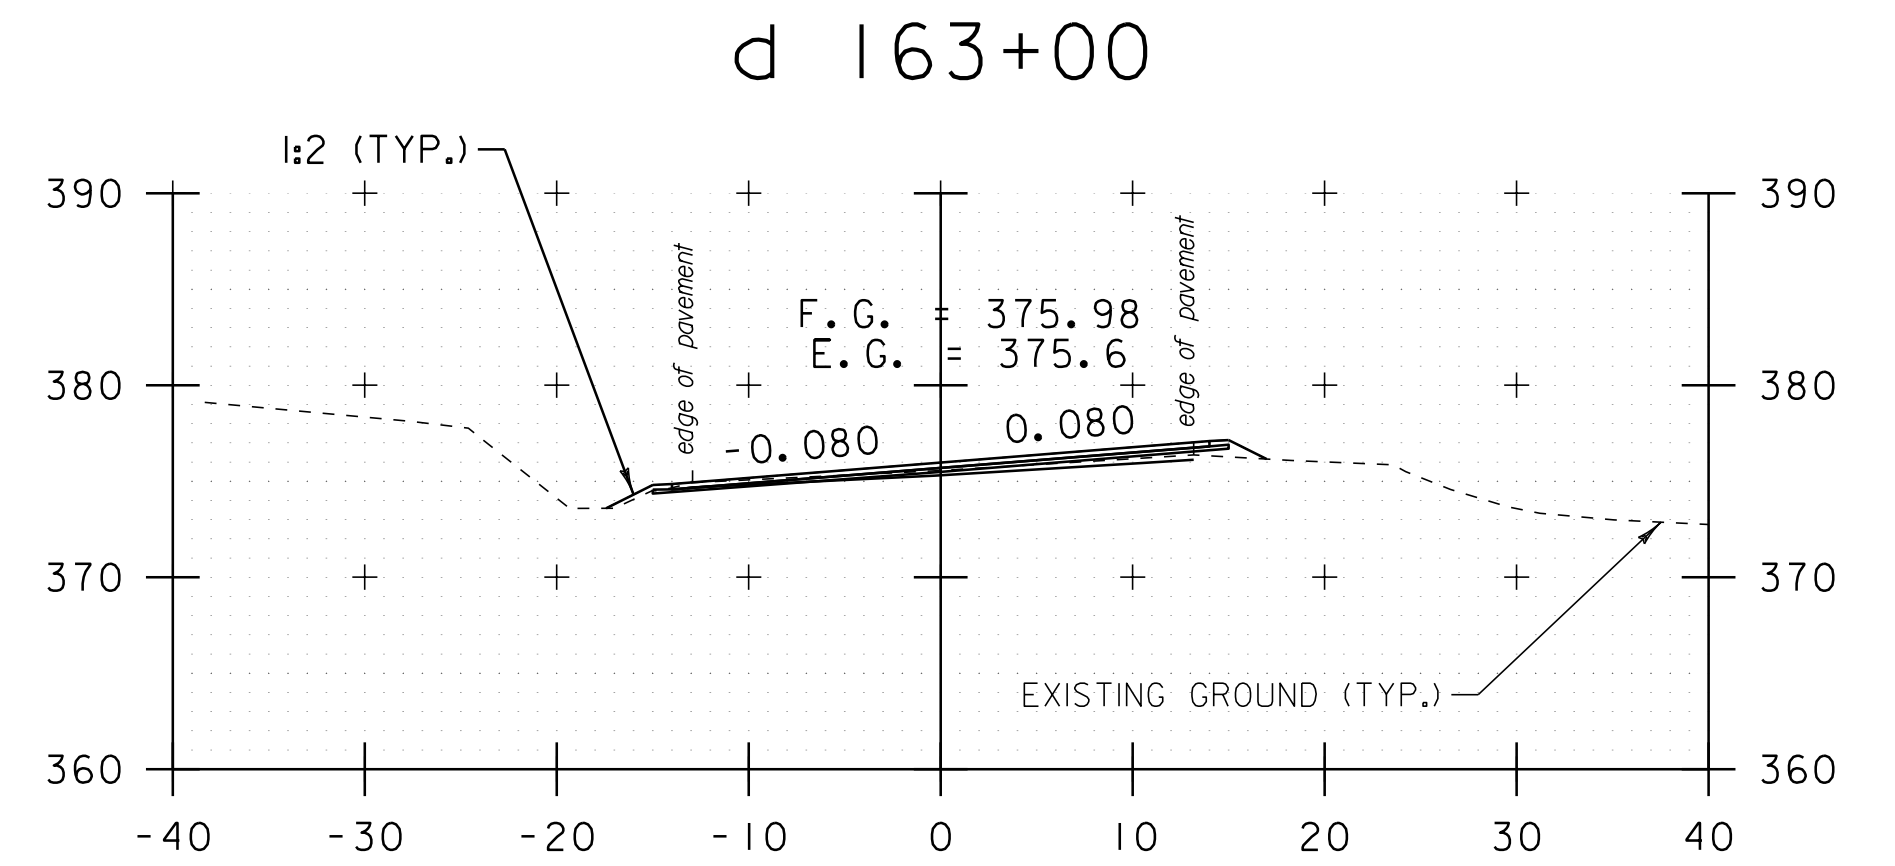

d 162+50

STA. d 159+30 TO STA. d 163+20

DATUM
NAVD 88
NAD 83

SCALE 1" = 10'-0"
10 0 10

CROSS SECTION SHEET 51

PROJECT NAME: ADDISON-NEW HAVEN
PROJECT NUMBER: STP 9632(1)
FILE NAME: p95B076.dgn
PROJECT LEADER: CDL
DESIGNED BY: SJL
PLOT FILE: p95B076_156.1
PLOT DATE: 3/13/2012
DRAWN BY: SJL
CHECKED BY: EPD
SHEET 156 OF 186