




d 165+00

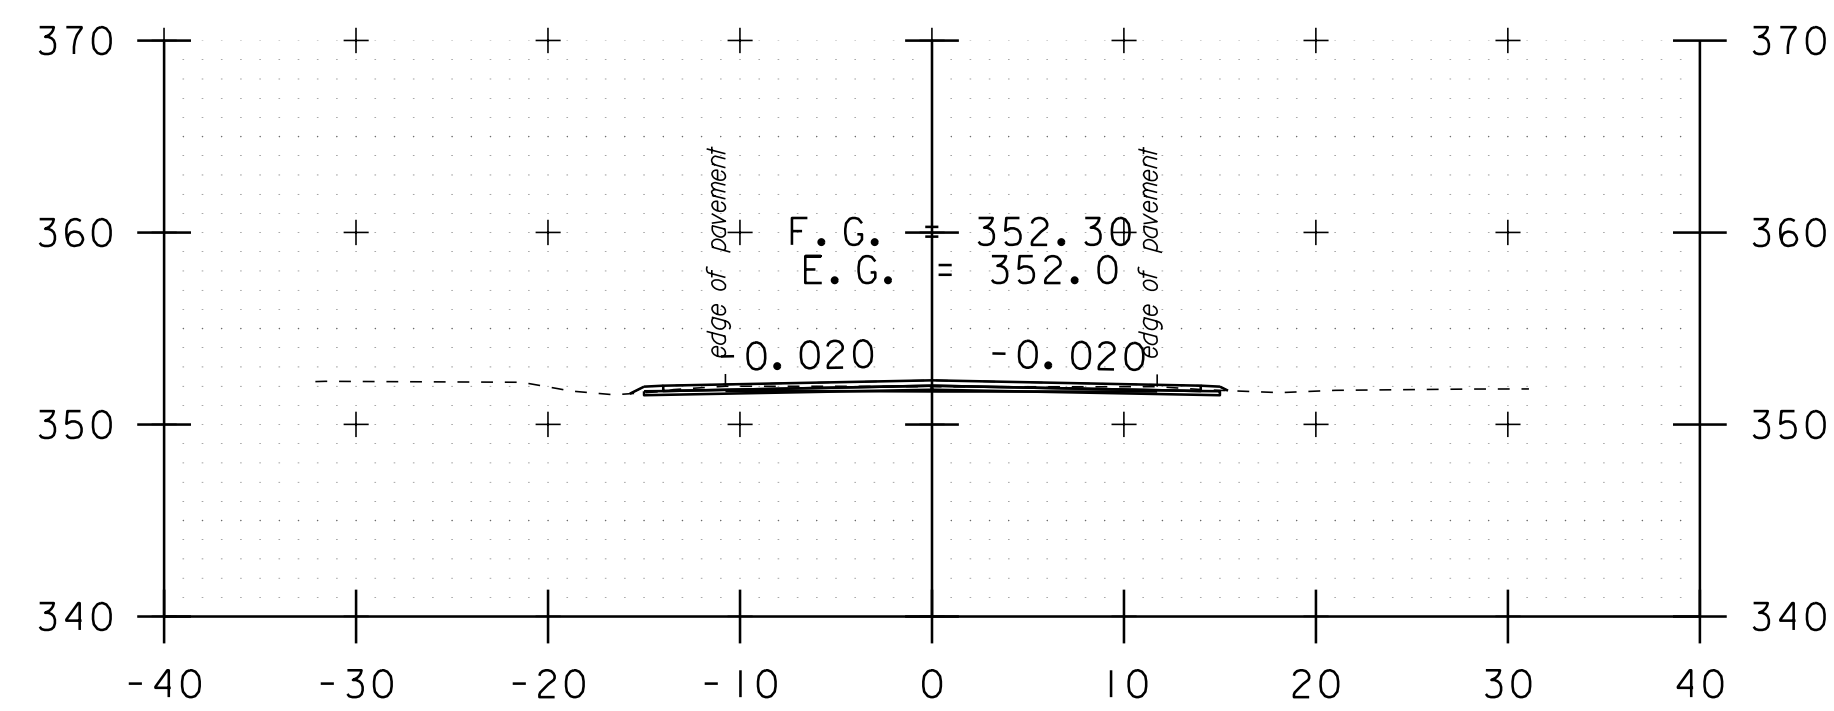


d 166+95

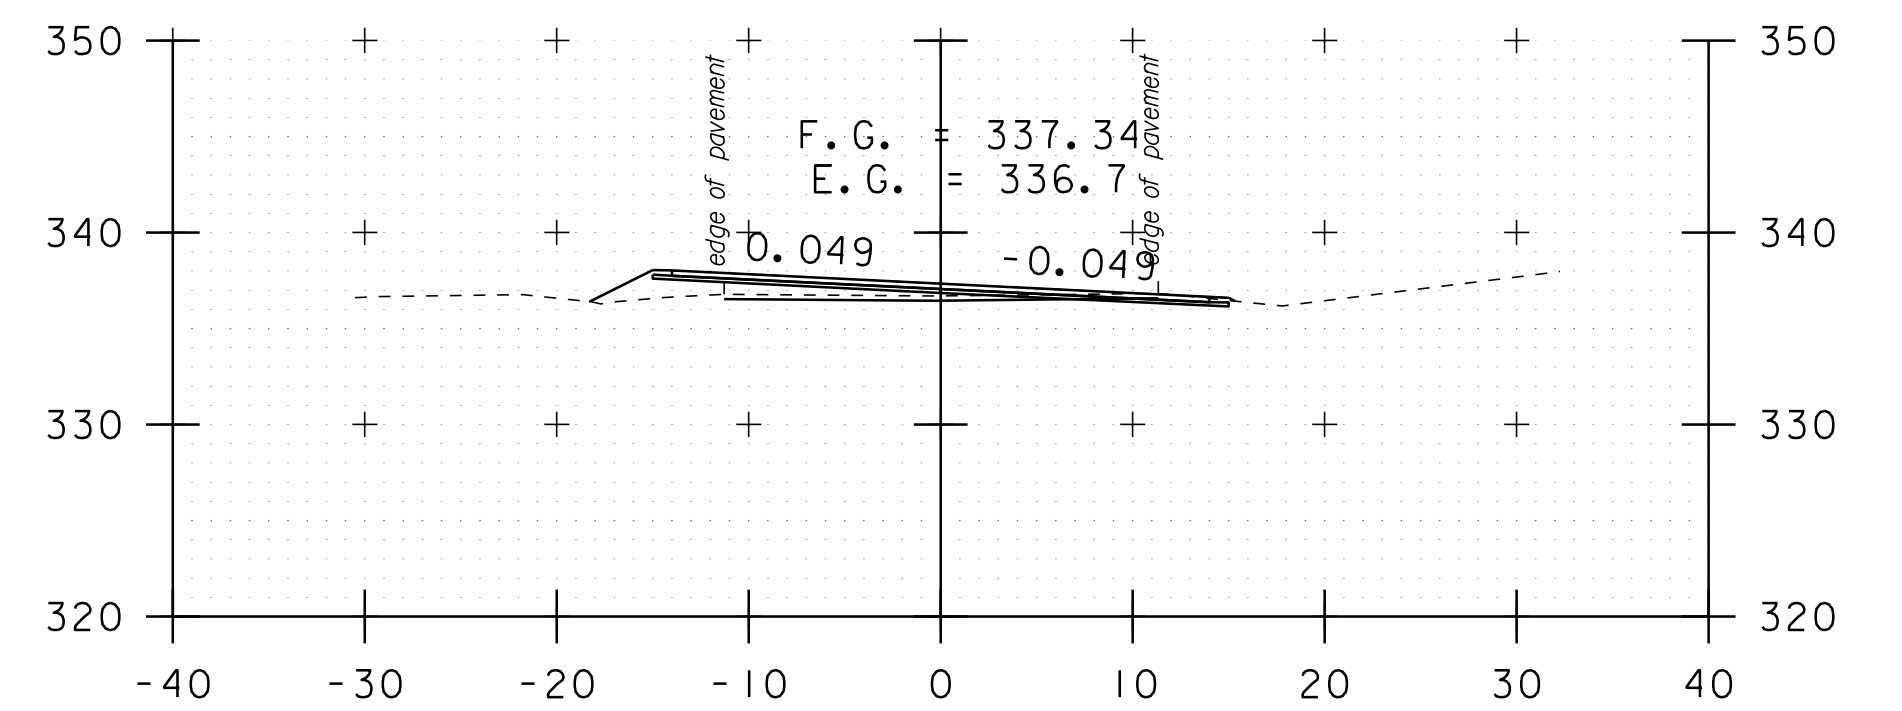


d 169+04

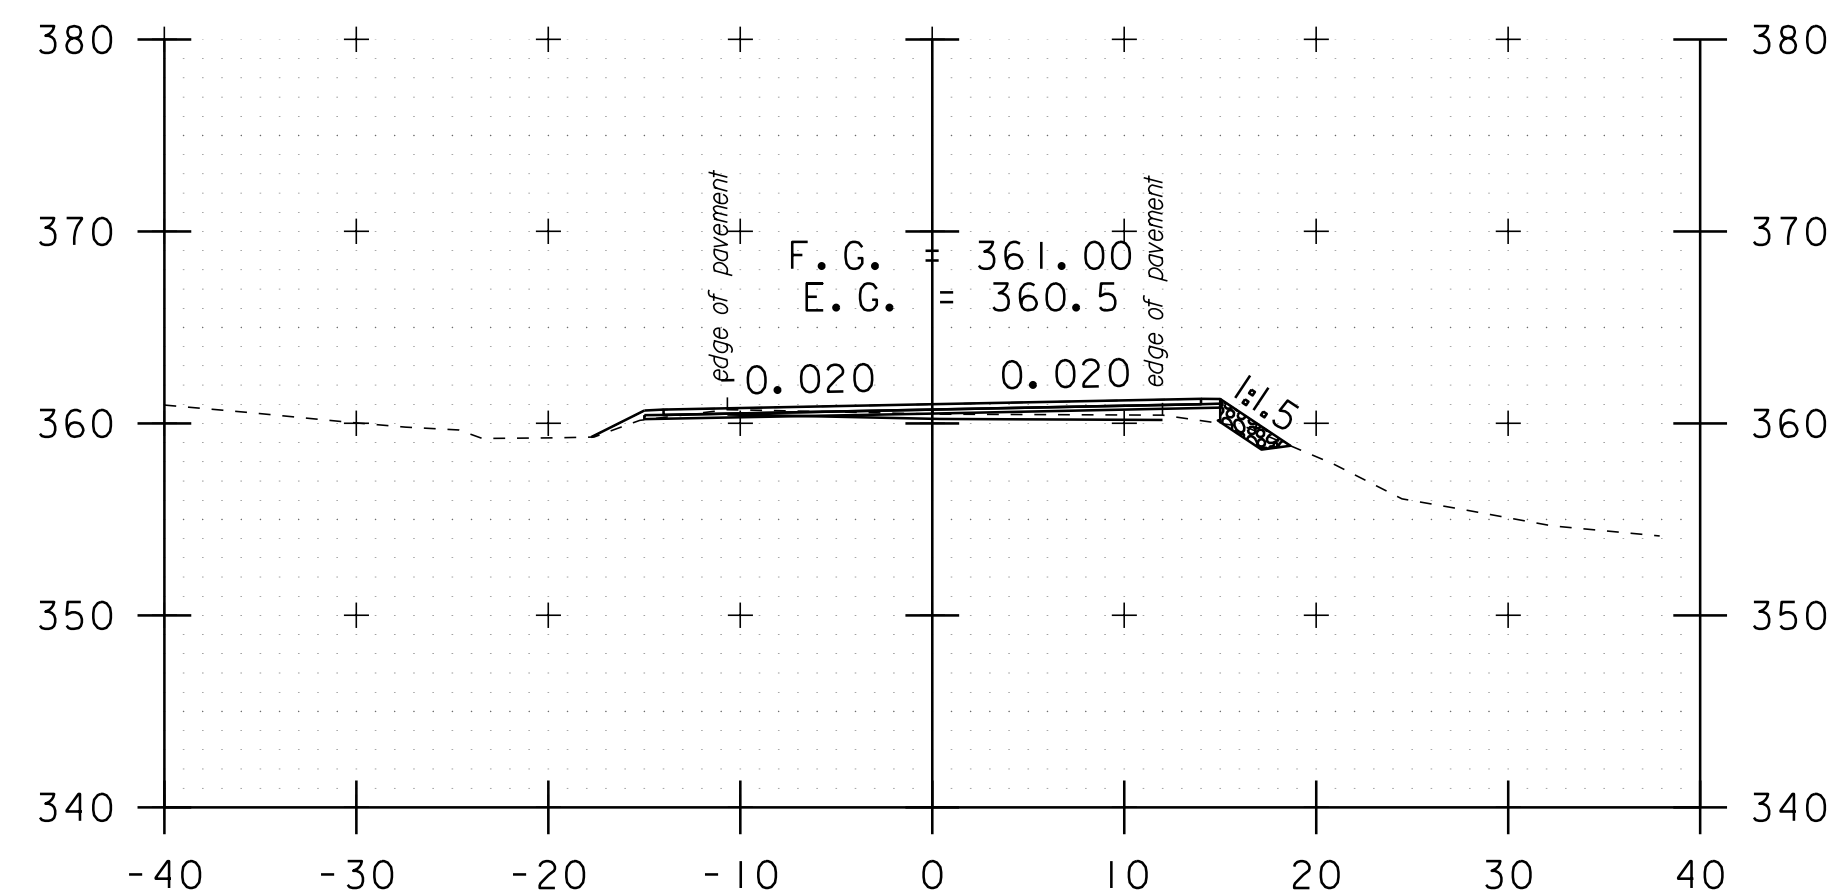


d 164+55

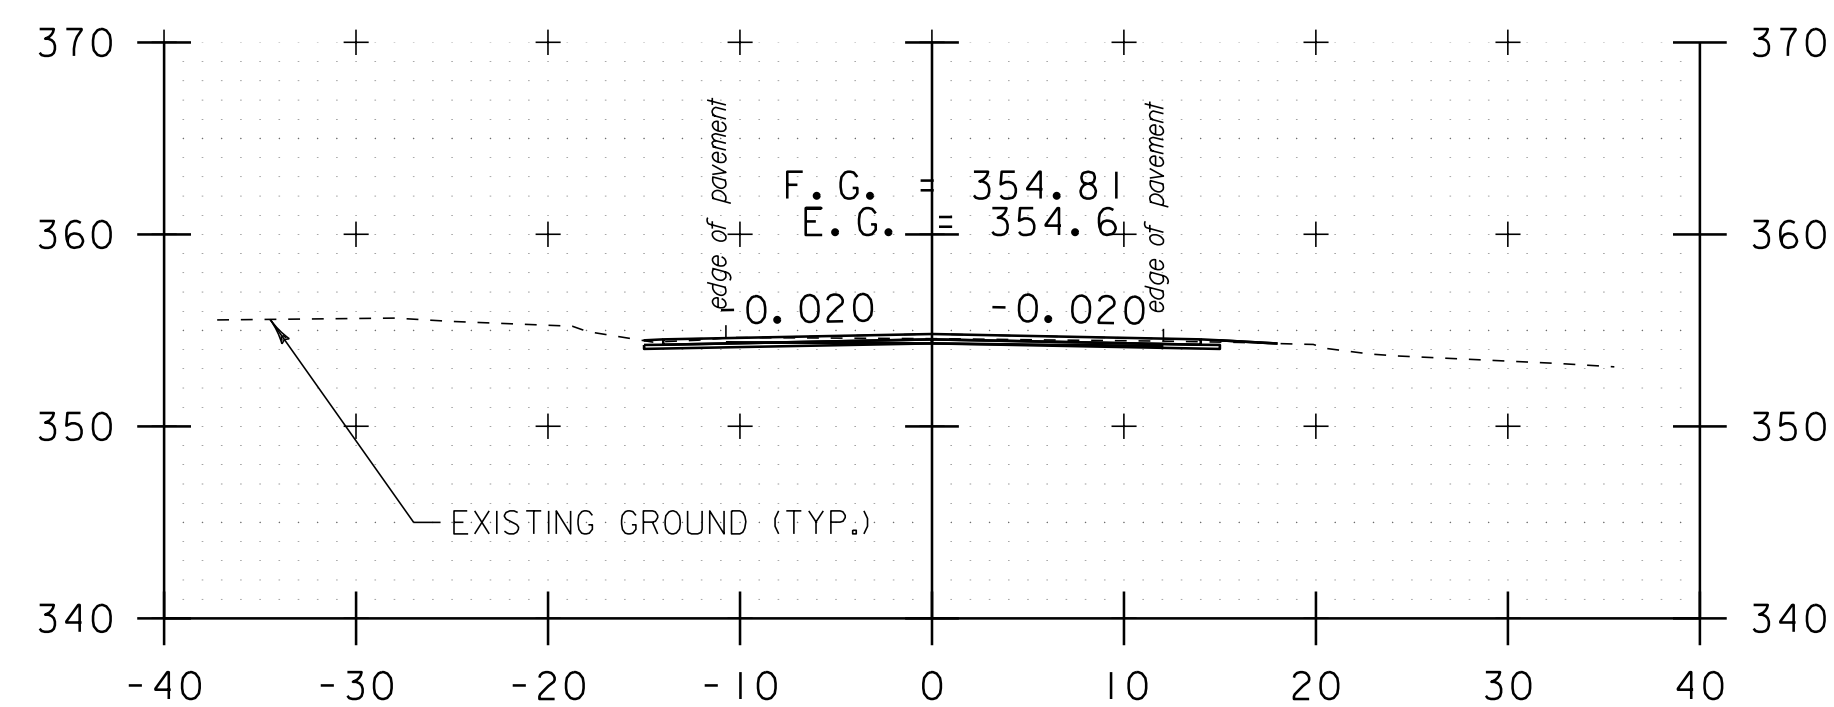


d 166+50  
DRIVE RT

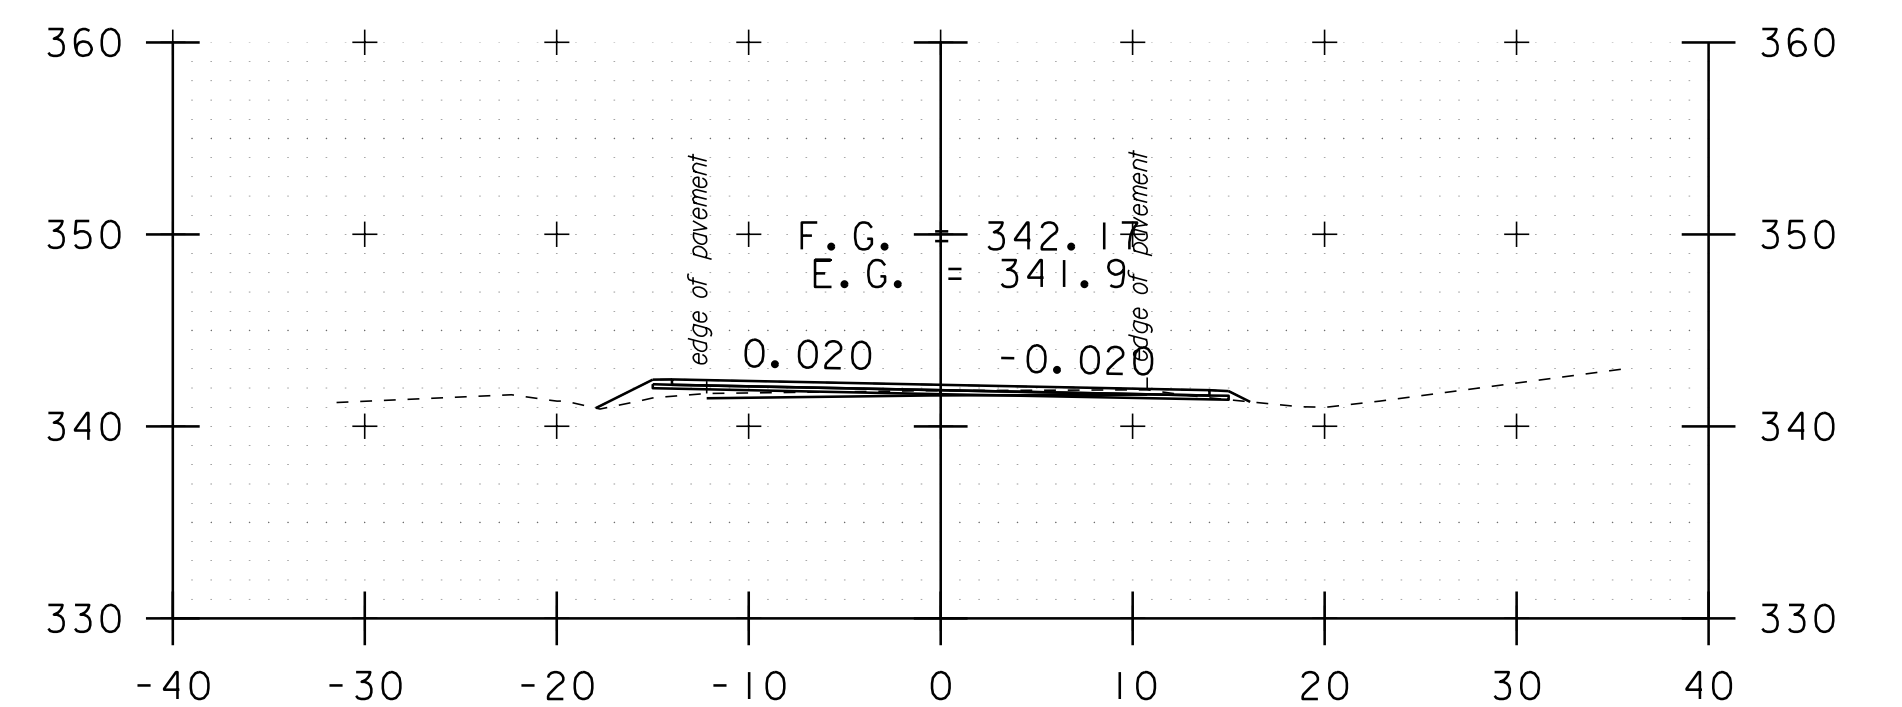


d 168+39

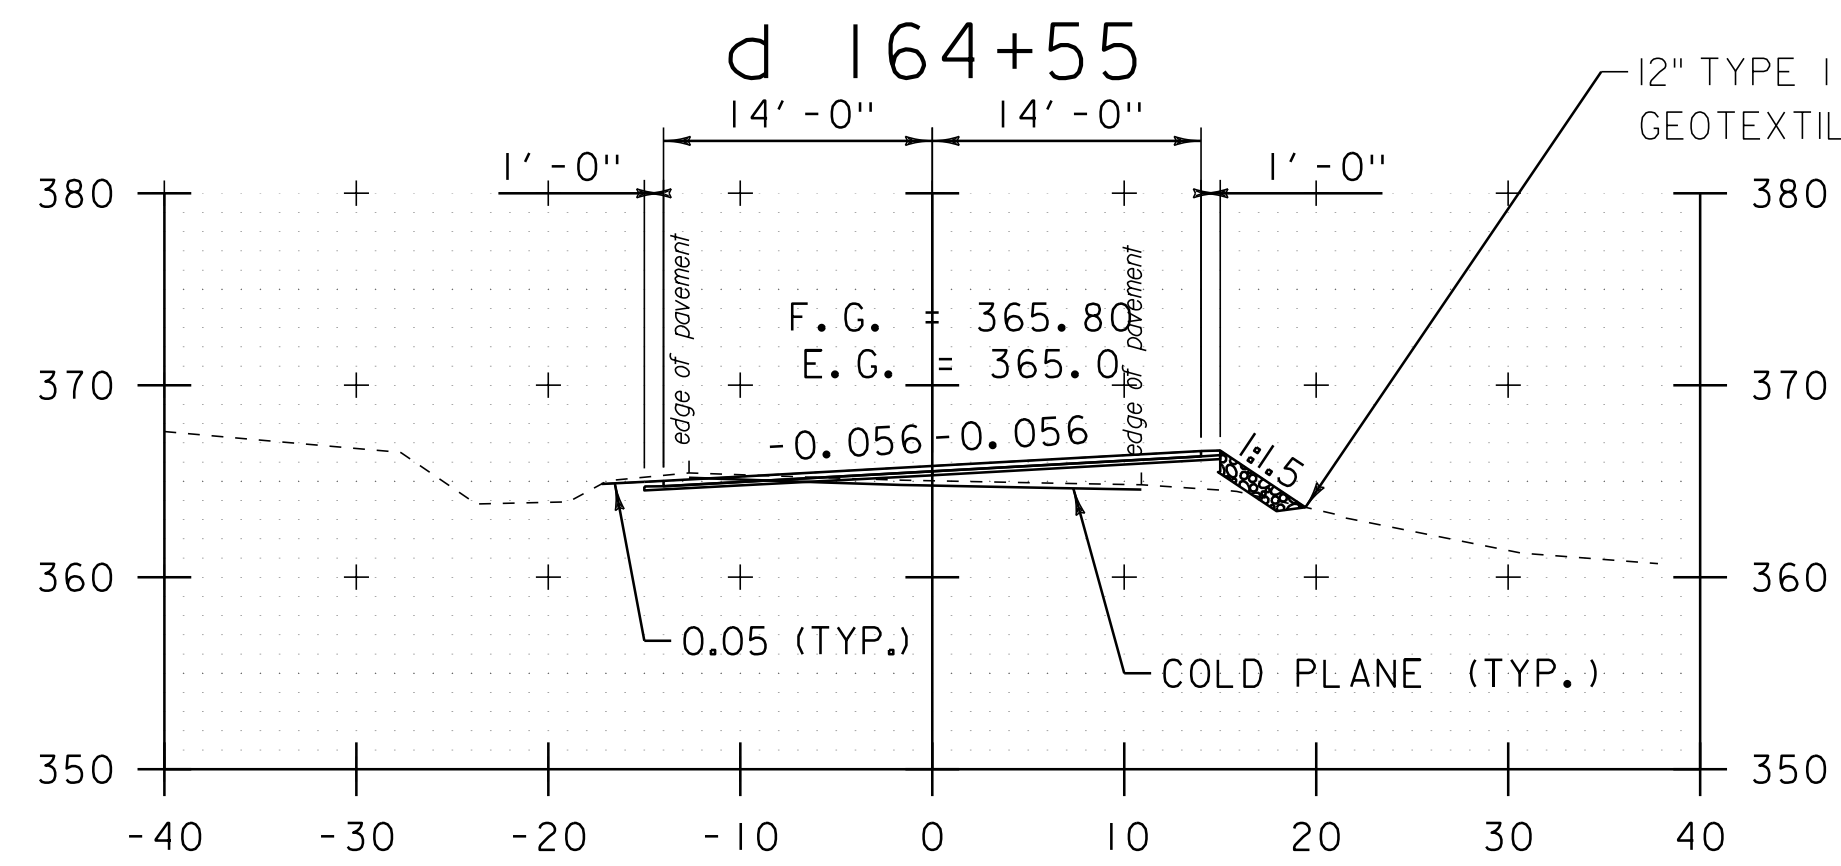

d 163+75

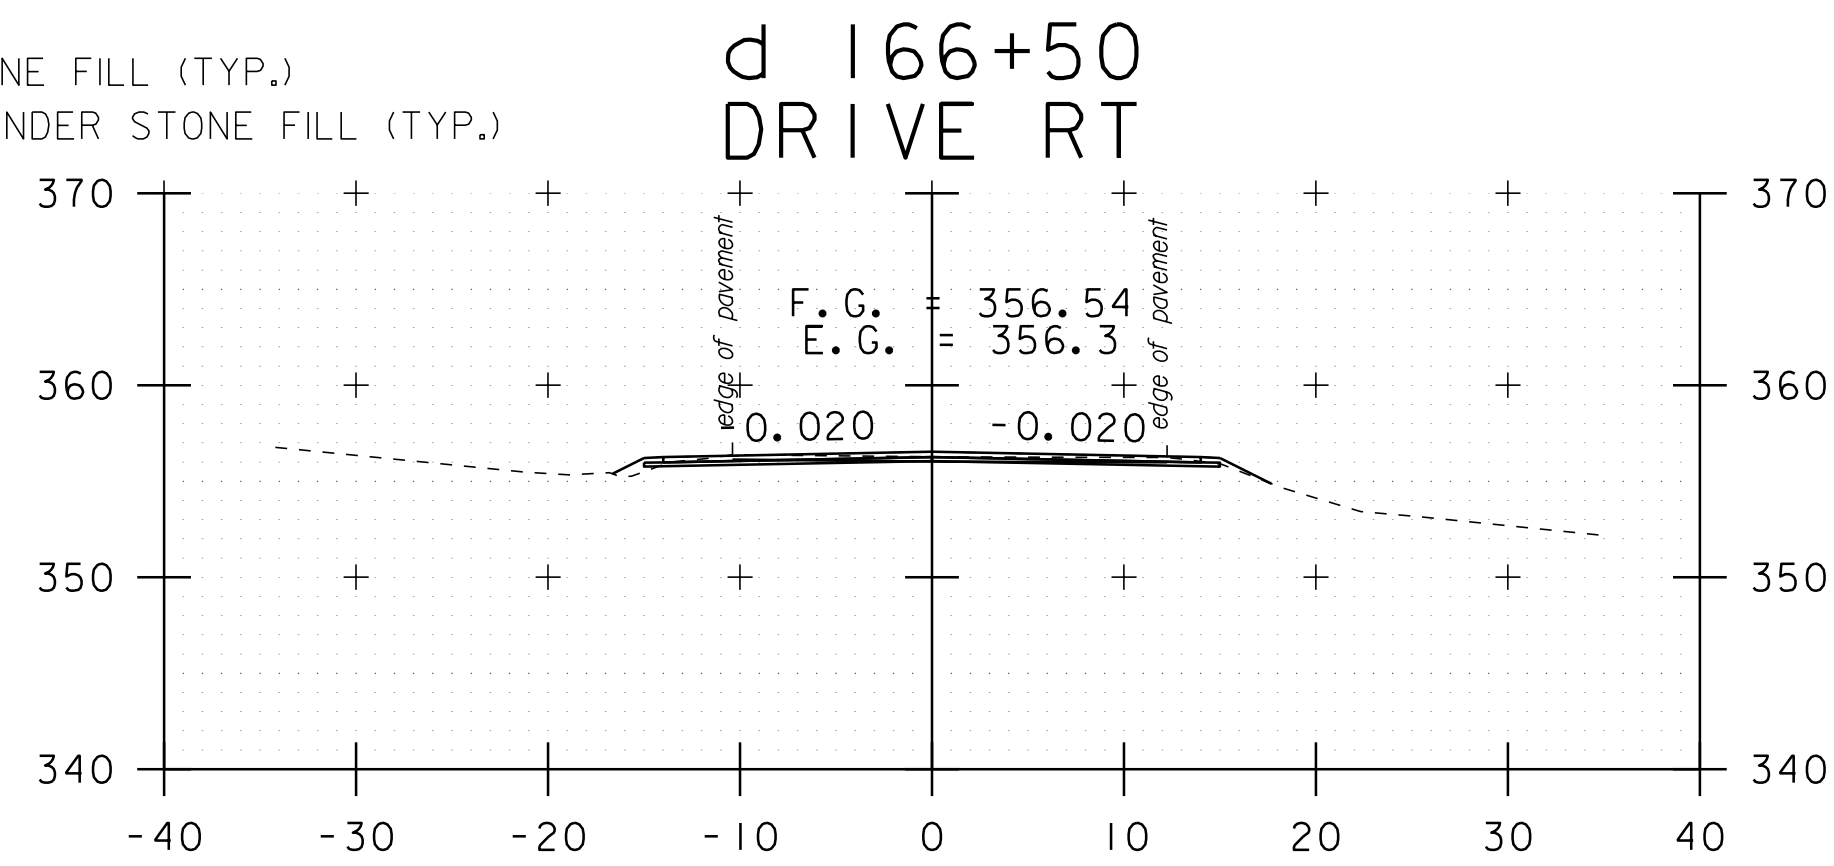


d 166+00

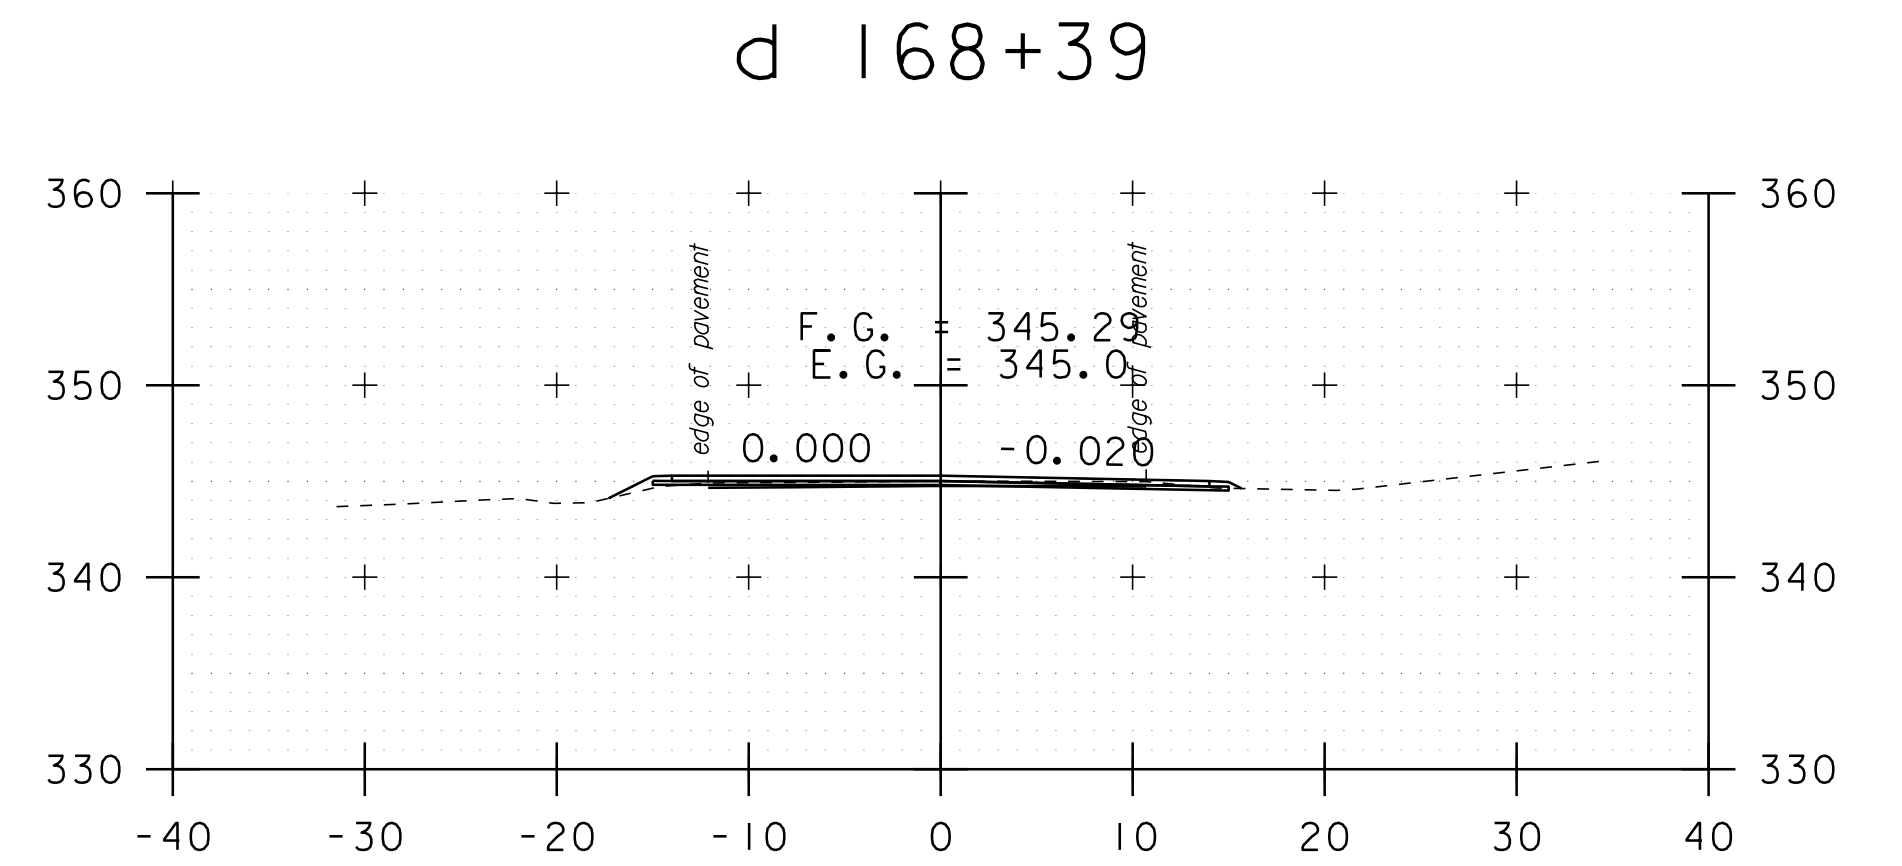

d 167+95

DATUM  
 NAVD 88  
 NAD 83

STA. d 163+75 TO STA. d 169+04

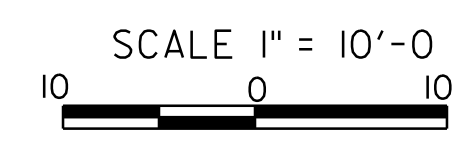

**CROSS SECTION SHEET 52**

PROJECT NAME: ADDISON-NEW HAVEN  
 PROJECT NUMBER: STP 9632(1)  
 FILE NAME: p95B076.dgn  
 PROJECT LEADER: CDL  
 DESIGNED BY: SJL  
 PLOT FILE: p95B076\_157.1  
 PLOT DATE: 3/13/2012  
 DRAWN BY: SJL  
 CHECKED BY: EPD  
 SHEET 157 OF 186