




d 170+50

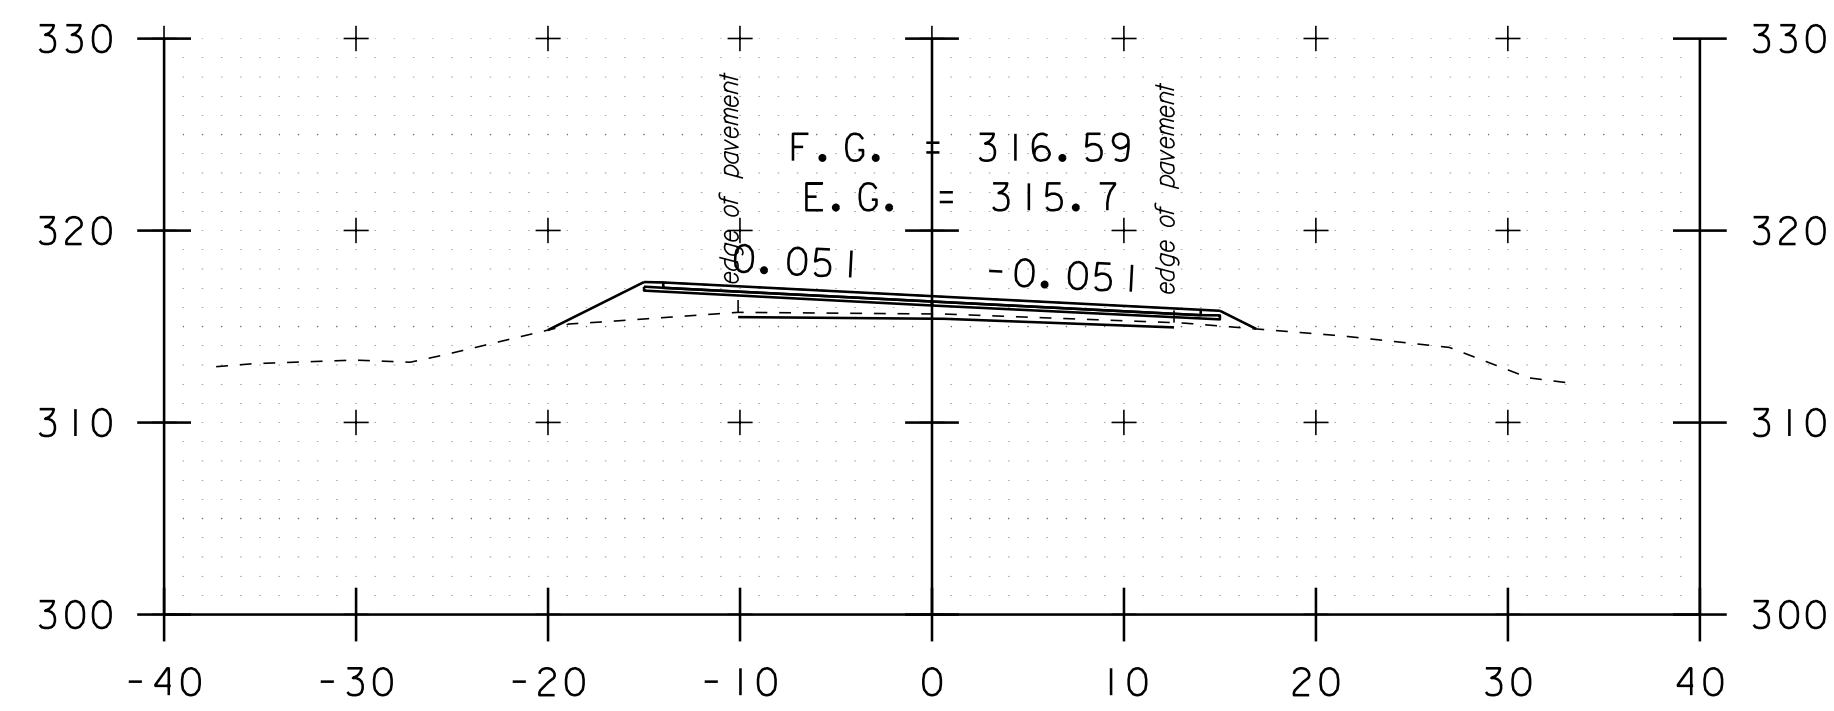


d 171+72

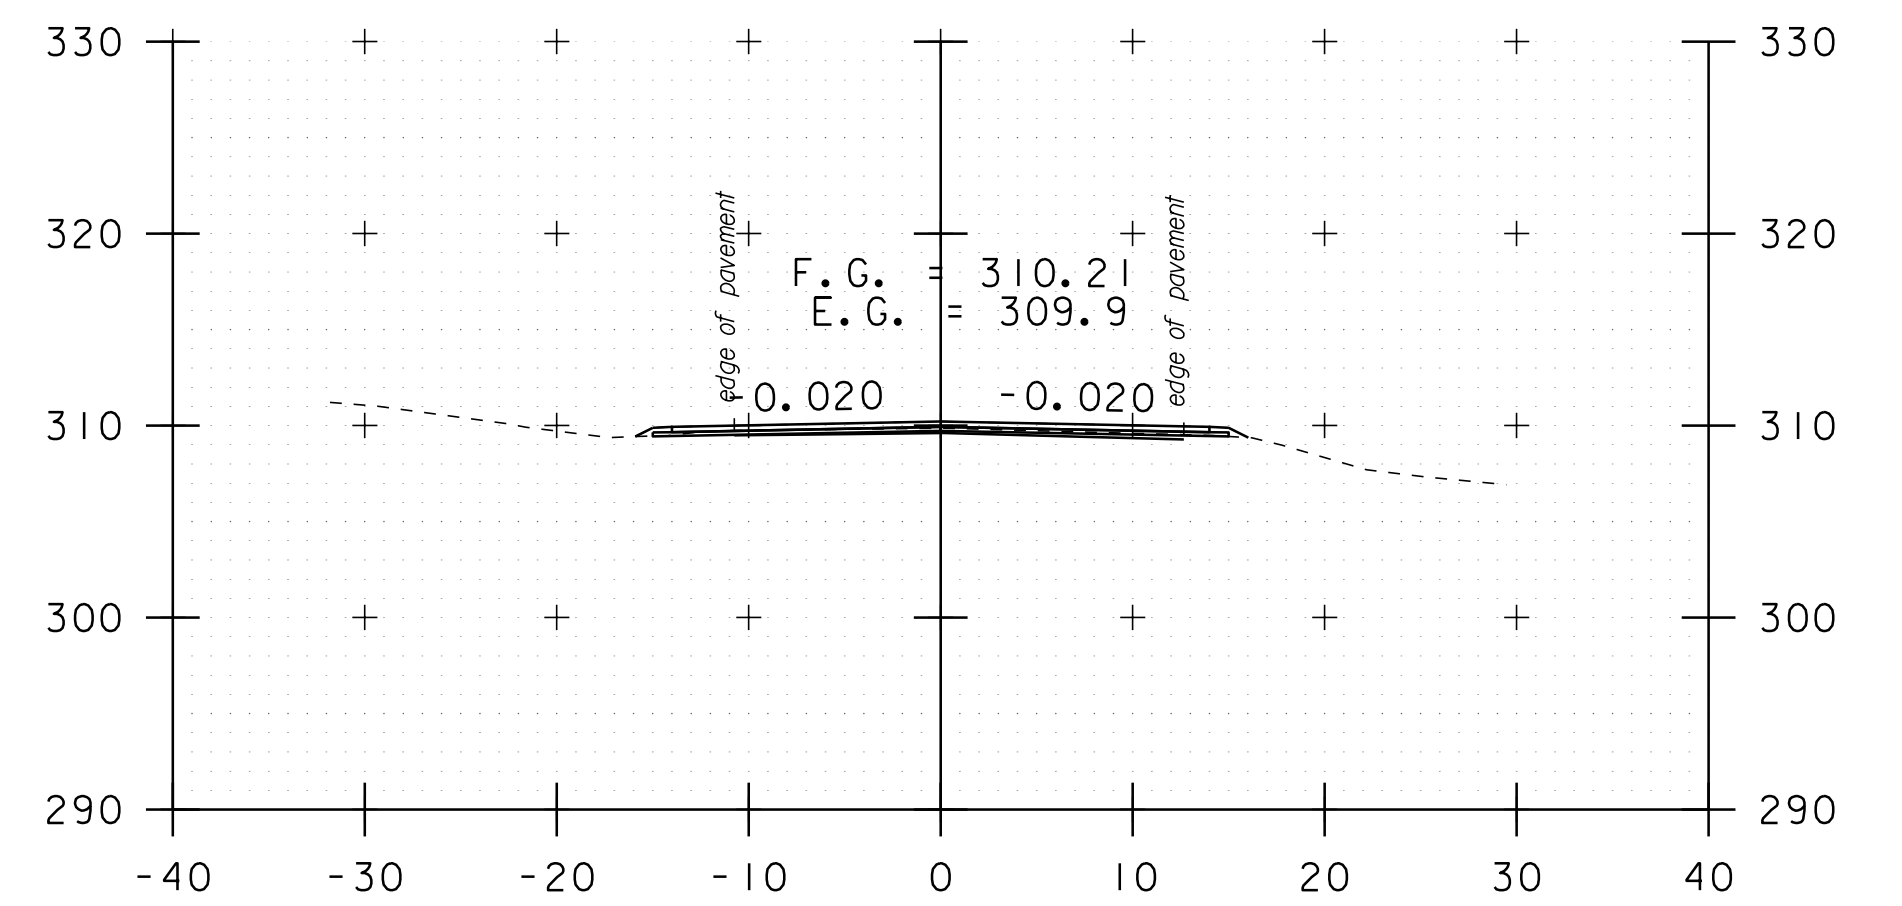


d 173+85

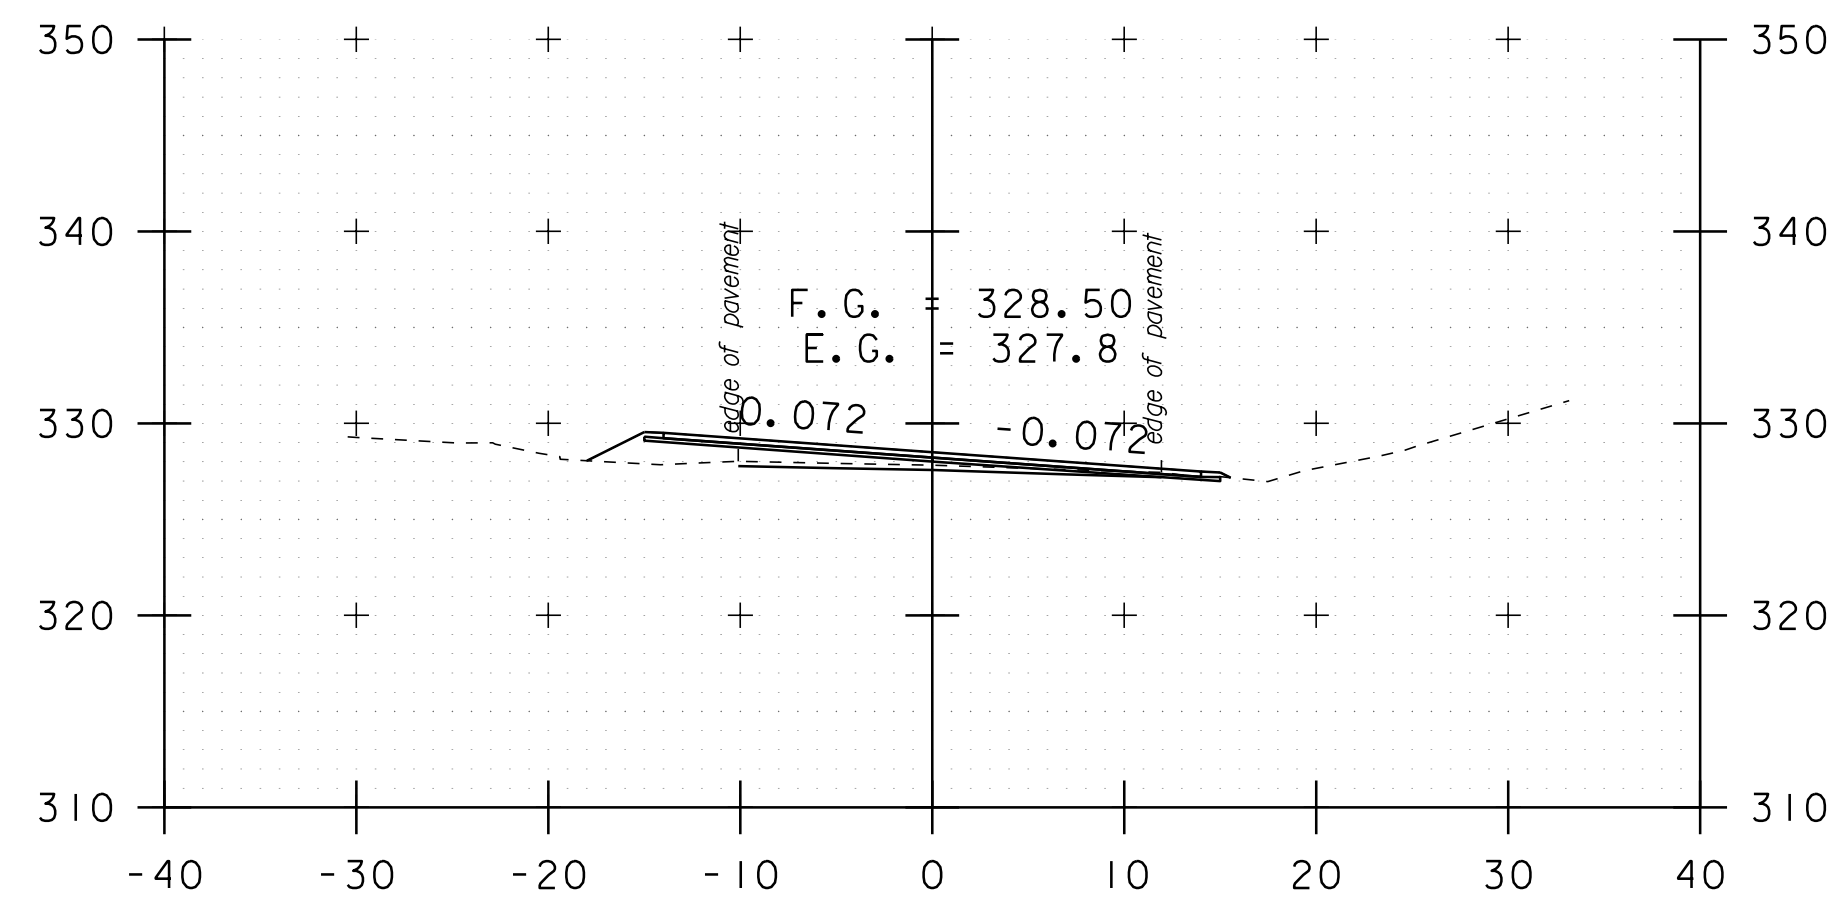


d 170+00

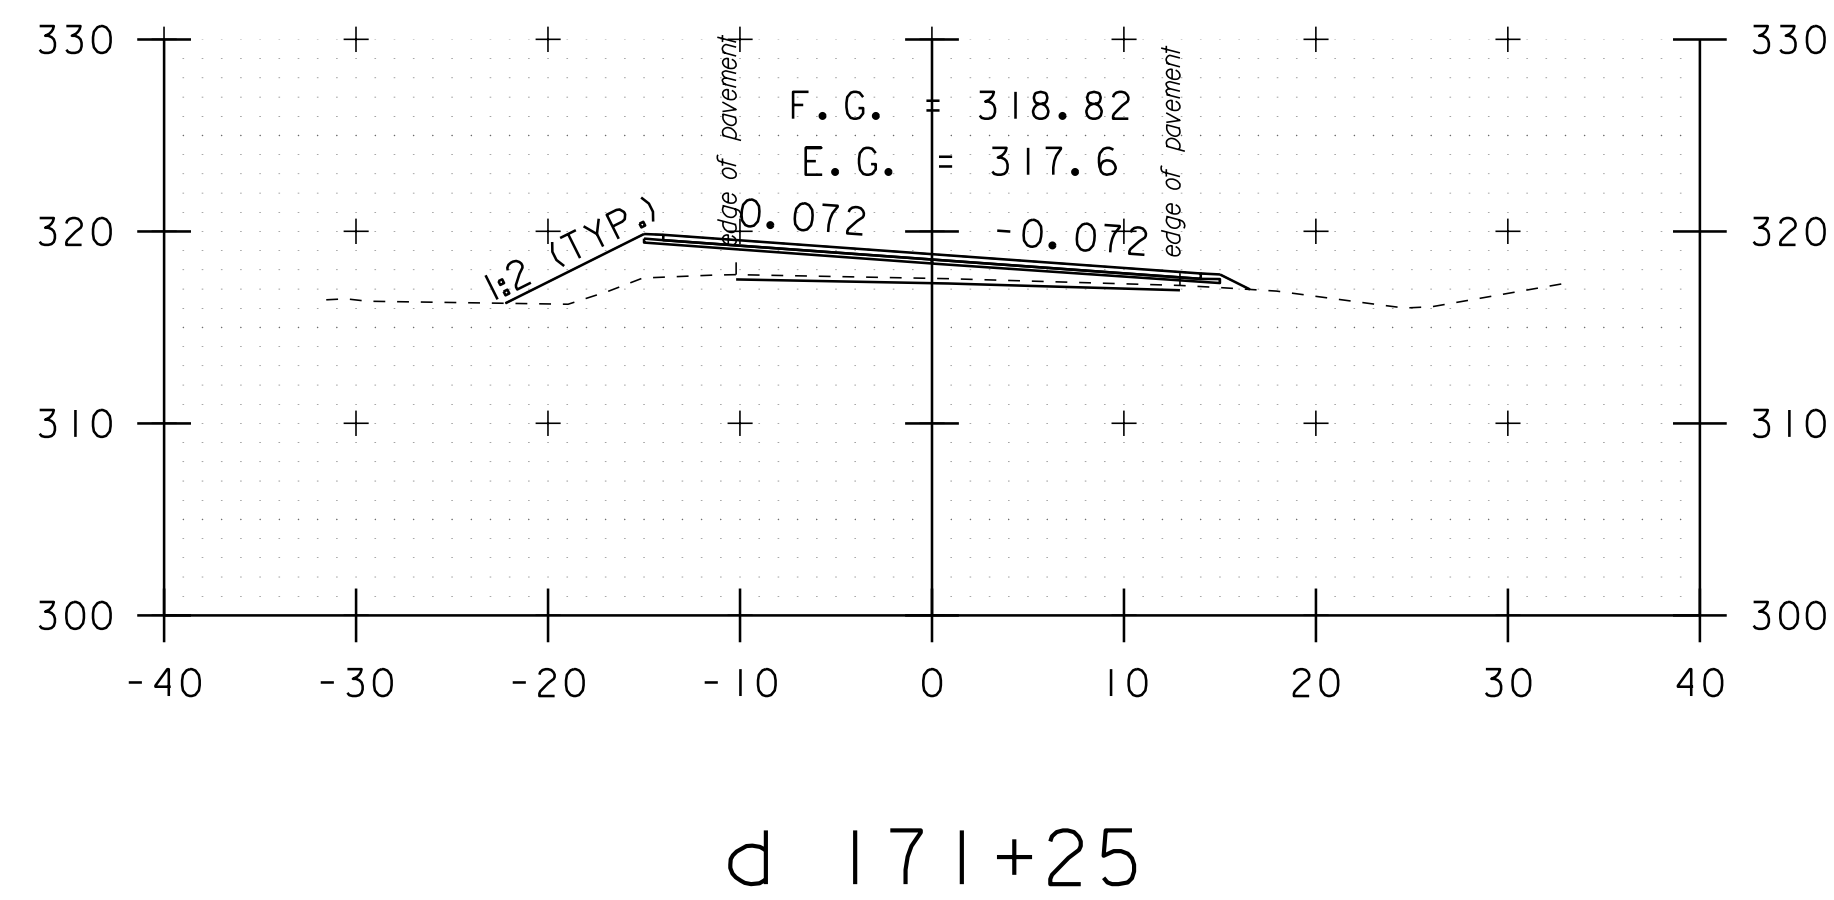


d 171+25

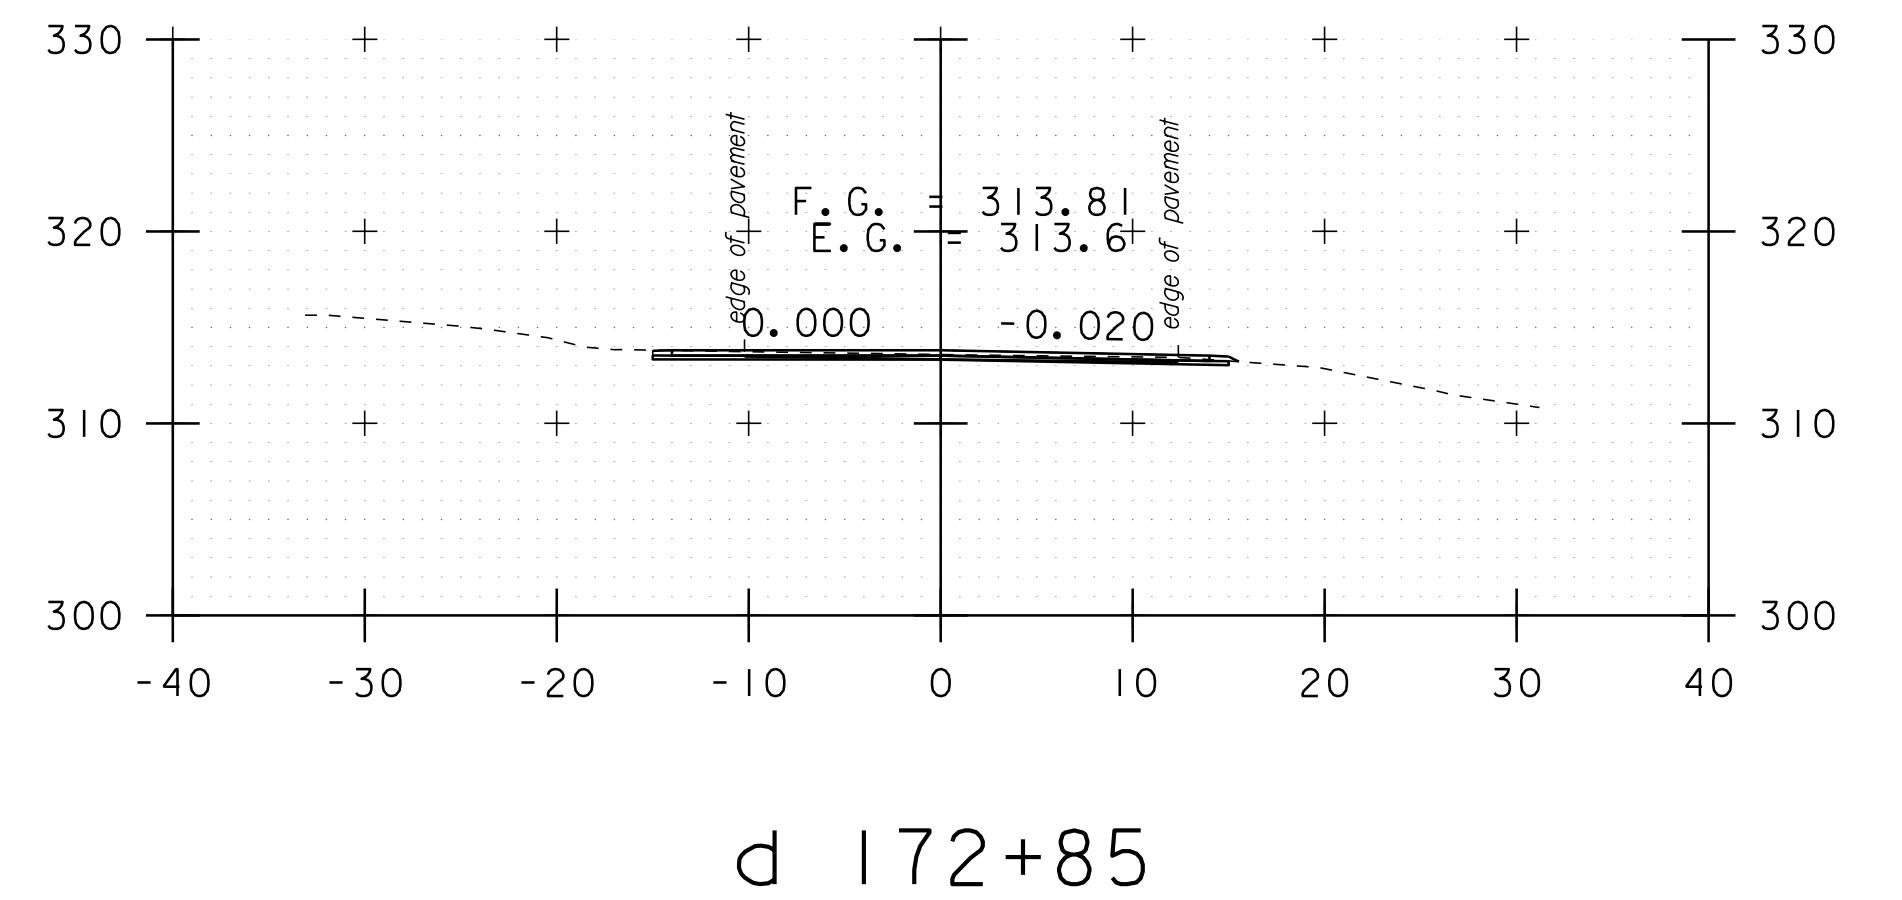


d 172+85

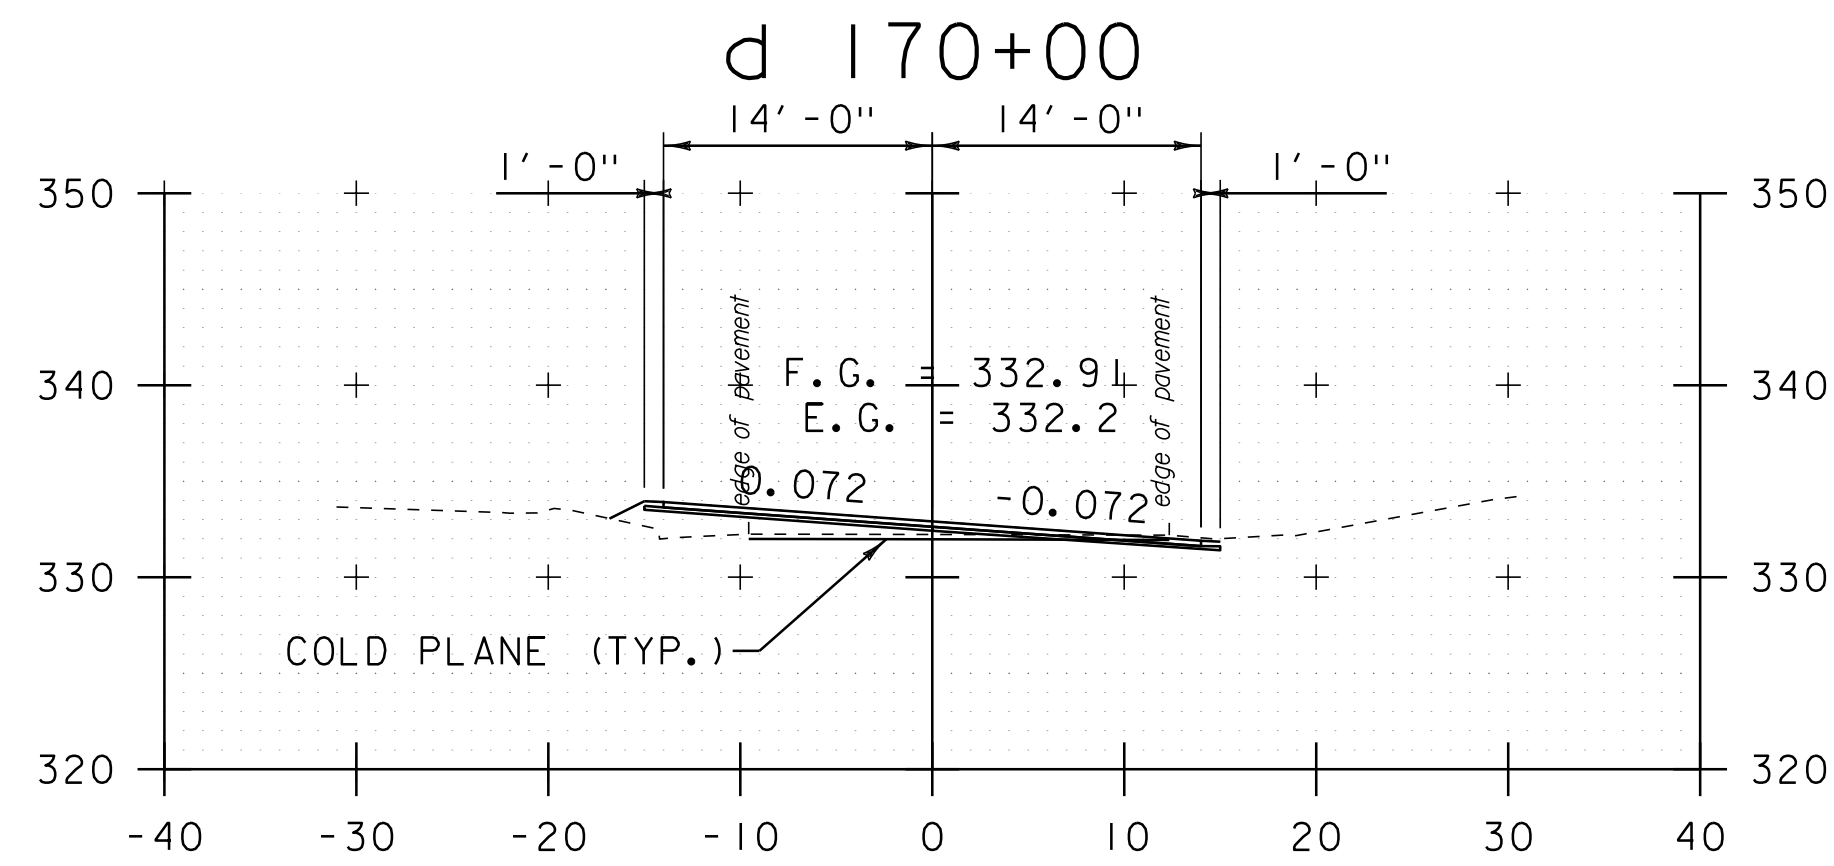

d 169+55

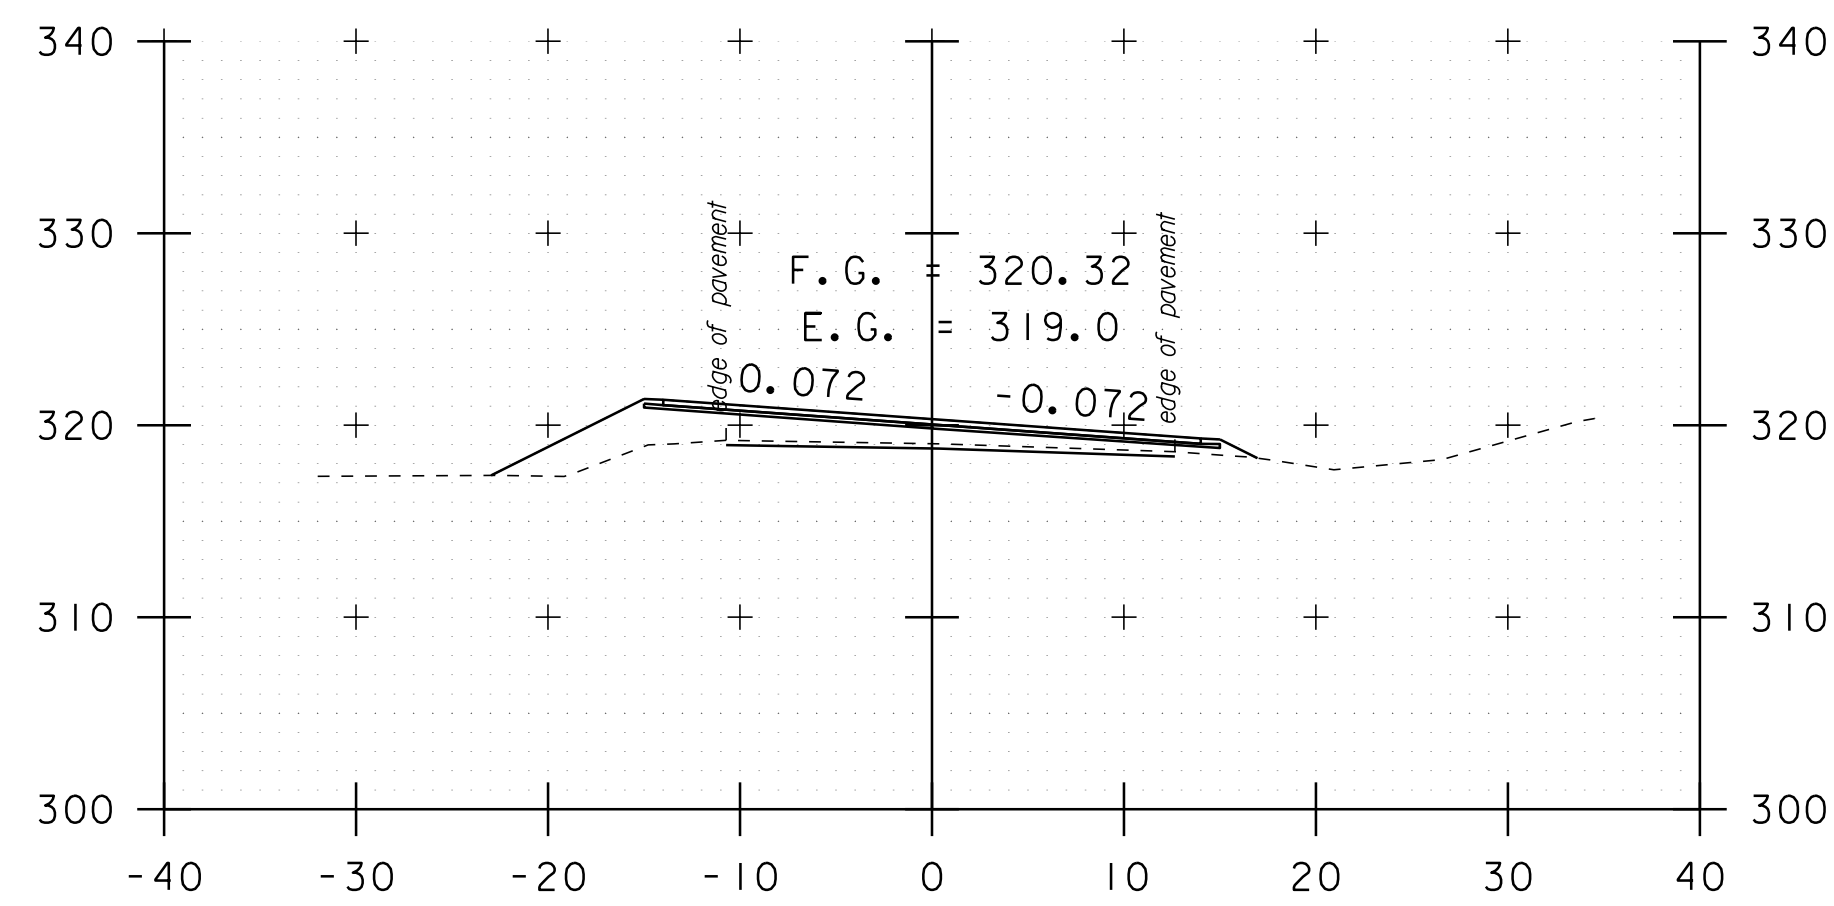


d 171+00

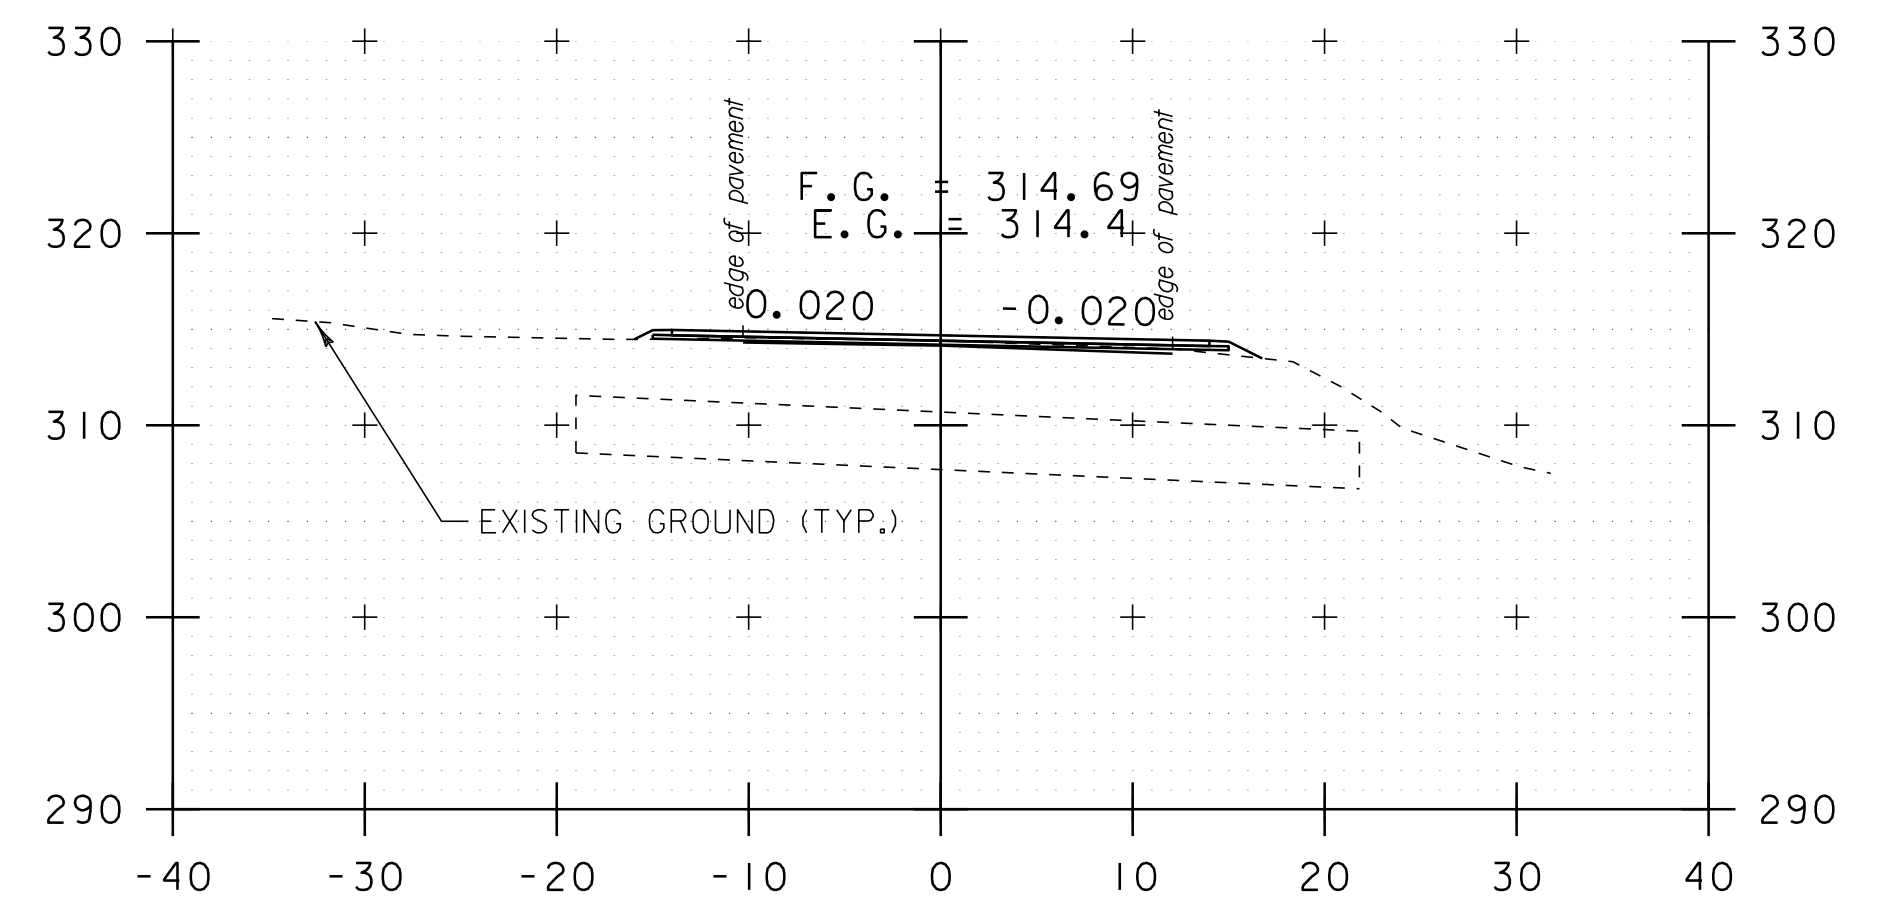

d 172+41

DATUM	NAVD 88
	NAD 83

STA. d 169+55 TO STA. d 173+85

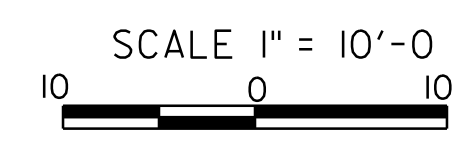

CROSS SECTION SHEET 53

PROJECT NAME:	ADDISON-NEW HAVEN
PROJECT NUMBER:	STP 9632(1)
FILE NAME:	p95B076.dgn
PROJECT LEADER:	CDL
DESIGNED BY:	SJL
PLOT FILE:	p95B076_158.1
PLOT DATE:	3/13/2012
DRAWN BY:	SJL
CHECKED BY:	EPD
SHEET	158 OF 186