


d 182+13


END PROJECT
MATCH EXISTING

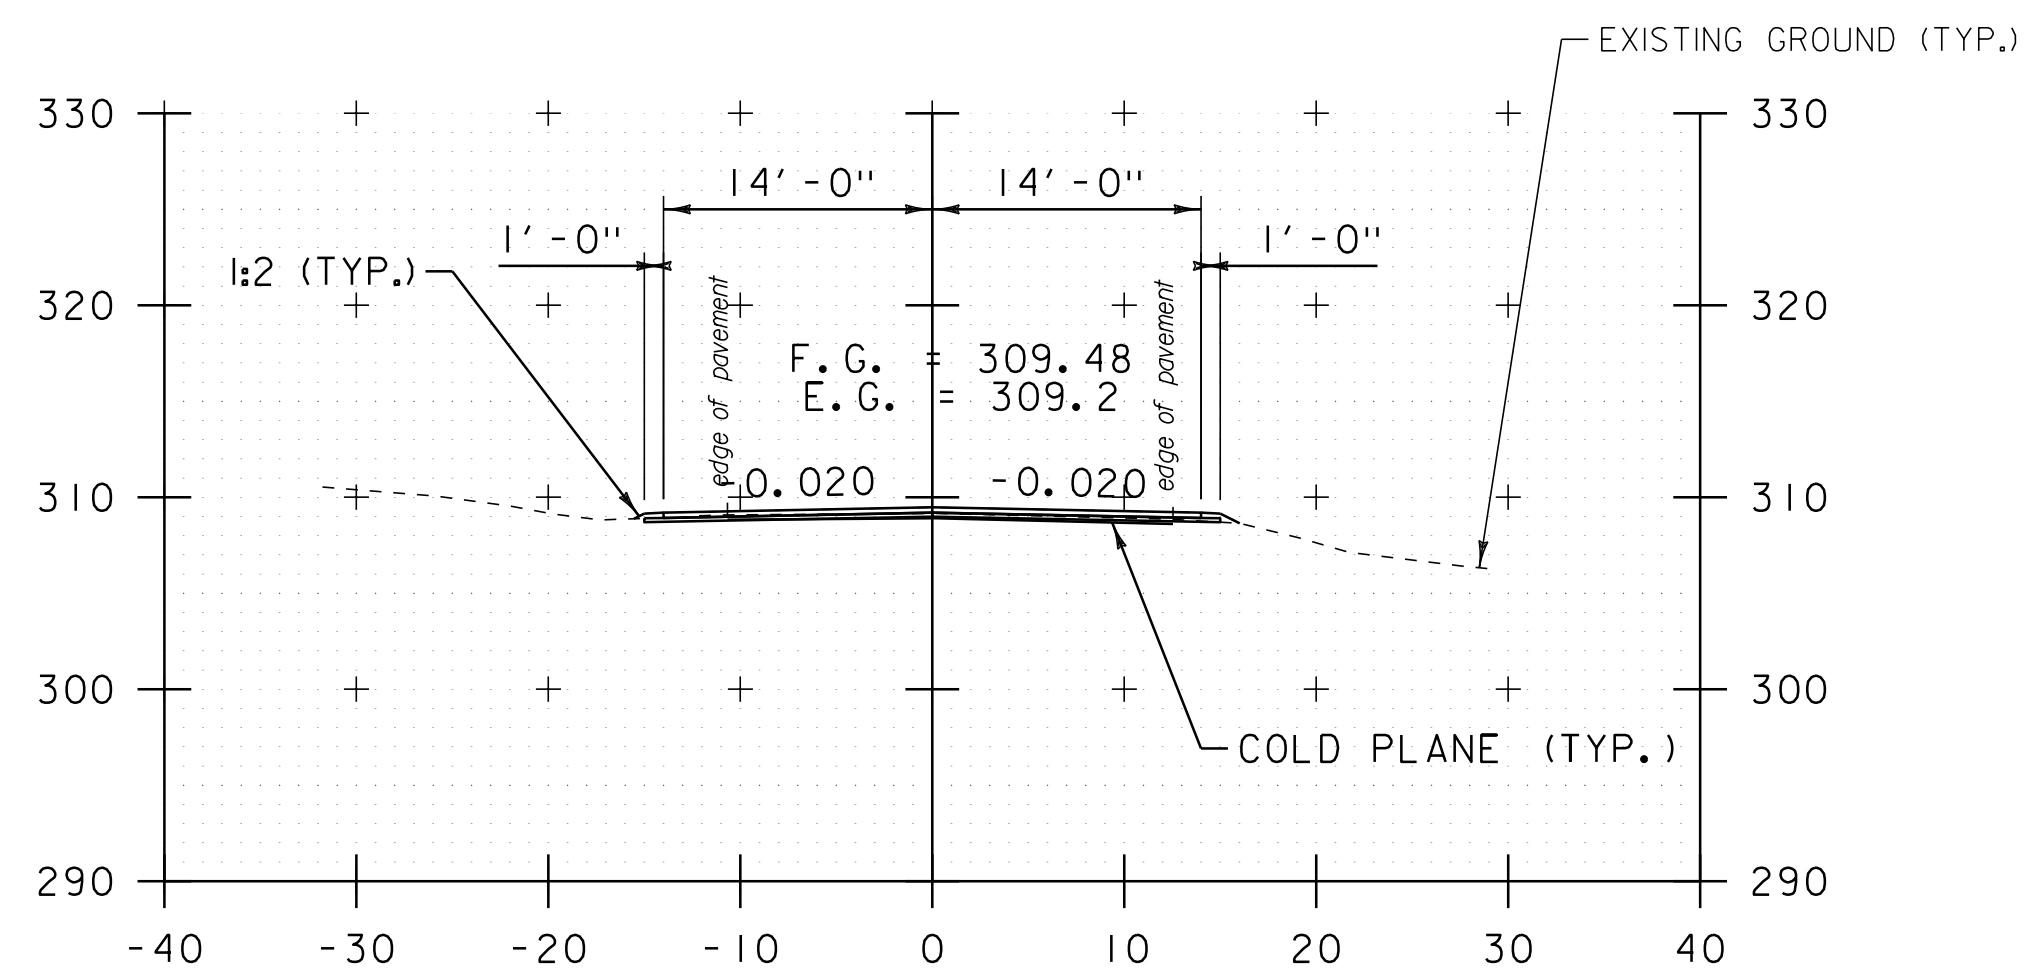

d 174+00

STA. d 174+00 TO STA. d 174+00

DATUM	NAVD 88
	NAD 83

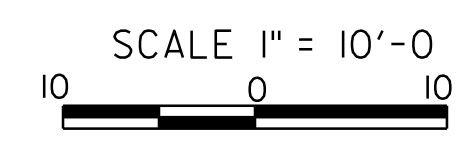

**CROSS
SECTION
SHEET 54**

PROJECT NAME: ADDISON-NEW HAVEN
PROJECT NUMBER: STP 9632(1)

FILE NAME: p95B076.dgn	PLOT DATE: 3/13/2012
PROJECT LEADER: CDL	DRAWN BY: SJL
DESIGNED BY: SJL	CHECKED BY: EPD
PLOT FILE: p95B076_159.1	SHEET 159 OF 186