

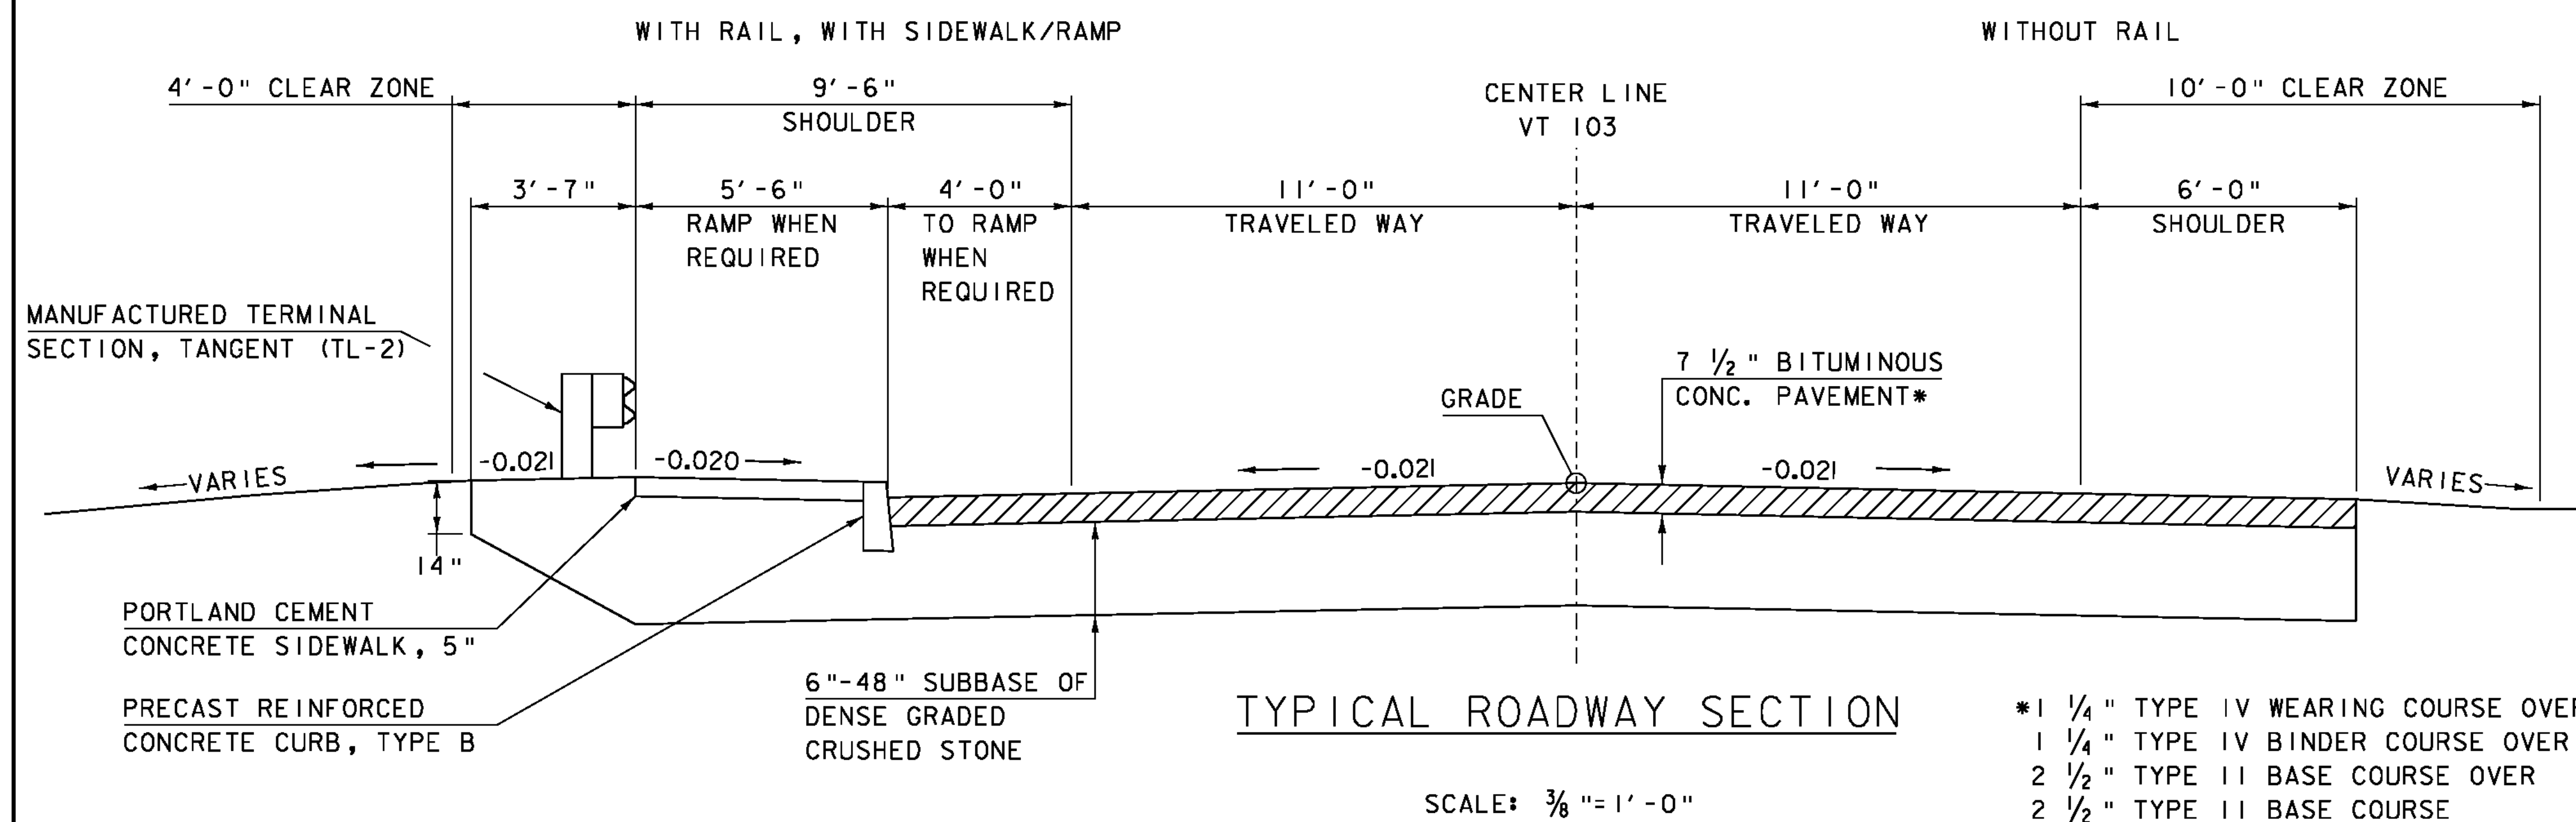
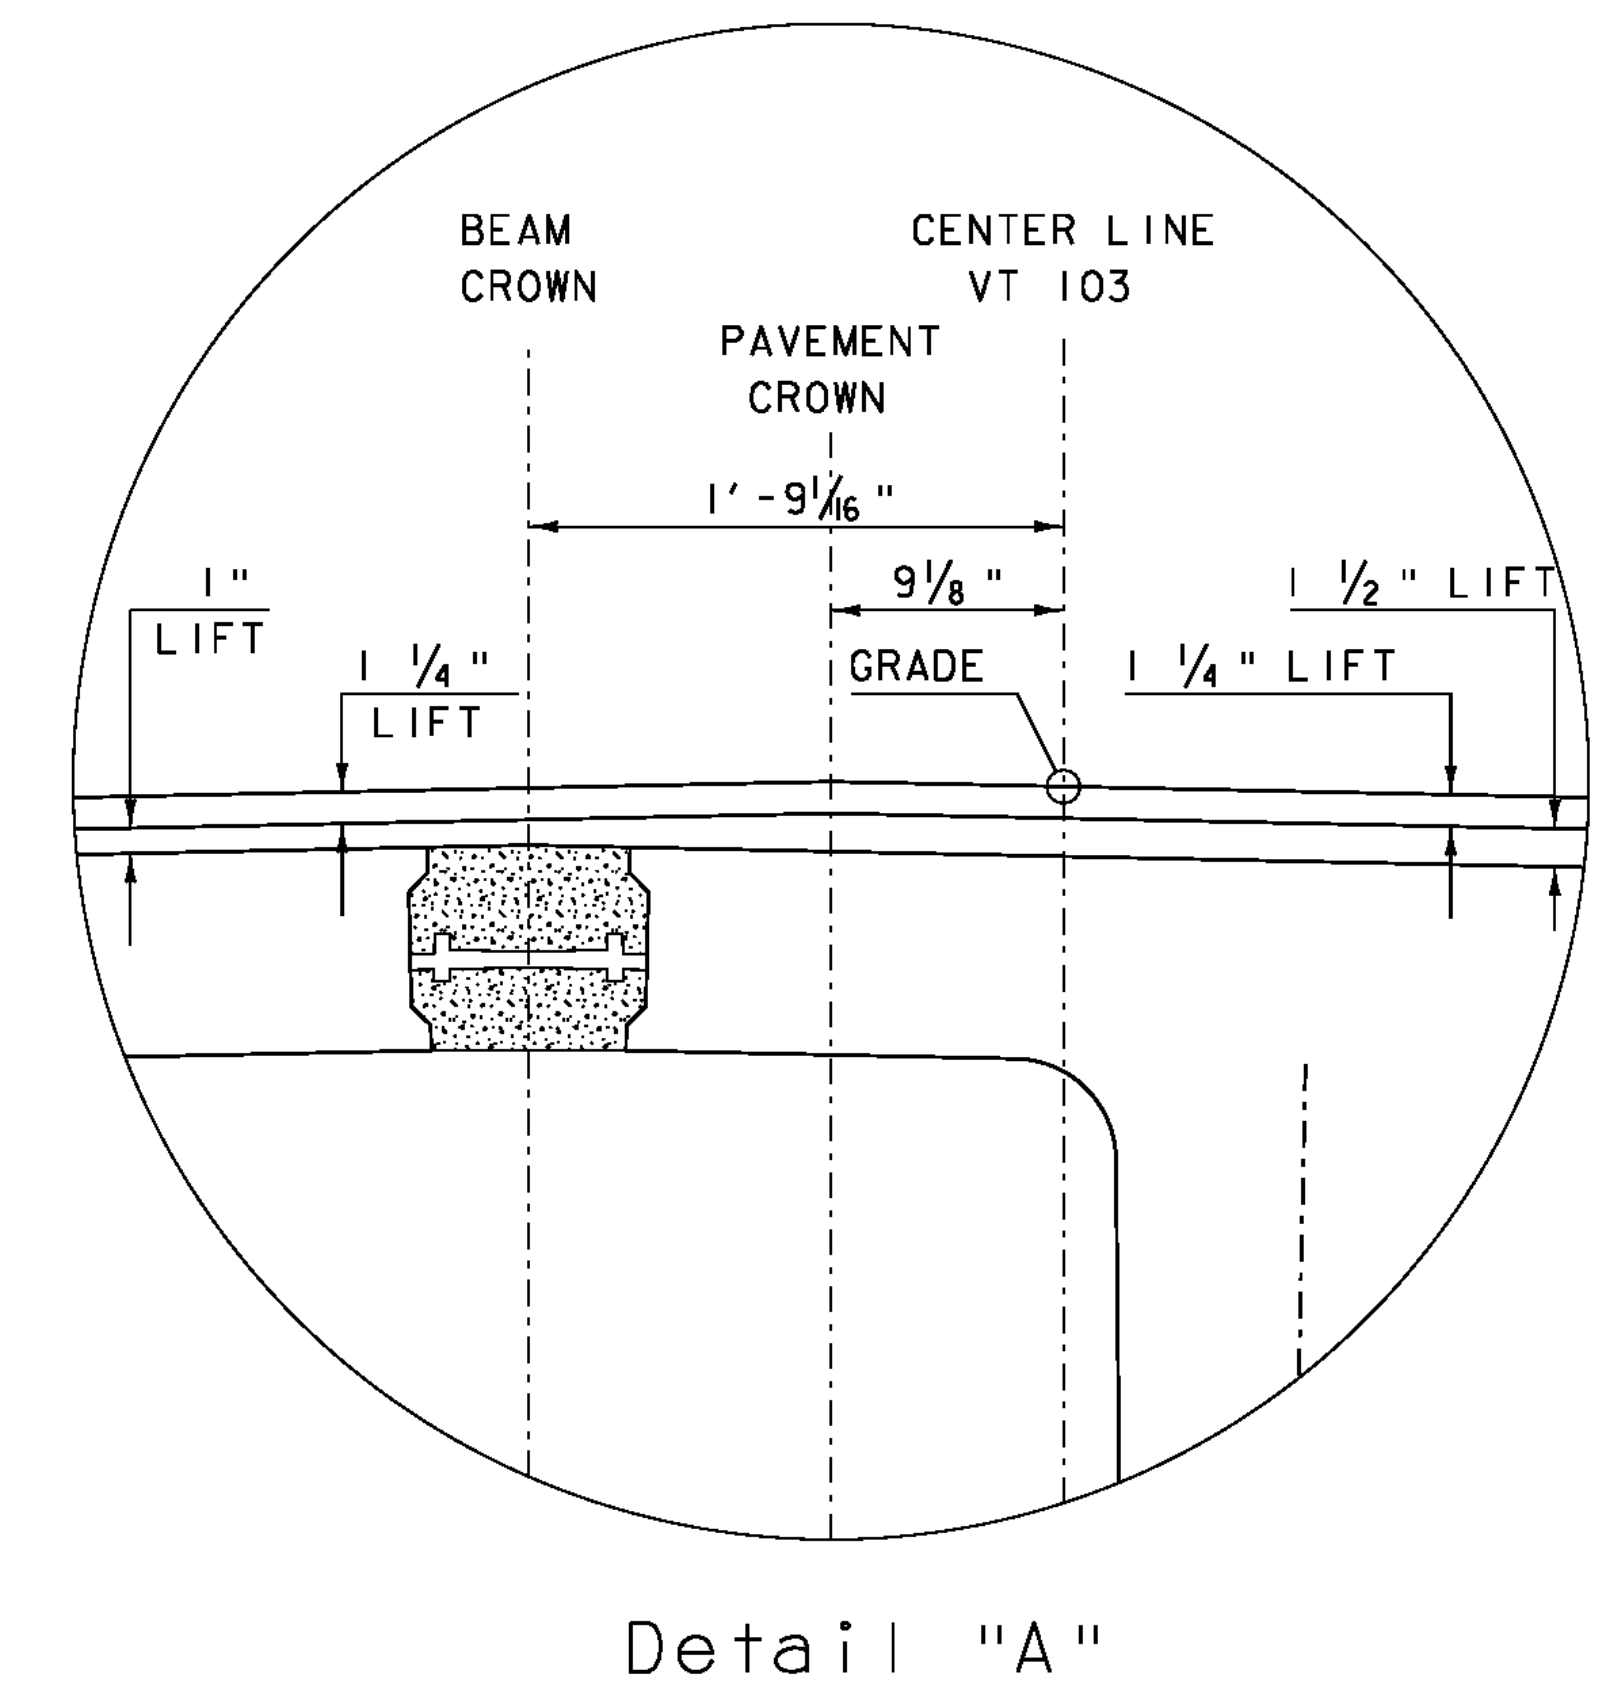


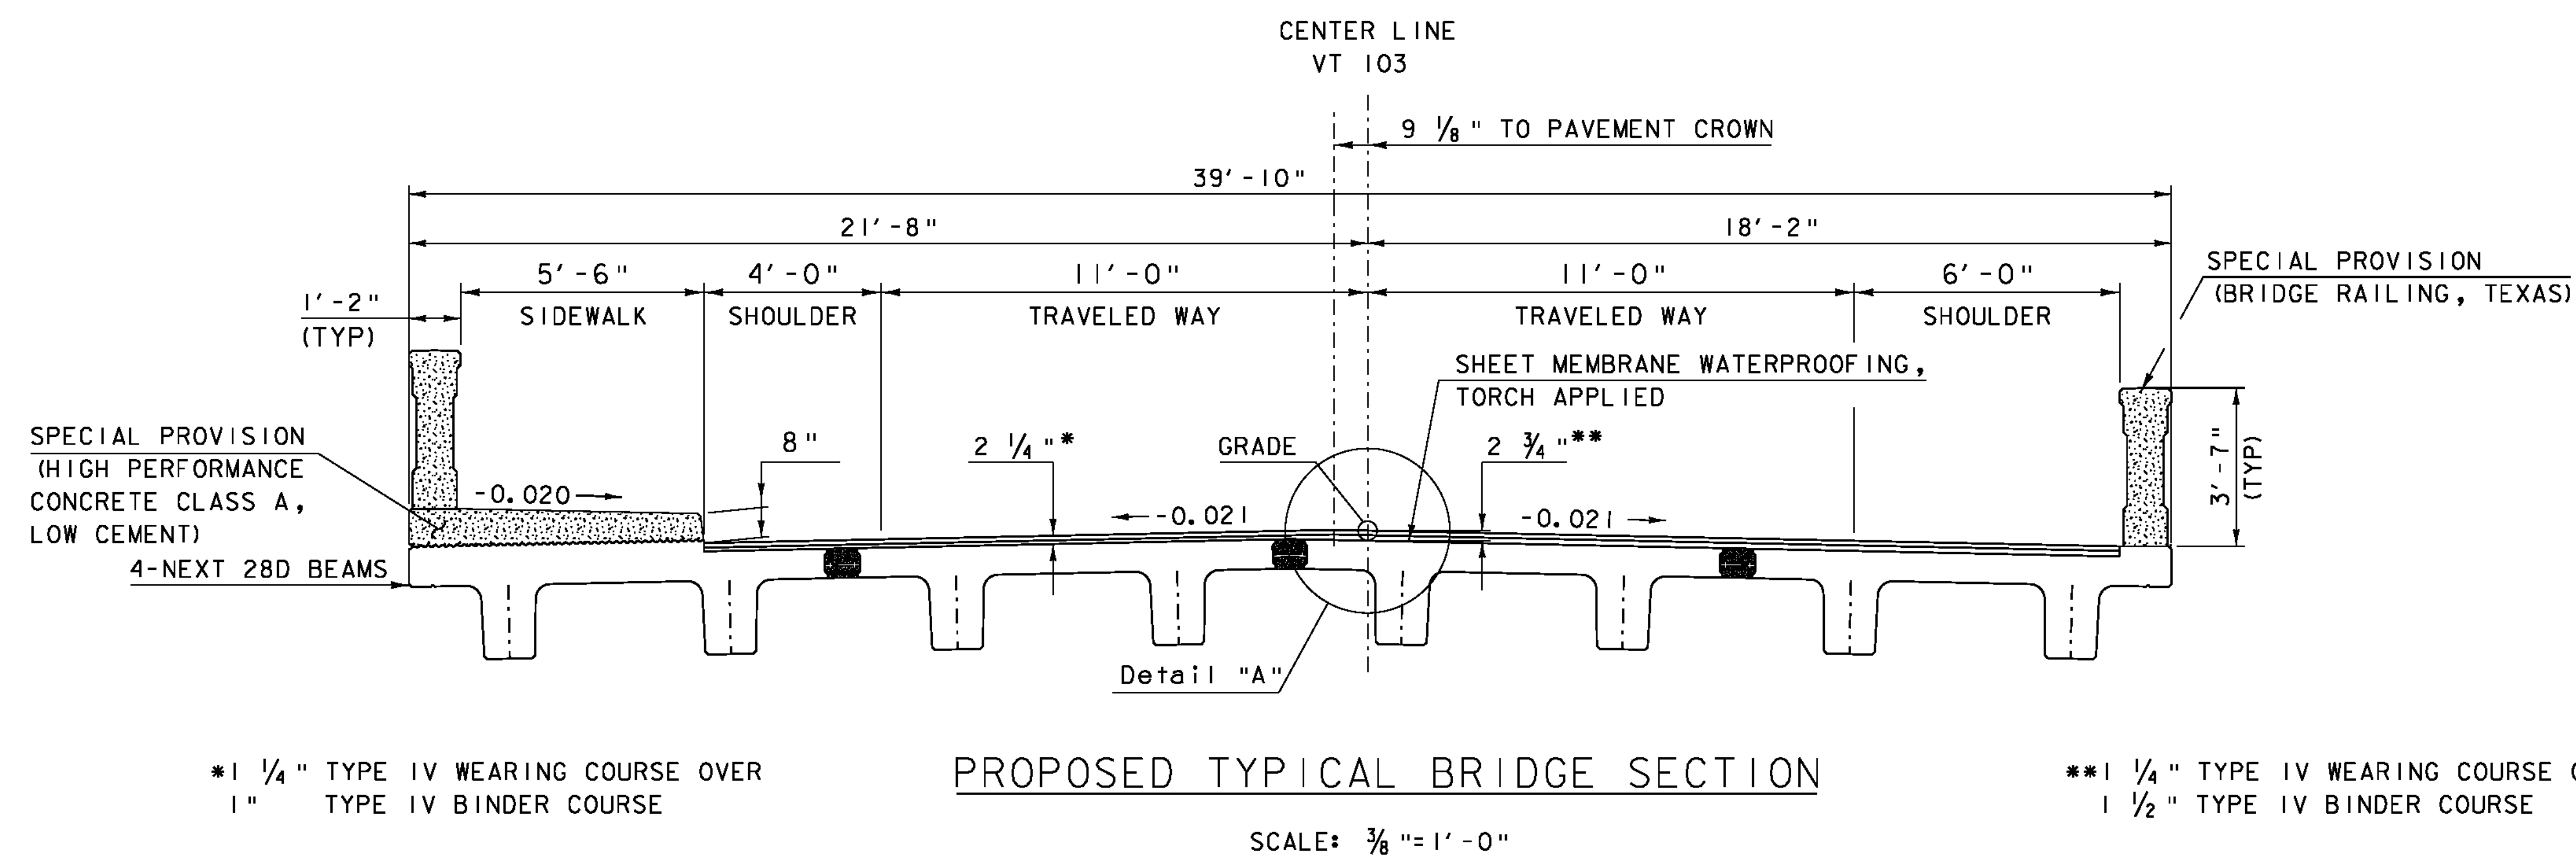

```
*1 1/4 " TYPE IV WEARING COURSE OVER
1 1/4 " TYPE IV BINDER COURSE OVER
2 1/2 " TYPE II BASE COURSE OVER
2 1/2 " TYPE II BASE COURSE
```

NOTE:
PAVEMENT SHALL BE A MARSHALL MIX PAID
FOR UNDER THE ITEM 406.25, "BITUMINOUS CONCRETE PAVEMENT".

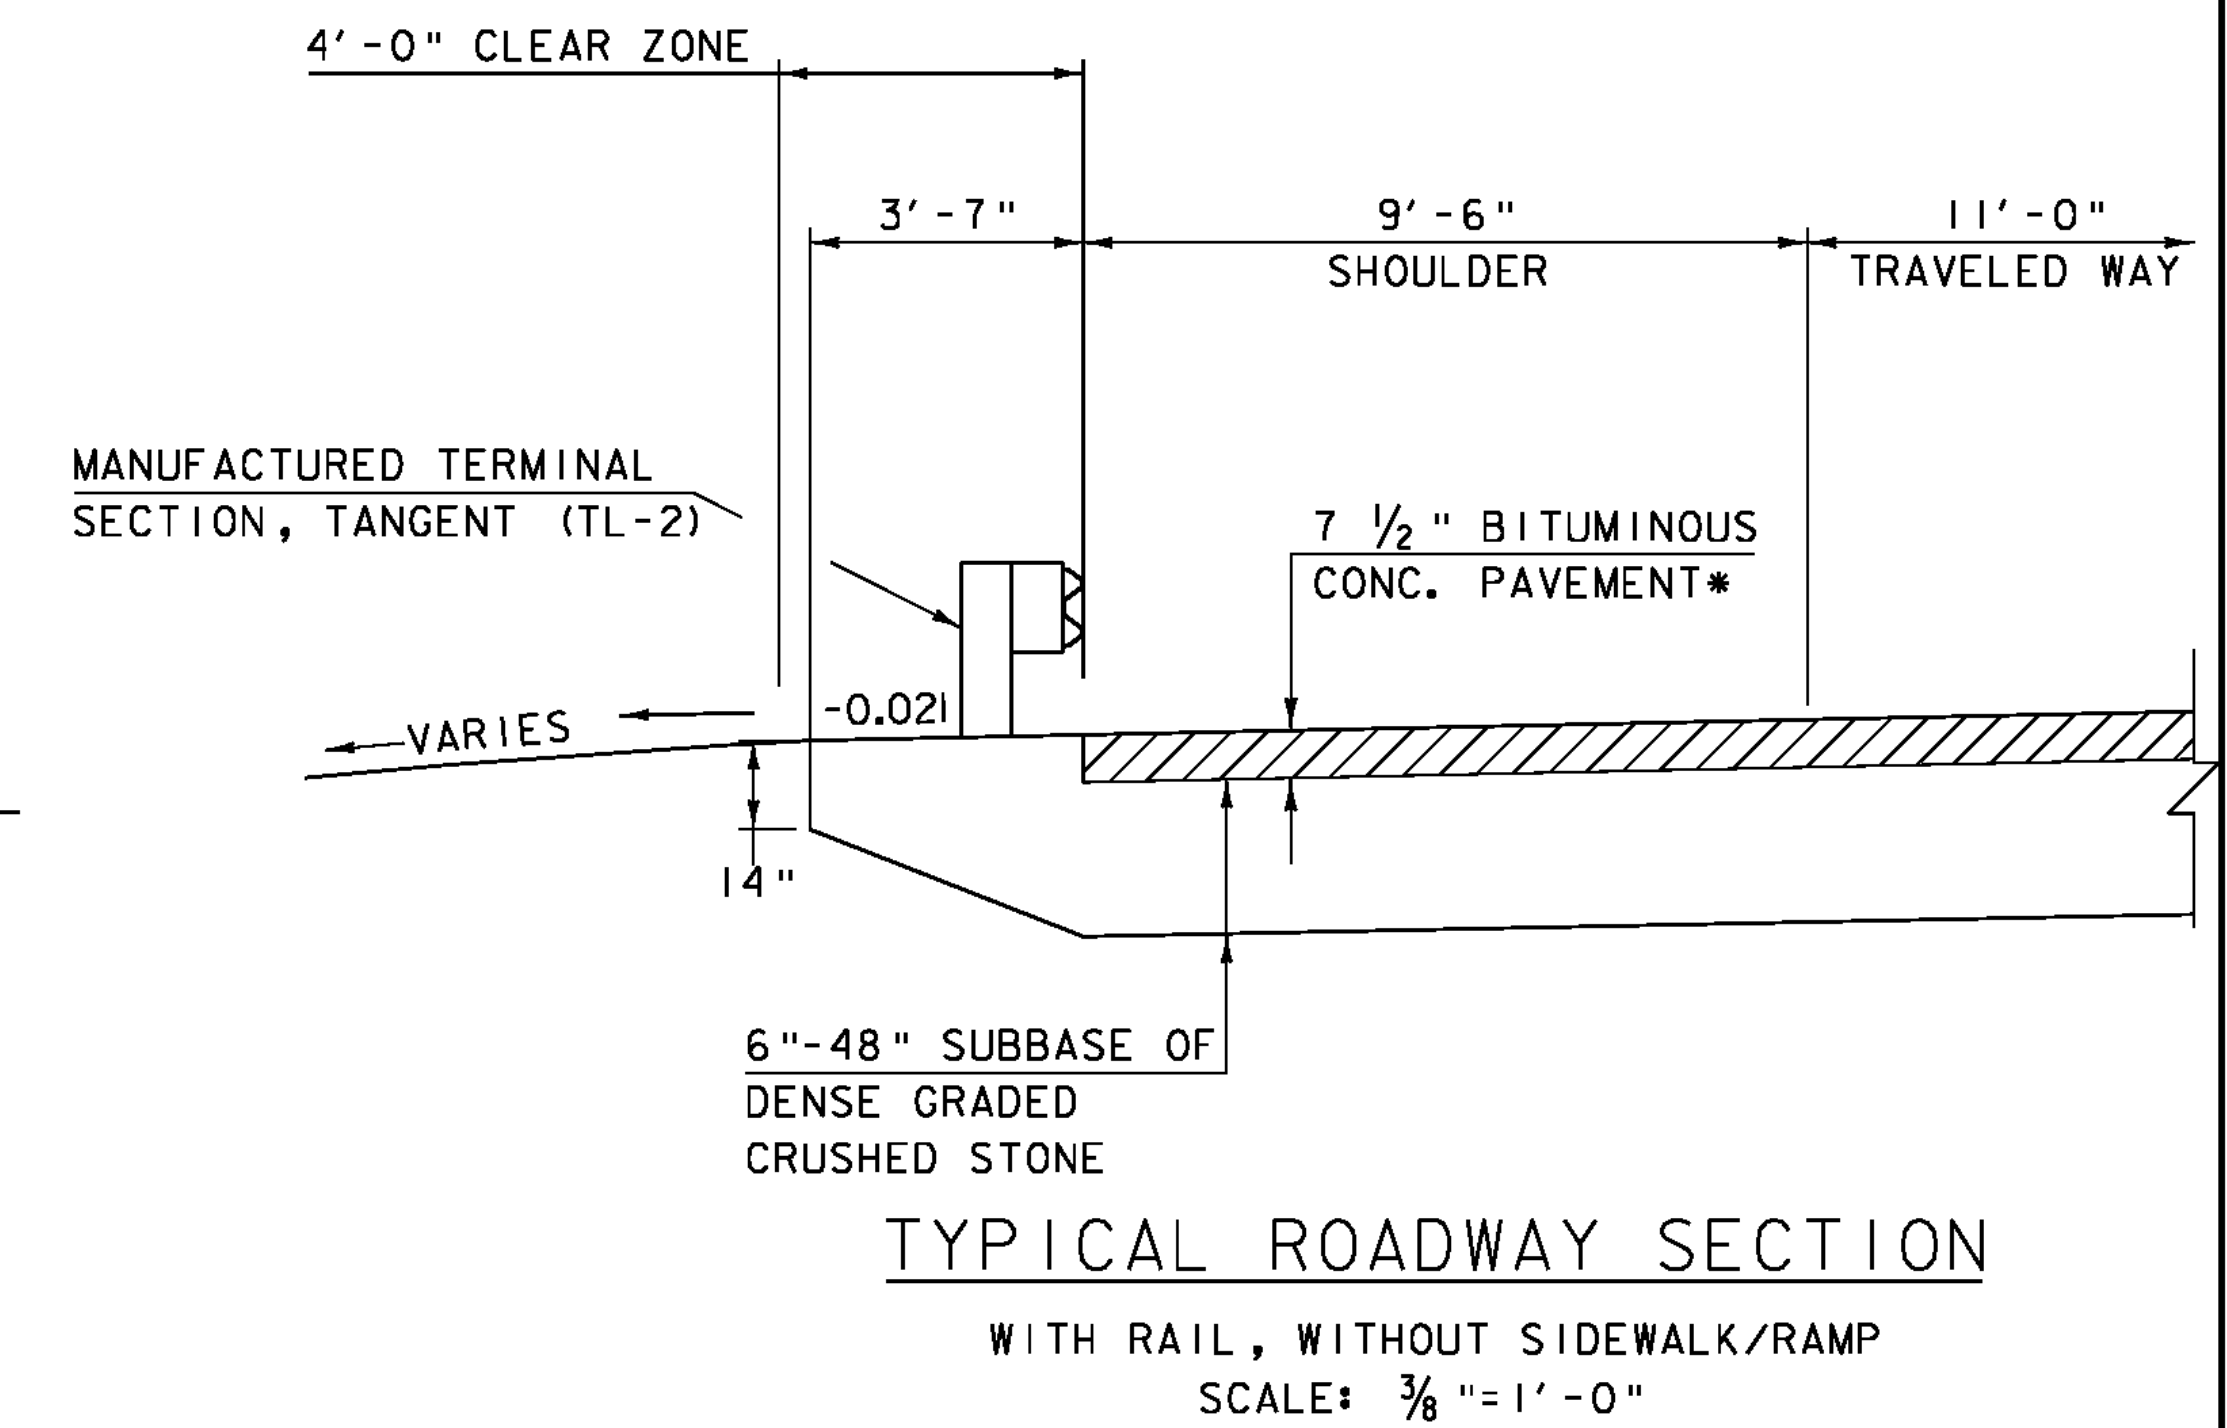

MATERIAL TOLERANCES
(IF USED ON PROJECT)

SURFACE	
- PAVEMENT (TOTAL THICKNESS)	+/- 1/4 "
- AGGREGATE SURFACE COURSE	+/- 1/2 "
SUBBASE	+/- 1 "
SAND BORROW	+/- 1 "

SCALE $\frac{3}{8}" = 1' - 0$

PROJECT NAME:	CHESTER
PROJECT NUMBER:	BRF 025-1(28)

FILE NAME: 84e061/Str/typ.dgn	PLOT DATE: 20-SEP-2010
PROJECT LEADER: C.P.WILLIAMS	DRAWN BY: M.FESSEL
DESIGNED BY: R.S.YOUNG	CHECKED BY: R.S.YOUNG
BRIDGE 8 TYPICAL SECTIONS	SHEET 15 OF 124