



VT103 PROFILE

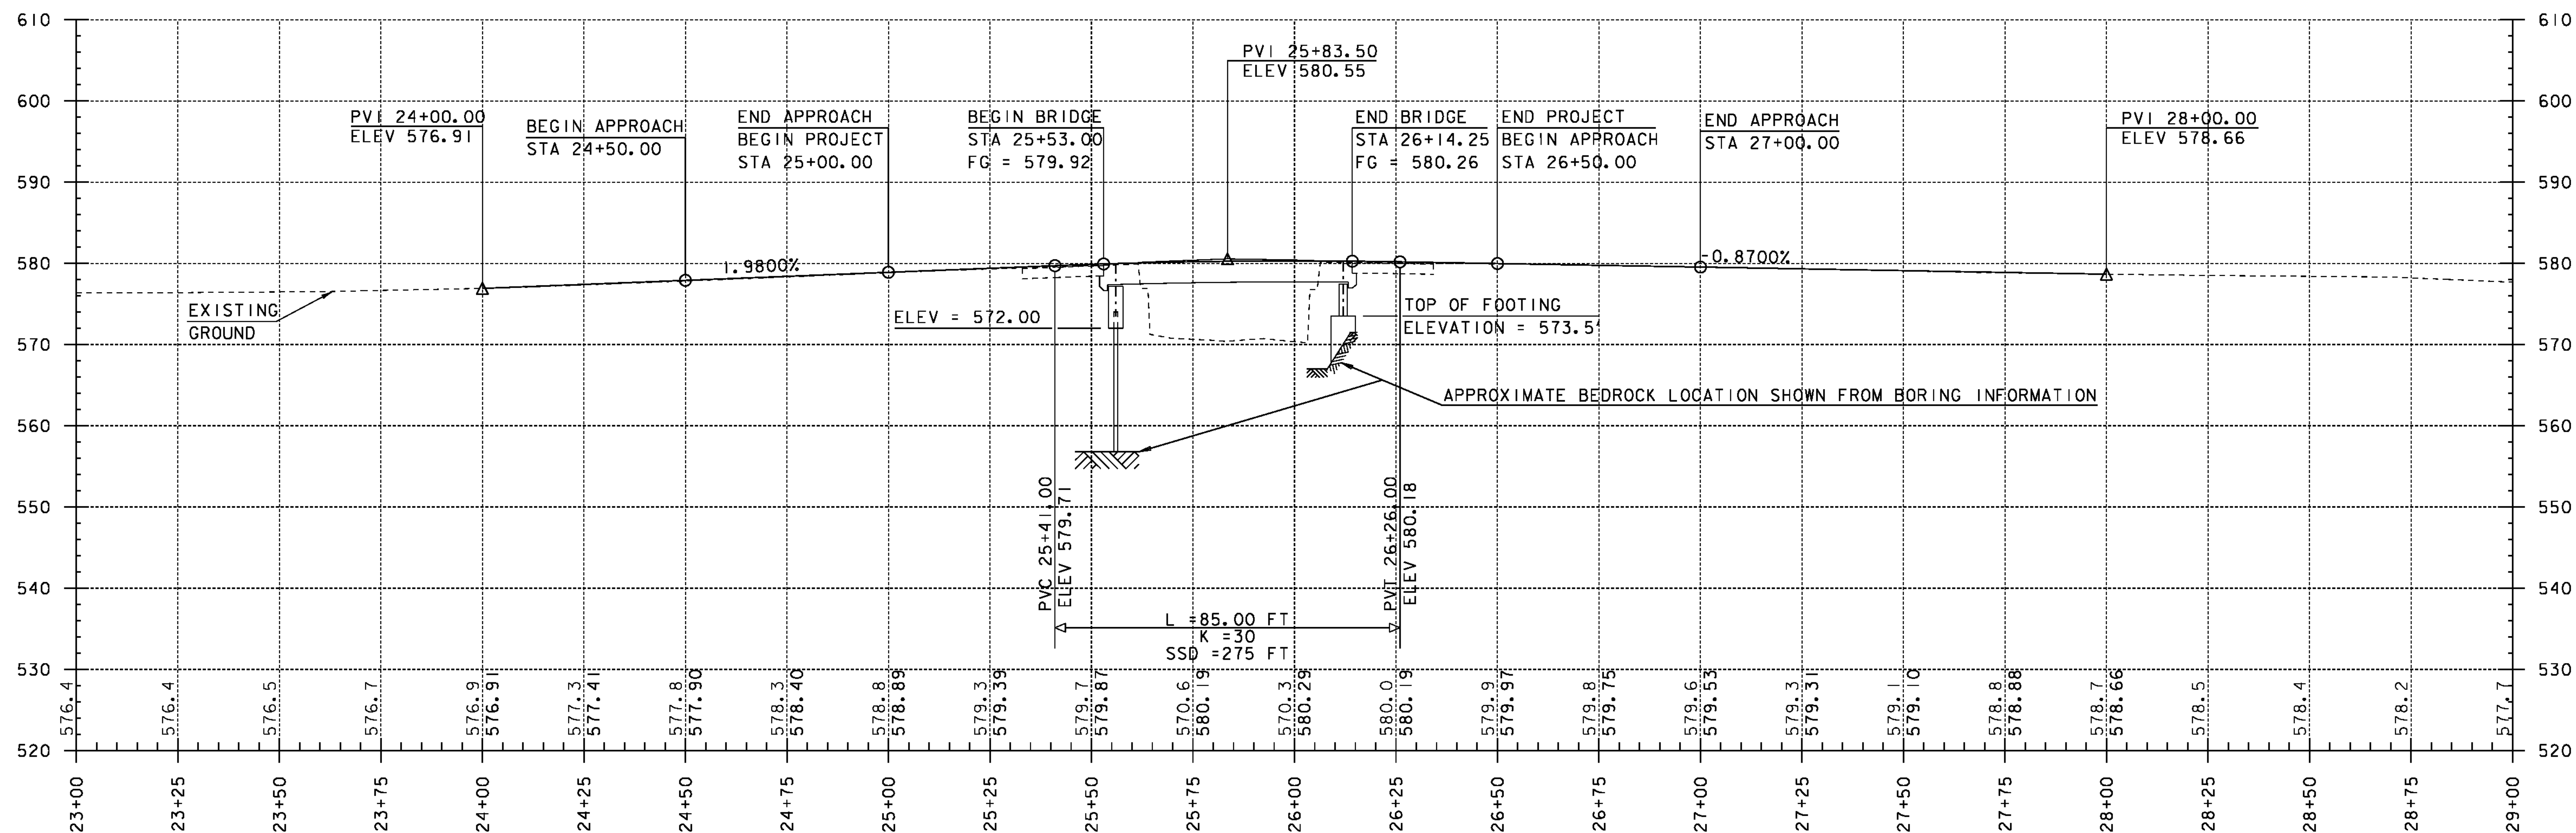

NOTES:


GRADES SHOWN TO THE NEAREST TENTH
ARE EXISTING GROUND ALONG C.

GRADES SHOWN TO THE NEAREST
HUNDREDTH ARE FINISH GRADE ALONG C.

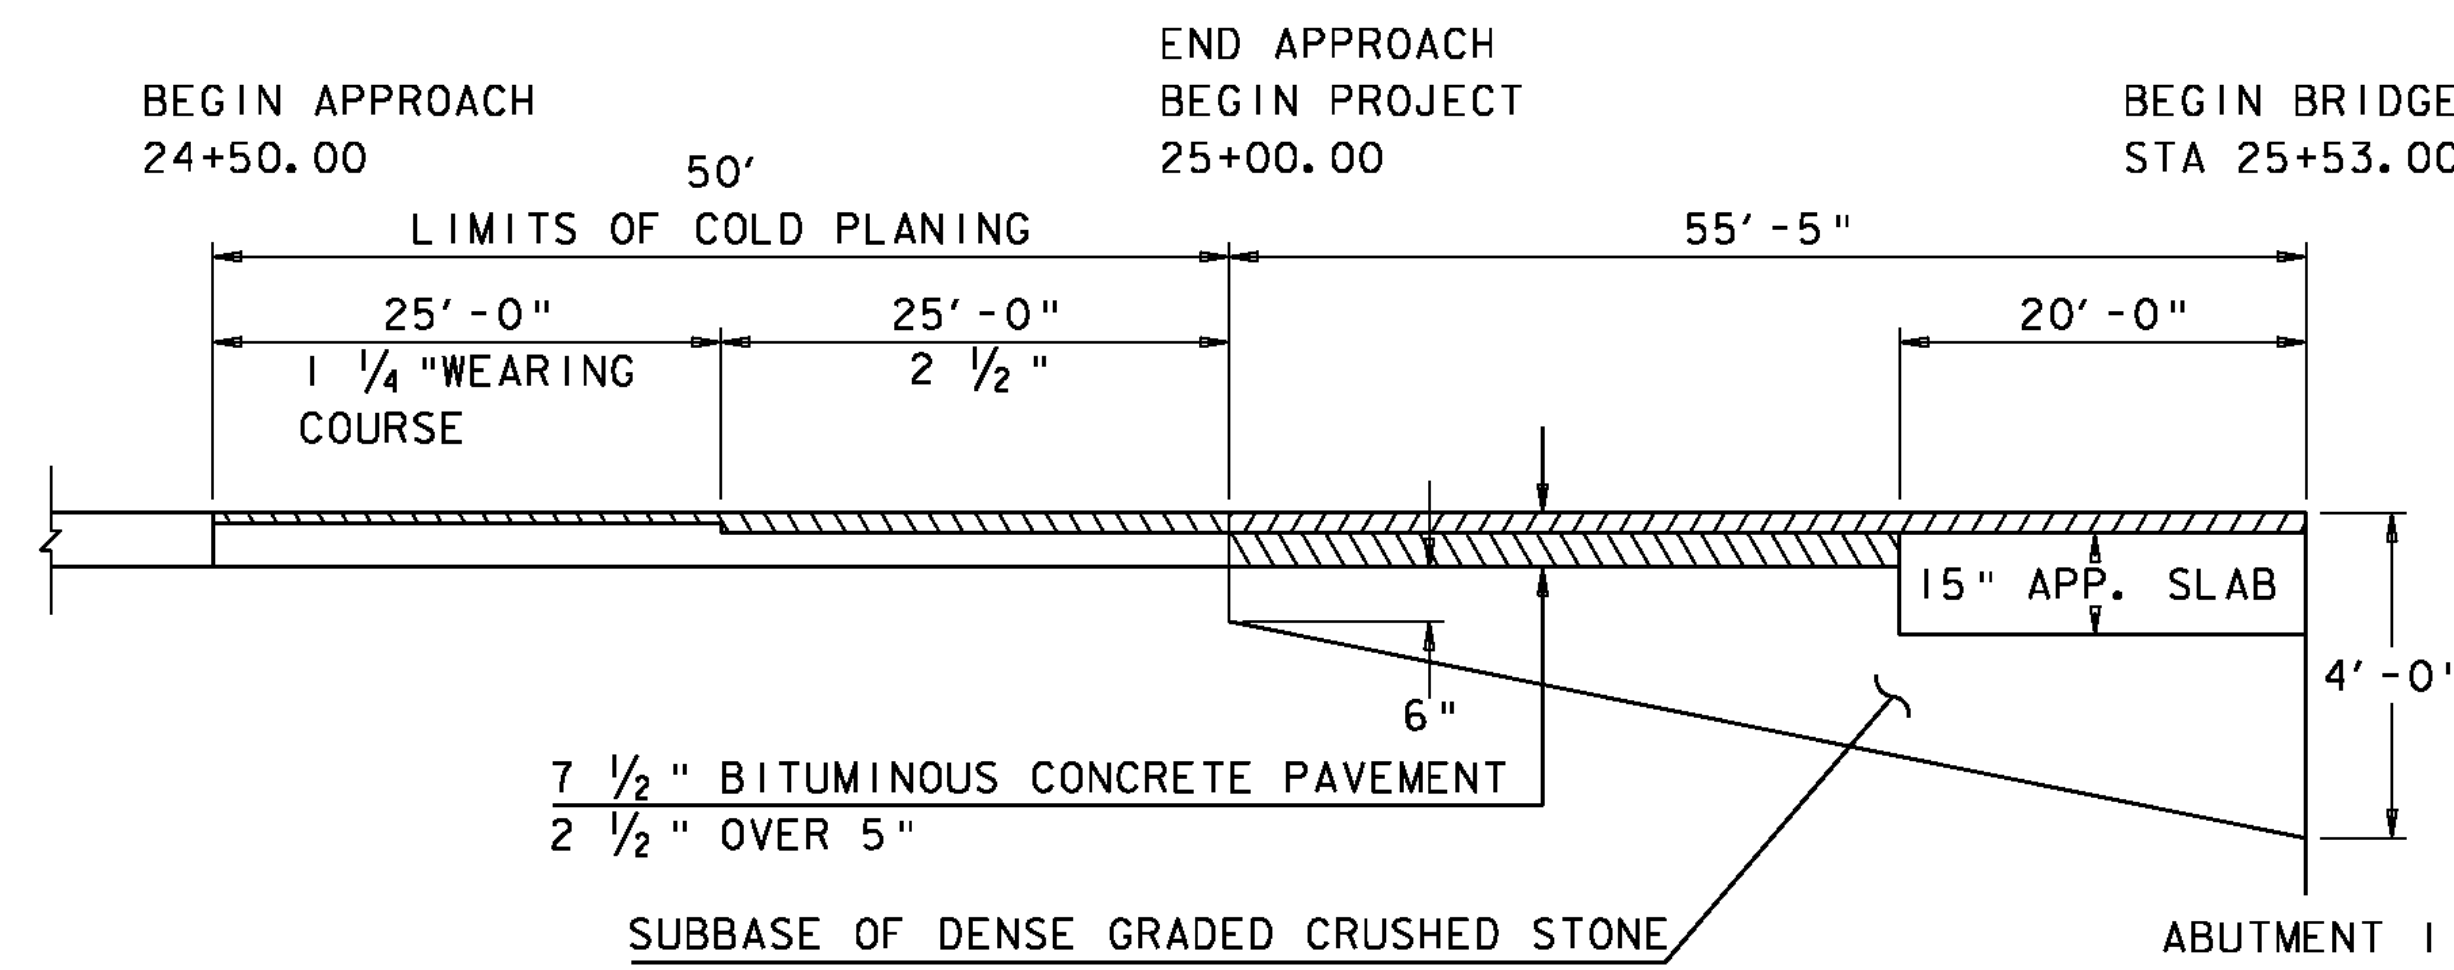


BEGIN PROJECT MATERIAL TRANSITION

NOT TO SCALE

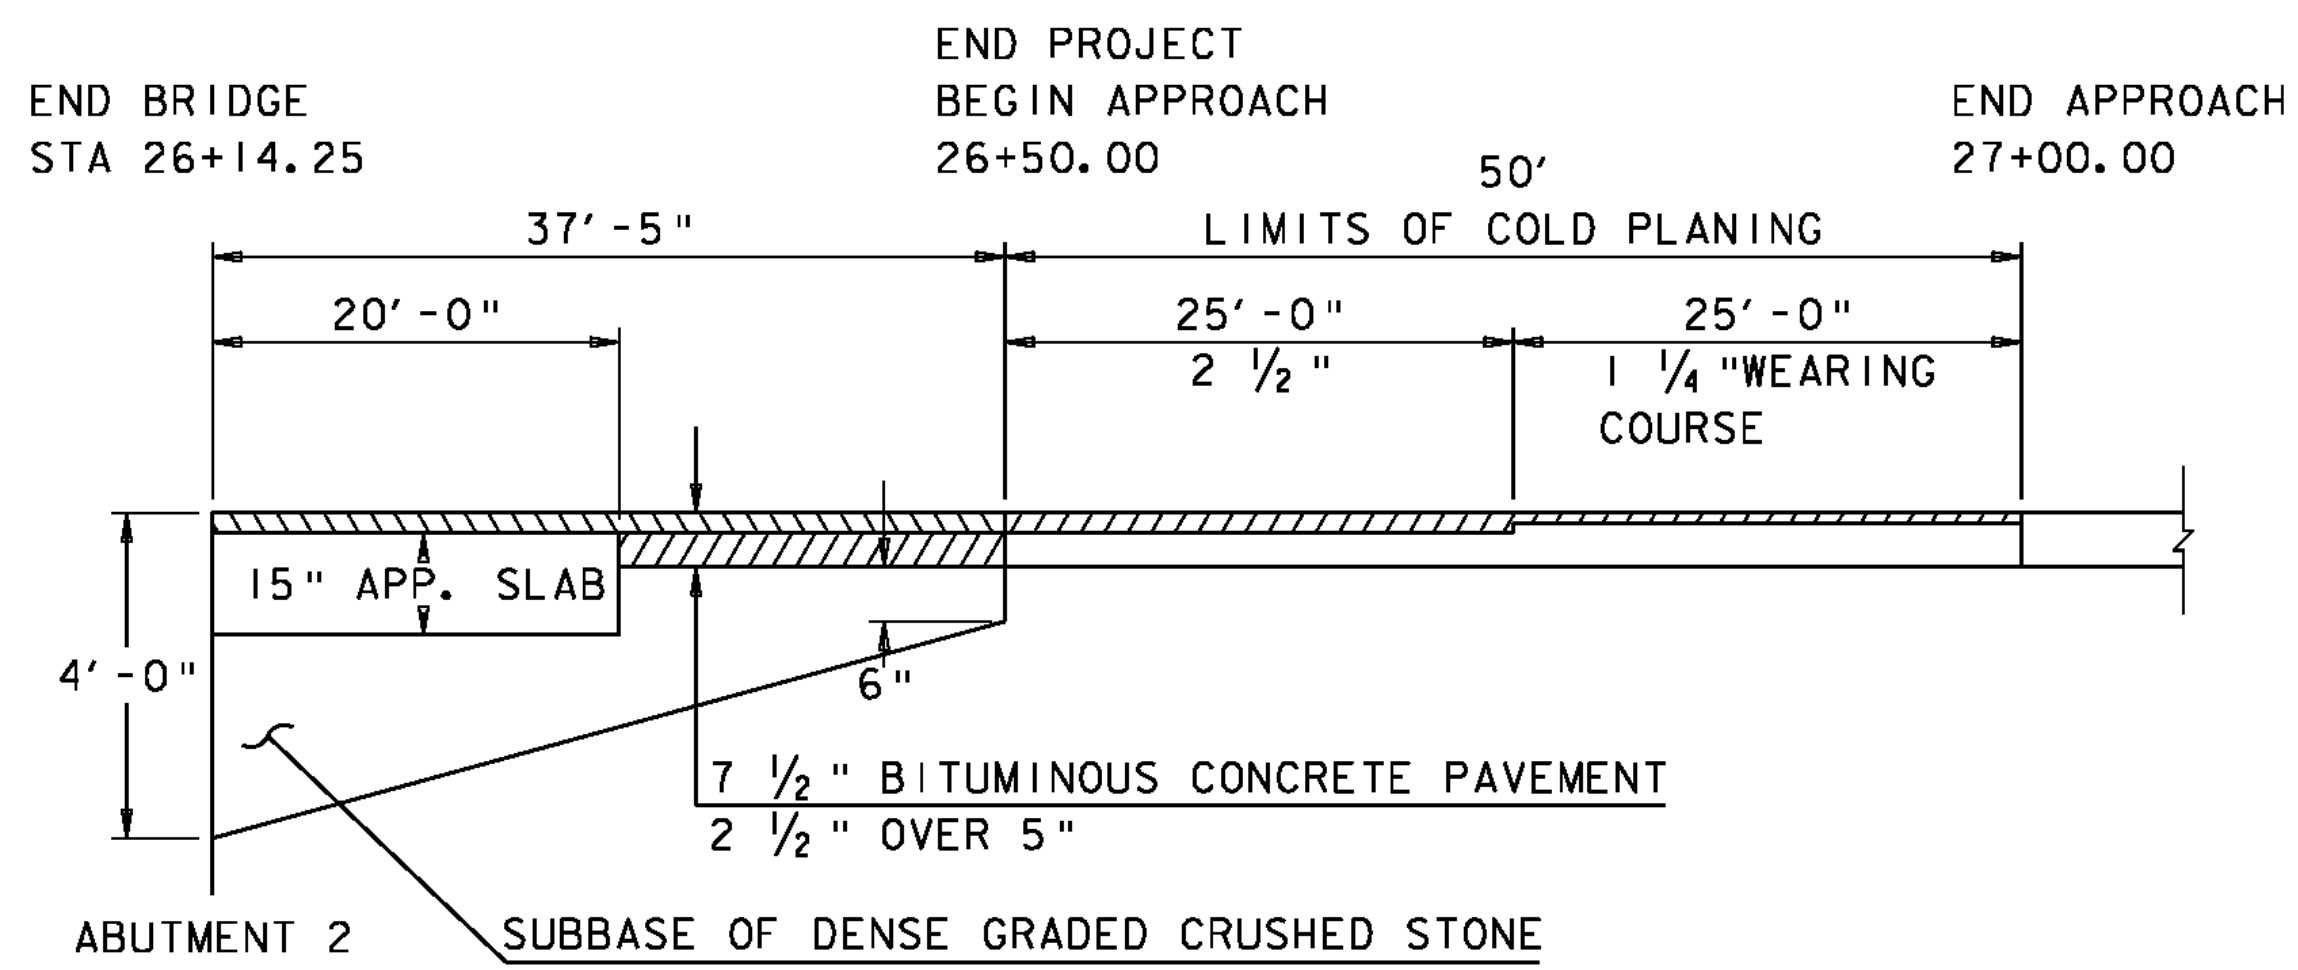

END PROJECT MATERIAL TRANSITION

NOT TO SCALE

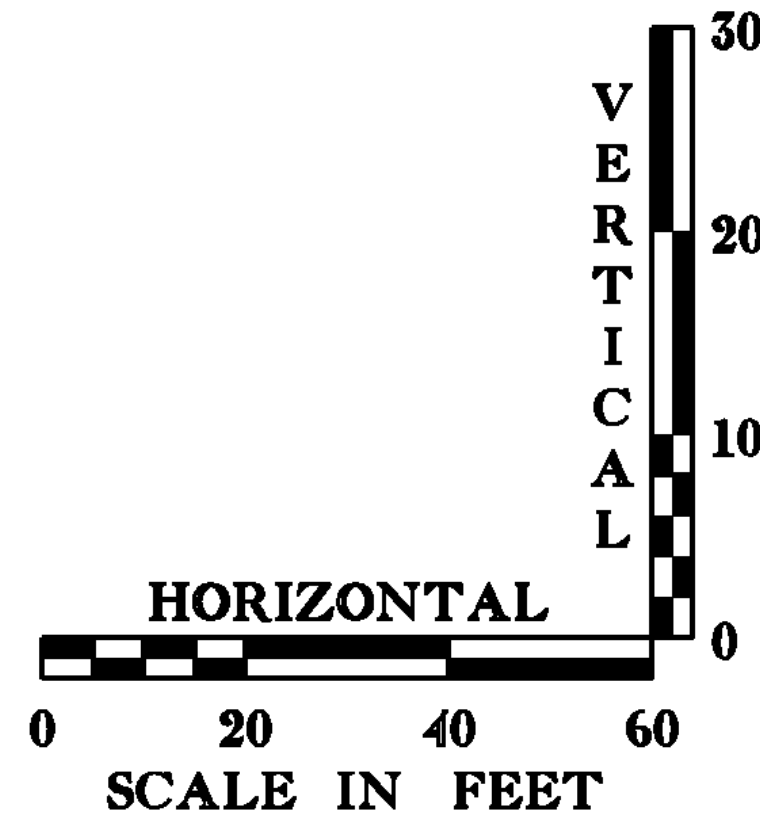

PROJECT NAME:	CHESTER	PLOT DATE:	20-SEP-2010
PROJECT NUMBER:	BRF 025-1(28)	DRAWN BY:	M.FESSEL
FILE NAME:	84e061/Str/s84e061pro.dgn	CHECKED BY:	R.S.YOUNG
PROJECT LEADER:	C.P.WILLIAMS	SHEET	19 OF 124
DESIGNED BY:	R.S.YOUNG		
BRIDGE 8 PROFILE SHEET			