



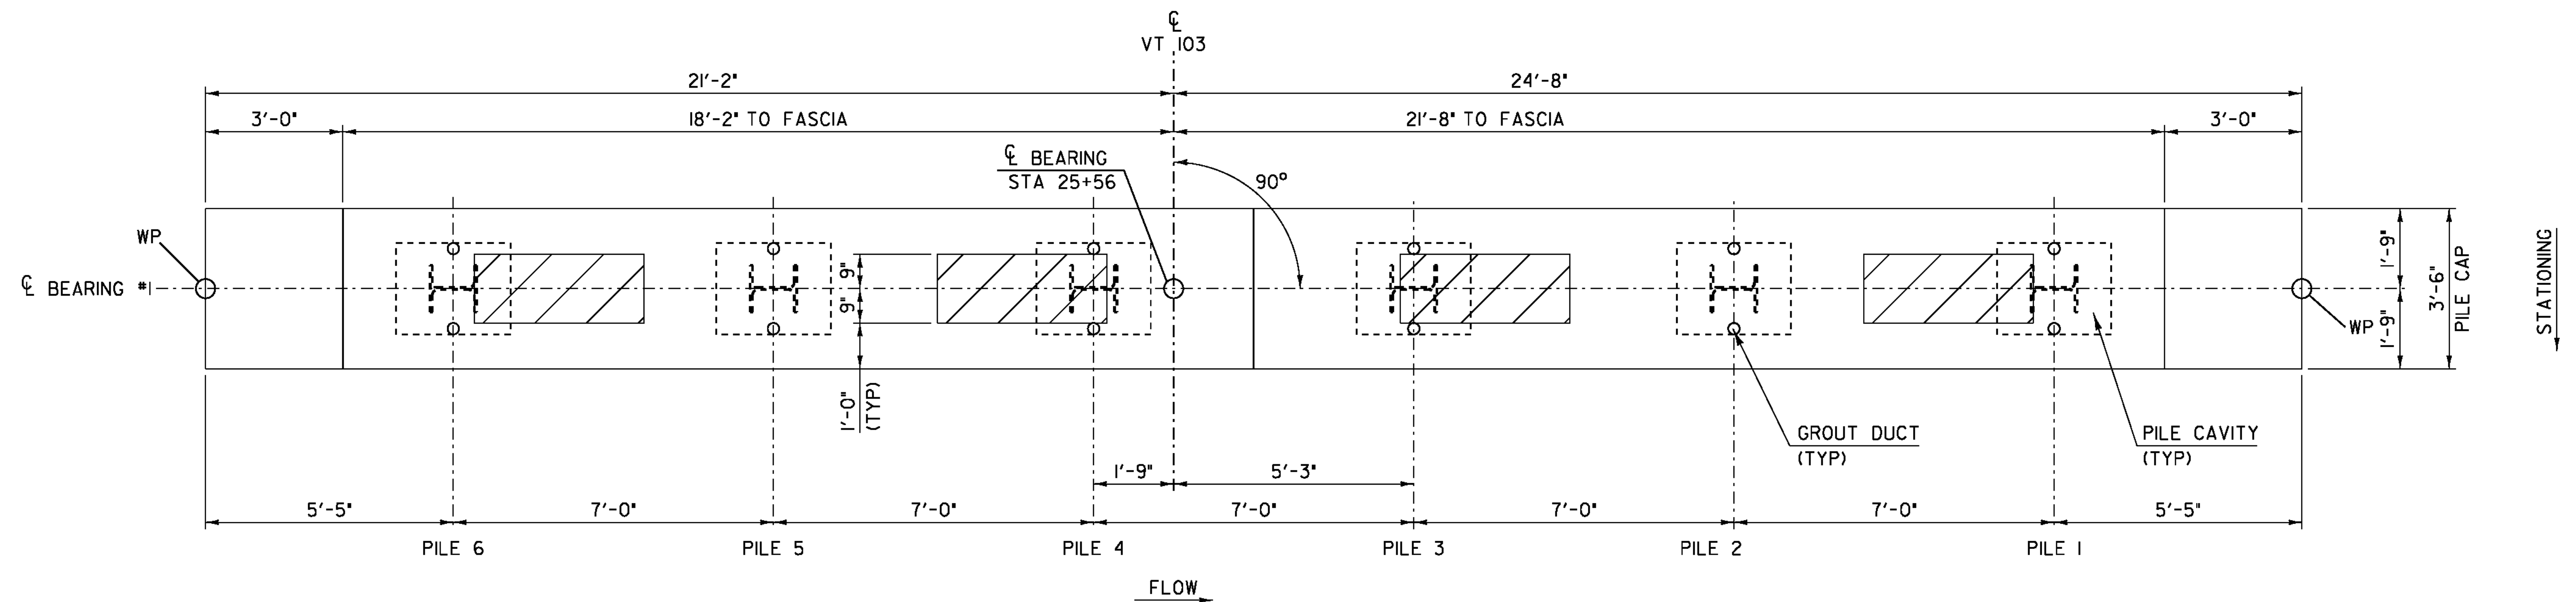

ABUTMENT I PLAN VIEW

SCALE $\frac{1}{2}" = 1'-0"$

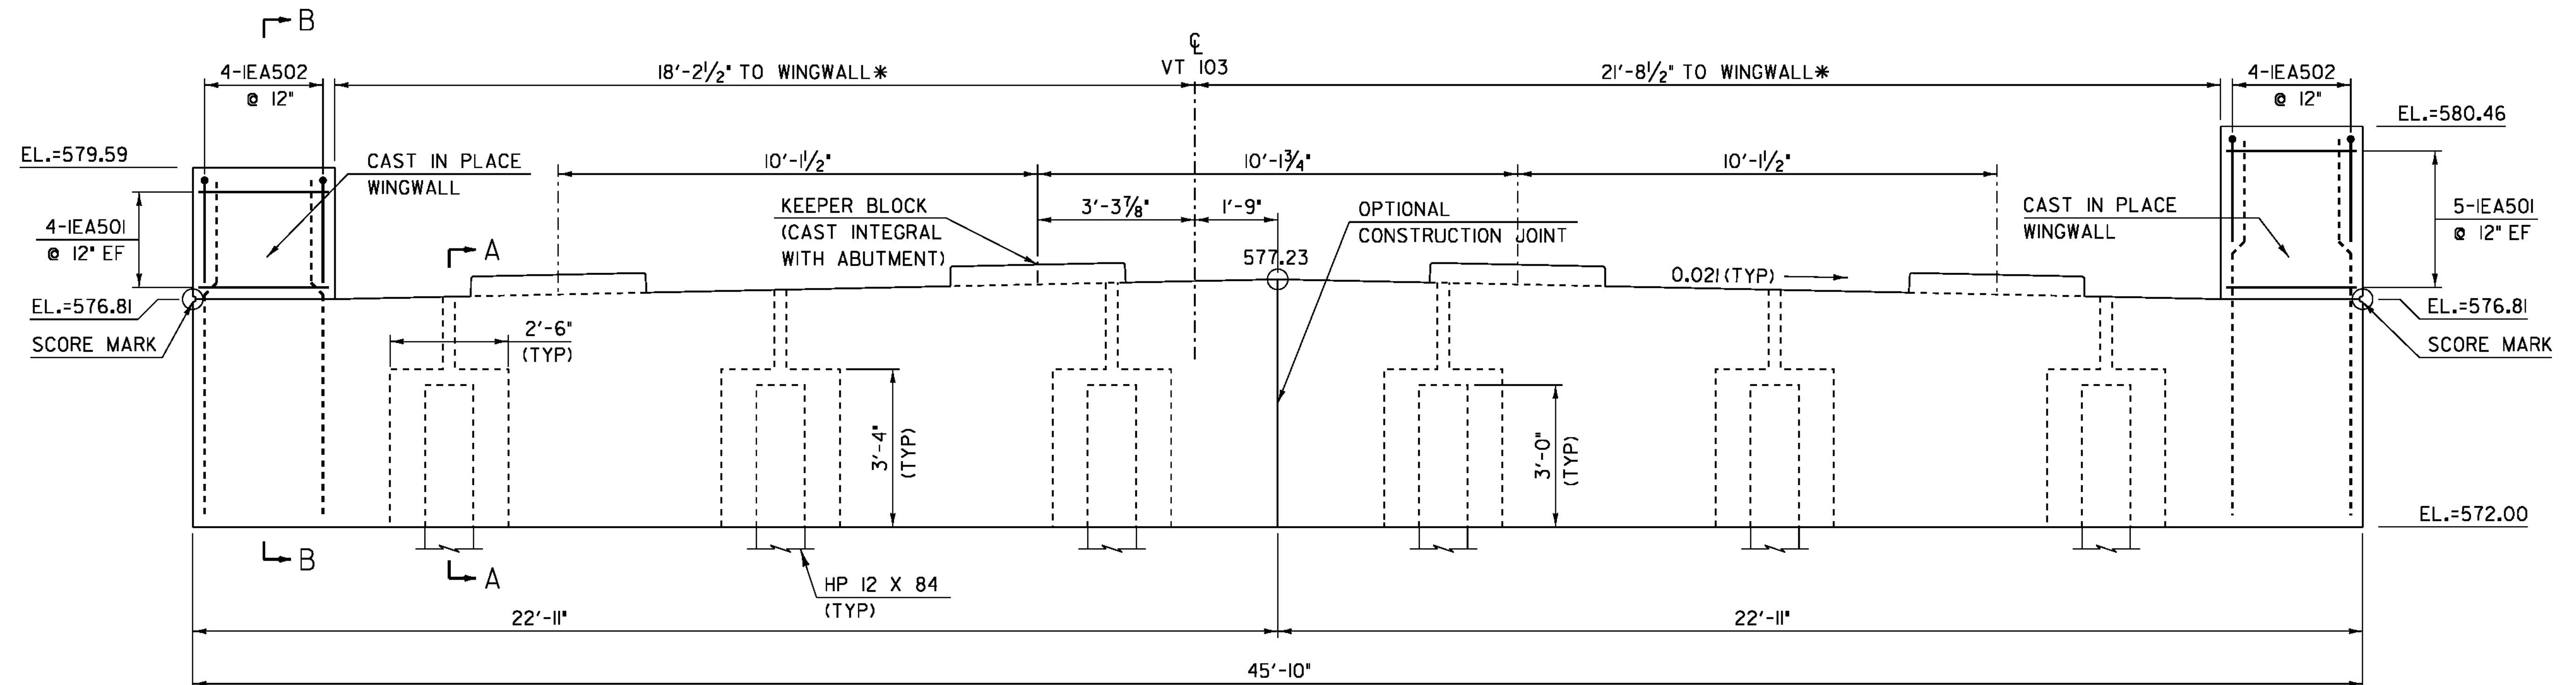

ABUTMENT I ELEVATION VIEW

SCALE $\frac{1}{2}" = 1'-0"$

SEE SHEET 34
FOR SECTIONS 'A-A' & 'B-B'

* PROVIDE $\frac{1}{2}"$ PREFORMED JOINT FILLER
BETWEEN FASCIA AND WINGWALLS

NOTE:

NF = NEAR FACE
FF = FAR FACE
EF = EACH FACE
▲ = CUT TO FIT IN FIELD
3" CLEAR, UNLESS OTHERWISE
SPECIFIED ON THE PLANS.
2'-2" BAR LAP UNLESS OTHERWISE
SPECIFIED ON THE PLANS.

SCALE $\frac{1}{2}" = 1'-0"$

PROJECT NAME: CHESTER
PROJECT NUMBER: BRF 025-1(28)

FILE NAME: 84e061/str/sub.dgn
PROJECT LEADER: C.P.WILLIAMS
DESIGNED BY: R.S.YOUNG
BRIDGE 8 ABUTMENT I DETAILS

PLOT DATE: 20-SEP-2010
DRAWN BY: M.FESSEL
CHECKED BY: R.S.YOUNG
SHEET 33 OF 124