


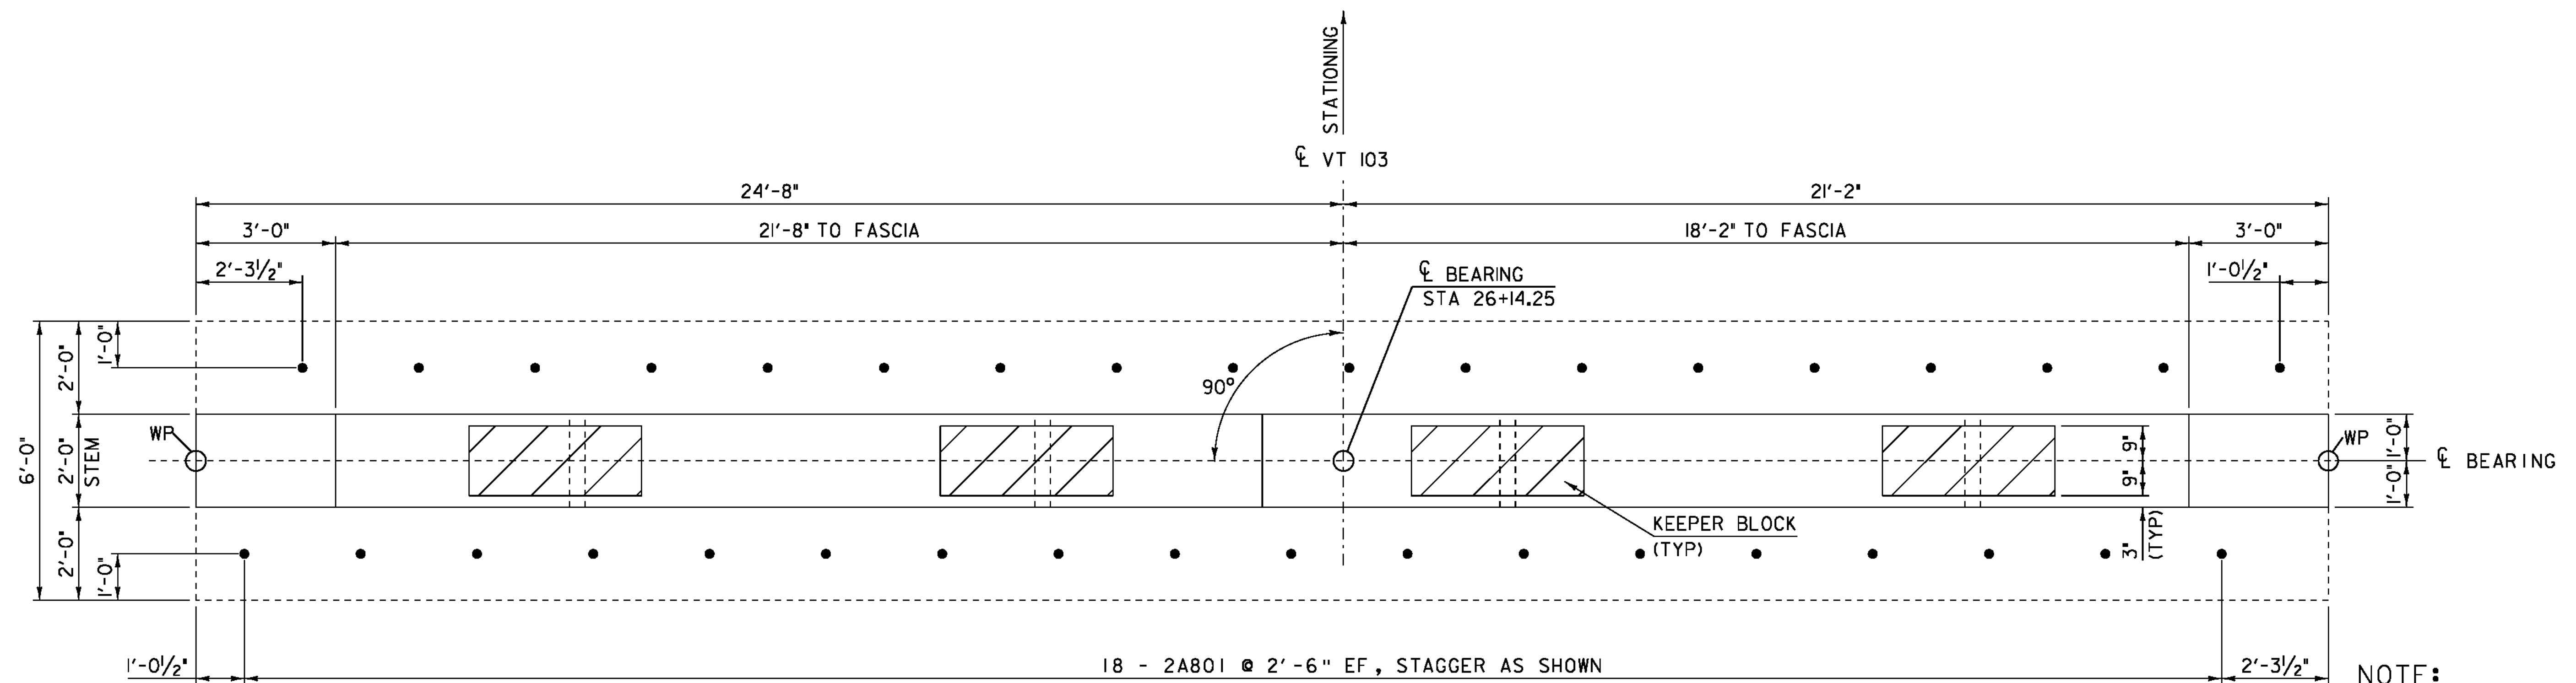


ABUTMENT 2 PLAN VIEW

SCALE 1/2" = 1'-0"

NOTE:

NF = NEAR FACE
FF = FAR FACE
EF = EACH FACE
▲ = CUT TO FIT IN FIELD
3" CLEAR, UNLESS OTHERWISE SPECIFIED ON THE PLANS.
2'-2" BAR LAP UNLESS OTHERWISE SPECIFIED ON THE PLANS.

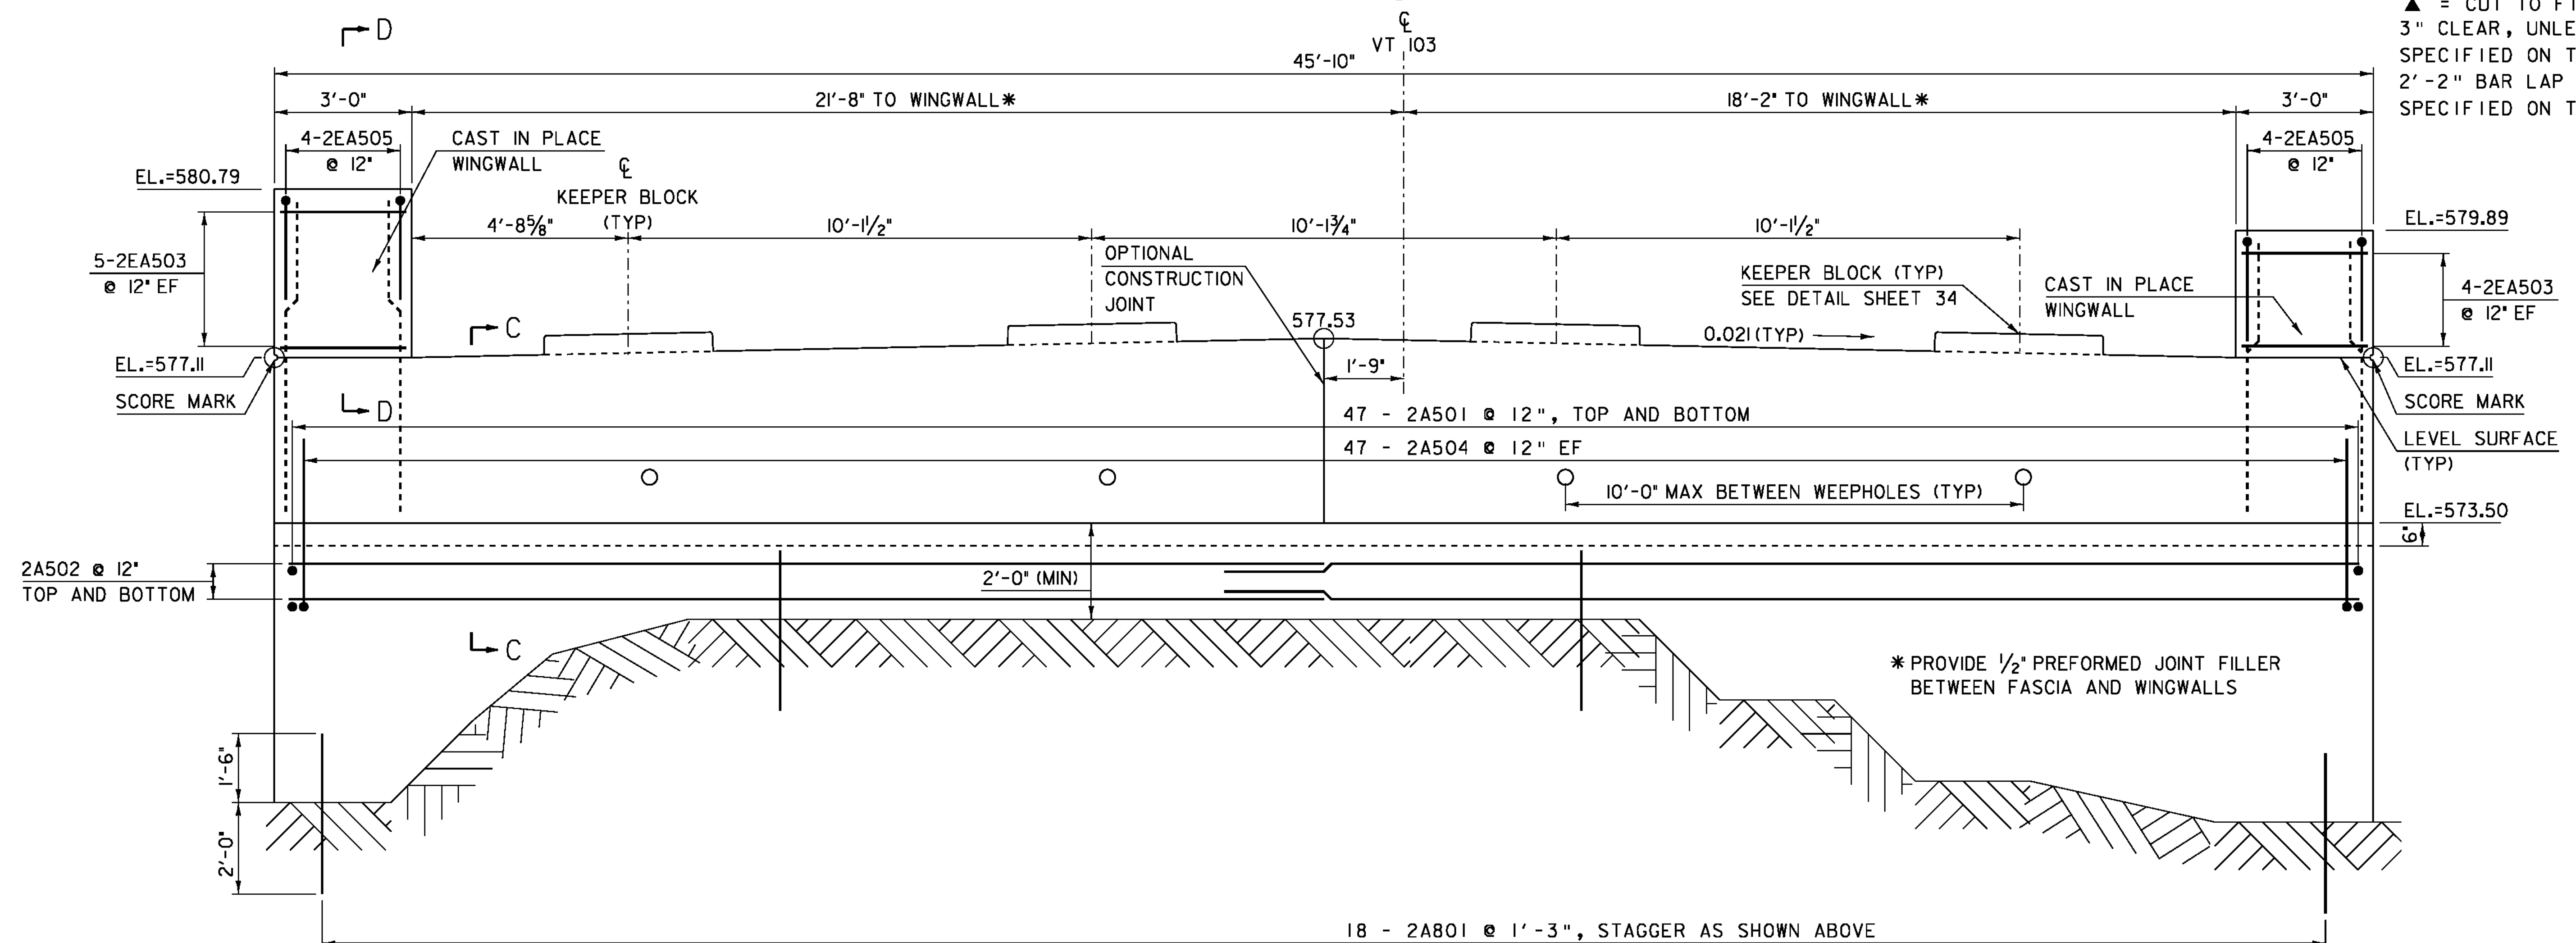

ABUTMENT 2 ELEVATION VIEW

SCALE 1/2" = 1'-0"

SEE SHEET 36
FOR SECTIONS "C-C" & "D-D"

SCALE 1/2" = 1'-0"

PROJECT NAME: CHESTER
PROJECT NUMBER: BRF 025-1(28)

FILE NAME: 84e061/Str/sub.dgn
PROJECT LEADER: C.P.WILLIAMS
DESIGNED BY: R.S.YOUNG
BRIDGE 8 ABUTMENT 2 DETAILS

PLOT DATE: 20-SEP-2010
DRAWN BY: M.FESSEL
CHECKED BY: R.S.YOUNG
SHEET 35 OF 124