
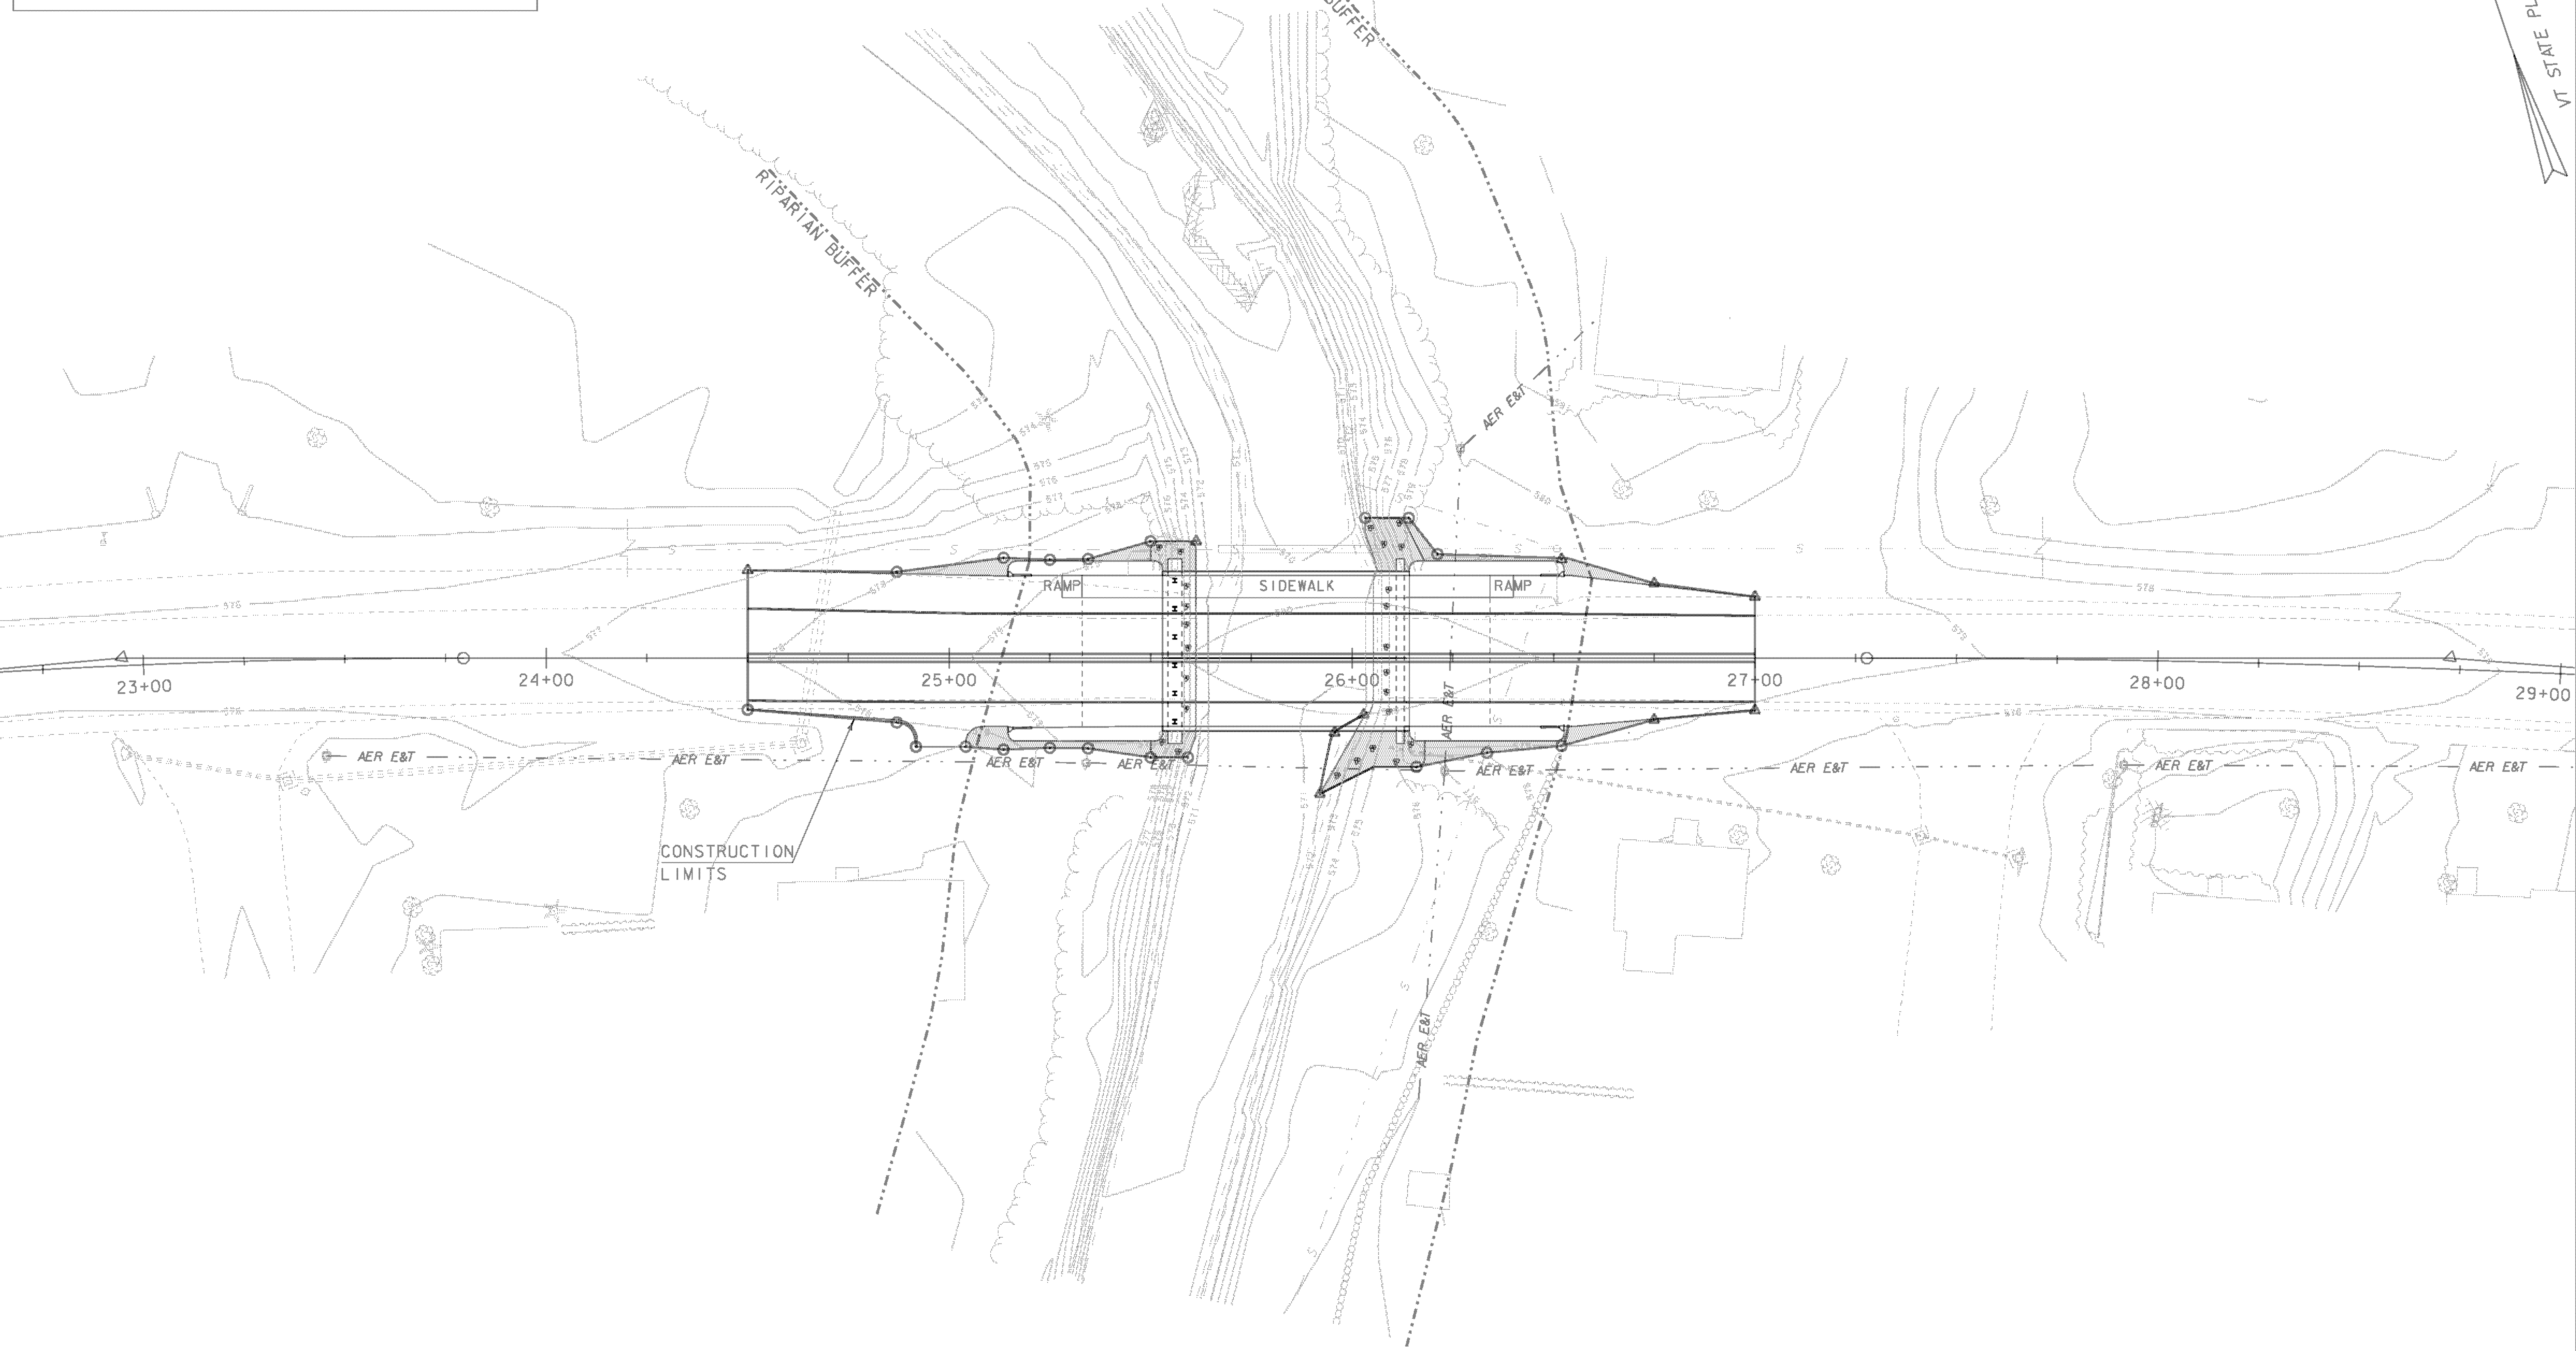


LEGEND

----- RIPARIAN BUFFER ZONE

 EROSION MATTING

 SEED AND MULCH

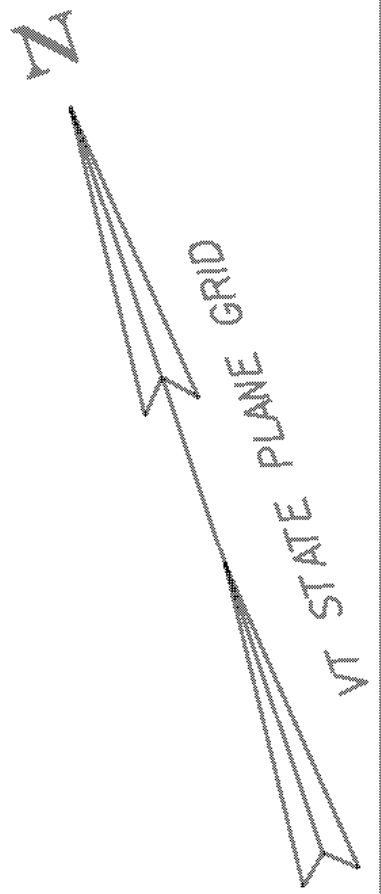

SCALE 1" = 20'-0"

20 0 20

PROJECT NAME: CHESTER		PLOT DATE: 20-SEP-2010	
PROJECT NUMBER: BRF 025-1(28)		DRAWN BY: M.FESSEL	
FILE NAME: s84e06lbr_ero.dgn		CHECKED BY: R.S.YOUNG	
PROJECT LEADER: C.P.WILLIAMS		SHEET 49 OF 124	
DESIGNED BY: R.S.YOUNG		BRIDGE 8 FINAL CONDITIONS SITE PLAN	