




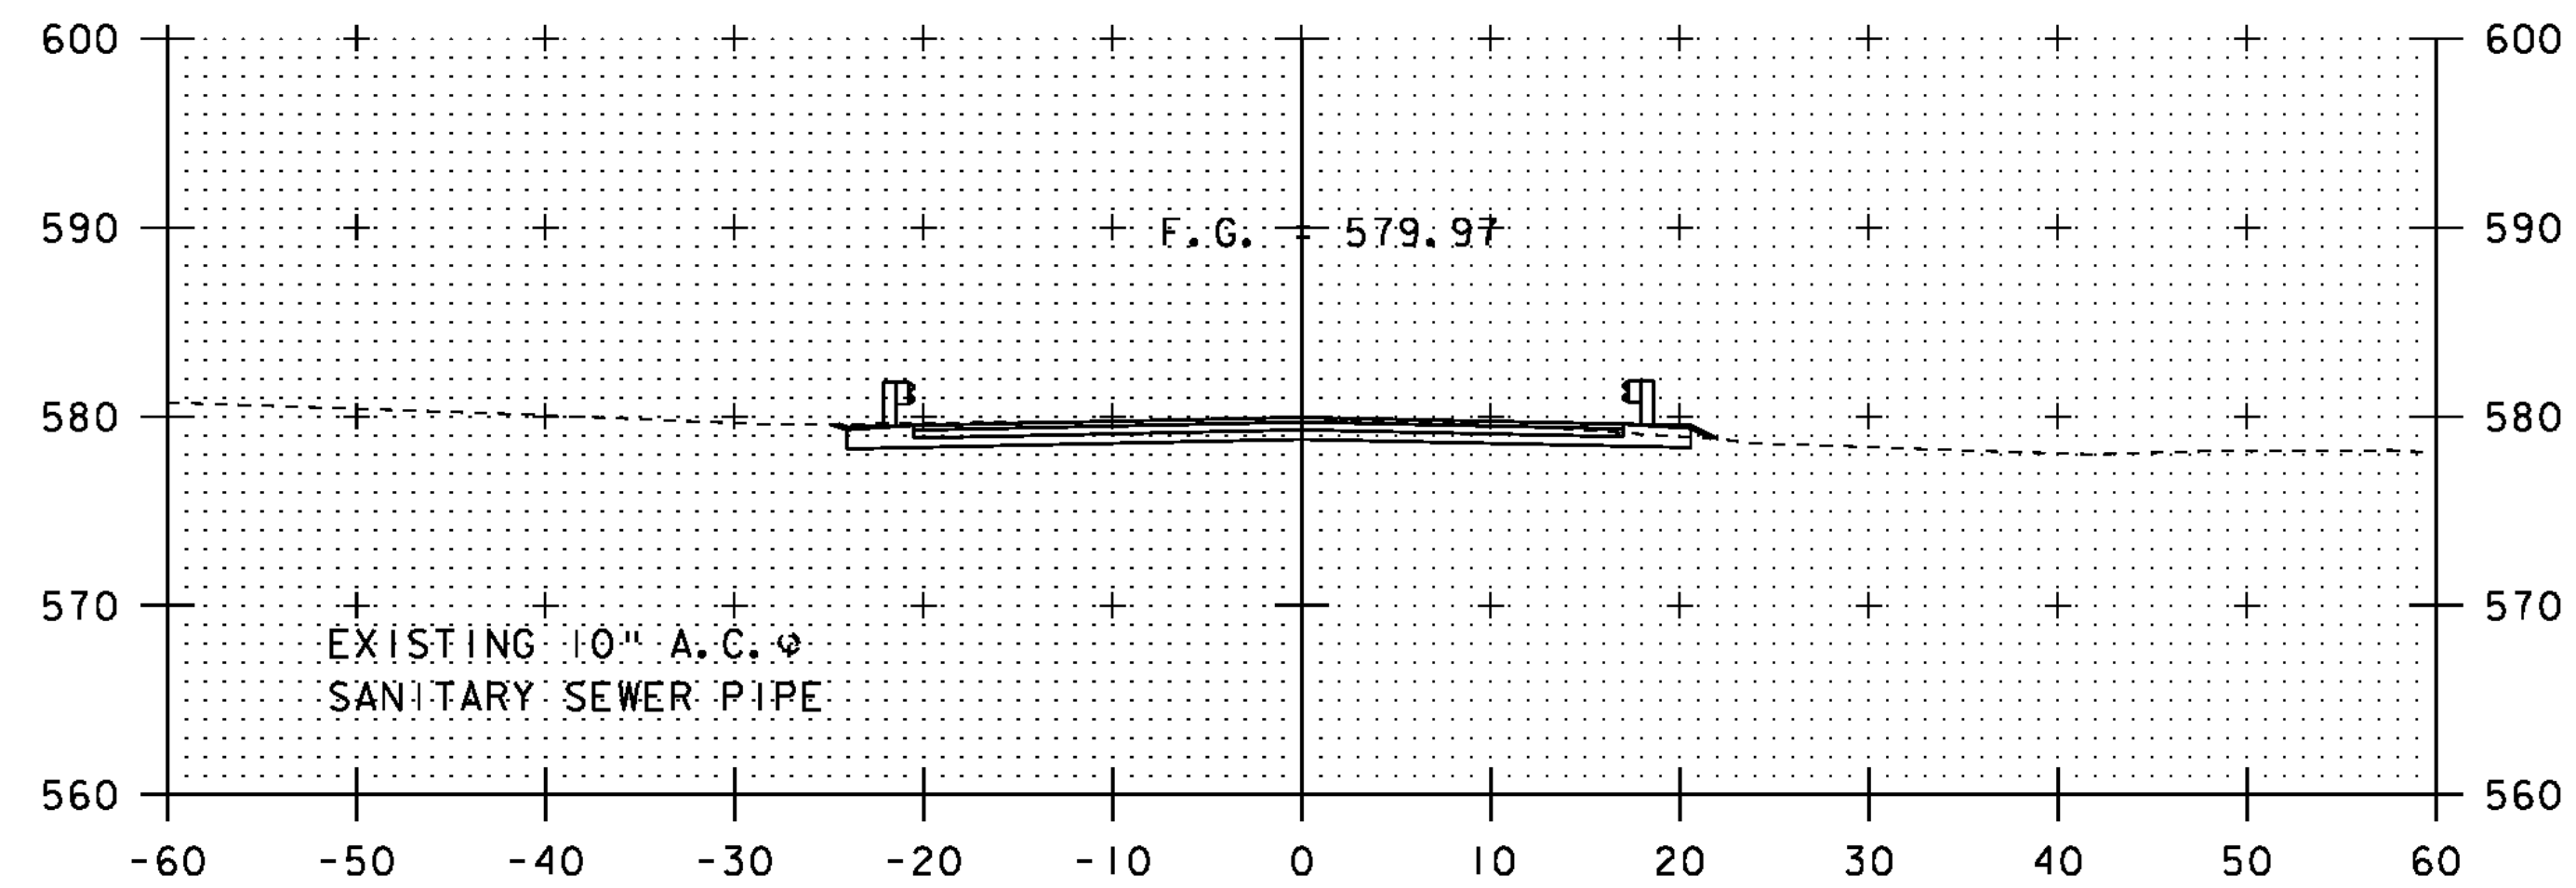

26+50
END PROJECT
STA 26+50.00

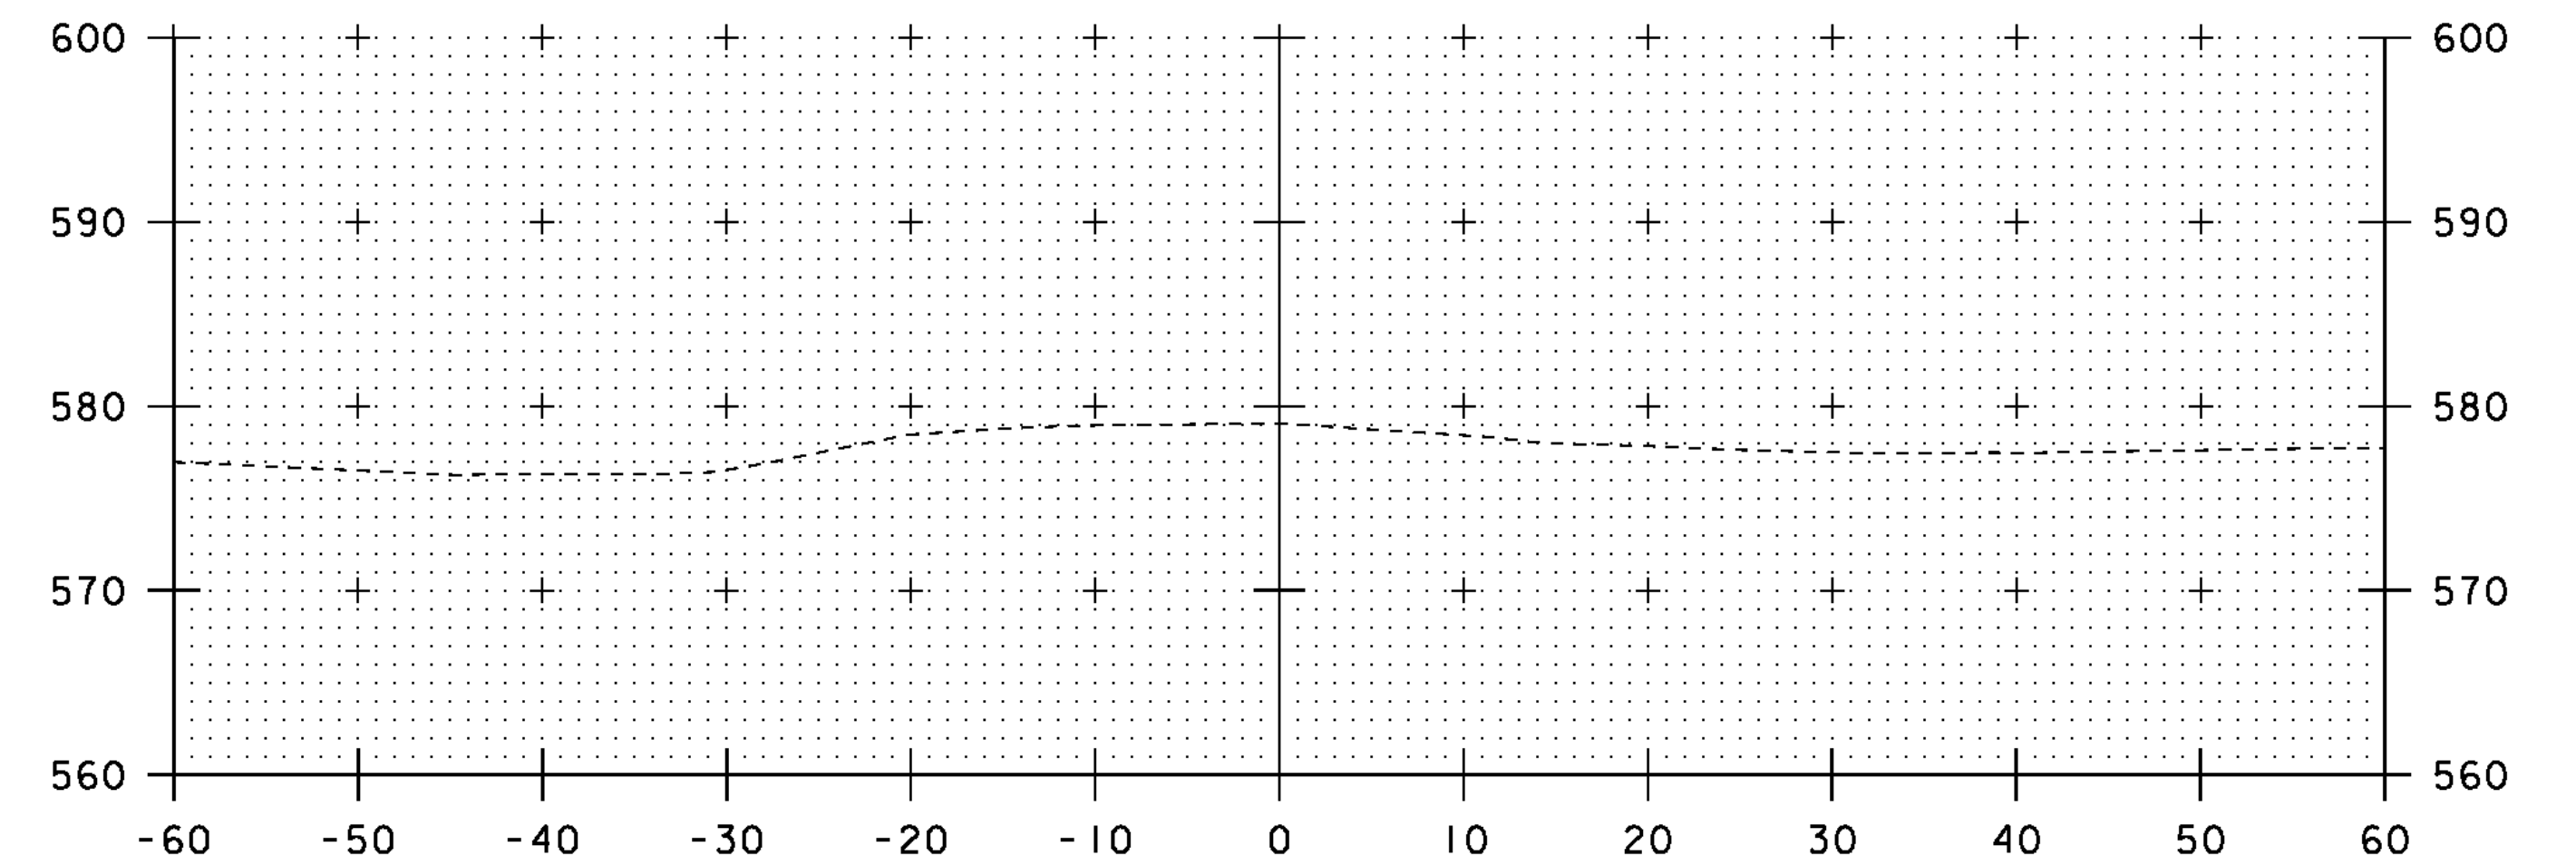


27+50

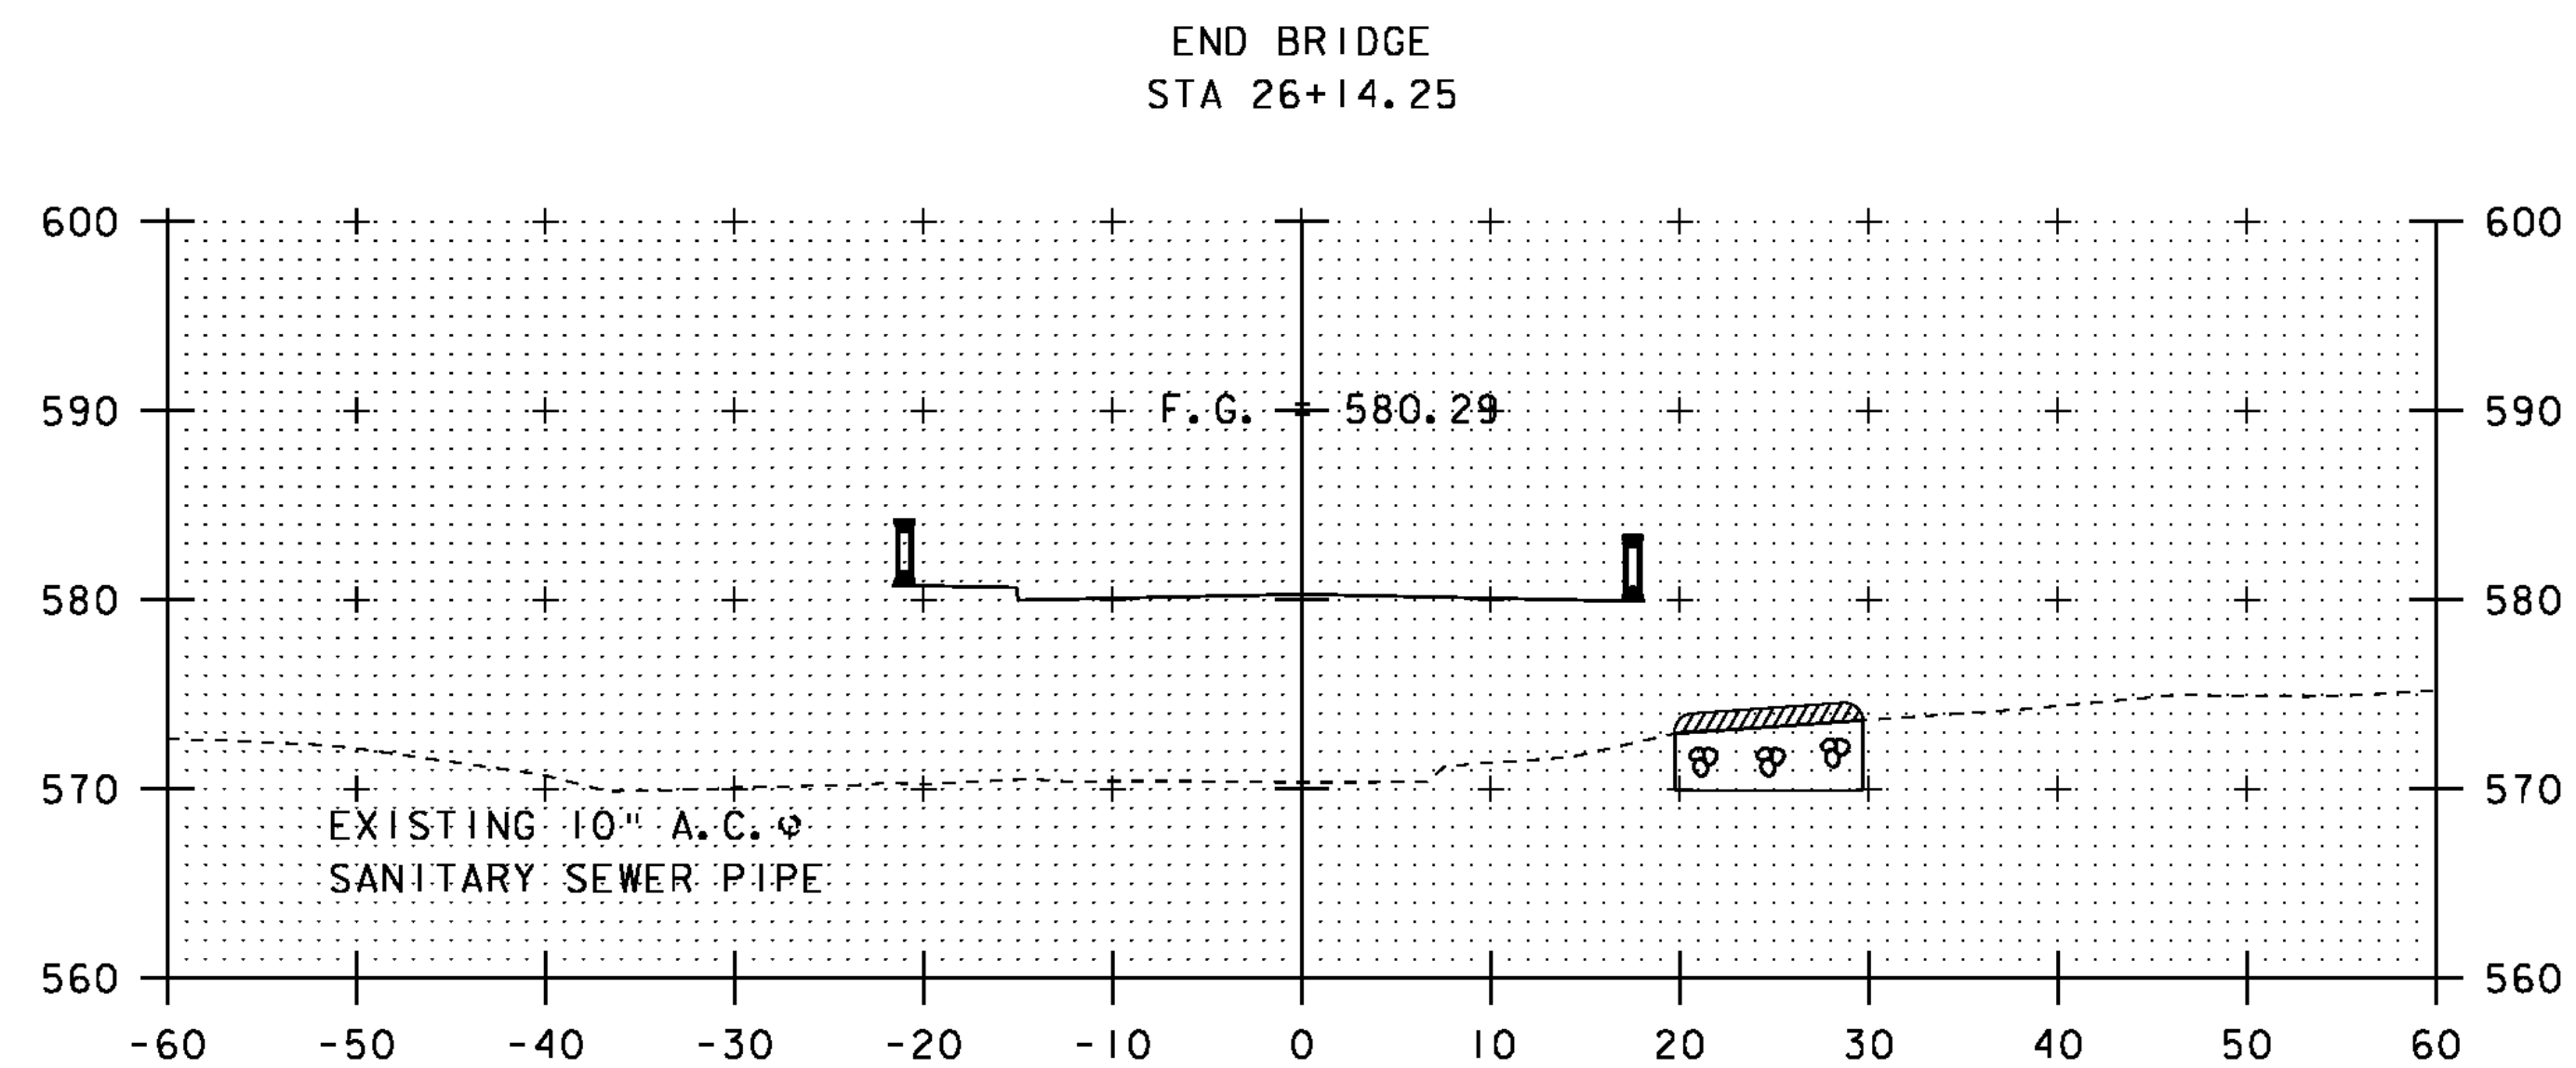

END BRIDGE
STA 26+14.25

26+00

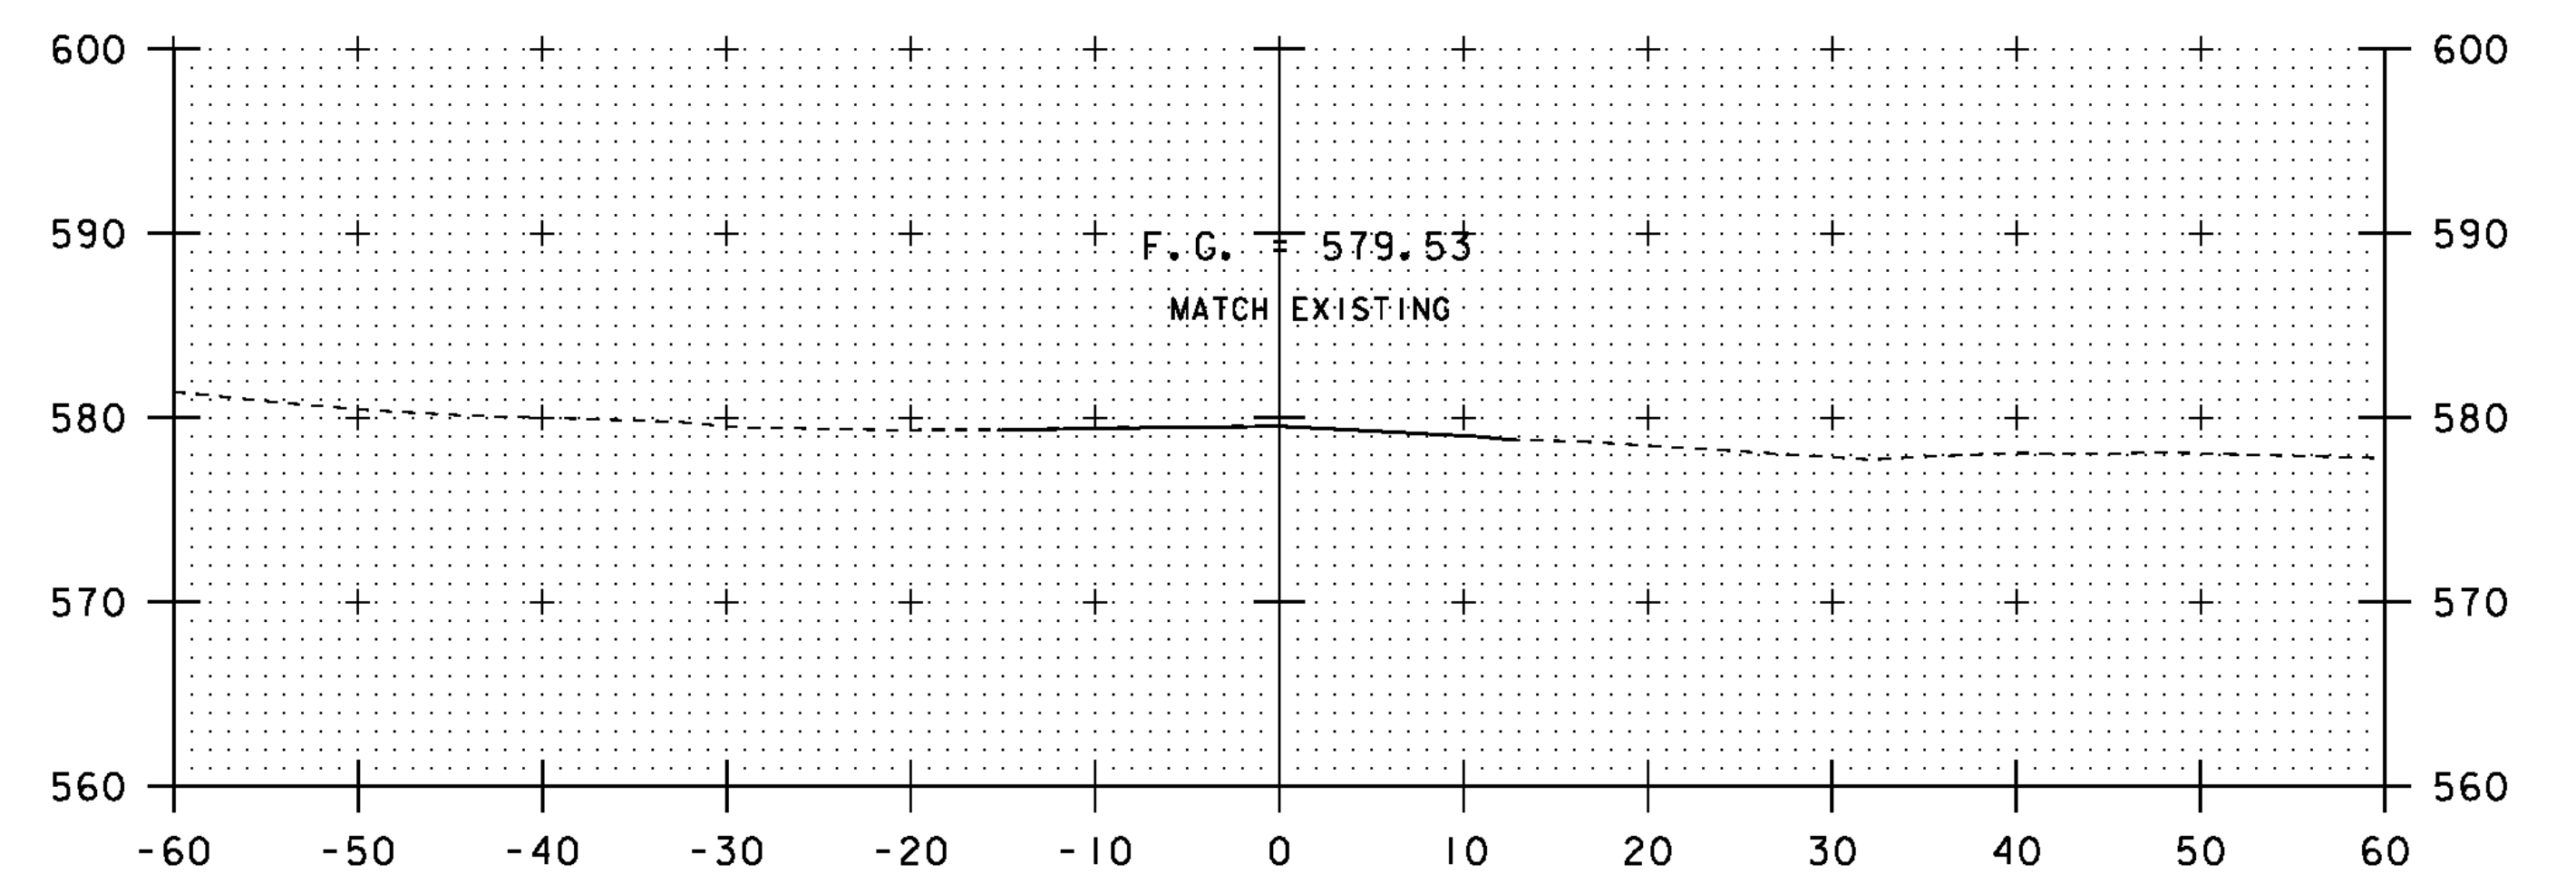

27+00

END APPROACH
STA 27+00.00

SCALE 1" = 10' - 0"
10 0 10

STA. 26+00 TO STA. 27+50

PROJECT NAME: CHESTER
PROJECT NUMBER: BRF 025-1(28)

FILE NAME: s84e061/Str/xsl.dgn
PROJECT LEADER: C.P.WILLIAMS
DESIGNED BY: R.S.YOUNG
BRIDGE 8 MAINLINE CROSS SECTIONS 2

PLOT DATE: 20-SEP-2010
DRAWN BY: M.FESSEL
CHECKED BY: R.S.YOUNG
SHEET 53 OF 124