



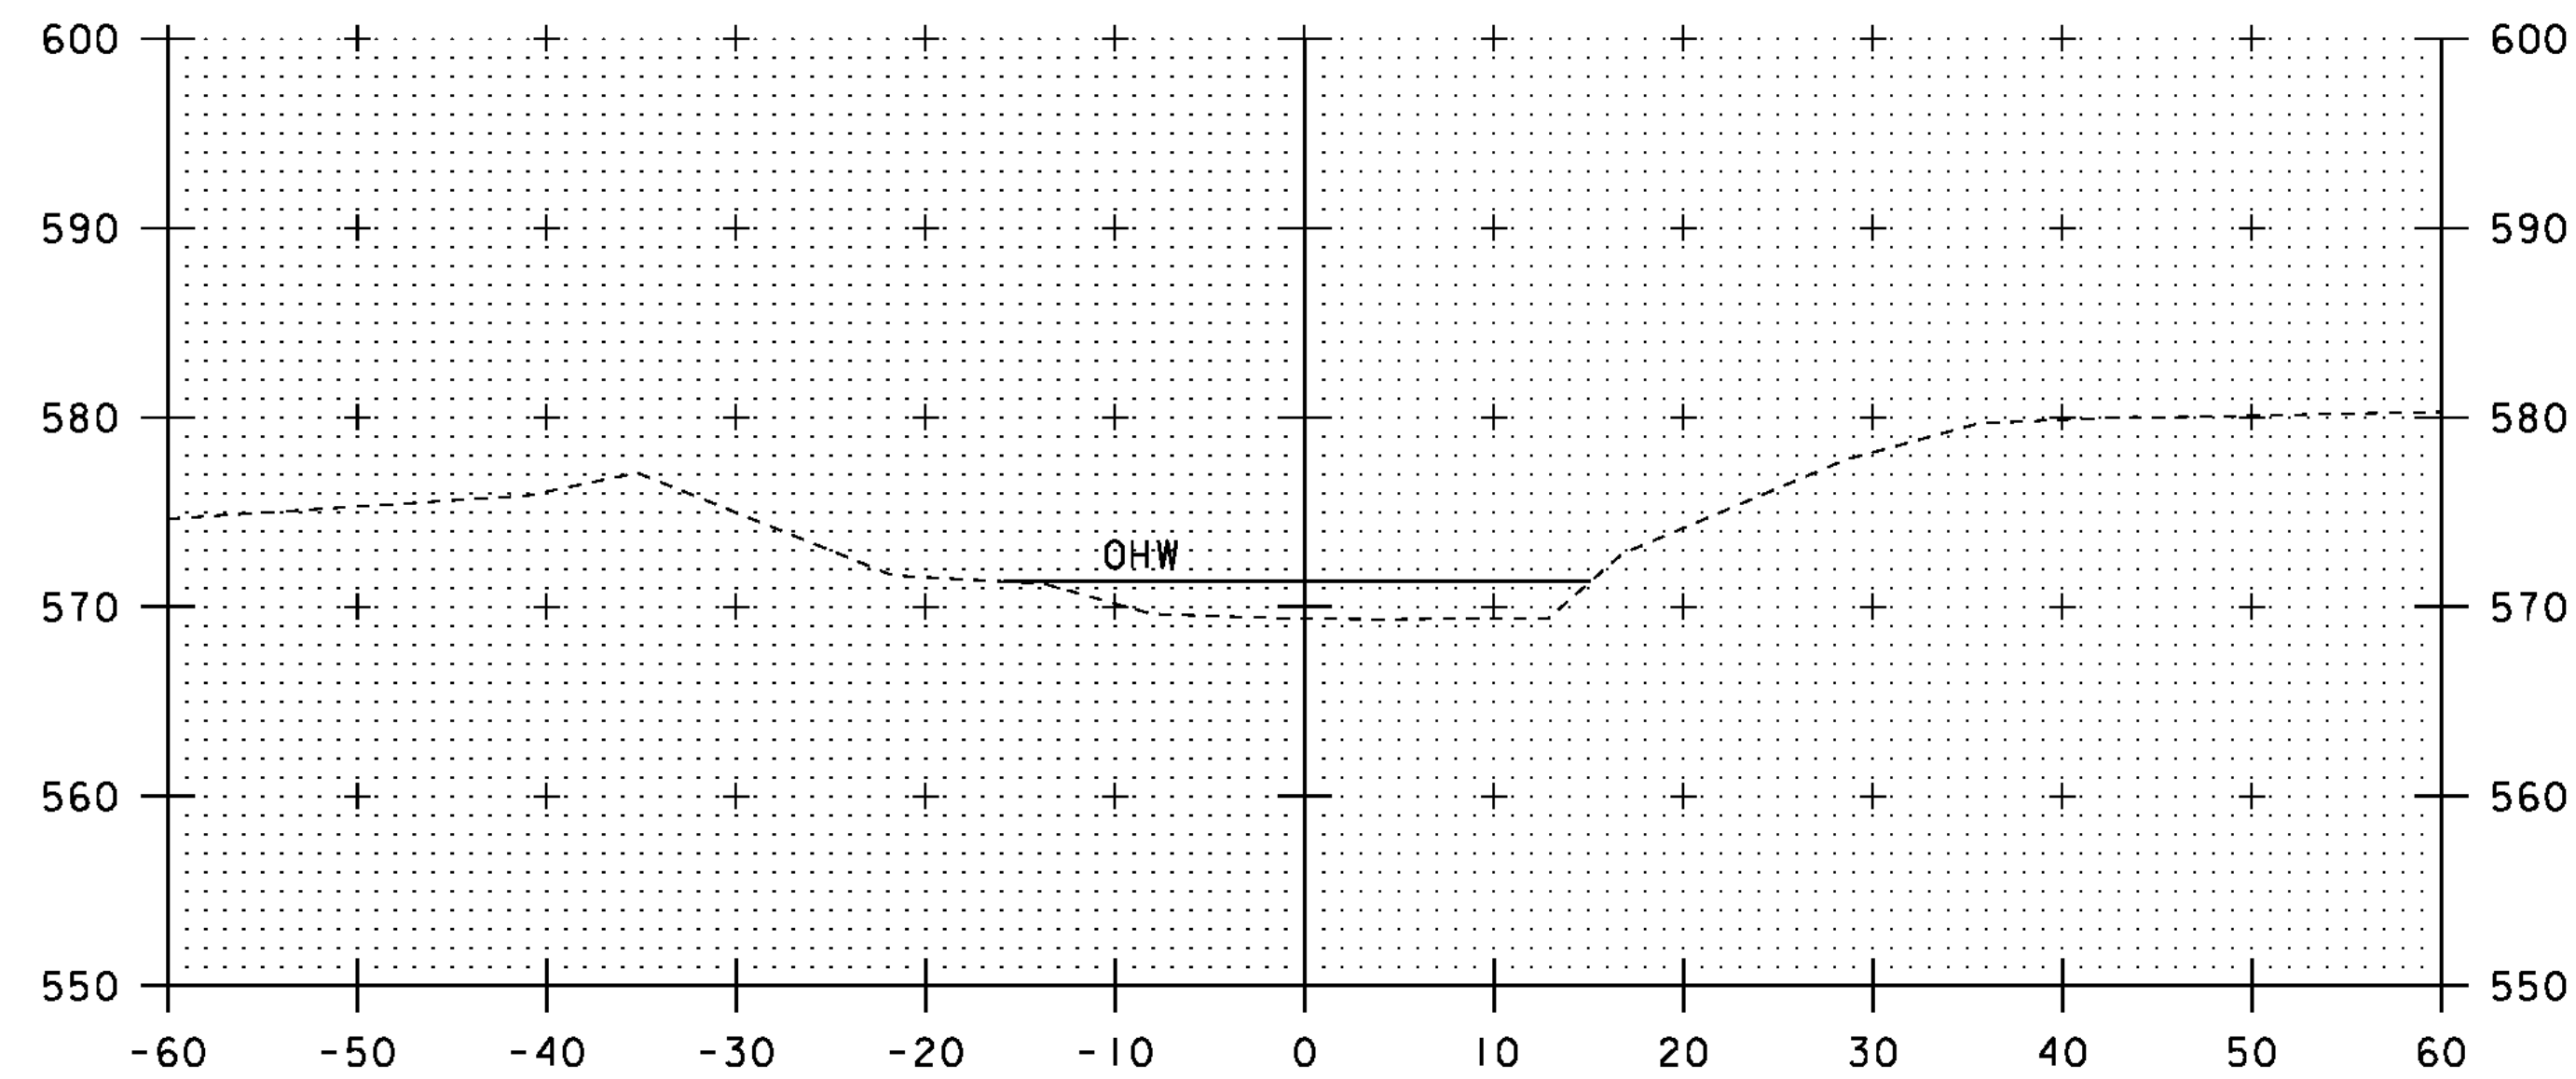

END STONE FILL, TYPE III
GEOTEXTILE UNDER STONE FILL
GRUBBING MATERIAL
UNCLASSIFIED CHANNEL EXCAVATION
STA 11+04.00 LT


11+25

END STONE FILL, TYPE III
GEOTEXTILE UNDER STONE FILL
GRUBBING MATERIAL
UNCLASSIFIED CHANNEL EXCAVATION
STA 11+10.00 RT

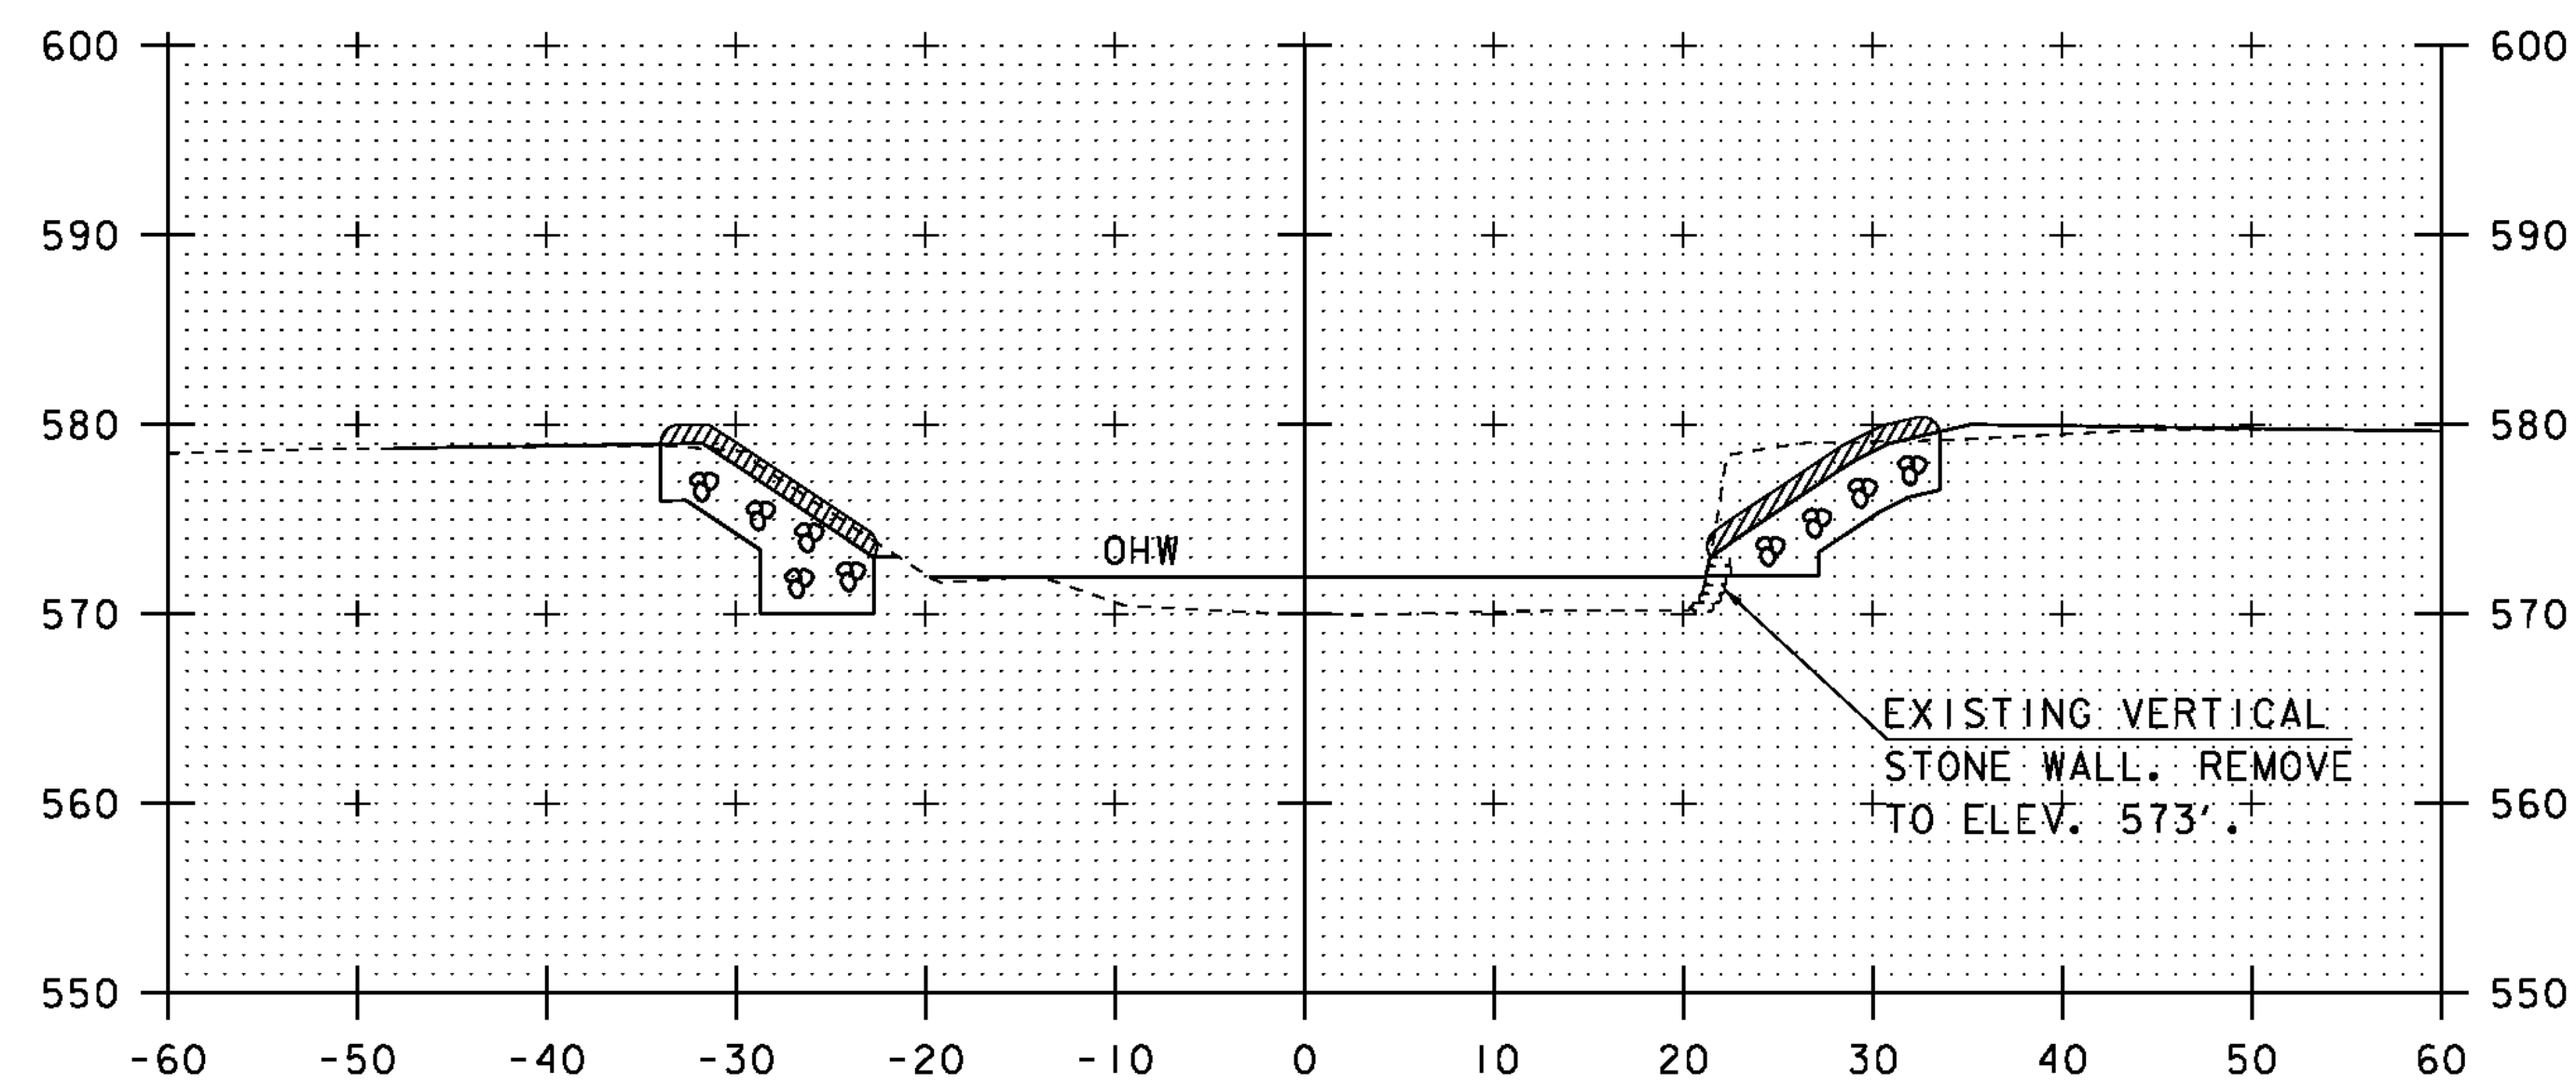


BEGIN GRUBBING MATERIAL
STA 10+96.50 LT AND RT

11+00

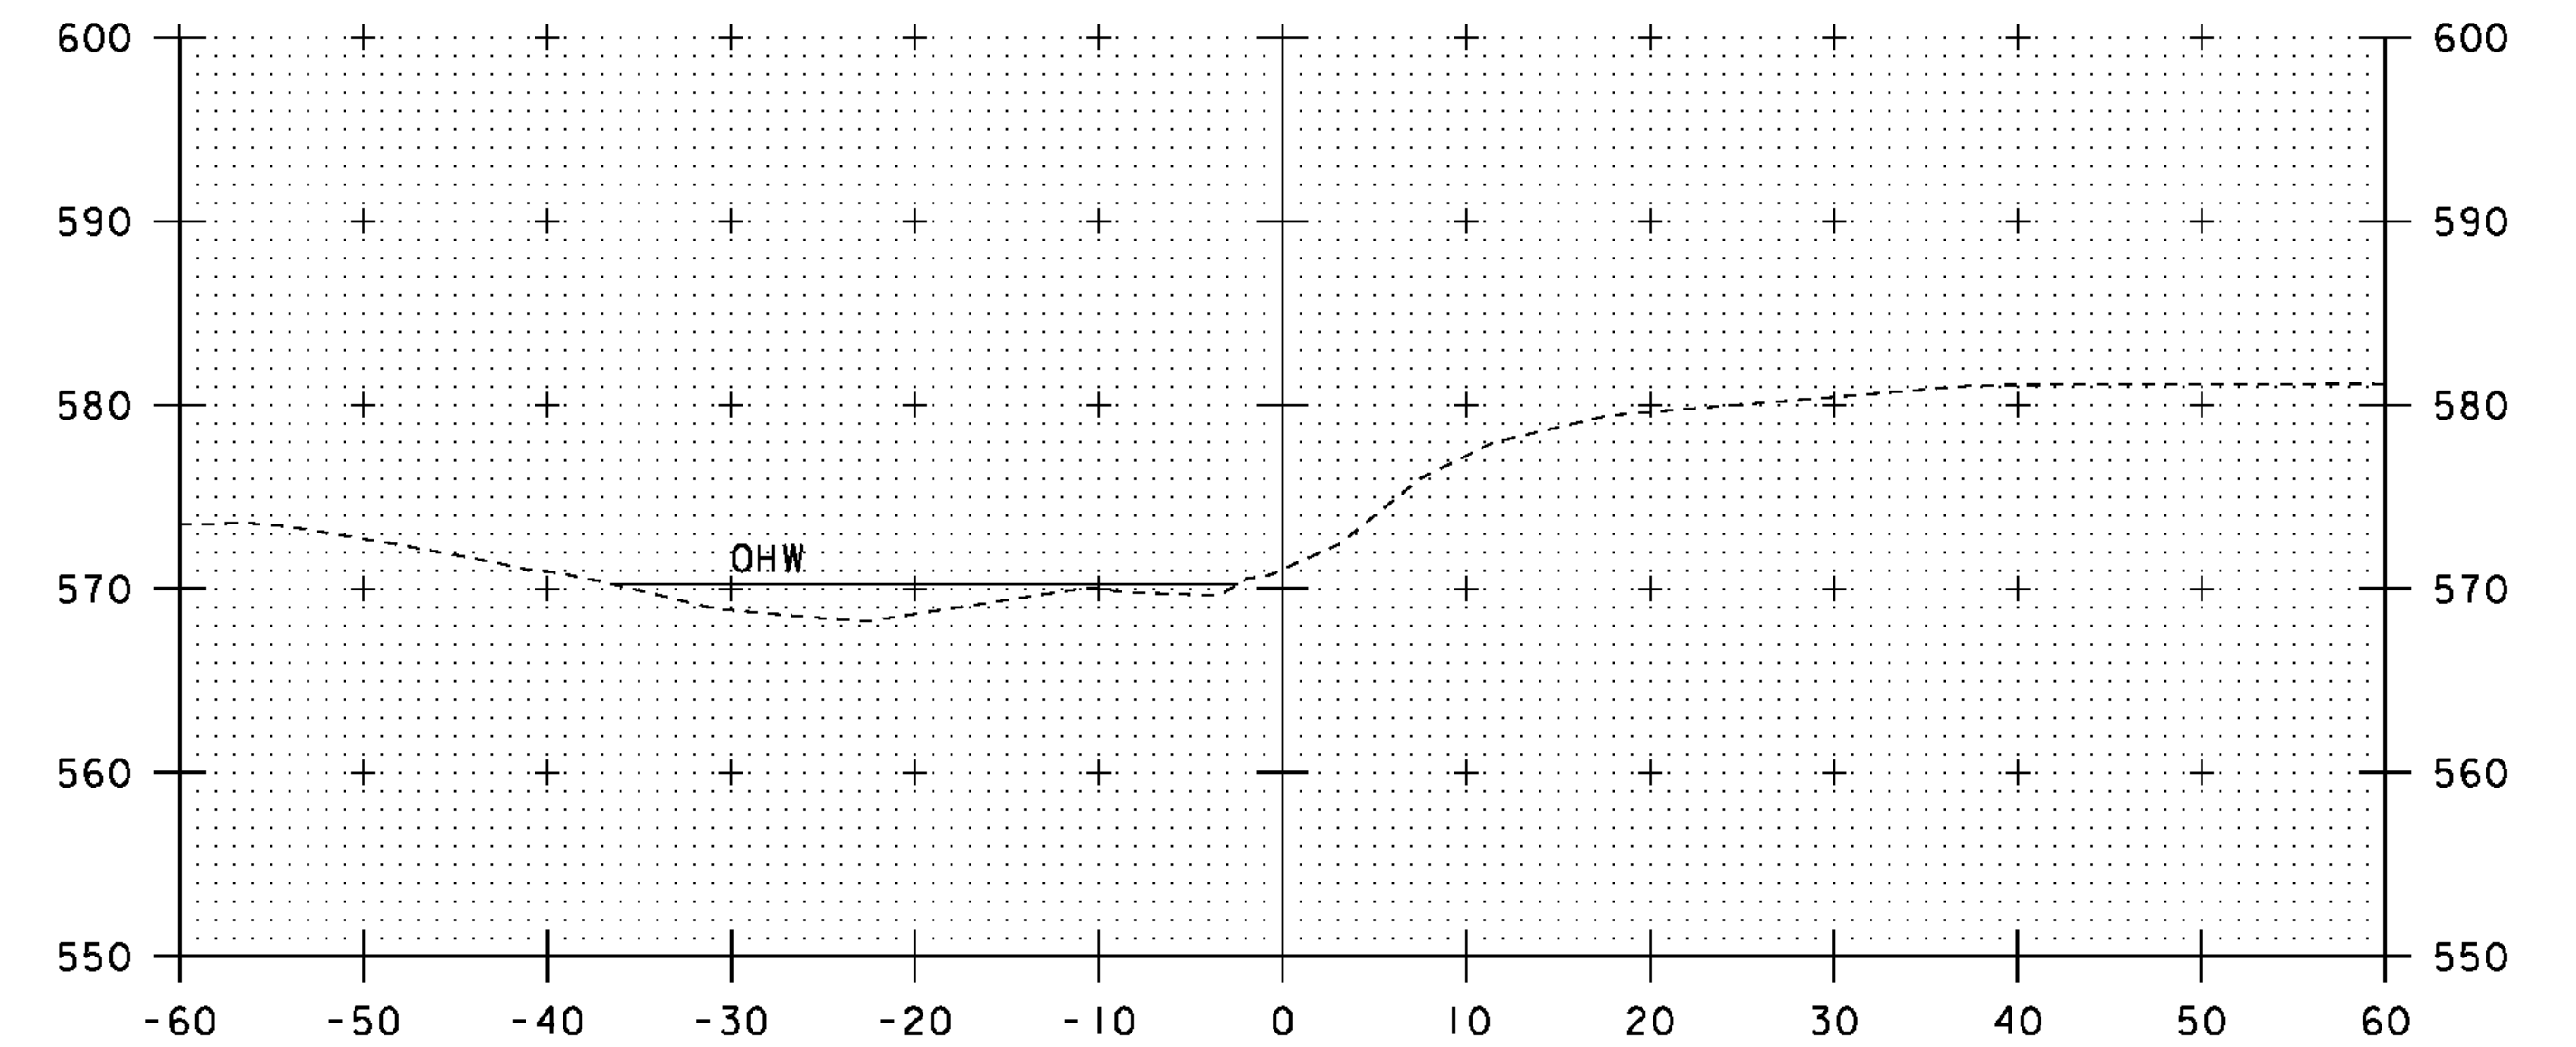

11+75

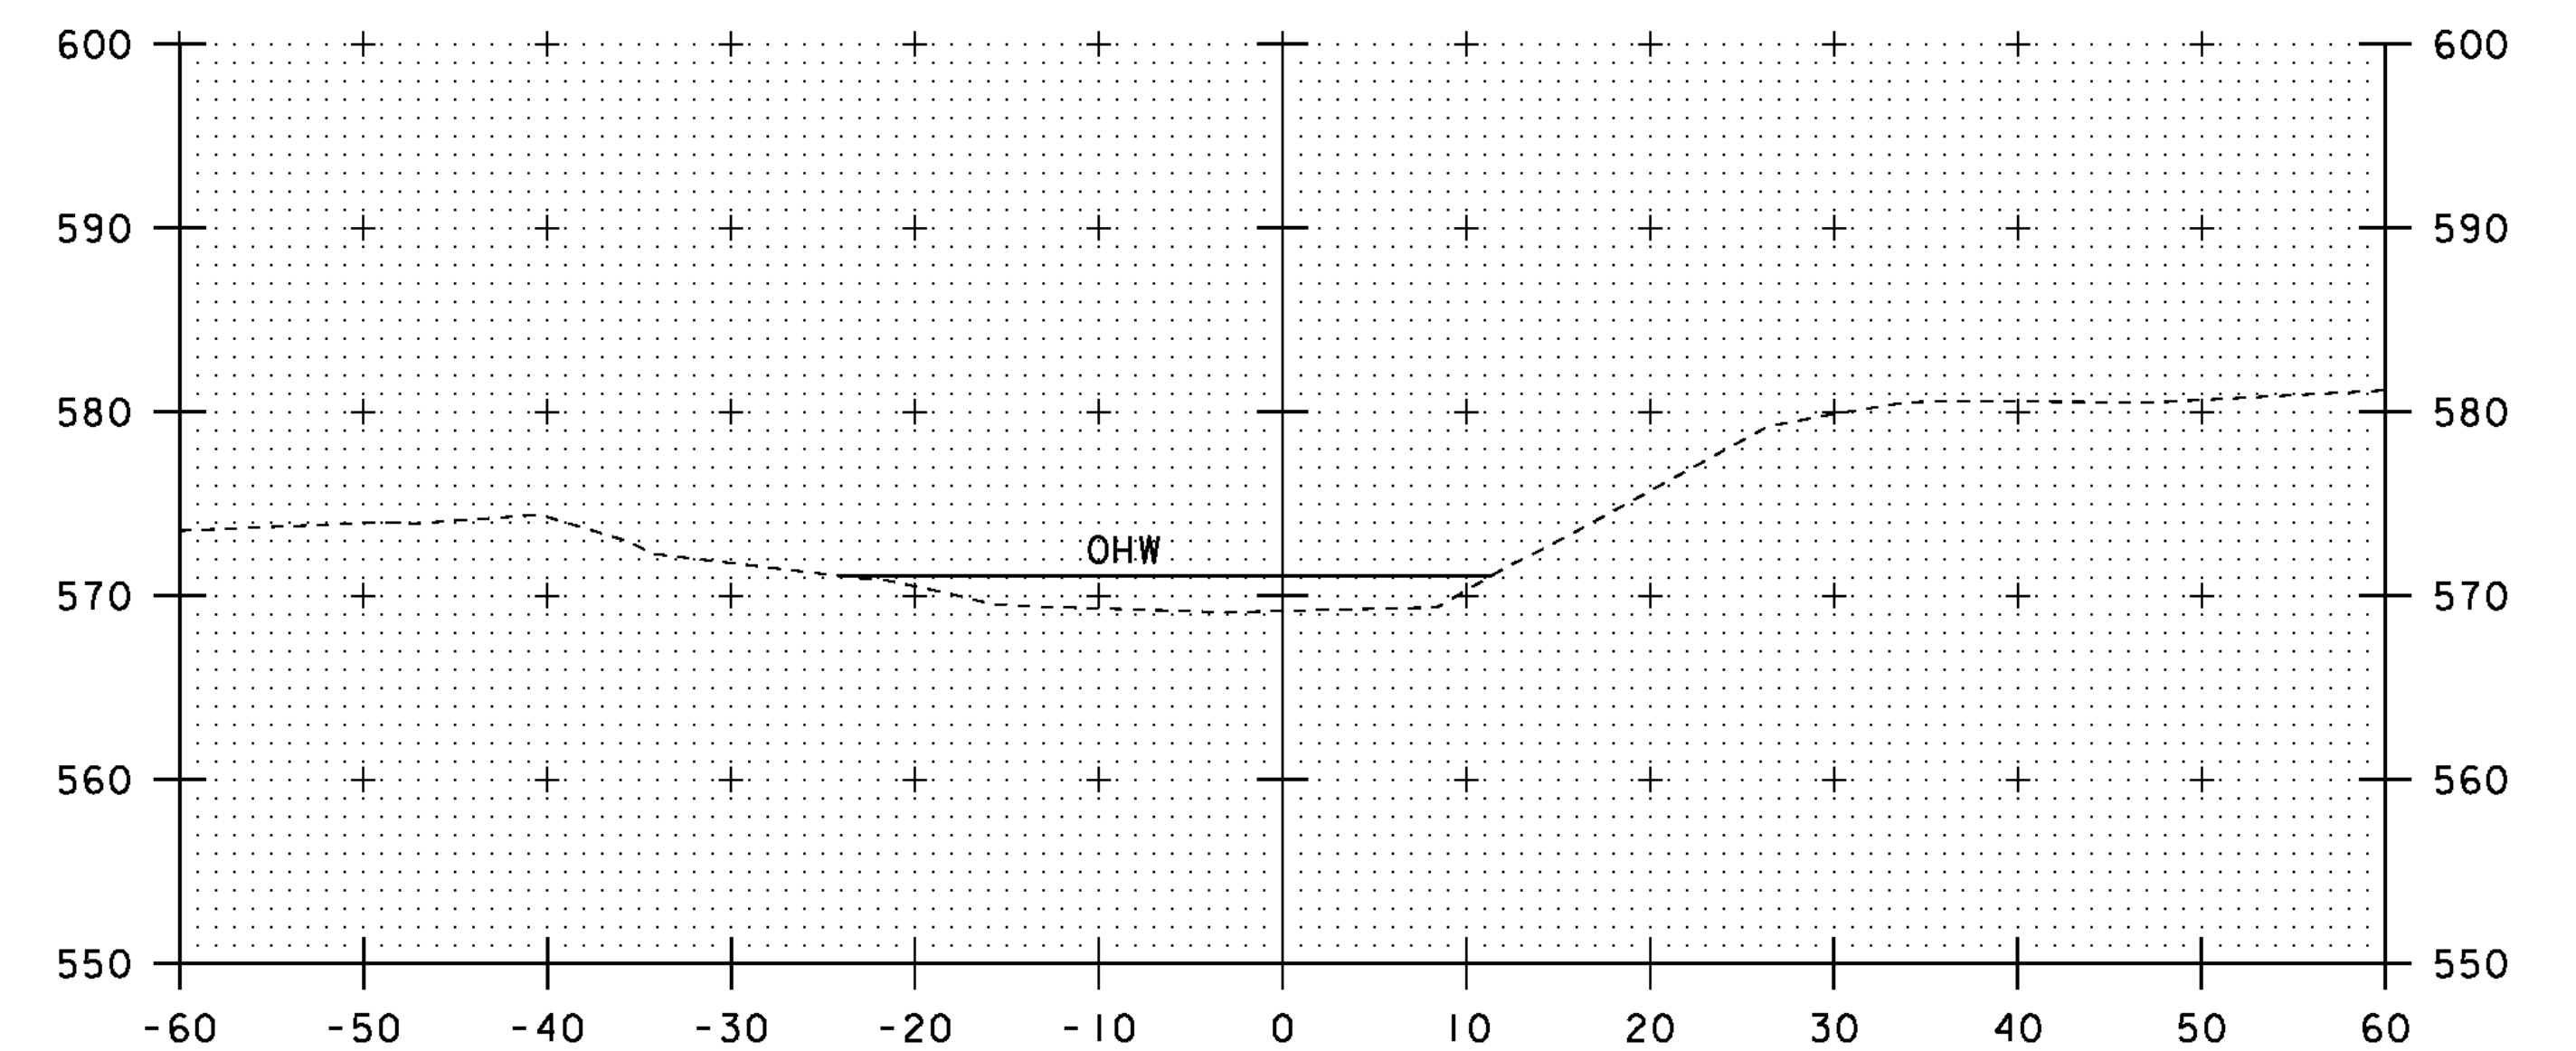

11+50

SCALE 1" = 10' - 0
10 0 10

STA. 11+00 TO STA. 11+75

PROJECT NAME: CHESTER
PROJECT NUMBER: BRF 025-1(28)

FILE NAME: s84e061/Str/xsl.dgn
PROJECT LEADER: C.P.WILLIAMS
DESIGNED BY: R.S.YOUNG
BRIDGE 8 CHANNEL CROSS SECTIONS 2

PLOT DATE: 20-SEP-2010
DRAWN BY: M.FESSEL
CHECKED BY: R.S.YOUNG
SHEET 55 OF 124